

It is the builder's complete responsibility to ensure that all plans submitted for approval fully comply with the Architectural Guidelines and all applicable regulations and requirements including zoning provisions and any provisions in the subdivision agreement. The Control Architect is not responsible in any way for examining or approving site (lotting) plans or working drawings with respect to any zoning or building code or permit matter or that any house can be properly built or located on its lot.

This is to certify that these plans comply with the applicable Architectural Design Guidelines approved by the Town of Bradford / West Gwillimbury.

ARCHITECTURAL REVIEW & APPROVAL

JAN 15 2018

John G. Williams Limited, Architect

TOWN OF BRADFORD WEST GWILLIMBURY - BUILDING DEPARTMENT

REVIEWED

INSPECTOR:

PERMIT NO.: MODEL CERT.

DATE: Oct. 22, 2018

ALL CONSTRUCTION SHALL COMPLY WITH THE ONTARIO BUILDING CODE AND ALL OTHER APPLICABLE STATUTORY REGULATIONS. THE REVIEWED DOCUMENTS MUST BE KEPT ON SITE AT ALL TIMES.

INSPECTION REQUEST EMAIL: BUILDINGINSPECTIONS@TOWNOFBWG.COM  
INSPECTION REQUEST FAX: (905) 778-2035  
INSPECTION REQUEST TELEPHONE: (905) 775-5369 EXT. 1500

NOTE: FLOOR FRAMING INFO REFER TO SHOP DRAWINGS FOR ALL TRUSS-JOIST INFORMATION AND DETAILS. UNLESS OTHERWISE NOTED.

NOTE J1: PROVIDE SOLID BLOCKING @ 24" O.C. WHERE FLOOR JOISTS ARE PARALLEL TO FOUNDATION WALL (TYP.)

AREA CALCULATIONS	ELEV. B
GROUND FLOOR AREA	1013 SF
SECOND FLOOR AREA	1162 SF
	2175 SF
DEDUCT ALL OPEN AREAS	0 SF
<b>TOTAL NET AREA</b>	<b>2175 SF</b> (202.06 m <sup>2</sup> )
FINISHED BSMT AREA	- SF
W/OUT PORCH	1234 SF (114.64 m <sup>2</sup> )
<b>COVERAGE</b>	<b>1448 SF</b> (134.52 m <sup>2</sup> )

no.	description	date	by
9			
8			
7			
6			
5			
4			
3	REVISED AS PER ENG'S COMMENTS	JAN 03-18	RC
2	REVISED AS PER FLOOR AND ROOF LAYOUTS	SEP 15-17	RC
1	REVISED FOUNDATION WALL TO BE 10"	NOV 30/16	SB

The undersigned has reviewed and takes responsibility for this design and has the qualifications and meets the requirements set out in the Ontario Building Code to be a Designer.	
qualification information	
Wellington Jno-Baptiste	25591
name	
registration information	BCN
VAS Design Inc.	42658
Contractor must verify all dimensions on the job and report any discrepancy to the Designer before proceeding with the work. All drawings and specifications are instruments of service and the property of the Designer which must be returned at the completion of the work. Drawings are not to be scaled.	

**VAS DESIGN**

255 Consumers Rd Suite 120  
Toronto ON M2J 1R4  
t 416.630.2255 f 416.630.4782  
vasdesign.com

**BAYVIEW WELLINGTON**  
**SITE COPY**  
project name  
GREEN VALLEY EAST  
BRADFORD EAST, ON.


date  
SEPT. 2016  
drawn by  
NC  
checked by  
RC  
scale  
3/16" = 1'-0"  
COR. UPGRADE BASEMENT PLAN 'B'

**SD25-4**  
SONOMA 4 LOT 154

project no.  
16023

drawing no.  
1B

## BASEMENT PLAN 'B' CORNER UPGRADE-LOT 154

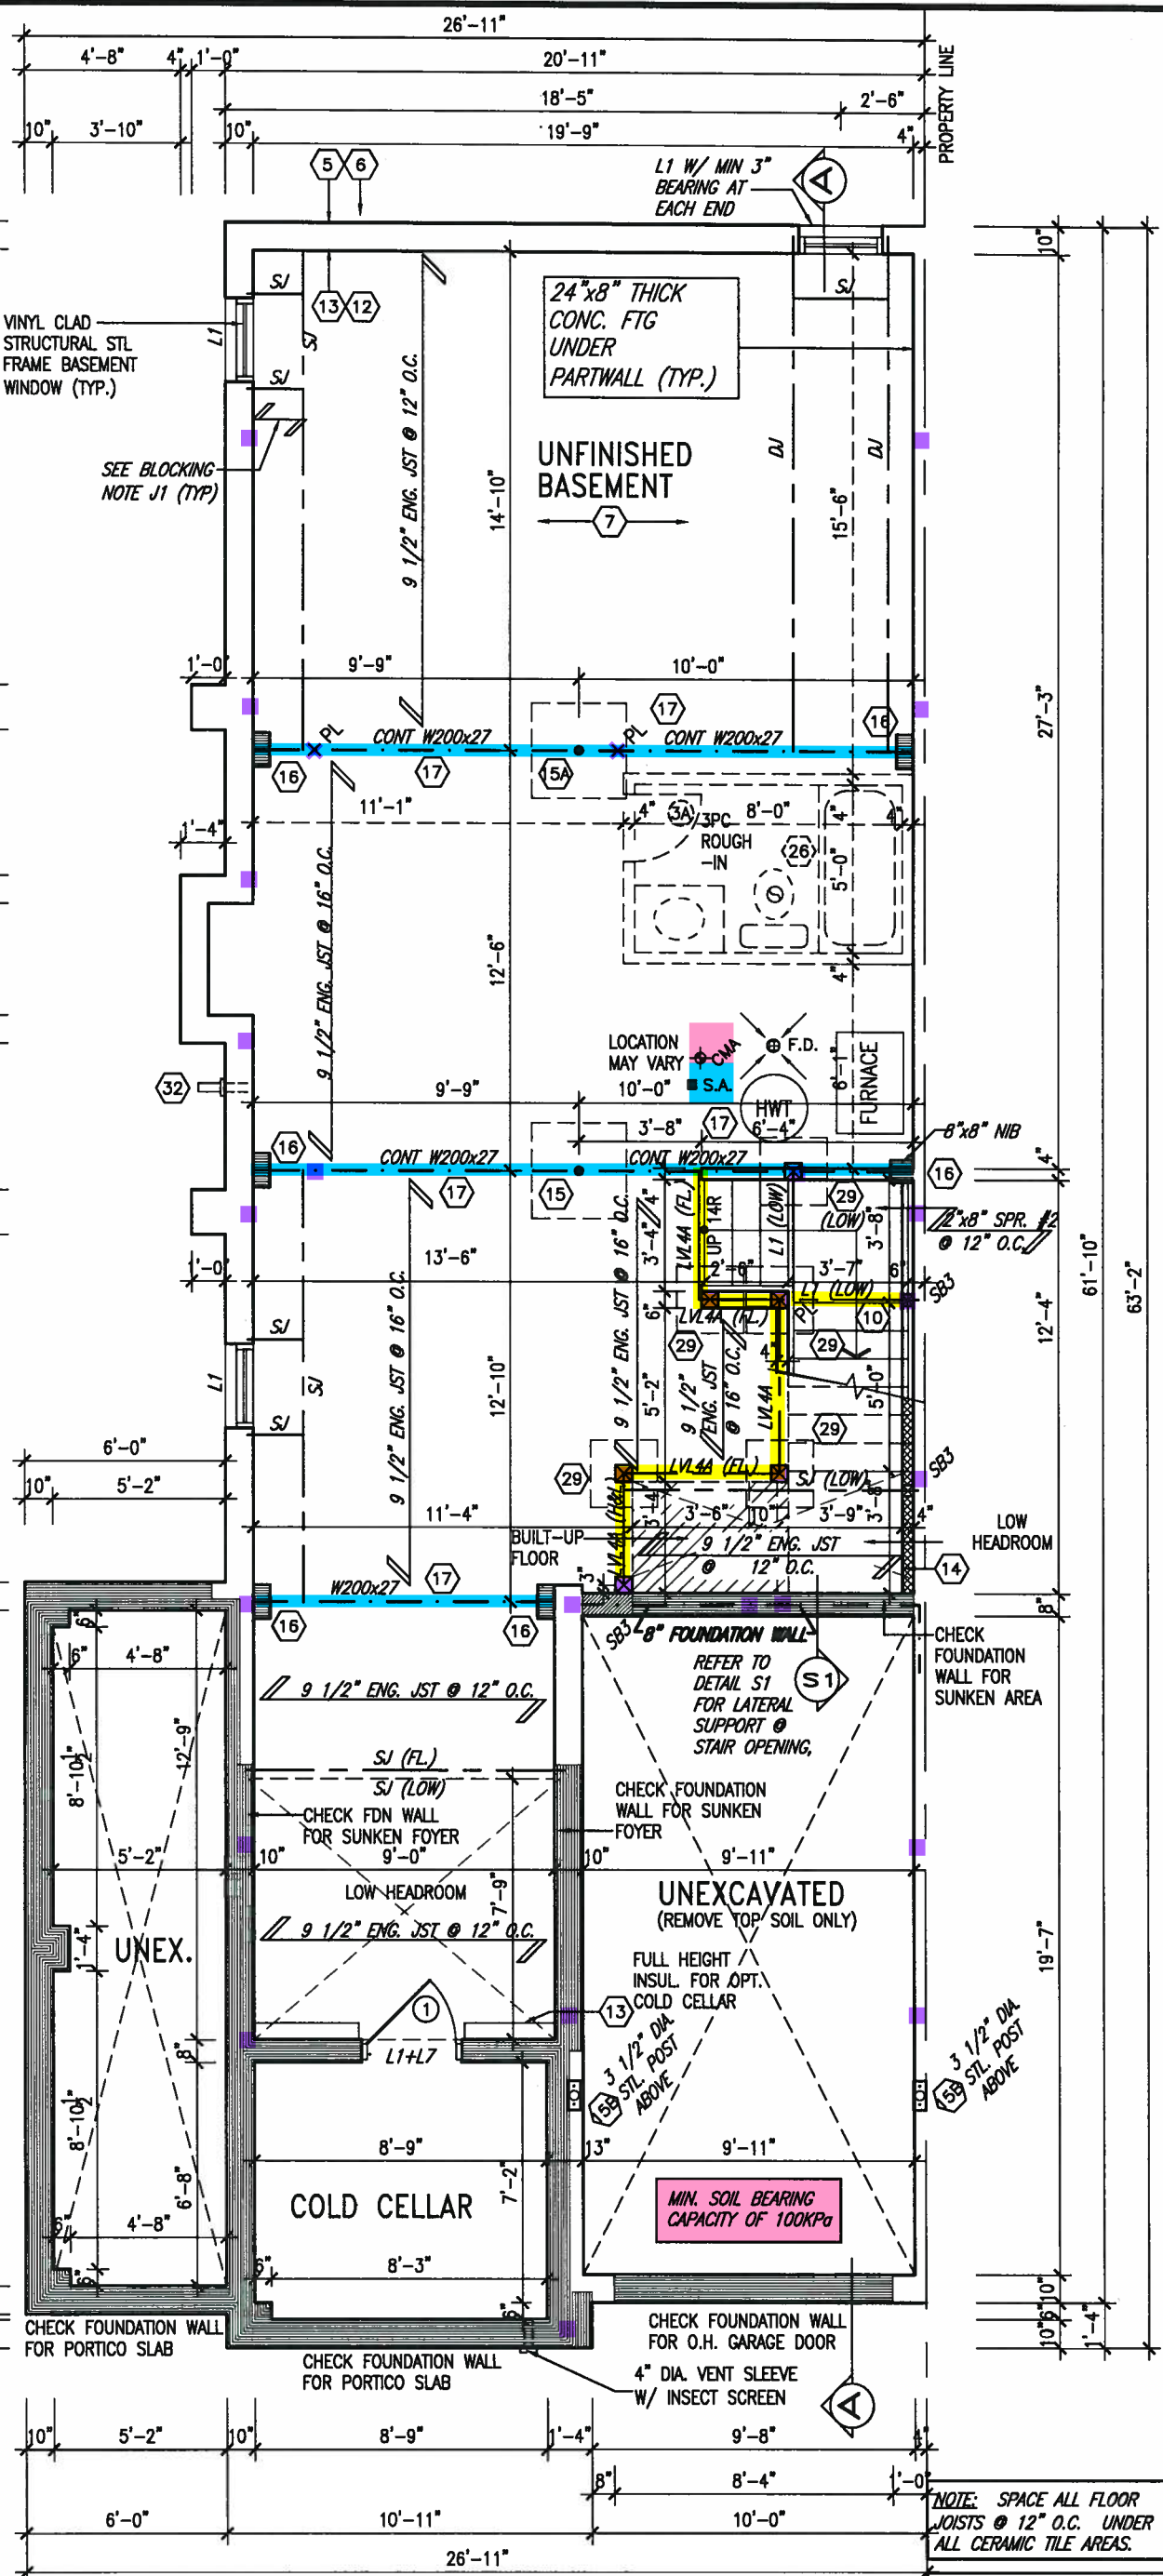

NOTE: SPACE ALL FLOOR JOISTS @ 12" O.C. UNDER ALL CERAMIC TILE AREAS.

NOTE: ALL LVL'S SUPPORTING FLOOR LOADS ARE TO BE SPECIFIED BY FLOOR TRUSS MANUFACTURER.



It is the builder's complete responsibility to ensure that all plans submitted for approval fully comply with the Architectural Guidelines and all applicable regulations and requirements including zoning provisions and any provisions in the subdivision agreement. The Control Architect is not responsible in any way for examining or approving site (lotting) plans or working drawings with respect to any zoning or building code or permit matter or that any house can be properly built or located on its lot.

This is to certify that these plans comply with the applicable Architectural Design Guidelines approved by the Town of BRADFORD / WEST GWILLIMBURY.



ARCHITECTURAL REVIEW & APPROVAL

JAN 15 2018

G. Williams Limited, Architect



JAN 11, 2018

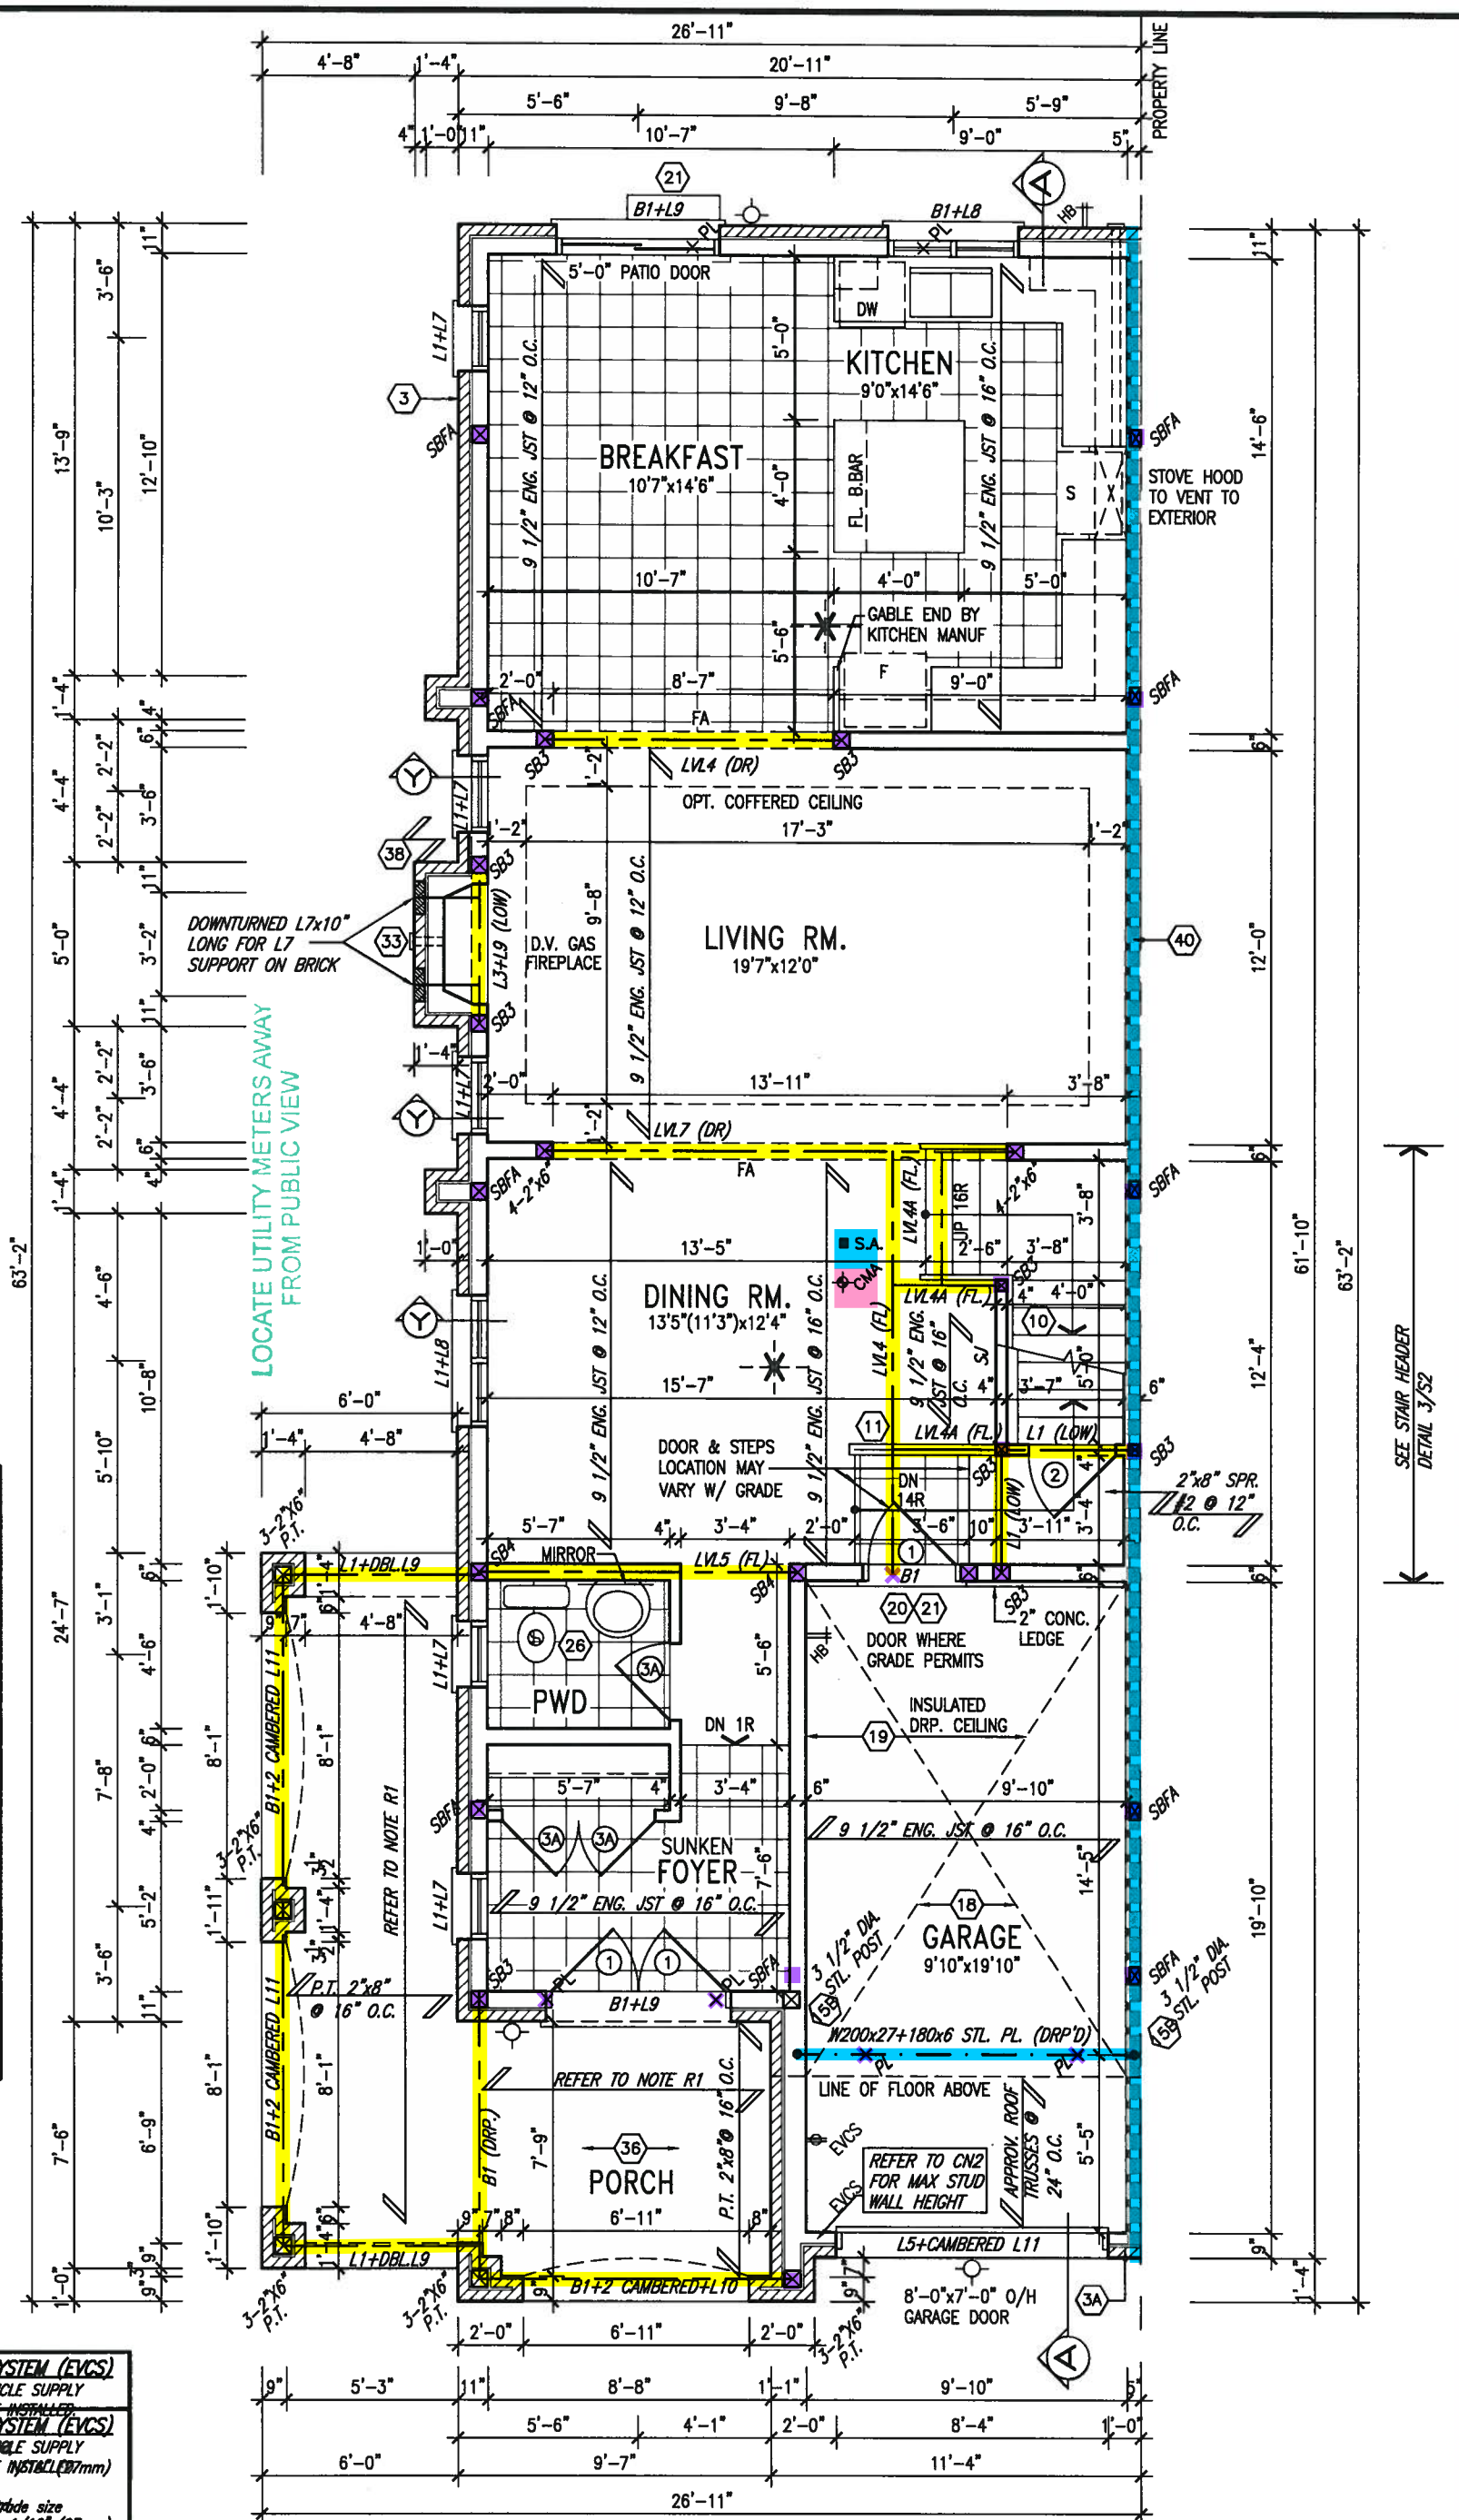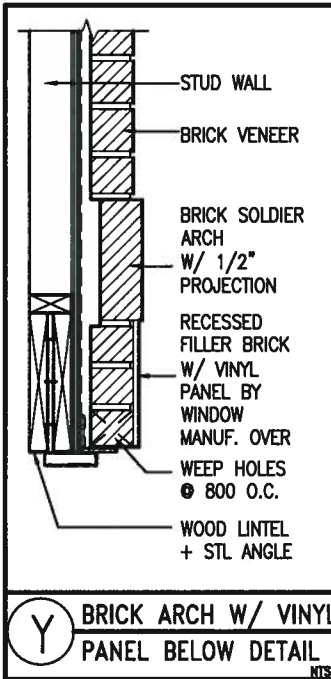

GROUND FLOOR PLAN 'B'  
CORNER UPGRADE-LOT 154

- ELECTRIC VEHICLE CHARGING SYSTEM (EVCS)**  
ROUGH-IN FOR FUTURE ELECTRIC VEHICLE SUPPLY EQUIPMENT (FOLLOWING SYSTEM TO BE INSTALLED)
- ELECTRIC VEHICLE CHARGING SYSTEM (EVCS)**  
ROUGH-IN FOR FUTURE ELECTRIC VEHICLE SUPPLY EQUIPMENT (FOLLOWING SYSTEM TO BE INSTALLED)
- ROUGH-IN INCLUDE:**
- A minimum 20' x 10' x 10' concrete pad size
  - Grounded metal rack, less than 1 1/16" (27mm)
  - Grounded electrical outlet box to be installed in the center of the pad
  - Grounded metal outlet box
  - Fumeproofed electrical outlet box to be installed
- REFER TO 2012 OBC 9.3.4.1

9				The undersigned has reviewed and takes responsibility for this design and has the qualifications and meets the requirements set out in the Ontario Building Code to be a Designer.
8	REFER TO 2012 OBC 9.3.4.1			
7				Wellington Jno-Baptiste 25591
6				name registration information
5				VA3 Design Inc. 42658
4				Contractor must verify all dimensions on the job and report any discrepancy to the Designer before proceeding with the work. All drawings and specifications are instruments of service and the property of the Designer which must be returned at the completion of the work. Drawings are not to be scaled.
3	REVISED AS PER ENG'S COMMENTS	JAN 03-18	RC	
2	REVISED AS PER FLOOR AND ROOF LAYOUTS	SEP 15-17	RC	
1	REVISED FOUNDATION WALL TO BE 10"	NOV 30/16	SB	
no.	description	date	by	

**VA3 DESIGN**  
255 Consumers Rd Suite 120  
Toronto ON M2J 1R4  
t 416.630.2255 f 416.630.4782  
va3design.com

**BAYVIEW WELLINGTON**  
**SD25-4**  
SONOMA 4 LOT 154  
project no. 16023

**GREEN VALLEY EAST**  
BRADFORD EAST, ON.  
drawing no. 2B

date SEPT. 2016  
drawn by NC  
checked by RC  
scale 3/16" = 1'-0"

COR. UPGRADE GRND. FLR. PLAN 'B'  
16023-SD25-4 COR LOT 154  
file name 16023-SD25-4 COR LOT 154.dwg - Wed - Jan 10 2018 - 12:21 PM



This is to certify that these plans comply with the applicable Architectural Design Guidelines approved by the Town of BRADFORD / WEST GWILLIMBURY.

~~JAN 15 2018~~

John G. Williams Limited, Architect

**NOTE: ROOF FRAMING**

**ALL LAMINATED VENEER  
LUMBER (LVL) BEAMS,  
BUILT-UP BEAMS, GIRDER  
TRUSSES AND METAL HANGER  
CONNECTIONS SUPPORTING  
ROOF FRAMING TO BE  
DESIGNED AND CERTIFIED BY  
ROOF TRUSS MANUFACTURER.  
REFER TO ROOF TRUSS SHOP  
DRAWINGS FOR ALL ROOF  
FRAMING INFORMATION UNLESS  
OTHERWISE NOTED ON  
ARCHITECTURAL DRAWINGS.**

**GRAB BAR NOTE**




STUD WALL  
REINFORCEMENT FOR  
FUTURE GRAB BARS IN  
MAIN BATHROOM

REINFORCEMENT OF STUD WALLS SHALL BE INSTALLED ADJACENT TO WATER CLOSETS AND SHOWER OR BATHTUB IN MAIN BATHROOM. REFER TO OBC. 9.5.2.3, 3.8.3.8.(3)(a), 3.8.3.8.(3)(c), 3.8.3.13.(2)(f) & 3.8.3.13.(4)(c). AND DETAILS PROVIDED.



JAN 11, 2018

OPT. SECOND FLR. W/  
ALT. ENSUITE LAYOUT

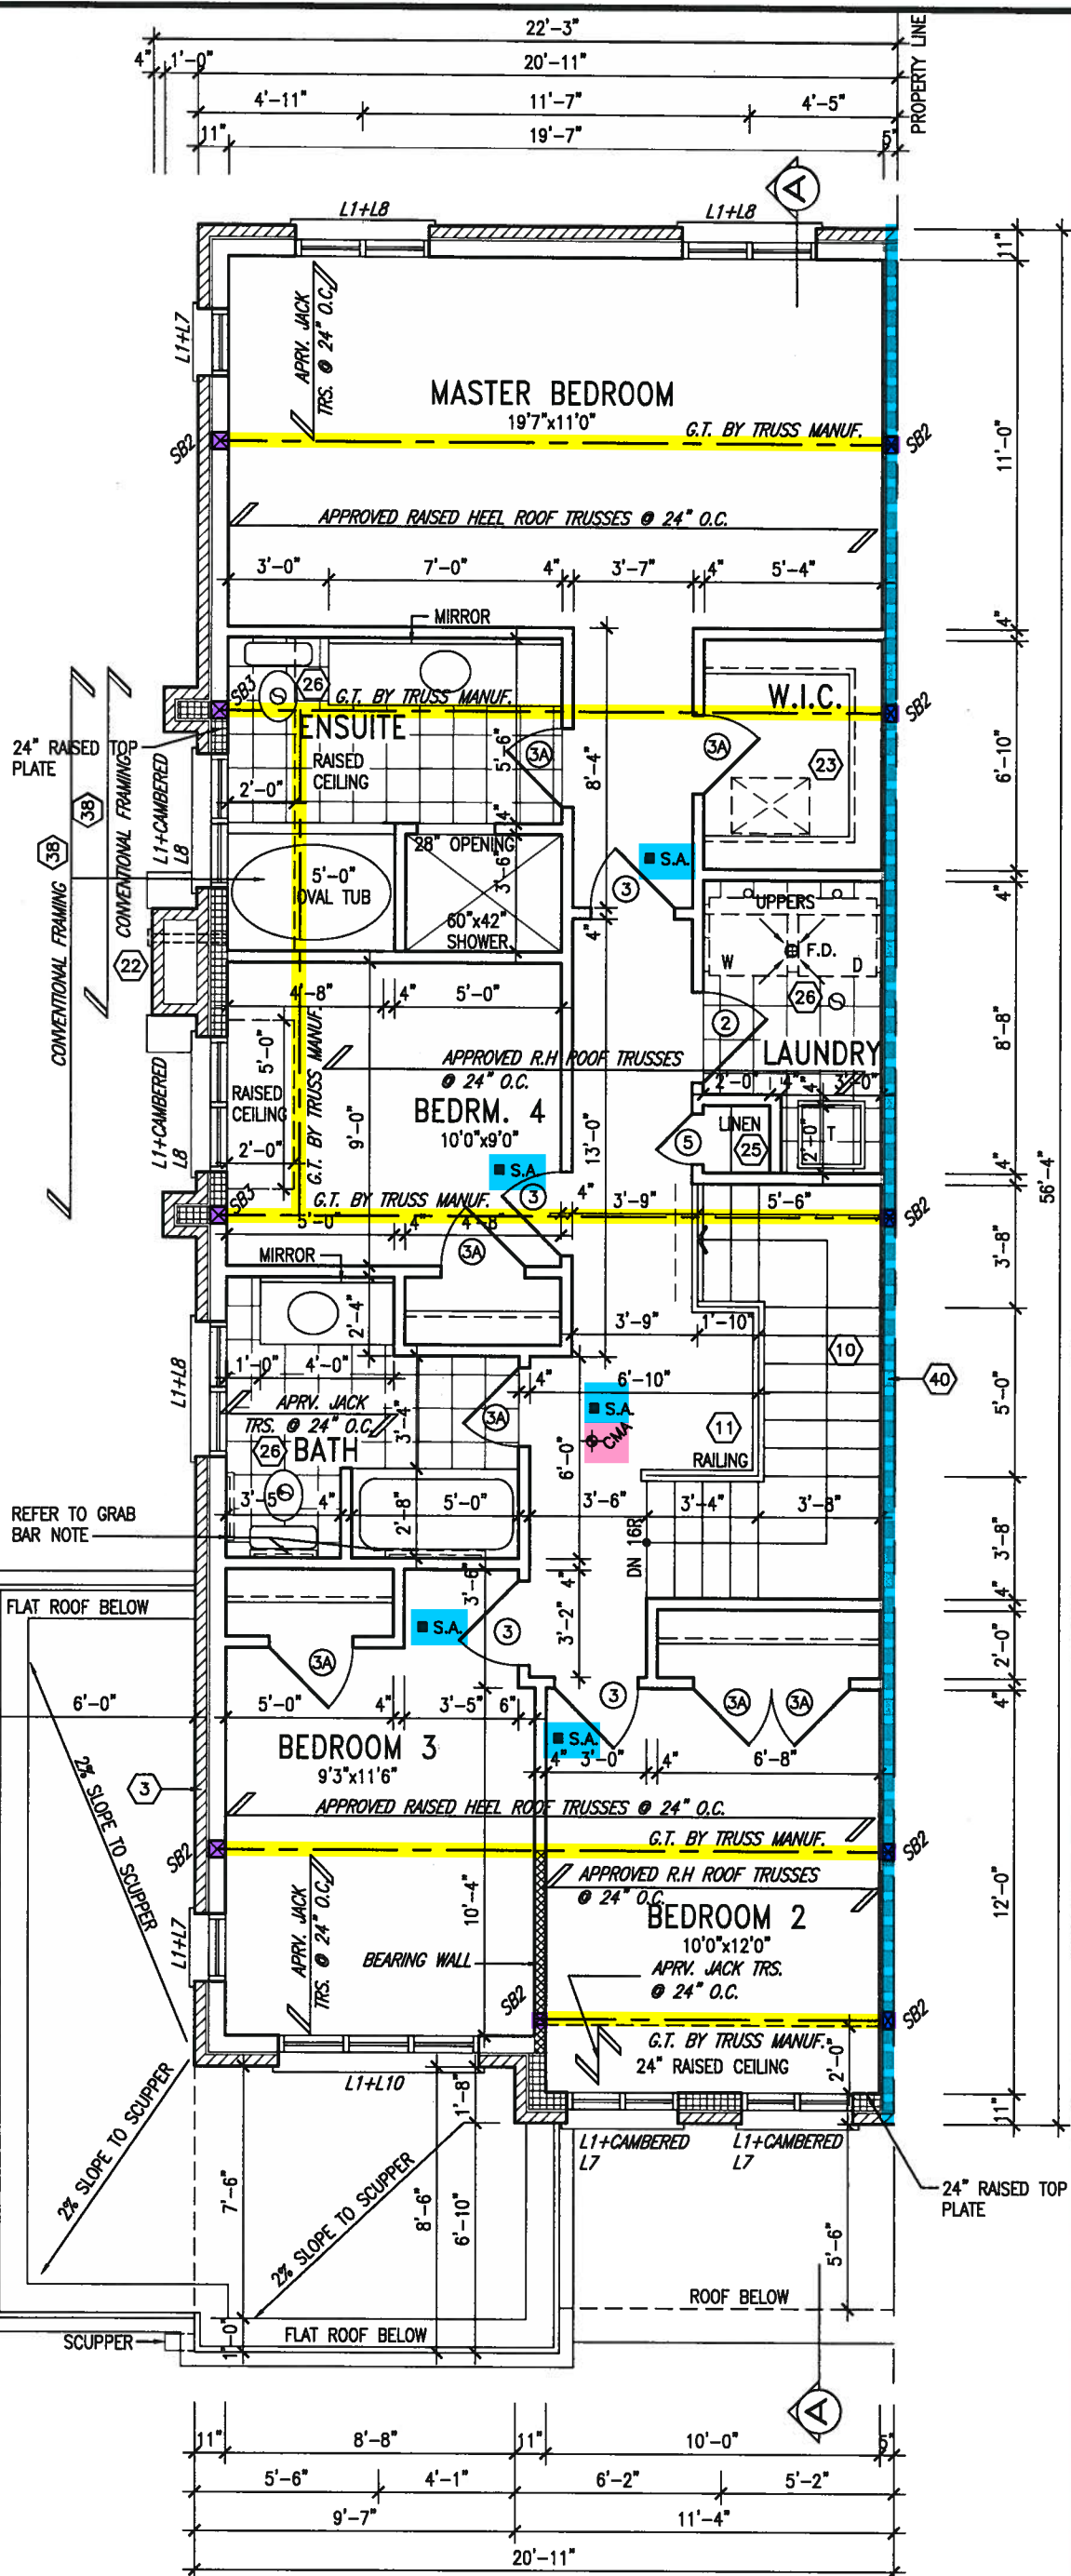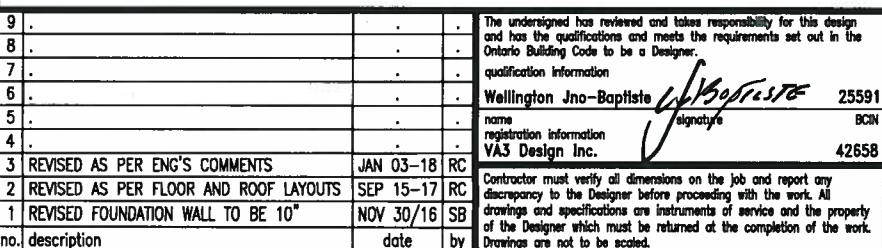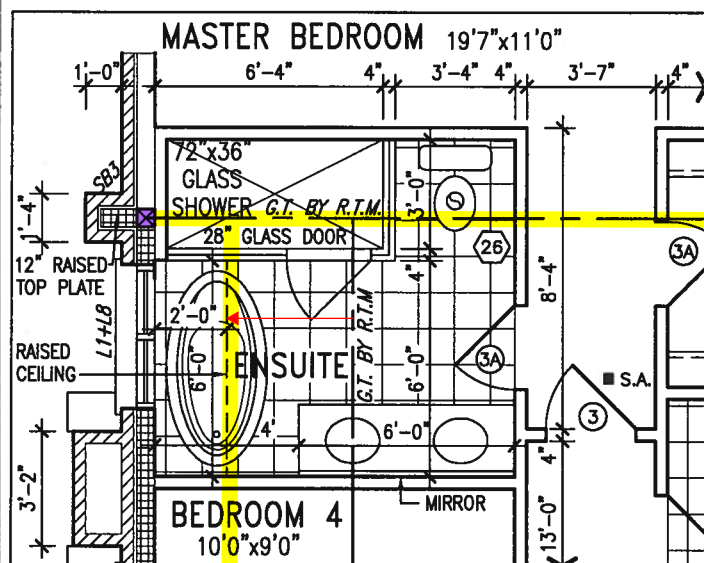

SECOND FLOOR PLAN 'B'  
CORNER UPGRADE—LOT 154

VA3  
DESIGN

255 Consumers Rd Suite 120  
Toronto ON M2J 1R4  
t 416.630.2255 f 416.630.4783  
va3design.com

## BAYVIEW WELLINGTON

project name  
**GREEN VALLEY EAST**

date  
SEPT. 2010drawn by  
NC

checked by  
RC

scale  
3/16" = 1'-0"

**COR. UPGRADE 2ND FLR. PLAN 'B'**

$$= 1'-0''$$

16023-SD25-4 COR LOT 1

SD25-4

SONOMA 4 LOT 154

project no.

16023

drawing no.

70

5B

00

All drawings specifications, related documents and design are the copyright property of VA3 DESIGN. Reproduction of this property in whole or in part is strictly prohibited without VA3 DESIGN's written permission.



This is to certify that these plans comply with the applicable Architectural Design Guidelines approved by the Town of BRADFORD / WEST GWILLIMBURY.




JAN 11, 2018

~~ARCHITECTURAL REVIEW & APPROVAL~~

~~JAN 15 2018~~

John B. Williams Limited, Architect

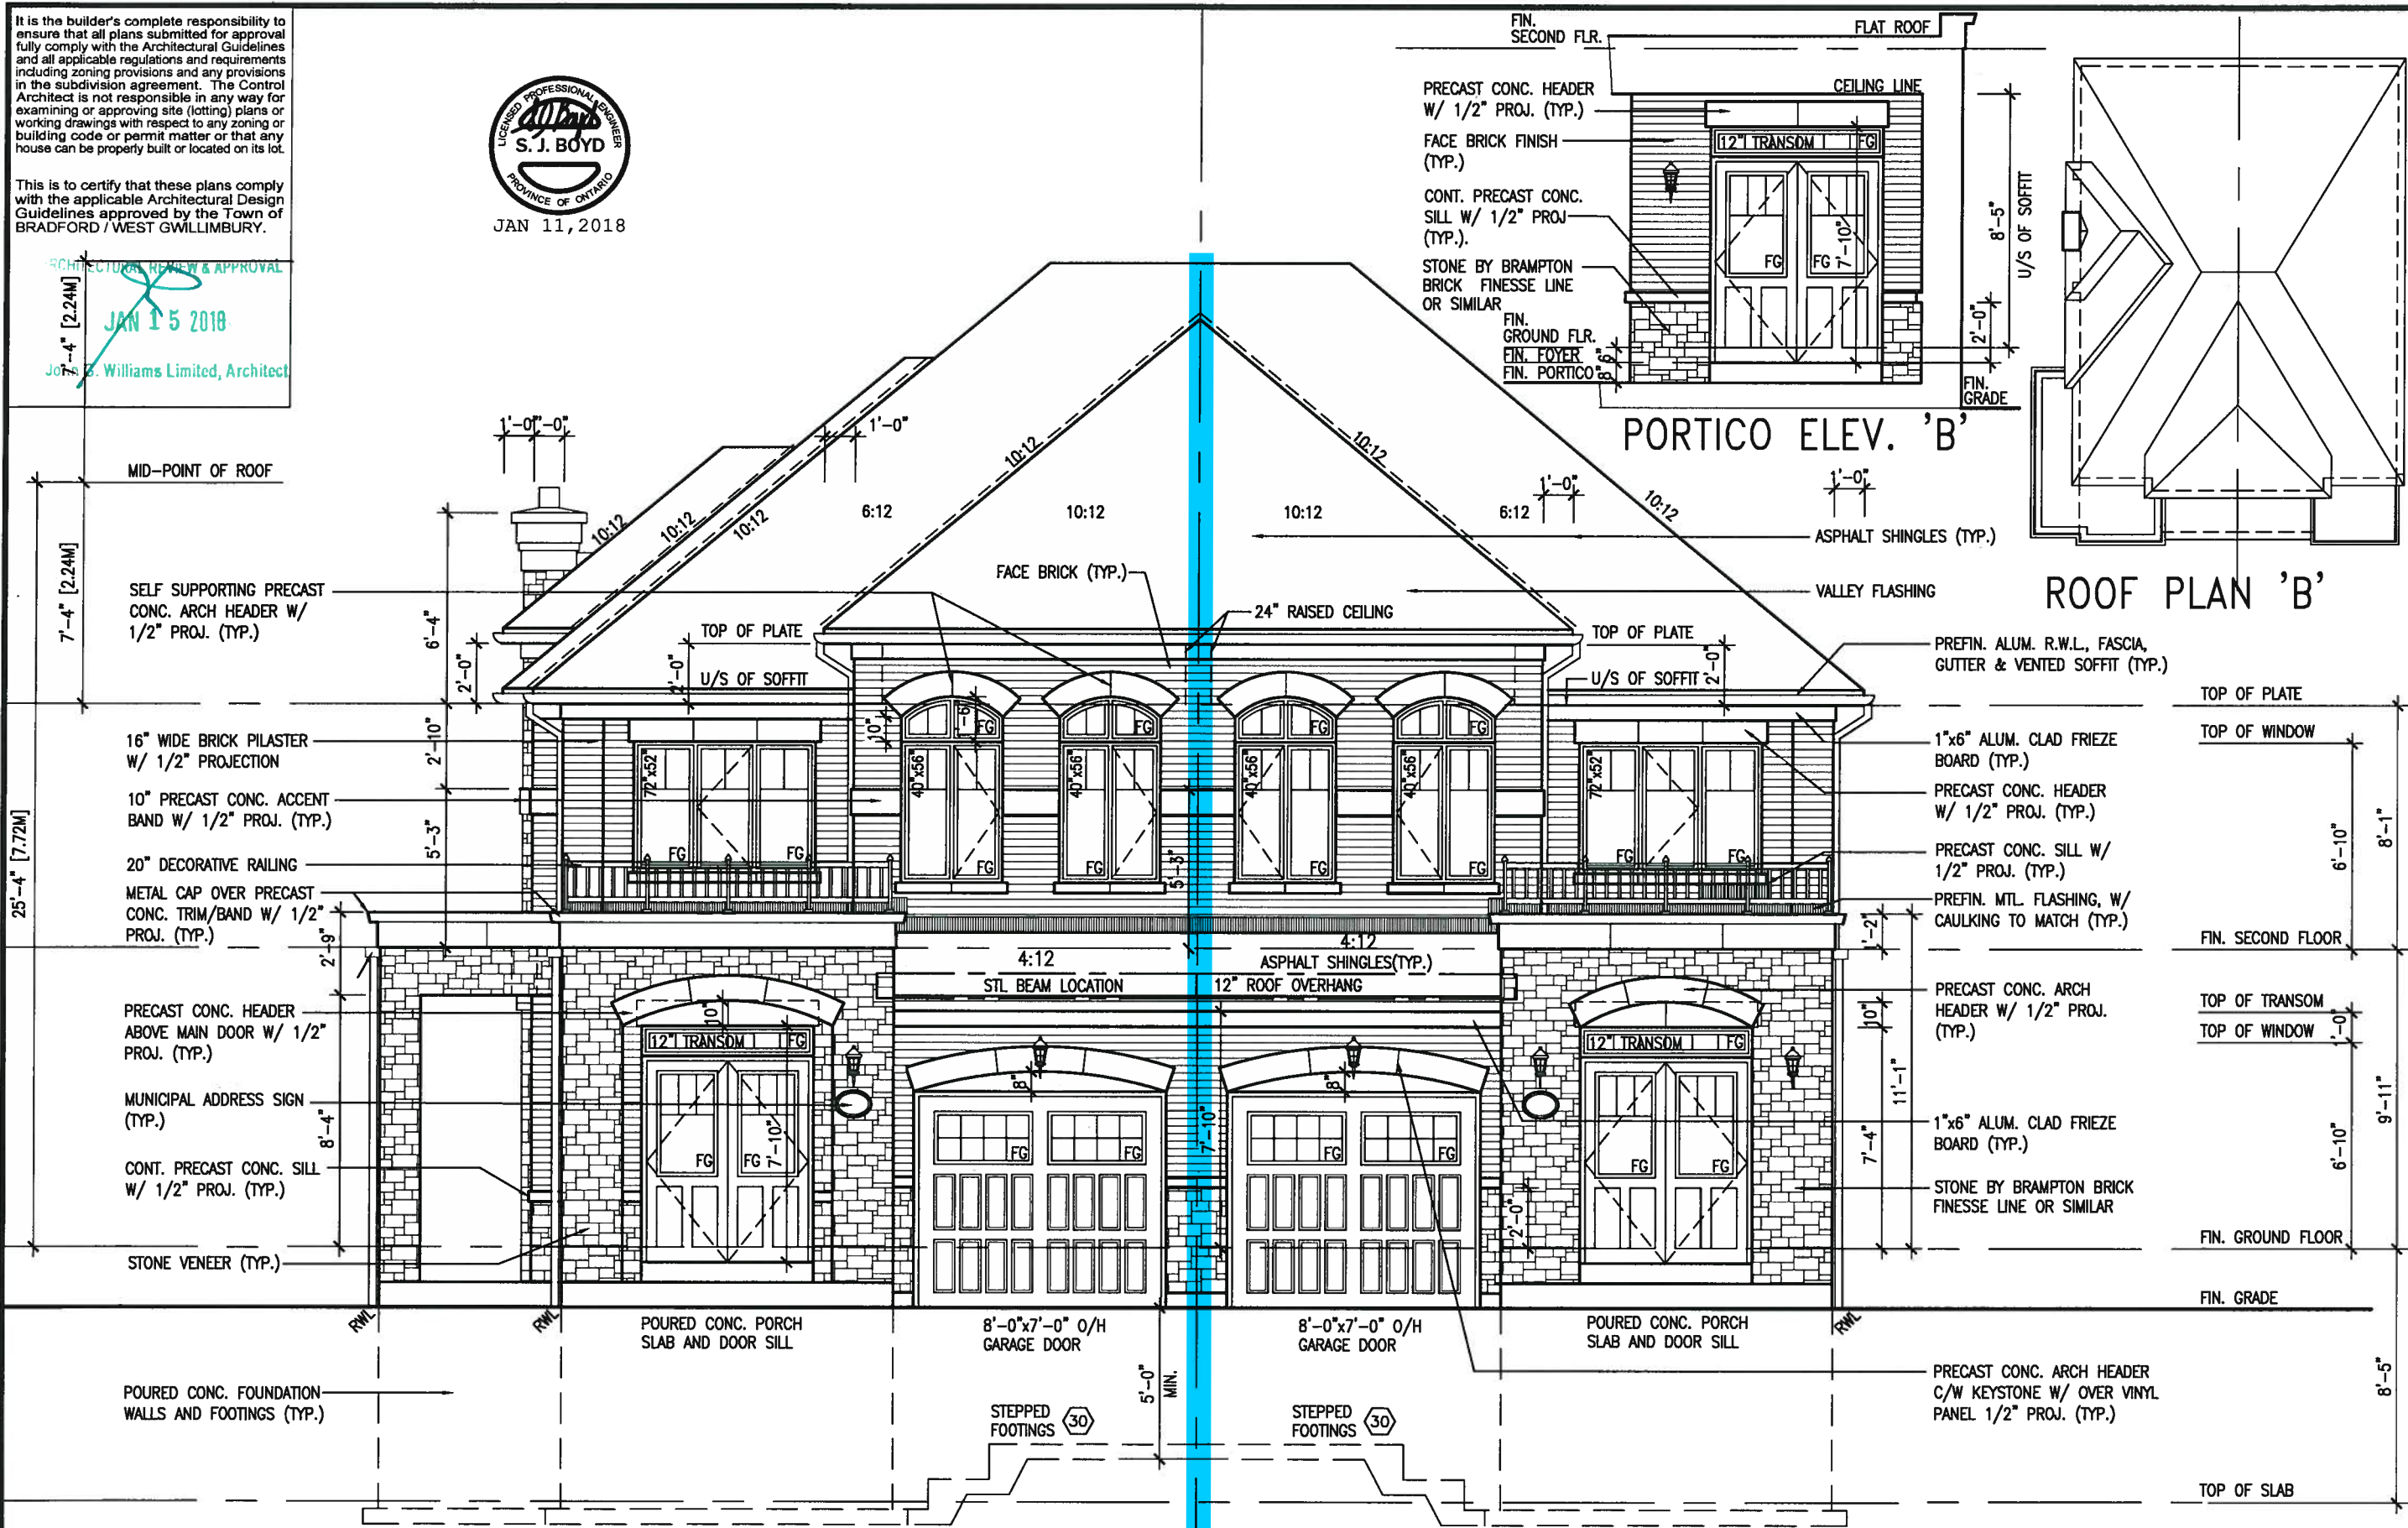

FRONT ELEVATION 'B'  
CORNER UPGRADE—LOT 154

FRONT ELEVATION 'B' (REV.)  
SD-4

# SITE COPY

<p><b>BAYVIEW WELLINGTON</b></p>	<p><b>SD25-4</b></p> <p><b>SONOMA 4 LOT 154</b></p>
<p><b>GREEN VALLEY EAST</b></p>	<p><b>BRADFORD EAST, ON.</b></p>
<p>project name</p> <p>DATE: SEPT. 2016</p> <p>drawn by</p> <p>scale</p> <p>checked by</p> <p>RC</p> <p>3/16" = 1'-0"</p> <p>NC</p>	<p>municipality</p> <p>project no.</p> <p>16023</p> <p>drawing no.</p> <p><b>FRONT ELEVATION 'B'</b></p> <p>16023-SD25-4 COR LOT 154</p> <p>16023-SD25-4 COR LOT 154.dwg - Wed - Sep 10 2016 - 09:21 AM</p> <p>16023-SD25-4 COR LOT 154.dwg - Wed - Sep 10 2016 - 09:21 AM</p>



The undersigned has reviewed and takes responsibility for this design and the information contained herein. The design meets the requirements set out in the Ontario Building Code to be a Designer.

qualification information

name *John Boppre* *Boppre* 255911 BCIN 426558  
registration information  
VA3 Design Inc. *signature*

Contractor must verify all dimensions on the job and report any deviations and modifications are instruments of service and the property of the Designer which must be returned at the completion of the work. Drawings are not to be copied.

[illegible]





姓名	性别	年龄	职业	住址	联系电话	电子邮箱

# SITE COPY






JAN 11, 2018

1'-0"

1'-0" 1'-0"

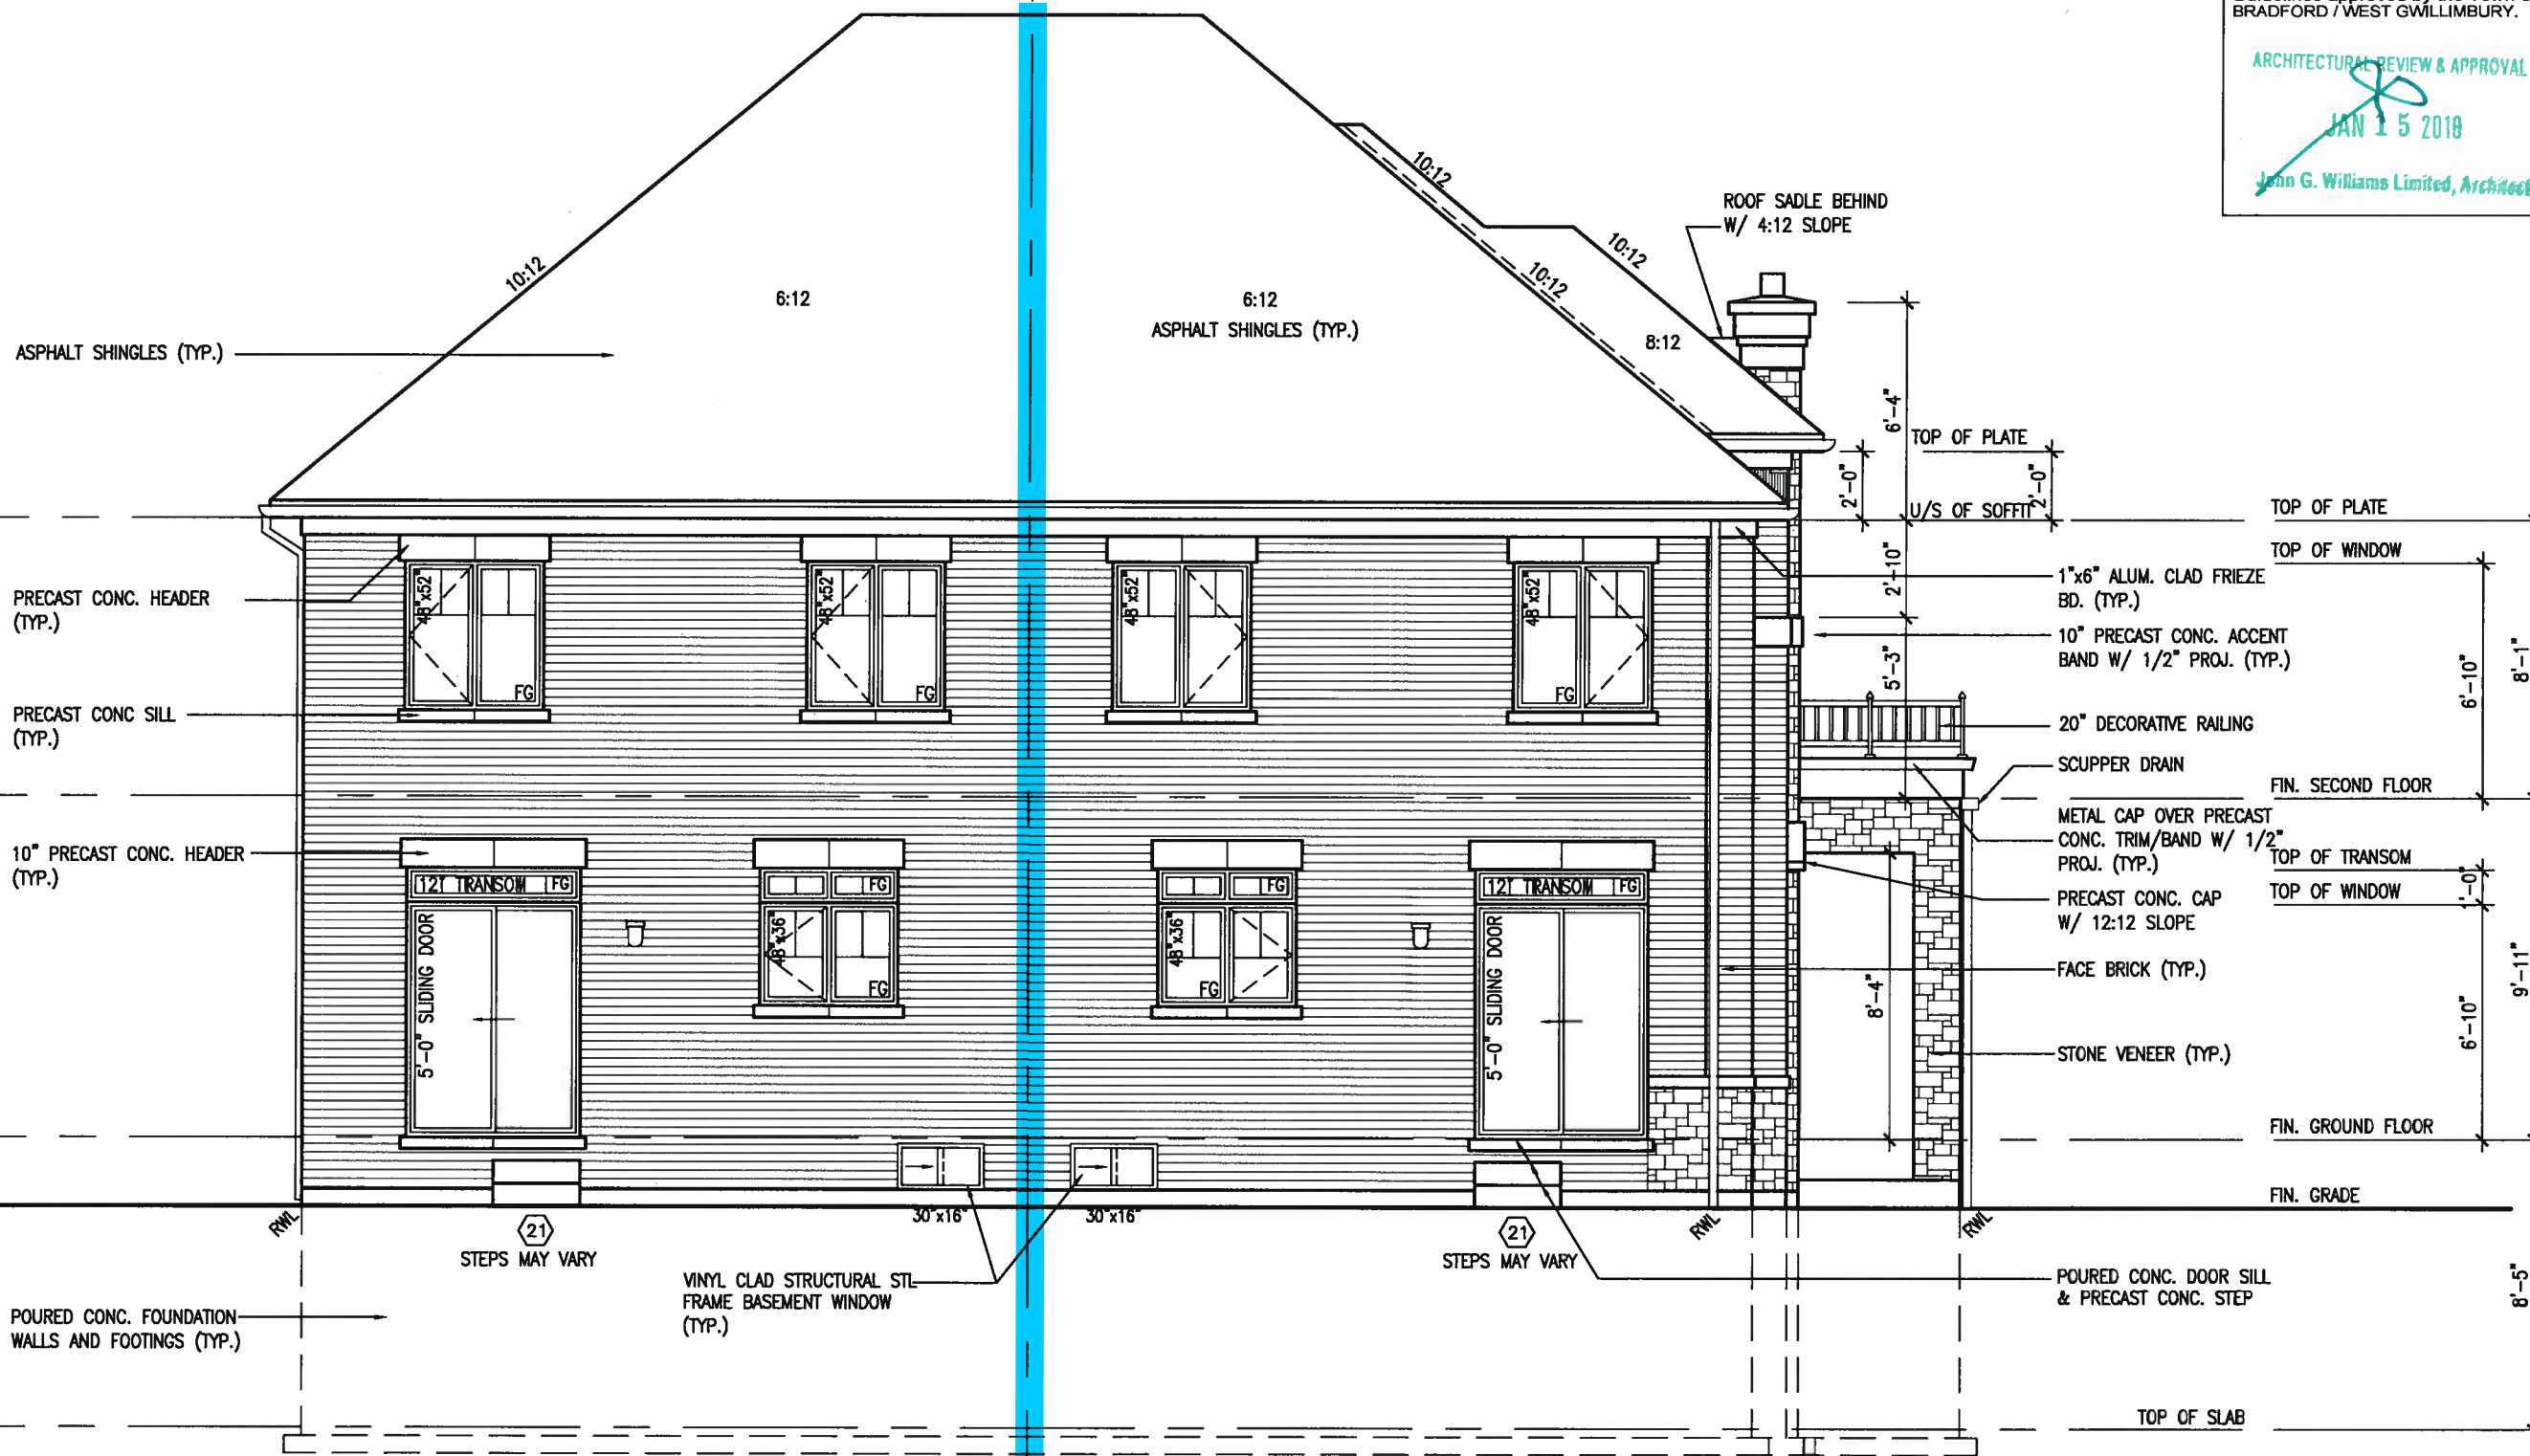

It is the builder's complete responsibility to ensure that all plans submitted for approval fully comply with the Architectural Guidelines and all applicable regulations and requirements including zoning provisions and any provisions in the subdivision agreement. The Control Architect is not responsible in any way for examining or approving site (lotting) plans or working drawings with respect to any zoning or building code or permit matter or that any house can be properly built or located on its lot.

This is to certify that these plans comply with the applicable Architectural Design Guidelines approved by the Town of BRADFORD / WEST GWILLIMBURY.

ARCHITECTURAL REVIEW & APPROVAL  
JAN 15 2018  
John G. Williams Limited, Architect

SD25-4		SONOMA 4 LOT 154		16023	
BAYVIEW WELLINGTON		BRADFORD EAST, ON.		16023	
GREEN VALLEY EAST		BRADFORD EAST, ON.		16023	
REAR ELEVATION 'B'		REAR ELEVATION 'B'		7B	
255 Consumers Rd Suite 120		Toronto ON M2J 1K4		16023-SD25-4 COR LOT 154	
t 416.630.2255 f 416.630.4782		vo3design.com		16023-SD25-4 COR LOT 154	
The undersigned has reviewed and takes responsibility for this design and has the qualifications and meets the requirements set out in the Ontario Building Code to be a Designer.		Wellington, Jno-Baptiste		25591	
qualification information		name		BCON	
Wellington, Jno-Baptiste		signature		42658	
VA3 Design Inc.		registration information		BCON	
Contractor must verify all dimensions on the job and report any discrepancy. If specifications are not provided, the property of the Designer which must be returned at the completion of the work. Drawings are not to be scaled.		no. description		date	
3		REVISED AS PER ENG'S COMMENTS		JAN 03-18 RC	
2		REVISED AS PER FLOOR AND ROOF LAYOUTS		SEP 15-17 RC	
1		REVISED FOUNDATION WALL TO BE 10"		NOV 30/16 SD	

REAR ELEVATION 'B' (REV.)  
SD-4

REAR ELEVATION 'B'  
CORNER UPGRADE-LOT 154

SITE COPY

It is the builder's complete responsibility to ensure that all plans submitted for approval fully comply with the Architectural Guidelines and all applicable regulations and requirements including zoning provisions and any provisions in the subdivision agreement. The Control Architect is not responsible in any way for examining or approving site (lotting) plans or working drawings with respect to any zoning or building code or permit matter or that any house can be properly built or located on its lot.

This is to certify that these plans comply with the applicable Architectural Design Guidelines approved by the Town of Bradford / West Gwillimbury.

ARCHITECTURAL REVIEW & APPROVAL

JAN 15 2018

John G. Williams Limited, Architect

6"x6" P.T. WOOD POST C/W GALV. METAL CAP AND METAL SHOE SET INTO 12" DIA. SONO TUBES TO EXTEND 6" ABOVE GRADE AND 5'-0" BELOW GRADE.

2-2"x8" P.T. DROPPED LEDGER FASTENED TO 2"x6" BLOCKING BETWEEN STUDS W/ 1/2" DIA. BOLTS @ 16" O.C. REFER TO DETAIL 1/S2


FOR 4-BR COND.

2-2"x8" P.T. DROPPED LEDGER FASTENED TO FDN WALL W/ 1/2" DIA. x12" LONG HILTI ADHESIVE ANCHORS @ 16" O.C. REFER TO DETAIL 1/S2

REAR WALL ONLY 2"x6" STUDS @ 16" O.C. ON 10" FDN. WALL FOR BACKFILL HEIGHT < 4'-7" OTHERWISE PROVIDE 6" CONC. SHELF ON 10" FDN. WALL ON 22"x6" THICK CONC. FOOTING UNLESS NOTED OTHERWISE

VINYL CLAD STRUCTURAL STL. FRAME BASEMENT WINDOW (TYP.)


10" FULL HEIGHT CONC. ON SIDE WALL W/ BRICK CHECK AS REQUIRED ON 22"x6" THICK CONC. FTG.

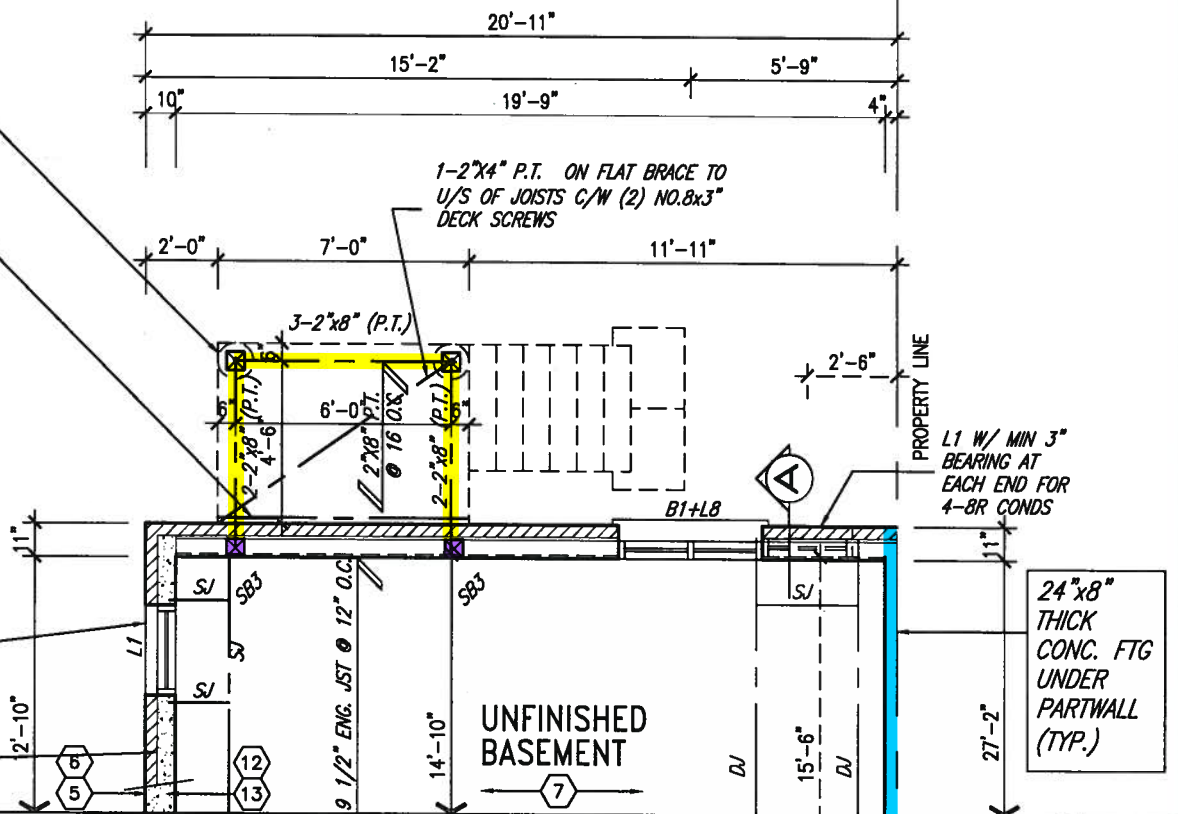

PARTIAL BASEMENT PLAN 'B'  
WOD 9R COND



JAN 11, 2018

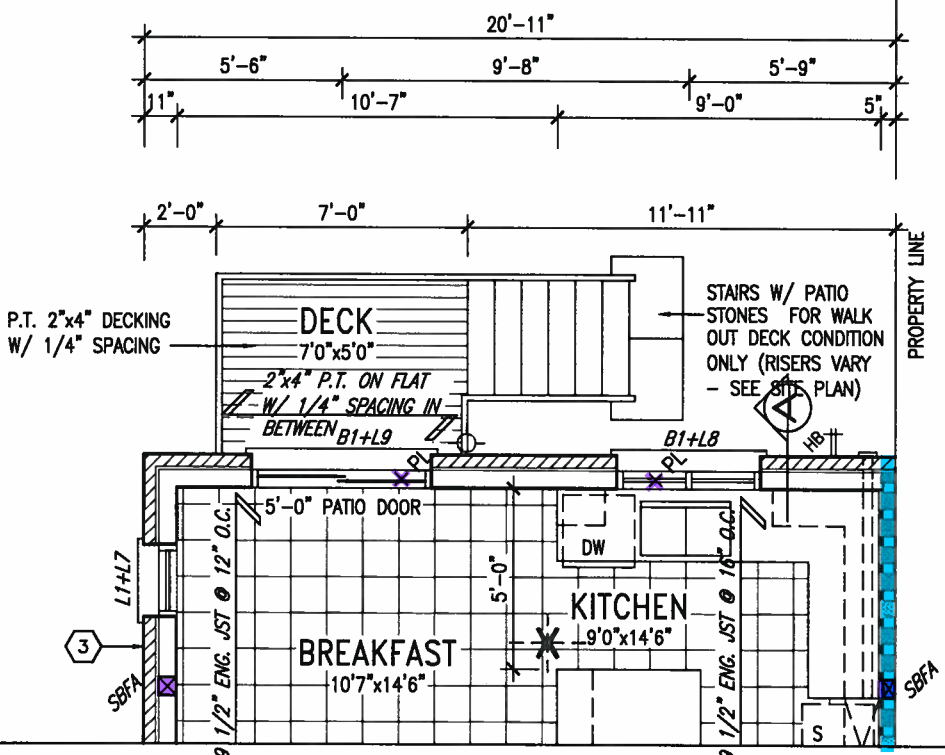

PARTIAL GROUND FLOOR PLAN 'B'  
WOD 9R COND

NOTE: SPACE ALL FLOOR JOISTS @ 12" O.C. UNDER ALL CERAMIC TILE AREAS.

NOTE: ALL LVL'S SUPPORTING FLOOR LOADS ARE TO BE SPECIFIED BY FLOOR TRUSS MANUFACTURER.

NOTE: FLOOR FRAMING INFO REFER TO SHOP DRAWINGS FOR ALL TRUSS-JOIST INFORMATION AND DETAILS. UNLESS OTHERWISE NOTED.

NOTE J1: PROVIDE SOLID BLOCKING @ 24" O.C. WHERE FLOOR JOISTS ARE PARALLEL TO FOUNDATION WALL (TYP.)

UNINSULATED OPENINGS (PER OBC. SB-12,3.1.1(7))				UNINSULATED OPENINGS (PER OBC. SB-12,3.1.1(7))			
SD25-4 COR LOT 154 ELEV B WOD	ENERGY EFFICIENCY - OBC SB12			SD25-4 COR LOT 154 ELEV B WOD	ENERGY EFFICIENCY - OBC SB12		
ELEVATION	WALL AREA S.F.	OPENING S.F.	PERCENTAGE	ELEVATION	WALL AREA S.F.	OPENING S.F.	PERCENTAGE
FRONT	458 S.F.	110.111 S.F.	24.04 %	FRONT	458 S.F.	110.111 S.F.	24.04 %
LEFT SIDE	1140 S.F.	163 S.F.	14.30 %	LEFT SIDE	1140 S.F.	163 S.F.	14.30 %
RIGHT SIDE	1140 S.F.	0 S.F.	0.00 %	RIGHT SIDE	1140 S.F.	0 S.F.	0.00 %
REAR 4-BR WOD COND	526 S.F.	94.833 S.F.	18.03 %	REAR 9R AND MORE WOD COND	526 S.F.	103.167 S.F.	19.61 %
* OPENINGS OMITTED AS PER SB-12 3.1.1.9(4) MAX 19.9 S.F. REFER TO ELEVATION FOR LOCATION				* OPENINGS OMITTED AS PER SB-12 3.1.1.9(4) MAX 19.9 S.F. REFER TO ELEVATION FOR LOCATION			
TOTAL SQ. FT.	3264.00 S.F.	367.94 S.F.	11.27 %	TOTAL SQ. FT.	3264.00 S.F.	376.28 S.F.	11.53 %
TOTAL SQ. M.	303.23 S.M.	34.18 S.M.	11.27 %	TOTAL SQ. M.	303.23 S.M.	34.96 S.M.	11.53 %

9.			The undersigned has reviewed and takes responsibility for this design and has the qualifications and meets the requirements set out in the Ontario Building Code to be a Designer.
8.			qualification information
7.			Wellington Jno-Baptiste 25591
6.			name
5.			registration information
4.			VA3 Design Inc. 42658
3.	REVISED AS PER ENG'S COMMENTS	JAN 03-18	RC
2.	REVISED AS PER FLOOR AND ROOF LAYOUTS	SEP 15-17	RC
1.	REVISED FOUNDATION WALL TO BE 10"	NOV 30/16	SB
no.	description	date	by

**VA3 DESIGN**  
255 Consumers Rd Suite 120  
Toronto ON M2J 1R4  
t 416.630.2255 f 416.630.4782  
va3design.com

**BAYVIEW WELLINGTON**  
**SITE COPY**  
project name GREEN VALLEY EAST  
municipality BRADFORD EAST, ON.

**SD25-4**  
SONOMA 4 LOT 154  
project no. 16023  
drawing no. 9B

date SEPT. 2016  
drawn by NC  
checked by RC  
scale 3/16" = 1'-0"  
PARTIAL PLAN WOD COND  
16023-SD25-4 COR LOT 154  
file name 16023-SD25-4 COR LOT 154.dwg  
Wed - Jan 10 2018 - 12:22 PM




It is the builder's complete responsibility to ensure that all plans submitted for approval fully comply with the Architectural Guidelines and all applicable regulations and requirements including zoning provisions and any provisions in the subdivision agreement. The Control Architect is not responsible in any way for examining or approving site (lotting) plans or working drawings with respect to any zoning or building code or permit matter or that any house can be properly built or located on its lot.

This is to certify that these plans comply with the applicable Architectural Design Guidelines approved by the Town of BRADFORD / WEST GWILLIMBURY.



1'-0"

1'-0"

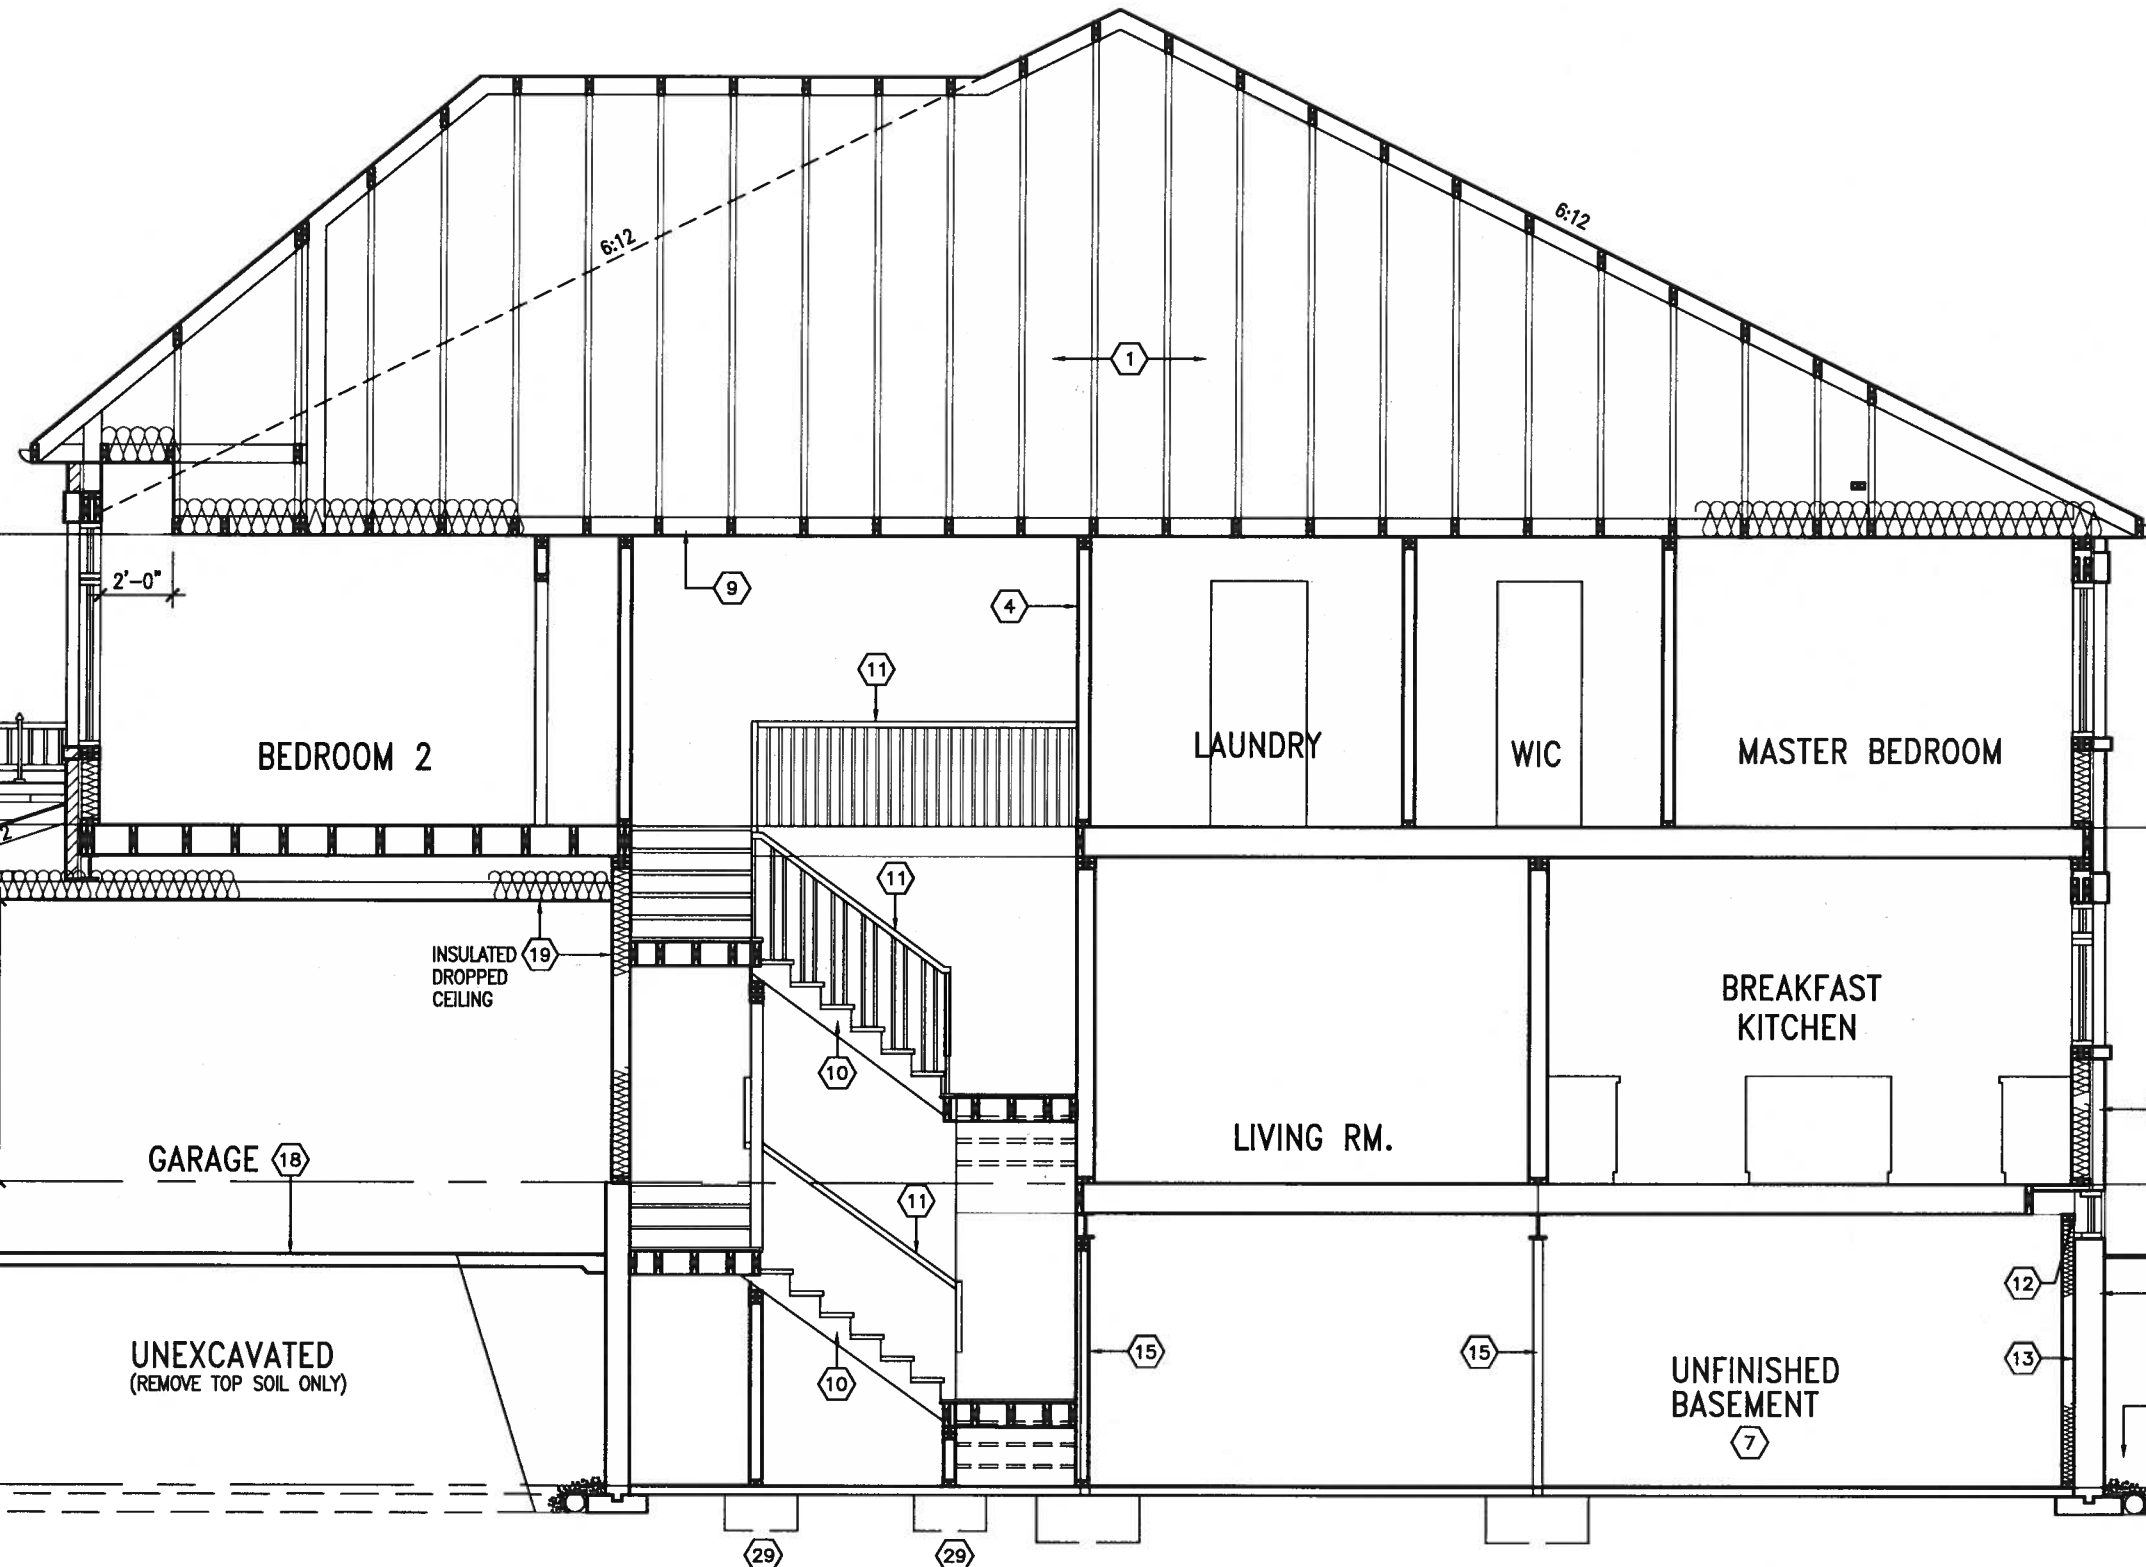

TOP OF PLATE  
TOP OF WINDOW  
FIN. SECOND FLOOR  
TOP OF TRANSOM  
TOP OF WINDOW  
FIN. GROUND FLOOR  
FIN. GRADE  
TOP OF SLAB

6'-10"  
8'-1"  
6'-10"  
9'-11"  
8'-5"

**SITE COPY**

SECTION A-A  
CORNER UPGRADE- LOT 154

<b>BAYVIEW WELLINGTON</b>		<b>SD25-4</b>	
GREEN VALLEY EAST		SONOMA 4 LOT 154	
BRADFORD EAST, ON.		16023	
project name		drawing no.	
SECTION A-A		8B	
date		file name	
SEPT. 20-16		16023-SD25-4 COR LOT 154	
drawn by		checked by	
NC		RC	
scale		3/16" = 1'-0"	
RECORD - 14 VARDINE WORKING 2016 \16023-SD25-4 COR LOT 154.dwg - Wed - Jun 10 2016 - 12:22 PM		REPRODUCTION OF THIS PROPERTY IN WHOLE OR IN PART IS STRICTLY PROHIBITED WITHOUT VAS DESIGN'S WRITTEN PERMISSION.	

The undersigned has reviewed and takes responsibility for this design and has the qualifications and meets the requirements set out in the Ontario Building Code to be a Designer.

qualification information  
Wellington Jno-Baptiste 25591 BCN  
VA3 Design Inc. 42658

Contractor must verify all dimensions on the job and report any discrepancy to the Designer before proceeding with the work. All dimensions are given in feet and inches. The Designer's responsibility is to provide a design that meets the requirements of the Ontario Building Code and the requirements of the property owner. Drawings are not to be scaled.

no.	description	date	by
3	REVISED AS PER ENG'S COMMENTS	JAN 03-18 RC	
2	REVISED AS PER FLOOR AND ROOF LAYOUTS	SEP 15-17 RC	
1	REVISED FOUNDATION WALL TO BE 10"	NOV 30/16 SB	

1'-0"

1'-0"



It is the builder's complete responsibility to ensure that all plans submitted for approval fully comply with the Architectural Guidelines and all applicable regulations and requirements including zoning provisions and any provisions in the subdivision agreement. The Control Architect is not responsible in any way for examining or approving site (lotting) plans or working drawings with respect to any zoning or building code or permit matter or that any house can be properly built or located on its lot.

This is to certify that these plans comply with the applicable Architectural Design Guidelines approved by the Town of BRADFORD / WEST GWILLIMBURY.

ARCHITECTURAL REVIEW & APPROVAL  
JAN 15 2018  
John G. Williams Limited, Architect

ASPHALT SHINGLES (TYP.)

ASPHALT SHINGLES (TYP.)

ROOF SADDLE BEHIND W/ 4:12 SLOPE

PRECAST CONC. HEADER (TYP.)

PRECAST CONC. SILL (TYP.)

10" PRECAST CONC. HEADER (TYP.)

36" HIGH WOOD RAILING (42" HIGH GUARD WHEN DECK IS MORE THAN 5'-11" ABOVE GRADE)

6"x6" P.T. POST ON 12" DIA. CONC. SONO TUBE

POURED CONC. FOUNDATION WALLS AND FOOTINGS (TYP.)

6'-4"  
2'-0"  
2'-10"  
TOP OF PLATE  
U/S OF SOFFIT  
TOP OF WINDOW

1"x6" ALUM. CLAD FRIEZE BD. (TYP.)  
10" PRECAST CONC. ACCENT BAND W/ 1/2" PROJ. (TYP.)

20" DECORATIVE RAILING  
SCUPPER DRAIN

METAL CAP OVER PRECAST CONC. TRIM/BAND W/ 1/2" PROJ. (TYP.)

PRECAST CONC. CAP W/ 12:12 SLOPE  
FACE BRICK (TYP.)

STONE VENEER (TYP.)

TOP OF PLATE  
TOP OF WINDOW

FIN. SECOND FLOOR

TOP OF TRANSOM  
TOP OF WINDOW

FIN. GROUND FLOOR

FIN. GRADE  
TOP OF WINDOW

TOP OF SLAB

REAR ELEVATION B (REV.)  
9R OR MORE -W.O.D. COND.


BASEMENT WINDOW SIZES  
4R-8R USE 30"x24" VINYL CLAD STRUCTURAL STEEL FRAME BASEMENT WINDOWS

REAR ELEVATION B  
CORNER UPGRADE-LOT 154  
9R OR MORE -W.O.D. COND.

**SITE COPY**

<b>BAYVIEW WELLINGTON</b>		<b>SD25-4</b>	
GREEN VALLEY EAST		SONOMA 4 LOT 154	
BRADFORD EAST, ON.		16023	
Municipality		Project no.	
BRADFORD EAST, ON.		16023	
REAR ELEVATION 'B'		WOD COND	
checked by		drawing no.	
RC		10B	
drawn by		file name	
NC		16023-SD25-4 COR LOT 154	
date		scale	
SEPT. 2016		3/16" = 1'-0"	
drawn by		date	
NC		JAN 10 2018 - 12:22 PM	
checked by		date	
RC		JAN 10 2018 - 12:22 PM	
drawn by		date	
NC		JAN 10 2018 - 12:22 PM	
checked by		date	
RC		JAN 10 2018 - 12:22 PM	
drawn by		date	
NC		JAN 10 2018 -	




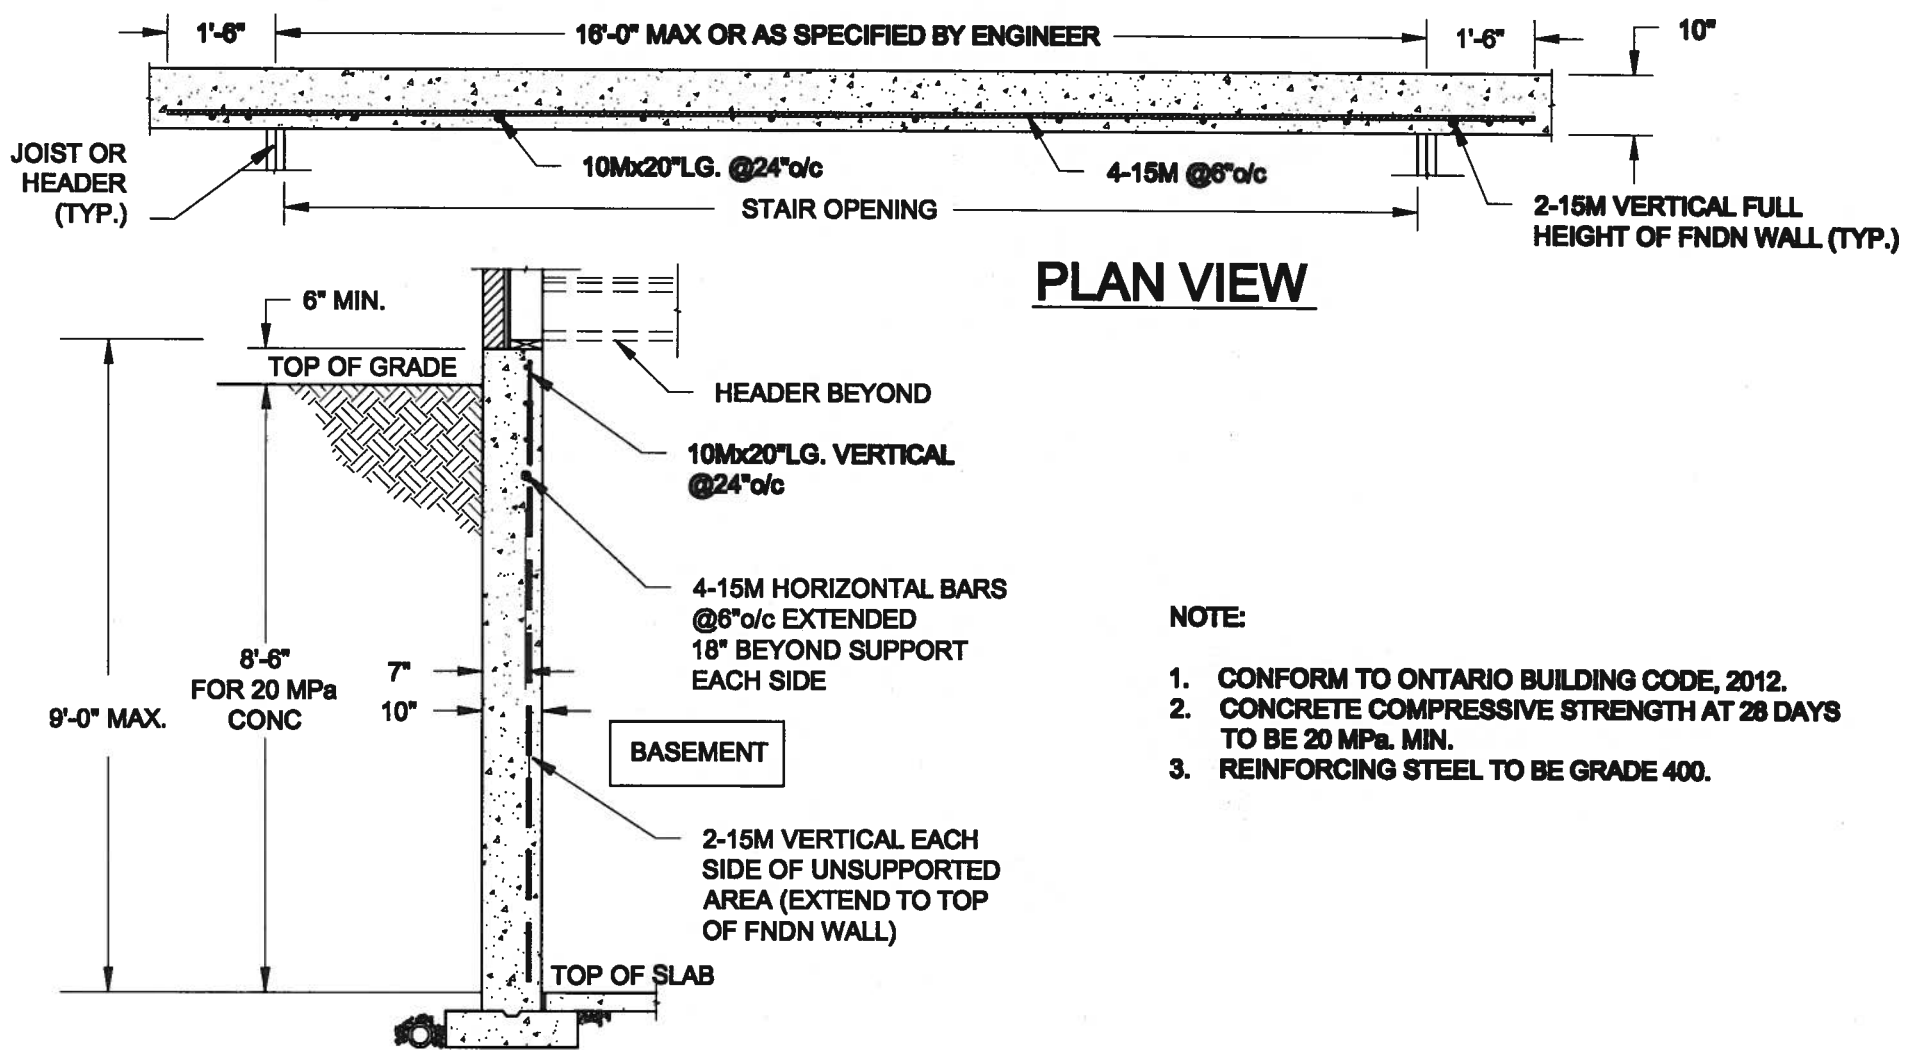


**NOTE:**

1. CONFORM TO ONTARIO BUILDING CODE, 2012.
2. CONCRETE COMPRESSIVE STRENGTH AT 28 DAYS TO BE 20 MPa. MIN.
3. REINFORCING STEEL TO BE GRADE 400.

**1**  
**S1** **LATERALLY UNSUPPORTED WALL**  
SCALE: 3/8" = 1'-0"

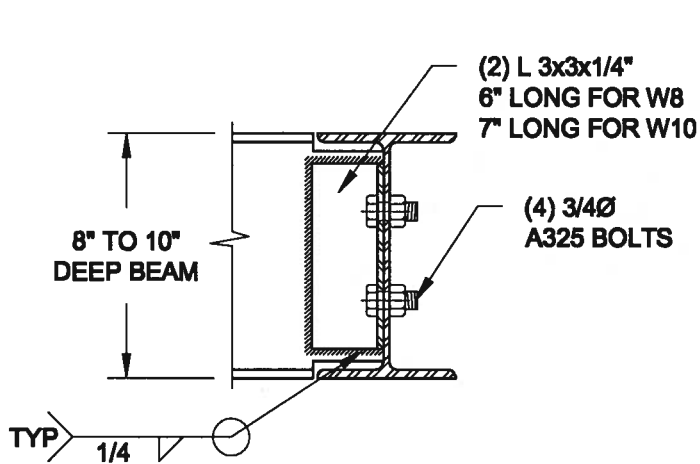

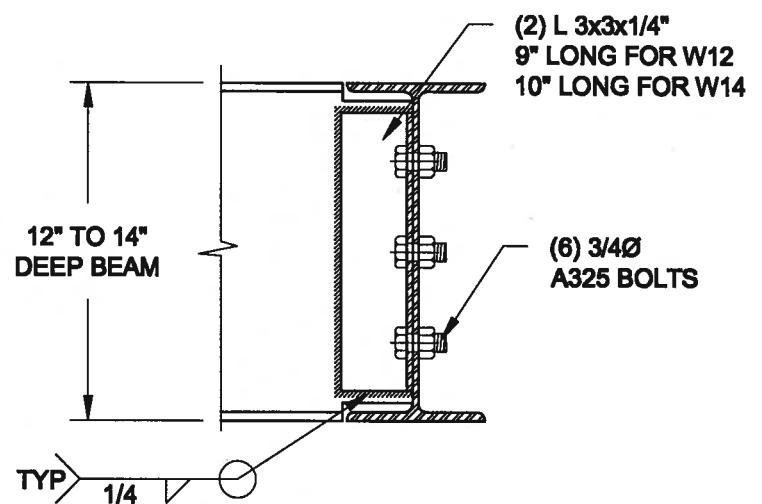


NOTE: DETAIL IS APPLICABLE TO W8x40 (W200x59) BEAM MAX AND W10x39 (W250x58) BEAM MAX.





NOTE: DETAIL IS APPLICABLE TO W12x58 (W310x88) BEAM MAX AND W14x48 (W360x72) BEAM MAX.

**2**  
**S2** **STEEL BEAM CONNECTION DETAIL**  
SCALE: 1-1/2" = 1'-0"

Scale: AS NOTED		<div>QUAILE ENGINEERING LTD.</div> <div></div> <div>38 Parkside Drive, UNIT 7 Newmarket, ON L3Y 8J9 T: 905-853-8547 E: quaile.eng@rogers.com</div>	Engineer's Seal: <div></div> <div>JAN 11, 2018</div>		Project: <div>BAYVIEW WELLINGTON HOMES - GREEN VALLEY DRIVES - SERIES</div> <div>BRADFORD, ONTARIO</div> <div>TYPICAL STRUCTURAL DETAILS</div>	
Date: JAN-08-2018			<div>SITE COPY</div>			
Drawn: SC	Checked: SJB					
Project No.: 17-194						

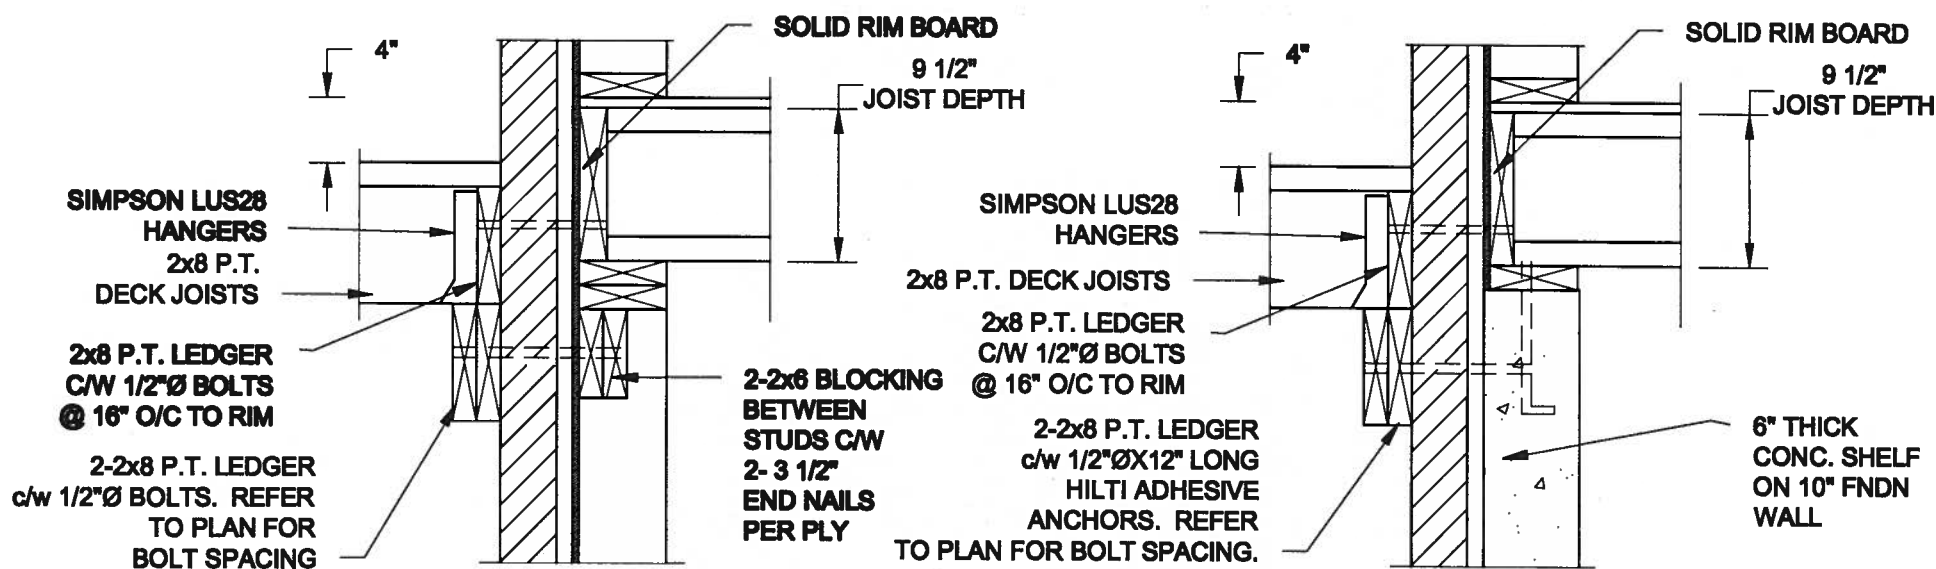

- NOTE: 1. WHERE BACKFILL HEIGHT < 4'-7", PROVIDE 2x6 @ 16" o/c KNEEWALL ON 10" THICK CONC FNDN WALL  
2. WHERE BACKFILL HEIGHT > 4'-7", PROVIDE 6" CONC SHELF FOR BRICK VENEER ON 10" THICK CONC FNDN WALL  
3. FOOTING TO BE 22"x6" THICK UNLESS NOTED OTHERWISE ON PLAN.

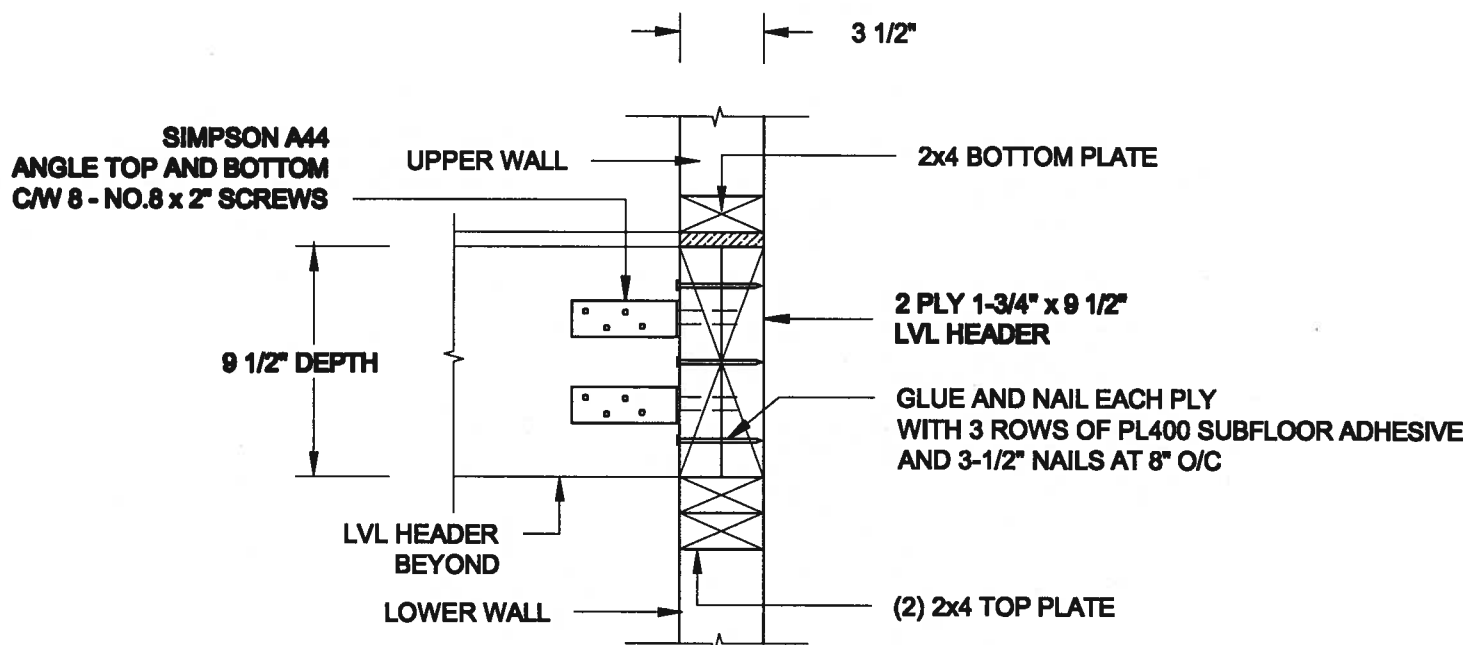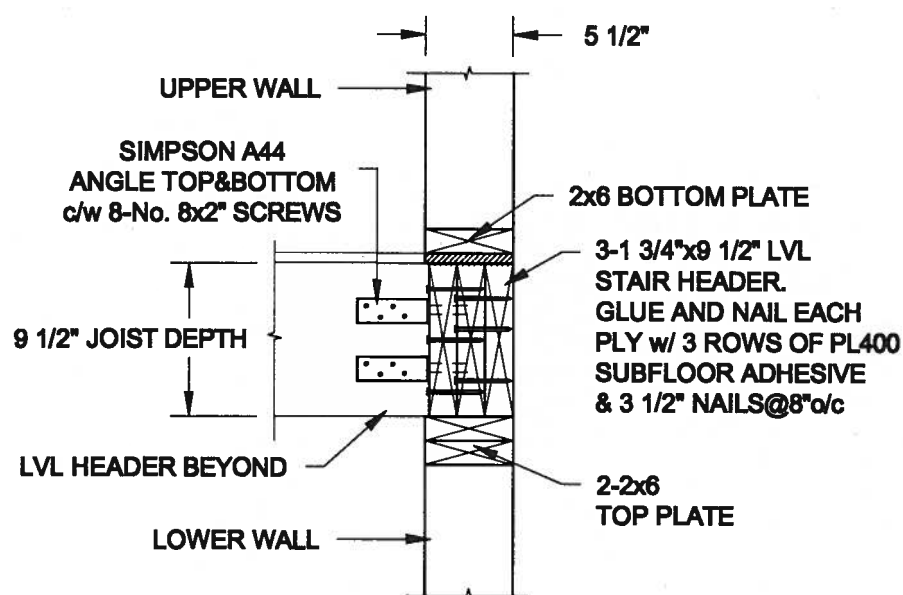

Scale:	AS NOTED
Date:	JAN-08-2018
Drawn:	SC
Checked:	SJB

## QUAILE ENGINEERING LTD.



38 Parkside Drive, UNIT 7  
Newmarket, ON  
L3Y 8J9  
T: 905-853-8547  
E: quaile.eng@rogers.com

Engineer's Seal



Project:

BAYVIEW WILMINGTON HOMES - GREEN VALLEY DRIVES - SIMS  
BRADFORD, ONTARIO

Project No.:

17-194

Drawing No.:

S2

**SITE COPY**



CONSTRUCTION NOTES (Unless otherwise noted)

ALL CONSTRUCTION TO ADHERE TO THESE PLANS AND SPEC'S AND TO CONFORM TO THE ONTARIO BUILDING CODE AND ALL OTHER APPLICABLE CODES AND AUTHORITIES HAVING JURISDICTION. THESE REQUIREMENTS ARE TO BE TAKEN AS MINIMUM SPECIFICATIONS. ONT. REG. 332/12-2012 OBC

1. ROOF CONSTRUCTION

NO.210 (10.25kg/m2) ASPHALT SHINGLES, 10mm (3/8") PLYWOOD SHEATHING WITH "H" CLIPS, APPROVED WOOD TRUSSES @ 600mm (24") O.C. MAX. APPROVED EAVES PROTECTION TO EXTEND 900mm (3'-0") FROM EDGE OF ROOF AND MIN. 300mm (12") BEYOND INNER FACE OF EXTERIOR WALL. (EAVES PROTECTION NOT REQ'D FOR ROOF SLOPES 8:12 OR GREATER) 38x89 (2"x4") TRUSS BRACING @ 1830mm (6'-0") O.C. AT BOTTOM CHORD. PREFIN. ALUM. EAVESTROUGH, FASCIA, RWL & VENTED SOFFIT. PROVIDE ICE & WATER SHIELD TO ALL ROOF/WALL SURFACES SUSCEPTIBLE TO ICE DAMMING. ROOF SHEATHING TO BE FASTENED 150 (6") C/C ALONG EDGES & INTERMEDIATE SUPPORTS WHEN TRUSSES SPACED GREATER THAN 406 (16"). ATTIC VENTILATION 1:300 OF INSULATED CEILING AREA WITH MIN. 25% AT EAVES & MIN. 25% AT RIDGE (OBC 9.19.1.2.).

2. FRAME WALL CONSTRUCTION (2"x6") (SB-12-TABLE 3.1.1.2A)

SIDING AS PER ELEV., 19x38 (1"x2") VERTICAL WOOD FURRING, CONTIN. SHEATHING MEMBRANE, 9.5mm (3/8") EXT. TYPE SHEATHING, 38x140 (2"x6") STUDS @ 400mm (16") O.C., RSI 3.87 (R22) INSULATION AND APPR. VAPOUR BARRIER AND APPR. CONTIN. AIR BARRIER, 13mm (1/2") INT. DRYWALL FINISH. SIDING TO BE MIN. 200mm (8") ABOVE FINISH GRADE. REFER TO OBC SB-12, CHAPTER 3 FOR ADDITIONAL THERMAL INSULATION REQUIREMENTS.

2A. RESERVED

2B. FRAME WALL CONSTRUCTION (2"x4") - GARAGE WALLS

SIDING AS PER ELEV., 19x38 (1"x2") VERTICAL WOOD FURRING, CONTIN. SHEATHING MEMBRANE, 9.5mm (3/8") EXT. TYPE SHEATHING, 38x89 (2"x4") STUDS @ 400mm (16") O.C. (MAX. HEIGHT 3000mm (9'-10")), WITH APPR. DIAGONAL WALL BRACING. SIDING TO BE MIN. 200mm (8") ABOVE FINISH GRADE.

2C. RESERVED

2D. STUCCO WALL CONSTRUCTION (2"x4") - GARAGE WALLS

STUCCO CLADDING SYSTEM CONFORMING TO O.B.C. 9.27.1.1.(2) & 9.28 THAT EMPLOY A MINIMUM 10mm AIR SPACE BEHIND THE CLADDING WITH POSITIVE DRAINAGE TO THE EXTERIOR AND APPLIED PER MANUFACTURERS SPECIFICATIONS OVER 25mm (1") MIN. EXPANDED OR EXTRUDED RIGID POLYSTYRENE ON APPROVED AIR/MOISTURE BARRIER ON 13mm (1/2") EXT. TYPE SHEATHING ON 38x89 (2"x4") STUDS @ 400 (16") O.C. STUCCO TO BE MIN. 200 (8") ABOVE FINISH GRADE.

2E. WALLS ADJACENT TO ATTIC SPACE - NO CLADDING

9.5mm (3/8") EXT. TYPE SHEATHING, 38x140 (2"x6") STUDS @ 400mm (16") O.C., RSI 3.87 (R22) INSULATION AND APPR. VAPOUR BARRIER AND APPR. CONTIN. AIR BARRIER, 13mm (1/2") INTERIOR DRYWALL FINISH. MID-HEIGHT BLOCKING REQ'D. IF NO SHEATHING APPLIED. REFER TO OBC SB-12, CHAPTER 3 FOR ADDITIONAL THERMAL INSULATION REQUIREMENTS.

3. BRICK VENEER CONSTRUCTION (2"x6") (SB-12-TABLE 3.1.1.2A)

70mm (4") FACE BRICK, 25mm (1") AIR SPACE, 22x180x76mm (7/8"x7"x0.03") GALV. METAL TIES @ 400mm (16") O.C. HORIZONTAL 600mm (24") O.C. VERTICAL. APPROVED SHEATHING PAPER, 9.5mm (3/8") EXT. TYPE SHEATHING, 38x140 (2"x6") STUDS @ 400mm (16") O.C., RSI 3.87 (R22) INSULATION & APPR. VAPOUR BARRIER WITH APPR. CONTIN. AIR BARRIER, 13mm (1/2") INTERIOR DRYWALL FINISH. PROVIDE WEEP HOLES @ 800mm (32") O.C. BOTTOM COURSE AND OVER OPENINGS. PROVIDE BASE FLASHING UP MIN. 150mm (6") BEHIND BUILDING PAPER. REFER TO OBC SB-12, CHAPTER 3 FOR ADDITIONAL THERMAL INSULATION REQUIREMENTS. BRICK TO BE MIN. 150mm (6") ABOVE FINISH GRADE.

3A. RESERVED

3B. BRICK VENEER CONSTRUCTION (2"x4") - GARAGE WALLS

70mm (4") FACE BRICK, 25mm (1") AIR SPACE, 22x180x76mm (7/8"x7"x0.03") GALV. METAL TIES @ 400mm (16") O.C. HORIZONTAL 600mm (24") O.C. VERTICAL. APPR. SHEATHING PAPER, 9.5mm (3/8") EXT. TYPE SHEATHING, 38x89 (2"x4") STUDS @ 400mm (16") O.C. (MAX. HEIGHT 3000mm (9'-10")) WITH APPR. DIAGONAL WALL BRACING. PROVIDE WEEP HOLES @ 800mm (32") O.C. BOTTOM COURSE AND OVER OPENINGS. PROVIDE BASE FLASHING UP MIN. 150mm (6") BEHIND BUILDING PAPER. BRICK TO BE MIN. 150mm (6") ABOVE FINISH GRADE.

3C. STUCCO WALL CONSTRUCTION (2"x6") (SB-12-TABLE 3.1.1.2A)

STUCCO CLADDING SYSTEM CONFORMING TO O.B.C. 9.27.1.1.(2) & 9.28 THAT EMPLOY A MINIMUM 10mm AIR SPACE BEHIND THE CLADDING WITH POSITIVE DRAINAGE TO THE EXTERIOR AND APPLIED PER MANUFACTURERS SPECIFICATIONS OVER 25mm (1") MIN. EXTRUDED OR EXPANDED RIGID POLYSTYRENE ON APPR. CONTIN. AIR/MOISTURE BARRIER ON 13mm (1/2") EXT. TYPE SHEATHING ON 38x140 (2"x6") STUDS @ 400mm (16") O.C., RSI 3.87 (R22) INSULATION, APPROVED VAPOUR BARRIER, 13mm (1/2") GYPSUM WALLBOARD INTERIOR FINISH. REFER TO OBC SB-12, CHAPTER 3 FOR ADDITIONAL THERMAL INSULATION REQUIREMENTS. STUCCO TO BE MIN. 200 (8") ABOVE FINISH GRADE.

4. INTERIOR STUD PARTITIONS

FOR BEARING PARTITIONS 38x89 (2"x4") @ 400mm (16") O.C. FOR 2 STOREYS AND 300mm (12") O.C. FOR 3 STOREYS, NON-BEARING PARTITIONS 38x89 (2"x4") @ 600mm (24") O.C. PROVIDE 38x89 (2"x4") BOTTOM PLATE AND 2/38x89 (2"x4") TOP PLATE. 13mm (1/2") INT. DRYWALL BOTH SIDES OF STUDS. PROVIDE 38x140 (2"x6") STUDS/PLATES WHEN NOTED.

5. FOUNDATION WALL/FOOTINGS (9.15.3, 9.15.4, 9.13.2, 9.14.2.1(2))

250mm (10") POURED CONC. FDTN. WALL 30MPa (4350psi) WITH BITUMINOUS DAMPROOFING AND DRAINAGE LAYER. DRAINAGE LAYER REQ'D. WHEN BASEMENT INSUL. EXTENDS 900 (2'-11") BELOW FIN. GRADE. DRAINAGE LAYER IS NOT REQ'D. WHEN FDTN. WALL IS WATERPROOFED. MAXIMUM POUR HEIGHT 2820 (9'-3") ON 560x155 (22"x6") CONTINUOUS KEYED CONC. FTG. BRACE FDTN. WALL PRIOR TO BACKFILLING. ALL FOOTINGS SHALL REST ON NATURAL UNDISTURBED SOIL OR COMPACTED ENGINEERED FILL. WITH MIN. BEARING CAPACITY OF 150kPa OR GREATER. IF SOIL BEARING DOES NOT MEET MINIMUM CAPACITY, ENGINEERED FOOTINGS ARE REQUIRED.

STOREYS SUPPORTED	W/ MASONRY VENEER	W/ SIDING ONLY
1	18" WIDE x 6" DEEP	18" WIDE x 6" DEEP
2	22" WIDE x 6" DEEP	22" WIDE x 6" DEEP
3	28" WIDE x 9" DEEP	22" WIDE x 6" DEEP

-SEE OBC 9.15.3.  
-MAXIMUM FLOOR LIVE LOAD OF 2.4kPa. (50psf.) PER FLOOR, AND MAX. LENGTH OF SUPPORTED FLOOR JOISTS IS 4.9m (16'-1").  
-REFER TO SOILS REPORT FOR SOIL CONDITIONS AND BEARING CAPACITY.

STRIP FOOTING SUPPORTING EXTERIOR WALLS (FOR W.O.B.)

-ASSUMING MASONRY VENEER CONSTRUCTION, MAX. FLOOR LIVE LOAD OF 2.4kPa. (50psf.) PER FLOOR, AND MAX. LENGTH OF SUPPORTED FLOOR JOISTS IS 4.9m (16'-1"). THE STRIP FOOTING SIZE IS AS FOLLOWS:

2 STOREY WITH WALK-OUT BASEMENT	545x175 (22"x7")
1	18" WIDE x 6" DEEP
2	22" WIDE x 6" DEEP
3	28" WIDE x 9" DEEP

6. FOUNDATION DRAINAGE OBC 9.14.2 & 9.14.3

100mm (4") DIA. FOUNDATION DRAINAGE TILE 150mm (6") CRUSHED STONE OVER AND AROUND DRAINAGE TILES.

7. BASEMENT SLAB OBC 9.1.1.6(1)(b), 9.16.4.5(1), 9.25.3.3(15)

80mm (3") MIN. 25MPa (3600psi) CONC. SLAB ON 100mm (4") COARSE GRANULAR FILL, OR 20MPa. (3000psi) CONC. WITH DAMPROOFING BELOW SLAB, UNDER SLAB INSULATION PER SB-12. ALL SLAB JOINTS & PENETRATIONS TO BE CAULKED.

8. EXPOSED FLOOR TO EXTERIOR (SB-12-TABLE 3.1.1.2A)

PROVIDE RSI 5.46 (R31) INSULATION, APPROVED VAPOUR BARRIER AND CONTINUOUS AIR BARRIER, FINISHED SOFFIT.

9. ATTIC INSULATION (SB-12-TABLE 3.1.1.2A) (SB-12-3.1.1.8)

RSI 10.56 (R60) BLOWN IN ROOF INSULATION AND APPROVED VAPOUR BARRIER, 16mm (5/8") INT. DRYWALL FINISH OR APPROVED EQUAL. RSI 3.52 (R20) MIN. ABOVE INNER SURFACE OF EXTERIOR WALL

10. ALL STAIRS/EXTERIOR STAIRS -OBC 9.8.-

UNIFORM RISE -5mm (1/4") MAX BETWEEN ADJACENT TREADS OR LANDINGS  
-10mm (1/2") MAX BETWEEN TALLEST & SHORTEST RISE IN FLIGHT  
MAX. RISE = 200 (7'-7/8")  
MIN. RUN = 210 (8'-1/4")  
MIN. TREAD = 235 (9'-1/4")  
MAX. NOSING = 25 (1")  
MIN. HEADROOM = 1950 (6'-5")  
RAIL @ LANDING = 900 (2'-11")  
RAIL @ STAIR = 865 (2'-10") TO 965 (3'-2")  
MIN. STAIR WIDTH = 860 (2'-10")  
FOR CURVED STAIRS  
MIN. RUN = 150 (6")  
MIN. AVG. RUN = 200 (8")

HANDRAILS -OBC 9.8.7-

FINISHED RAILING ON PICKETS SPACED MAXIMUM 100mm (4") BETWEEN PICKETS. CLEARANCE BETWEEN HANDRAIL AND SURFACE BEHIND IT TO BE 50 (2") MIN. HANDRAILS TO BE CONTINUOUS EXCEPT FOR NEWEL POST AT CHANGES OF DIRECTION.

INTERIOR GUARDS -OBC 9.8.8.-

INTERIOR GUARDS: 900mm (2'-11") MIN. HIGH  
EXTERIOR GUARDS - OBC 9.8.8.  
900mm (36") HIGH GUARD WHERE DISTANCE FROM PORCH TO FIN. GRADE IS LESS THAN 1800mm (7'1"). 1070mm (42") HIGH GUARD IS REQUIRED WHERE DISTANCE EXCEEDS 1800mm (7'1").

SILL PLATE - OBC 9.23.7

38x89 (2"x4") SILL PLATE WITH 13mm (1/2") DIA. ANCHOR BOLTS 200mm (8") LONG, EMBEDDED MIN. 100mm (4") INTO CONC. @ 2400mm (7'-10") O.C. CAULKING OR 25 (1") MIN. MINERAL WOOL BETWEEN PLATE AND TOP OF FDTN. WALL. USE NON-SHRINK GROUT TO LEVEL SILL PLATE WHEN REQUIRED.

BASEMENT INSULATION (SB-12-3.1.1.7, 9.25.2.3, 9.13.2.6)

FOUNDATION WALLS ENCLOSING HEATED SPACE SHALL BE INSULATED FROM THE UNDERSIDE OF THE SUBFLOOR TO NOT MORE THAN 200mm (8") ABOVE THE FINISHED FLOOR & NO CLOSER THAN 50mm (2") OF THE BASEMENT SLAB. RSI3.52ci (R20ci) BLANKET INSULATION TO HAVE APPROVED VAPOUR BARRIER. RECOMMEND DAMPROOF WITH BUILDING PAPER BETWEEN THE FOUNDATION WALL AND INSULATION UP TO GRADE LEVEL. NOTE: FULL HEIGHT INSULATION AT COLD CELLAR WALLS. AIR BARRIER TO BE SEALED TO FOUNDATION WALL WITH CAULKING. CONTINUOUS INSULATION (ci) IS NOT TO BE INTERRUPTED BY FRAMING.

BEARING STUD PARTITION

38x89 (2"x4") STUDS @ 400mm (16") O.C. 38x89 (2"x4") SILL PLATE ON DAMPROOFING MATERIAL, 13mm (1/2") DIA. ANCHOR BOLTS 200mm (8") LONG, EMBEDDED MIN. 100mm (4") INTO CONC. @ 2400mm (7'-10") O.C. 100mm (4") HIGH CONC. CURB ON 350x155 (14"x6") CONC. FOOTING. ADD HORIZ. BLOCKING AT MID-HEIGHT IF WALL IS UNFINISHED.

STEEL BASEMENT COLUMN (SEE O.B.C. 9.15.3.3)

89mm(3-1/2") DIA x 3.0mm(0.118) SINGLE WALL TYPE 2 ADJUSTABLE STL. COL. W/ MIN. CAPACITY OF 71.2kN (16,000lbs.) AT A MAX. EXTENSION OF 2318mm (7'-7 1/2") CONFORMING TO CAN/CGSB-7.2-9.4, AND WITH 150x150x9.5 (6"x6"x3/8") STL. PLATE TOP & BOTTOM. 870x870x10 (34"x34"x1/4") CONC. FOOTING ON UNDISTURBED SOIL OR ENGINEERED FILL CAPABLE OF SUSTAINING A PRESSURE OF 150 Kpa. MINIMUM AND AS PER SOILS REPORT.

STEEL BASEMENT COLUMN (SEE O.B.C. 9.15.3.3)

89mm(3-1/2") DIA x 4.78mm(.188) FIXED STL. COL. WITH 150x150x9.5 (6"x6"x3/8") STL. TOP & BOTTOM PLATE ON 1070x1070x460 (42"x42"x18") CONC. FOOTING ON UNDISTURBED SOIL OR ENGINEERED FILL CAPABLE OF SUSTAINING A PRESSURE OF 150 Kpa. MIN. AND AS PER SOILS REPORT.

STEEL COLUMN

90mm(3-1/2") DIA x 4.78mm(.188) NON-ADJUSTABLE STL. COL. TO BE ON 150x150x9.5 (6"x6"x3/8") STEEL TOP PLATE, & BOTTOM PLATE. BASE PLATE 120x250x12.5 (4 1/2"x10"x1/2") WITH 2-12mm DIA. x 300mm LONG x50mm HOOK ANCHORS (2-1/2"x2"x2") FIELD WELD COL. TO BASE PLATE.

16. BEAM POCKET OR 300x150 (12"x6") POURED CONC. NIB WALLS.

17. 19x64 (1"x3") CONTINUOUS WOOD STRAPPING BOTH SIDES OF STEEL BEAM.

18. GARAGE SLAB

100mm (4") 32MPa (4640psi) CONC. SLAB WITH 5-8% AIR ENTRAINMENT ON OPT. 100 (4") COARSE GRANULAR FILL WITH COMPACTED SUB-BASE OR COMPACTED NATIVE FILL. SLOPE TO FRONT.

19. GARAGE CEILINGS/INTERIOR WALLS

13mm (1/2") GYPSUM BOARD ON WALL AND CEILING BETWEEN HOUSE AND GARAGE. TAPE AND SEAL ALL JOINTS AIRTIGHT PER O.B.C. 9.10.9.16. WALLS (R22), CEILINGS (R31). REFER TO SB-12, TABLE 3.1.1.2.A. FOR REQUIRED THERMAL INSULATION.

DOOR AND FRAME GASPROOFED. DOOR EQUIPPED WITH SELF CLOSING DEVICE AND WEATHERSTRIPPING PER OBC 9.10.13.15.

21. EXTERIOR STEP

PRECAST CONCRETE STEP OR WOOD STEP WHERE NOT EXPOSED TO WEATHER. MAX. RISE 200mm (7'-7/8") MIN. TREAD 250mm (9'-1/2"). SEE OBC. 9.8.9.2, 9.8.9.3, & 9.8.10.

22. DRYER EXHAUST (OBC-6.2.3.8(7) & 6.2.4.11.)

CAPPED DRYER EXHAUST VENTED TO EXTERIOR. (USE 100mm (4") DIA. SMOOTH WALL VENT PIPE)

23. INSULATED ATTIC ACCESS (OBC-9.18.2.1 & SB12-3.1.1.8)

ATTIC ACCESS HATCH WITH MIN. DIMENSION OF 545x610mm (21 1/2"x24") & A MIN. AREA OF 0.32 SQ.M. (3.44 SQ.FT.) WITH WEATHERSTRIPPING. RSI 3.52 (R20) RIGID INSUL. BACKING.

24. FIREPLACE CHIMNEYS OBC 9.21

TOP OF FIREPLACE CHIMNEY SHALL BE 915mm (3'-0") ABOVE THE HIGHEST POINT AT WHICH IT COMES IN CONTACT WITH THE ROOF AND 610mm (2'-0") ABOVE THE ROOF SURFACE WITHIN A HORIZ. DISTANCE OF 3050mm (10'-0") FROM THE CHIMNEY.

25. LINEN CLOSET, 4 SHELVES MIN. 350mm (14") DEEP.

26. MECHANICAL EXHAUST FAN, VENTED TO EXTERIOR AS REQUIRED BY OBC. 9.32.3.5 & 9.32.3.10.

27. STEEL BEARING PLATE FOR MASONRY WALLS

280x280x16 (11"x11"x5/8") STL. PLATE FOR STL BEAMS AND 280x280x12 (11"x11"x1/2") STL. PLATE FOR WOOD BEAMS BEARING ON CONC. BLOCK PARTYWALL, ANCHORED WITH 2-19mm (3/4") x 200mm (8") LONG GALV. ANCHORS WITHIN SOLID BLOCK COURSE. LEVEL WITH NON-SHRINK GROUT.

OR SOLID WOOD BEARING FOR WOOD STUD WALLS

SOLID BEARING TO BE AT LEAST AS WIDE AS THE SUPPORTED MEMBER. SOLID WOOD BEARING COMPRISED OF BUILT-UP WOOD STUDS TO BE CONSTRUCTED IN ACCORDANCE WITH OBC 9.17.4.2(2).

28. RESERVED

29. BEARING WOOD POST (BASEMENT) (OBC 9.17.4.)

3-38x140 (3-2"x6") BUILT-UP POST ON METAL BASE SHOE ANCHORED TO CONC. WITH 12.7 DIA. BOLT, 610x610x300 (24"x24"x12") CONC. FOOTING.

30. STEPPED FOOTINGS OBC 9.15.3.9

MIN. HORIZ. STEP = 600mm (24").  
MAX. VERT. STEP = 600mm (24")

31. SLAB ON GRADE

MIN. 100mm (4") CONCRETE SLAB ON GRADE ON 100mm (4") COARSE GRANULAR FILL. REINFORCED WITH 6x6-W2.9xW2.9 MESH PLACED NEAR MID-DEPTH OF SLAB. CONC. STRENGTH 32 MPa (4640 psi) WITH 5-8% AIR ENTRAINMENT ON COMPACTED SUB-GRADE. WHERE REQUIRED, REFER TO OBC SB-12, TABLE 3.1.1.2.A. FOR REQUIRED MINIMUM INSULATION UNDER SLAB.

32. DIRECT VENTING GAS FURNACE/ H.W.T VENT

DIRECT VENT FURNACE TERMINAL MIN. 900mm (36") FROM A GAS REGULATOR. MIN. 300mm (12") ABOVE FIN. GRADE. FROM ALL OPENINGS, EXHAUST AND INTAKE VENTS, HRV INTAKE TO BE A MIN. OF 1830mm (6'-0") FROM ALL EXHAUST TERMINALS. REFER TO GAS UTILIZATION CODE.

33. DIRECT VENTING GAS FIREPLACE VENT

DIRECT VENT GAS FIREPLACE. VENT TO BE A MINIMUM 300mm (12") FROM ANY OPENING AND ABOVE FIN. GRADE. REFER TO GAS UTILIZATION CODE.

34. SUBFLOOR JOIST STRAPPING AND BRIDGING

16mm (5/8") T & G SUBFLOOR ON WOOD FLOOR JOISTS. FOR CERAMIC TILE APPLICATION (\* SEE OBC 9.30.6. \* ) 6mm (1/4") PANEL TYPE UNDERLAY UNDER RESILIENT & PARQUET FLOORING. (\* SEE OBC 9.30.2. \*)  
FLOOR JOISTS WITH SPANS OVER 2100mm (6'-11") TO BE BRIDGED WITH 38x38 (2"x2") CROSS BRACING OR SOLID BLOCKING @ 2100mm (6'-11") O.C. MAX. AND WHERE SPECIFIED BY JOIST TABLES A-1 OR A-2 STRAPPING SHALL BE 19x64 (1"x3") @ 2100mm (6'-11") O.C. UNLESS A PANEL TYPE CEILING FINISH IS APPLIED. (\* SEE OBC 9.23.9.4. \*)

35. EXPOSED BUILDING FACE OBC 9.10.15 & SB-2-2.3.5(2)

EXTERIOR WALLS TO HAVE A FIRE RESISTANCE RATING OF NOT LESS THAN 45 min. WHERE LIMITING DISTANCE (LD) IS LESS THAN 1.2M (3'-11"). WHERE THE LD IS LESS THAN 600mm (1'-11") THE EXPOSING FACE SHALL BE CLAD IN NON-COMBUSTIBLE MATERIAL. SEE ELEVATIONS FOR ADDITIONAL NOTES. OFFENDING GARAGE WALLS INCLUDED.

36. COLD CELLAR PORCH SLAB (OBC 9.38.1)

FOR MAX. 2500mm (8'-2") PORCH DEPTH (SHORTEST DIM.), 125mm (5") 32MPa (4640psi) CONC. SLAB WITH 5-8% AIR ENTRAINMENT. REIN. WITH 10M BARS @ 200mm (7 7/8") O.C. EACH WAY IN BOTTOM THIRD OF SLAB, MIN. 30mm (1 1/4") COVER. 600x600 (23 5/8"x23 5/8") 10M DOWELS @ 600mm (23 5/8") O.C., ANCHORED IN PERIMETER FDTN. WALLS. SLOPE SLAB MIN. 1.0% FROM HOUSE WALL. SLAB TO HAVE MIN. 75mm (3") BEARING ON FDTN. WALLS. PROVIDE (L7) UNTEL OVER CELLAR DOOR WITH 100mm (4") END BEARING.

THE FDTN. WALL SHALL NOT BE REDUCED TO LESS THAN 90mm (3-1/2") THICK TO A MAX. DEPTH OF 600mm (24") AND SHALL BE TIED TO THE FACING MATERIAL WITH METAL TIES SPACED 200mm (8") O.C. VERTICALLY AND 900mm (36") O.C. HORIZONTALLY. FILL SPACE BETWEEN WALL AND FACING SILL WITH MORTAR.

38. CONVENTIONAL ROOF FRAMING (2.0kPa. SNOW LOAD)

38x140 (2"x6") RAFTERS @ 400mm (16") O.C. FOR MAX 11'-7" SPAN. 38x184 (2"x8") RIDGE BOARD, 38x89 (2"x4") COLLAR TIES AT MIDSPANS. CEILING JOISTS TO BE 38x89 (2"x4") @ 400mm (16") O.C. FOR MAX. 2830mm (9'-3") SPAN & 38x140 (2"x6") @ 400 (16") O.C. FOR MAX. 4450mm (14'-7") SPAN.  
RAFTERS FOR BUILT-UP ROOF TO BE 38x89 (2"x4") @ 600mm (24") O.C. WITH A 38x89 (2"x4") CENTRE POST TO THE TRUSS BELOW, LATERALLY BRACED @ 1800mm (6'-0") O.C. VERTICALLY.

GENERAL NOTES

WINDOWS: 1) MINIMUM BEDROOM WINDOW -OBC 9.9.10.1-

AT LEAST ONE BEDROOM WINDOW ON A GIVEN FLOOR IS TO HAVE MIN. 0.35m2 UNOBSTRUCTED GLAZED OR OPENABLE AREA WITH MIN. CLEAR WIDTH OF 380 mm (1'-3").

2) WINDOW GUARDS -OBC 9.8.8.1(6)

A GUARD IS REQUIRED WHERE THE TOP OF THE WINDOW SILL IS LOCATED LESS THAN 480mm (1'-7") ABOVE FIN. FLOOR AND THE DISTANCE FROM THE FIN. FLOOR TO THE ADJACENT GRADE IS GREATER THAN 1800mm (5'-11")

3) EXTERIOR WINDOWS

SHALL COMPLY WITH OBC DIV. 8 9.7.3. & SB12-3.1.1.9

GENERAL: 1) MECHANICAL VENTILATION IS REQUIRED TO COMPLY WITH OBC-DIV. B. 6.2.2. SEE MECHANICAL DRAWINGS.

2) ALL DOWNSPOUTS TO DRAIN AWAY FROM THE BUILDING AS PER OBC 9.26.18.2. & 5.6.2.2.(3) AND MUNICIPAL STANDARDS.

3) ALL WINDOW WELLS TO DRAIN TO FOOTING LEVEL PER OBC 9.14.6.3. CHECK WITH THE LOCAL AUTHORITY.

4) STUD WALL REINFORCEMENT FOR FUTURE GRAB BARS IN MAIN BATHROOM

REINFORCEMENT OF STUD WALLS SHALL BE INSTALLED ADJACENT TO WATER CLOSETS AND SHOWER OR BATHTUB IN MAIN BATHROOM. REFER TO OBC. 9.5.2.3, 3.8.3.8.(1)(c) & 3.8.3.13.(1)(f). SEE DETAIL.

5) ALL EXTERIOR DOORS TO COMPLY WITH THERMAL RESISTANCE AS STATED IN O.B.C. SB-12-3.1.1.9.

6) ALL AIR BARRIER SYSTEMS ARE REQUIRED TO COMPLY WITH O.B.C. DIV.-8 9.2.5.

LUMBER: 1) ALL LUMBER SHALL BE SPRUCE NO.2 GRADE, UNLESS NOTED OTHERWISE.

2) STUDS SHALL BE STUD GRADE SPRUCE, UNLESS NOTED OTHERWISE.

3) LUMBER EXPOSED TO THE EXTERIOR TO BE SPRUCE NO.2 GRADE PRESSURE TREATED OR CEDAR, UNLESS NOTED OTHERWISE.

4) ALL LAMINATED VENEER LUMBER (L.V.L.) BEAMS, GIRDER TRUSSES, AND METAL HANGER CONNECTIONS SUPPORTING ROOF FRAMING TO BE DESIGNED & CERTIFIED BY TRUSS MANUFACTURER.

5) LVL BEAMS SHALL BE 2.0E-2950F MIN., NAIL EACH PLY OF LVL WITH 89mm (3 1/2") LONG COMMON WIRE NAILS @ 300mm (12") O.C. STAGGERED IN 2 ROWS FOR 184, 240 & 300mm (7 1/4", 9 1/2", 11 7/8") DEPTHS AND STAGGERED IN 3 ROWS FOR GREATER DEPTHS AND FOR 4 PLY MEMBERS ADD 13mm (1/2") DIA. GALVANIZED BOLTS BOLTED AT MID-DEPTH OF BEAM @ 915mm (3'-0") O.C.

6) PROVIDE FACE MOUNT BEAM HANGERS TYPE "SCL" MANUFACTURED BY SIMPSON STRONG-TIE OR EQUAL FOR ALL LVL BEAM TO BEAM CONNECTIONS UNLESS OTHERWISE NOTED. REFER TO ENG. FLOOR LAYOUTS.

7) JOIST HANGERS: PROVIDE METAL HANGERS FOR ALL JOISTS AND BUILT-UP WOOD MEMBERS INTERSECTING FLUSH BUILT-UP WOOD MEMBERS

8) WOOD FRAMING NOT TREATED WITH A WOOD PRESERVATIVE. IN CONTACT WITH CONCRETE, SHALL BE SEPARATED FROM THE CONCRETE BY AT LEAST 2 mL POLYETHYLENE FILM, No. 50 (45lbs.) ROLL ROOFING OR OTHER DAMPROOFING MATERIAL EXCEPT WHERE THE WOOD MEMBER IS AT LEAST 150mm (6") ABOVE THE GROUND.

STEEL: 1) STRUCTURAL STEEL SHALL CONFORM TO CAN/CSA-G40-21 GRADE 300W. HOLLOW STRUCTURAL SECTIONS SHALL CONFORM TO CSA-G40-21 GRADE 350W "STRUCTURAL QUALITY STEEL". OBC. 9.9.23.43.



2) REINFORCING STEEL SHALL CONFORM TO CSA-G30-18M GRADE 400R.

STUCCO: 1) ALL STUCCO WALLS TO HAVE A MINIMUM 10mm AIR SPACE BEHIND THE CLADDING WITH POSITIVE DRAINAGE TO THE EXTERIOR. THE EXTERIOR SHEATHING MUST NOT BE GYPSUM BASED. ALL STUCCO TO BE INSTALLED AS PER MANUFACTURERS SPECIFICATIONS.

LEGEND

CLASS 'B' V
-------------









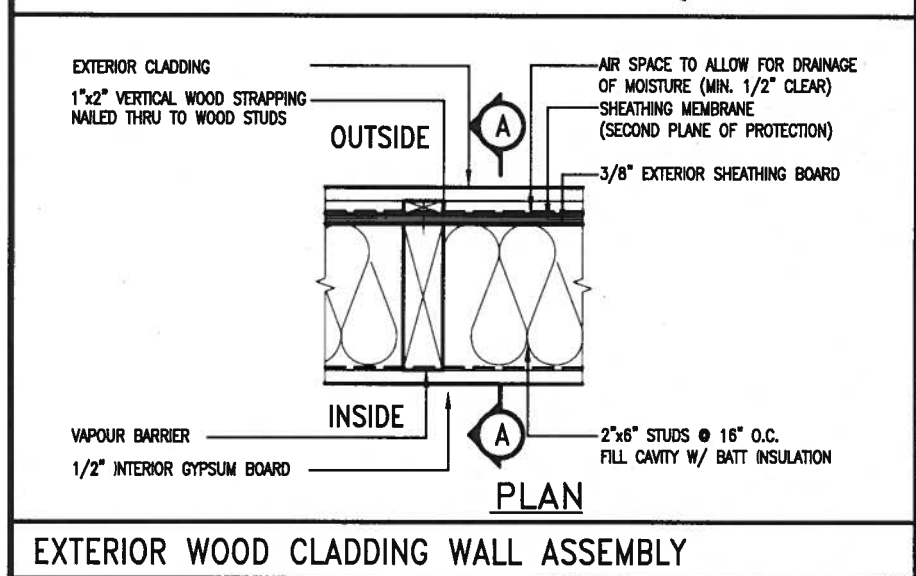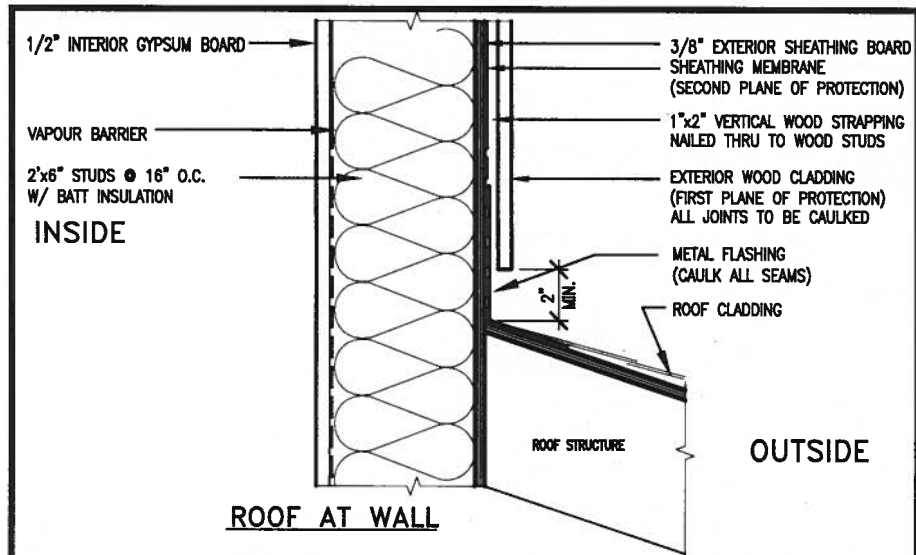

EXTERIOR WOOD CLADDING WALL ASSEMBLY

**STUD WALL REINFORCEMENT FOR FUTURE GRAB BARS IN MAIN BATHROOM**

REINFORCEMENT OF STUD WALLS SHALL BE INSTALLED ADJACENT TO WATER CLOSETS AND SHOWER OR BATHTUB IN MAIN BATHROOM. FUTURE GRAB BARS TO BE MOUNTED TO RESIST HORIZ. AND VERT. LOADS OF 1.3 KN (300 lb). REFER TO OBC, DIV. B- 9.5.2.3. WATER CLOSET 3.8.3.8.(3)(a) & 3.8.3.8.(3)(c). SHOWER 3.8.3.13.(2)(i). BATHTUB & 3.8.3.13.(4)(c). AND DETAILS PROVIDED.

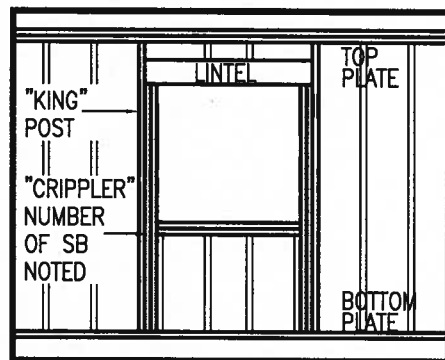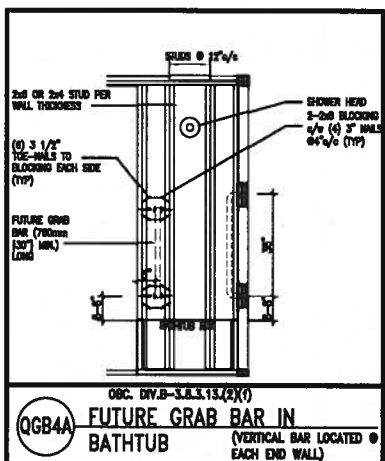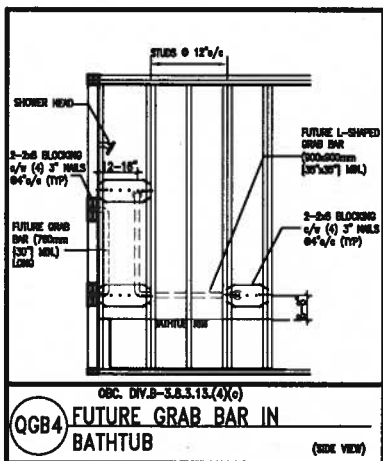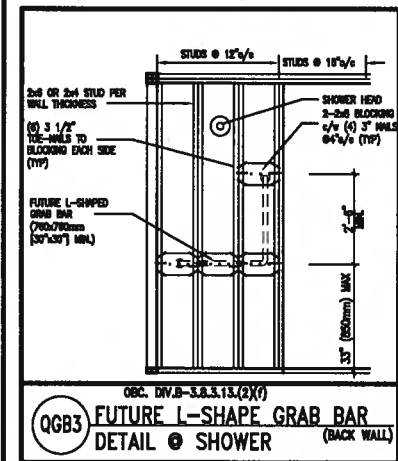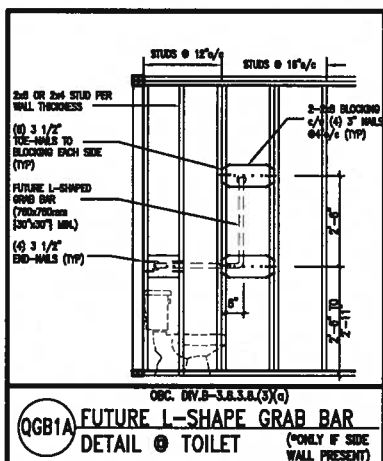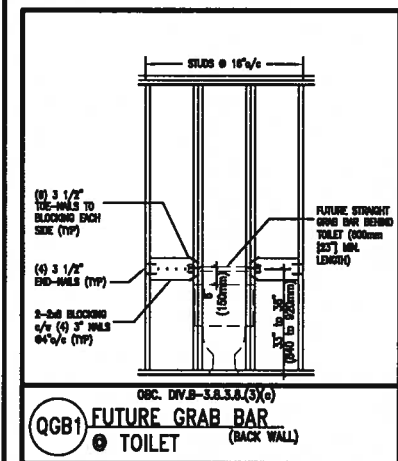

**MAX. HEIGHT FOR 2"x4" GARAGE WALL IS AS FOLLOW:**

- 2"x4" @ 16" O.C. - 9'-10"
- 2"x4" @ 12" O.C. - 10'-9"
- 3"x4" @ 16" O.C. - 11'-2"
- 3"x4" @ 12" O.C. - 12'-4"

**NOTES:**

- FOR ROOF DESIGN SNOW LOAD OF UP TO 2.5 KPa. SUPPORTED ROOF TRUSS LENGTH OF 6.0m AND FLOOR JOIST LENGTH OF 2.5m OF ONE FLOOR.
- PROVIDE HORIZONTAL SOLID BLOCKING @ 1200 O.C. (4'-0")
- PROVIDE A MINIMUM OF 9.5mm (3/8") PLYWOOD OR OSB EXTERIOR SHEATHING ON THE EXTERIOR FACE.
- FOR A 1/50 YEAR REFERENCE WIND PRESSURE OF 0.6 KPa.
- STUDS GREATER THAN 9'-10" HIGH TO BE No. 2 SPF.
- STUD SPECIFICATION IS SUITABLE FOR BRICK VENEER OR SIDING.

**\*\* MAX. HEIGHT FOR 2"x6" EXTERIOR WALL IS AS FOLLOW:**

- 2"x6" @ 16" O.C. - 12'-6"
- 2"x6" @ 12" O.C. - 13'-10"
- 2"x6" @ 16" O.C. - 15'-0"
- 2"x6" @ 12" O.C. - 17'-4"

**MAX. HEIGHT FOR 2"x8" EXTERIOR WALL IS AS FOLLOWS:**

- 2"x8" @ 16" O.C. - 16'-0"
- 2"x8" @ 12" O.C. - 17'-9"
- 2"x8" @ 16" O.C. - 20'-4"
- 2"x8" @ 12" O.C. - 22'-4"

**NOTES:**

- FOR ROOF DESIGN SNOW LOAD OF UP TO 2.5 KPa.
- SUPPORTED ROOF TRUSS LENGTH OF 6.0m ONLY.
- PROVIDE HORIZONTAL SOLID BLOCKING @ 1200 O.C. (4'-0")
- PROVIDE A MINIMUM OF 9.5mm (3/8") PLYWOOD OR OSB EXTERIOR SHEATHING ON THE EXTERIOR FACE AND 12.5mm (1/2") GYPSUM BOARD ON THE INTERIOR FACE.
- WALL FRAMING SHALL CONFORM TO OBC 9.23.10.1.(2)
- FOR A 1/50 YEAR REFERENCE WIND PRESSURE OF 0.6 KPa.
- STUDS GREATER THAN 9'-10" HIGH TO BE No. 2 SPF.
- STUD SPECIFICATION IS SUITABLE FOR BRICK VENEER OR SIDING.

\*\* STUD INFORMATION TAKEN FROM OBC TABLE A-30

9.				The undersigned has reviewed and takes responsibility for this design and has the qualifications and meets the requirements set out in the Ontario Building Code to be a Designer.
8.				qualification information
7.				Wellington Jno-Baptiste 25591
6.				name
5.				registration information
4.				VA3 Design Inc. 42658
3.				
2.	UPDATE TO 2018	JAN 11-18	RC	Contractor must verify all dimensions on the job and report any discrepancy to the Designer before proceeding with the work. All drawings and specifications are instruments of service and the property of the Designer which must be returned at the completion of the work. Drawings are not to be scaled.
1.	ISSUE FOR CLIENT REVIEW	AUG 04-17	RC	
no.	description	date	by	




255 Consumers Rd Suite 120  
Toronto ON M2J 1R4  
t 416.630.2255 f 416.630.4782  
va3design.com

**BAYVIEW WELLINGTON**  
**GREEN VALLEY EAST**

**CONST NOTE**

project no.	16023
drawing no.	CN2
date	MAY 2018
drawn by	RC
checked by	
scale	3/16" = 1'-0"
CONSTRUCTION NOTES	
file name	16023-CN-A1
date	Jan 11 2018 - 10:08 AM



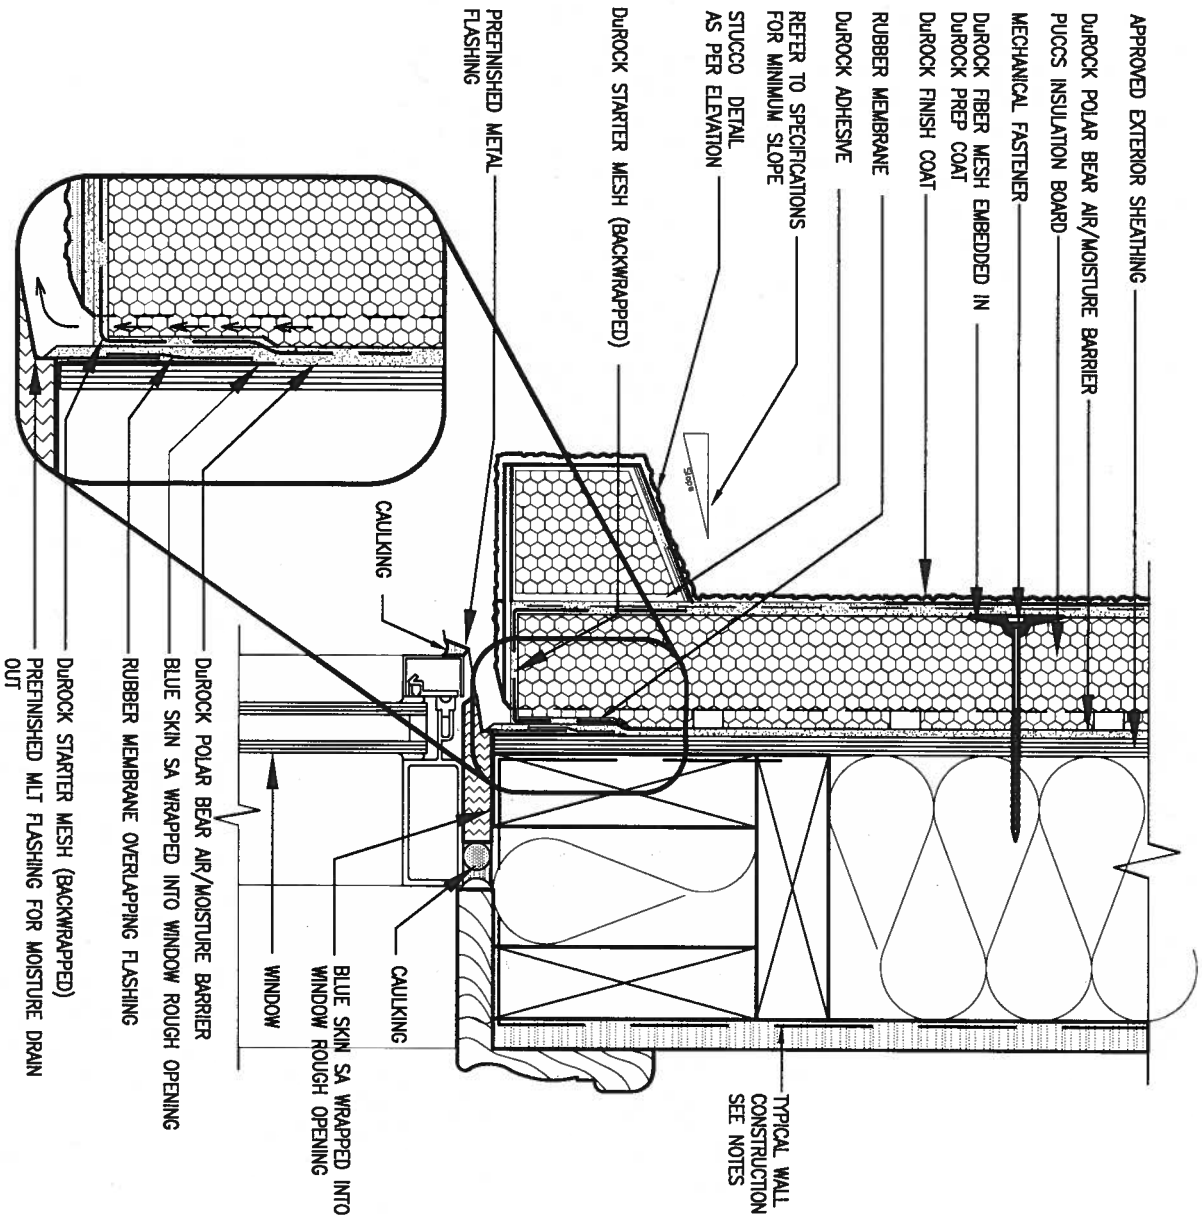


## 1 WINDOW HEADER

CN3

SCALE: 3"=1'-0"

ALL STUCCO WALLS TO HAVE A MINIMUM 10mm AIR SPACE BEHIND THE CLADDING WITH POSITIVE DRAINAGE TO THE EXTERIOR. THE EXTERIOR SHEATHING MUST NOT BE GYPSUM BASED. ALL STUCCO TO BE INSTALLED AS PER MANUFACTURERS SPECIFICATIONS. DETAILS ARE BASED ON DUROCK PUCCS SYSTEM

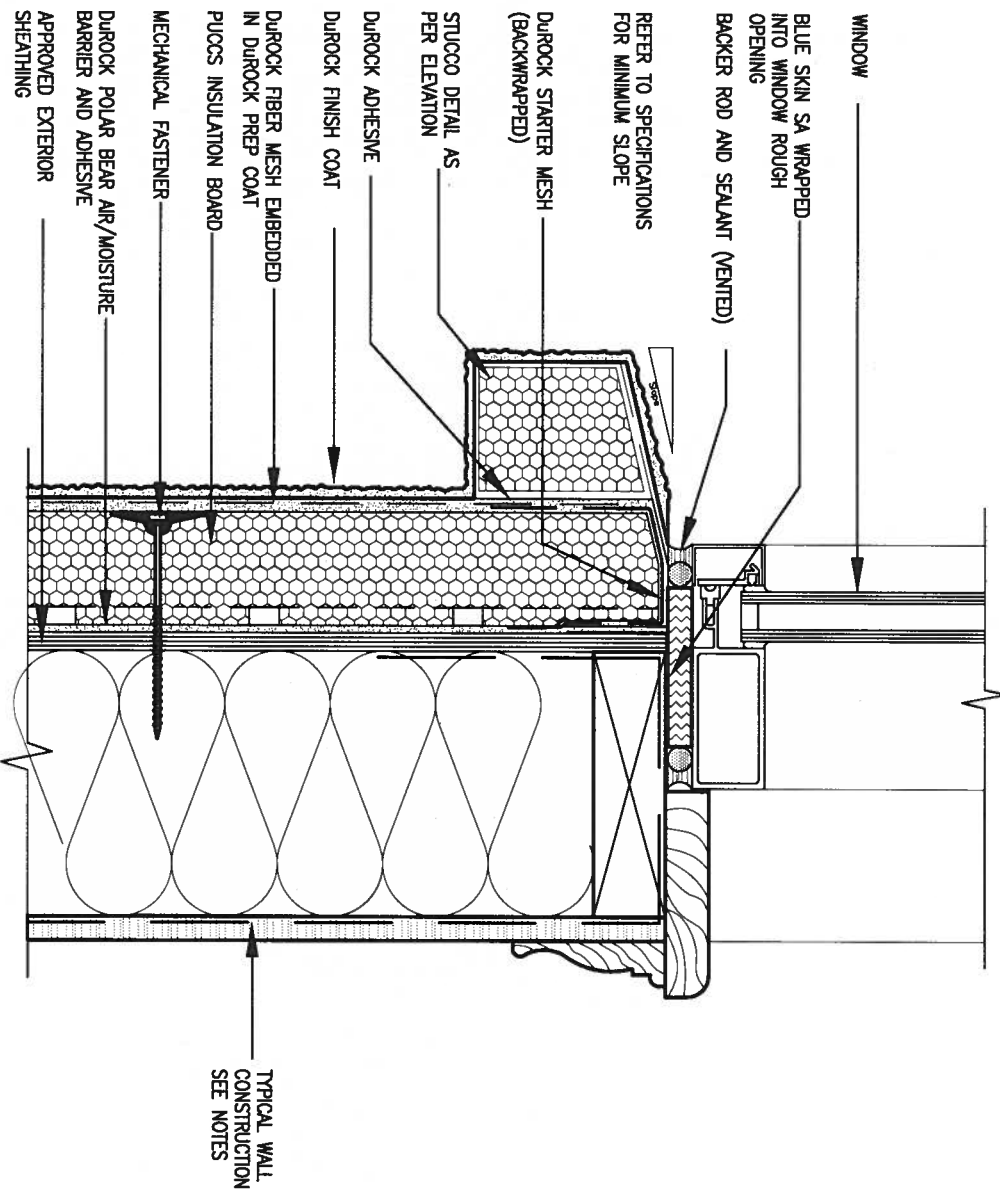

## 2 WINDOW SILL

CN3

SCALE: 3"=1'-0"

9.			
8.			
7.			
6.			
5.			
4.			
3.			
2.	UPDATE TO 2018	JAN 11-18	RC
1.	ISSUE FOR CLIENT REVIEW	AUG 04-17	RC
no.	description	date	by

The undersigned has reviewed and takes responsibility for this design and has the qualifications and meets the requirements set out in the Ontario Building Code to be a Designer.	
qualification information	
Wellington Jno-Baptiste	25591
name	BCIN
registration information	
VA3 Design Inc.	42658
Contractor must verify all dimensions on the job and report any discrepancy to the Designer before proceeding with the work. All drawings and specifications are instruments of service and the property of the Designer which must be returned at the completion of the work. Drawings are not to be scaled.	

**VA3 DESIGN**  
255 Consumers Rd Suite 120  
Toronto ON M2W 1R4  
t 416.630.2255 f 416.630.4782  
va3design.com

**BAYVIEW WELLINGTON**  
**GREEN VALLEY EAST**  
date MAY 2018  
drawn by RC  
checked by  
scale 3/16" = 1'-0"  
multiplicity  
BRADFORD

### CONSTRUCTION NOTES

file name  
16023-CN-A1

drawing no.

**CN3**


### CONST NOTE

project no.

16023






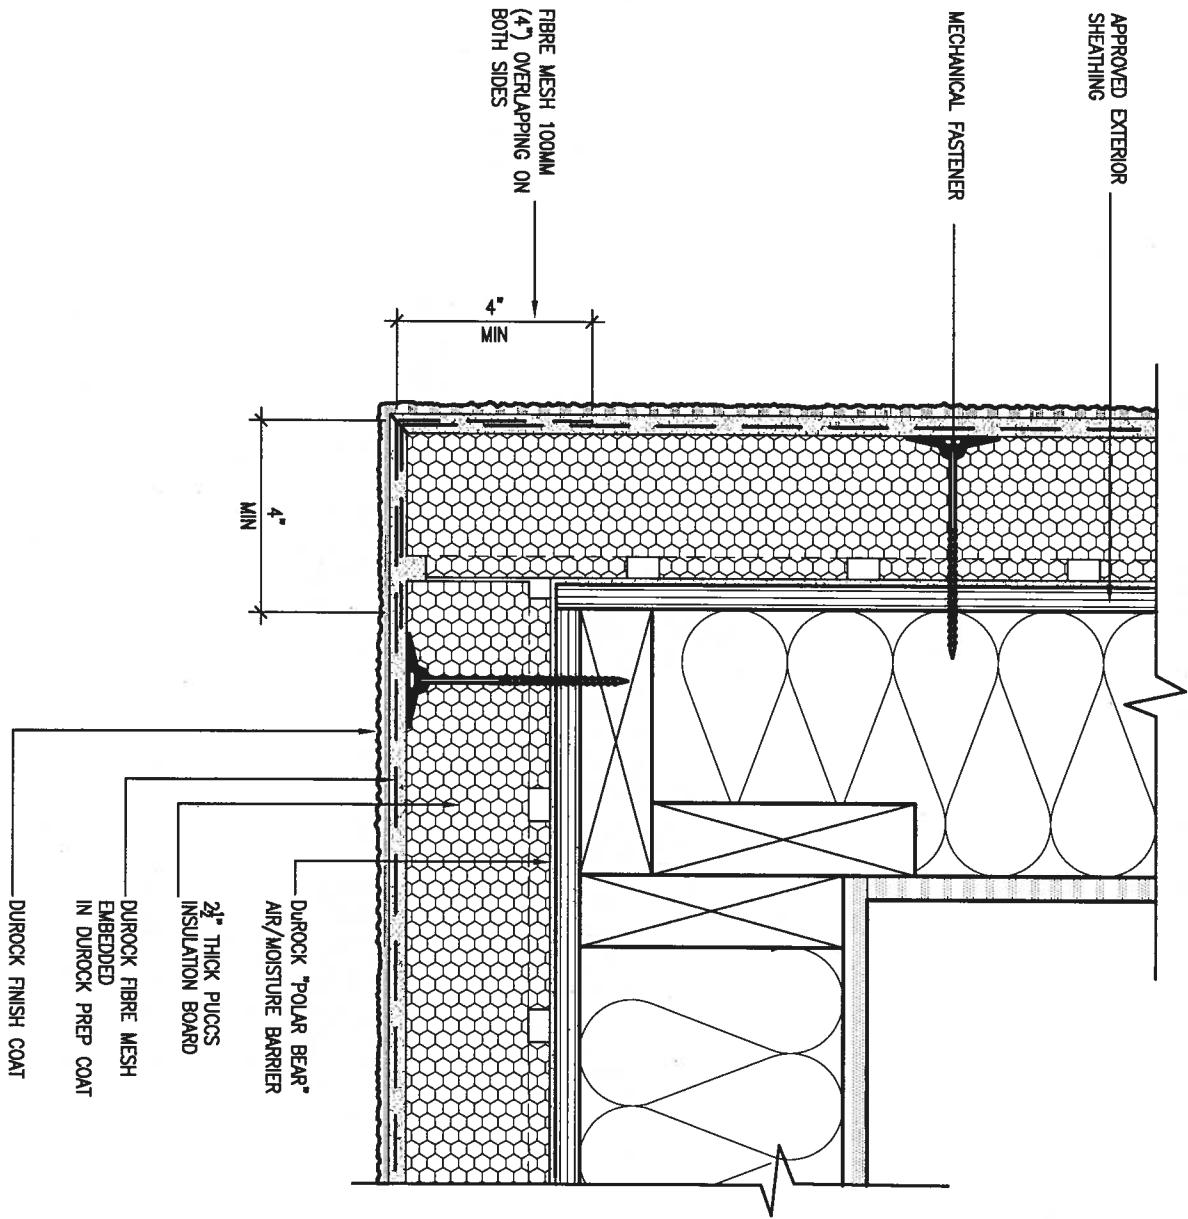

5 CORNER DETAIL  
CNS SCALE: 3"=1'-0"

ALL STUCCO WALLS TO HAVE A MINIMUM 10mm AIR SPACE BEHIND THE CLADDING WITH POSITIVE DRAINAGE TO THE EXTERIOR. THE EXTERIOR SHEATHING MUST NOT BE GYPSUM BASED. ALL STUCCO TO BE INSTALLED AS PER MANUFACTURERS SPECIFICATIONS.  
DETAILS ARE BASED ON DUROCK PUCCS SYSTEM

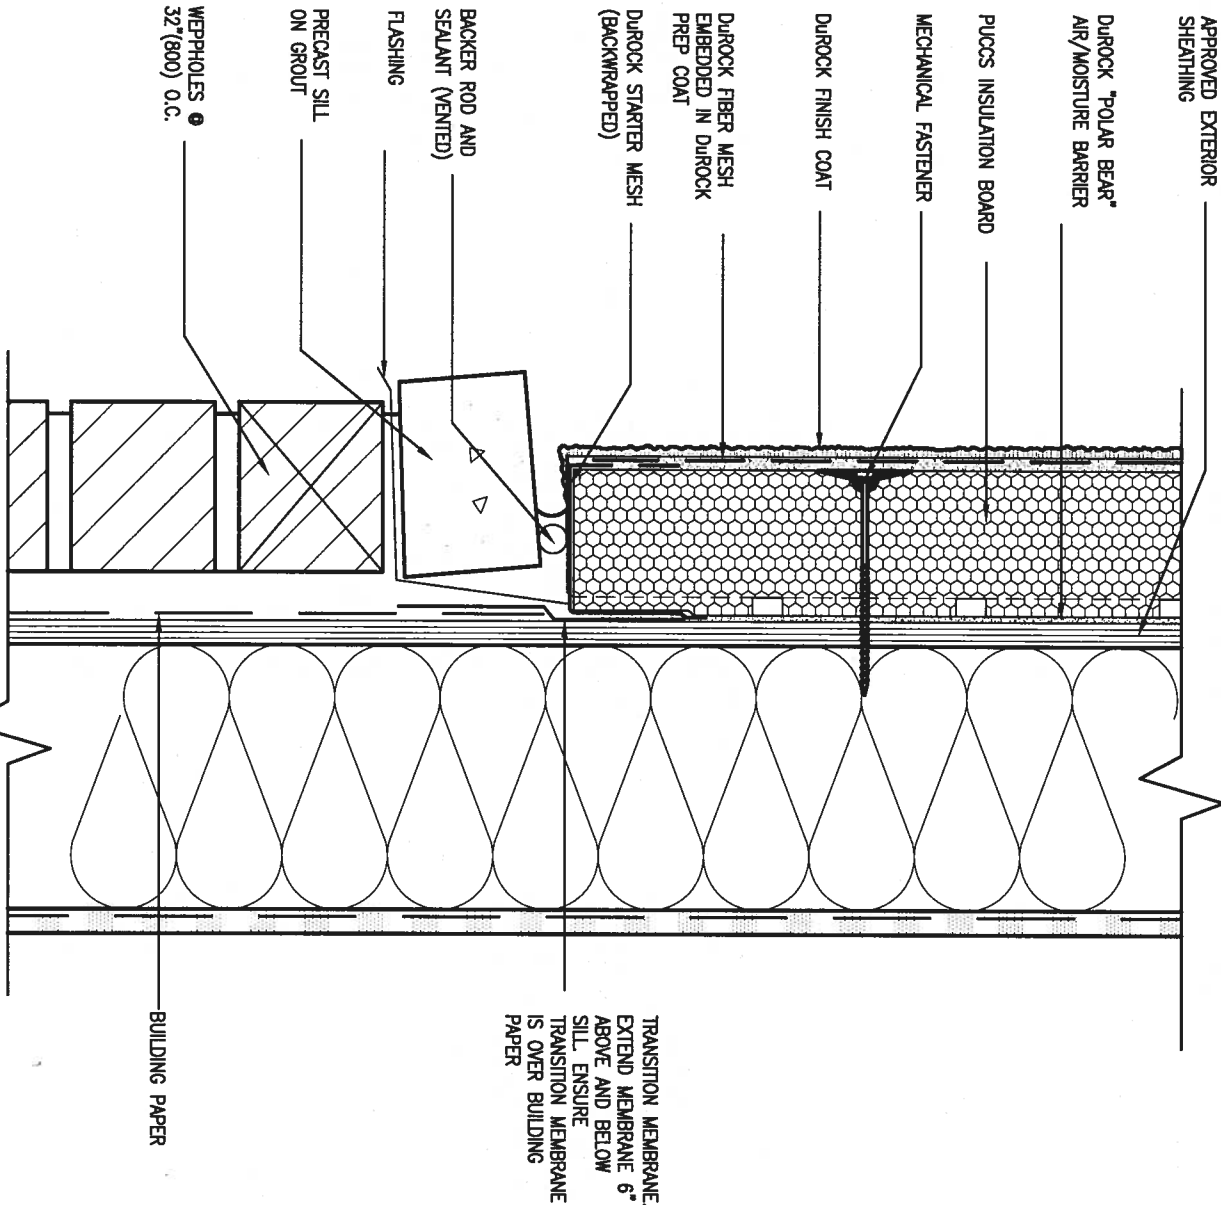

6 STUCCO / MASONRY PLINTH CONNECTION  
CNS SCALE: 3"=1'-0"

9.	.	.
8.	.	.
7.	.	.
6.	.	.
5.	.	.
4.	.	.
3.	.	.
2	UPDATE TO 2018	JAN 11-18 RC
1	ISSUE FOR CLIENT REVIEW	AUG 04-17 RC
no.	description	date by

The undersigned has reviewed and takes responsibility for this design and has the qualifications and meets the requirements set out in the Ontario Building Code to be a Designer.  
qualification information  
Wellington Jno-Baptiste 25591  
name  
registration information  
VA3 Design Inc. 42658  
Contractor must verify all dimensions on the job and report any discrepancy to the Designer before proceeding with the work. All drawings and specifications are instruments of service and the property of the Designer which must be returned at the completion of the work. Drawings are not to be scaled.

**VA3 DESIGN**  
255 Consumers Rd Suite 120  
Toronto ON M2J 1R4  
t 416.630.2255 f 416.630.4782  
va3design.com

**BAYVIEW WELLINGTON**  
**GREEN VALLEY EAST**  
project name  
date MAY 2016  
drawn by RC  
checked by  
scale 3/16" = 1'-0"  
RICHARD - H:\ARCHIVE\WORKING\2016\16023.BW\Units\CN NOTES\16023-CN-A1.dwg - Thu - Jan 11 2018 - 10:10 AM

**CONST NOTE**

project no.  
16023

drawing no.

**CN5**

**CONSTRUCTION NOTES**

file name  
16023-CN-A1


SB12-COMPLIANCE PACKAGE 'A1'

THE MINIMAL THERMAL PERFORMANCE OF BUILDING ENVELOPE AND EQUIPMENT SHALL CONFORM TO THE FOLLOWING SB-12 COMPLIANCE PACKAGE AS PER OBC SUPPLEMENTARY STANDARD SB-12, SECTION 3.1.1.1.


USE SB-12 COMPLIANCE PACKAGE (A1):

COMPONENT	A1	Notes:
Ceiling with Attic Space	10.56	R20 at inner face of exterior walls
Minimum RSI (R) value	(R60)	
Ceiling without Attic Space	5.46	BATT or SPRAY
Minimum RSI (R) value	(R31)	
Exposed Floor	5.46	BATT or SPRAY
Minimum RSI (R) value	(R31)	
Walls Above Grade	3.87	6" R22 BATT
Minimum RSI (R) value	(R22)	
Basement Walls	3.52ci	OPTION TO USE R12+R10ci.
Minimum RSI (R) value	(R20ci)	
Edge of Below Grade Slab ≤600mm below grade	1.76	RIGID INSUL
Minimum RSI (R) value	(R10)	
Windows & Sliding glass Doors	1.6	
Maximum U-value		
Skylights	2.8U	
Maximum U-value		
Space Heating Equipment	96% Min.	NATURAL GAS
Minimum AFUE		
Hot Water Heater	0.8	NATURAL GAS
Minimum EF		
HRV	75%	-
Minimum Efficiency		
Drain Water Heat Recovery Unit (DWHR)	Minimum 1 OR Maximum 2 Required. Dependent on number of showers installed. Refer to SB12-3.1.1.12 for information	

ci- Denotes Continuous Insulation without framing interruption.

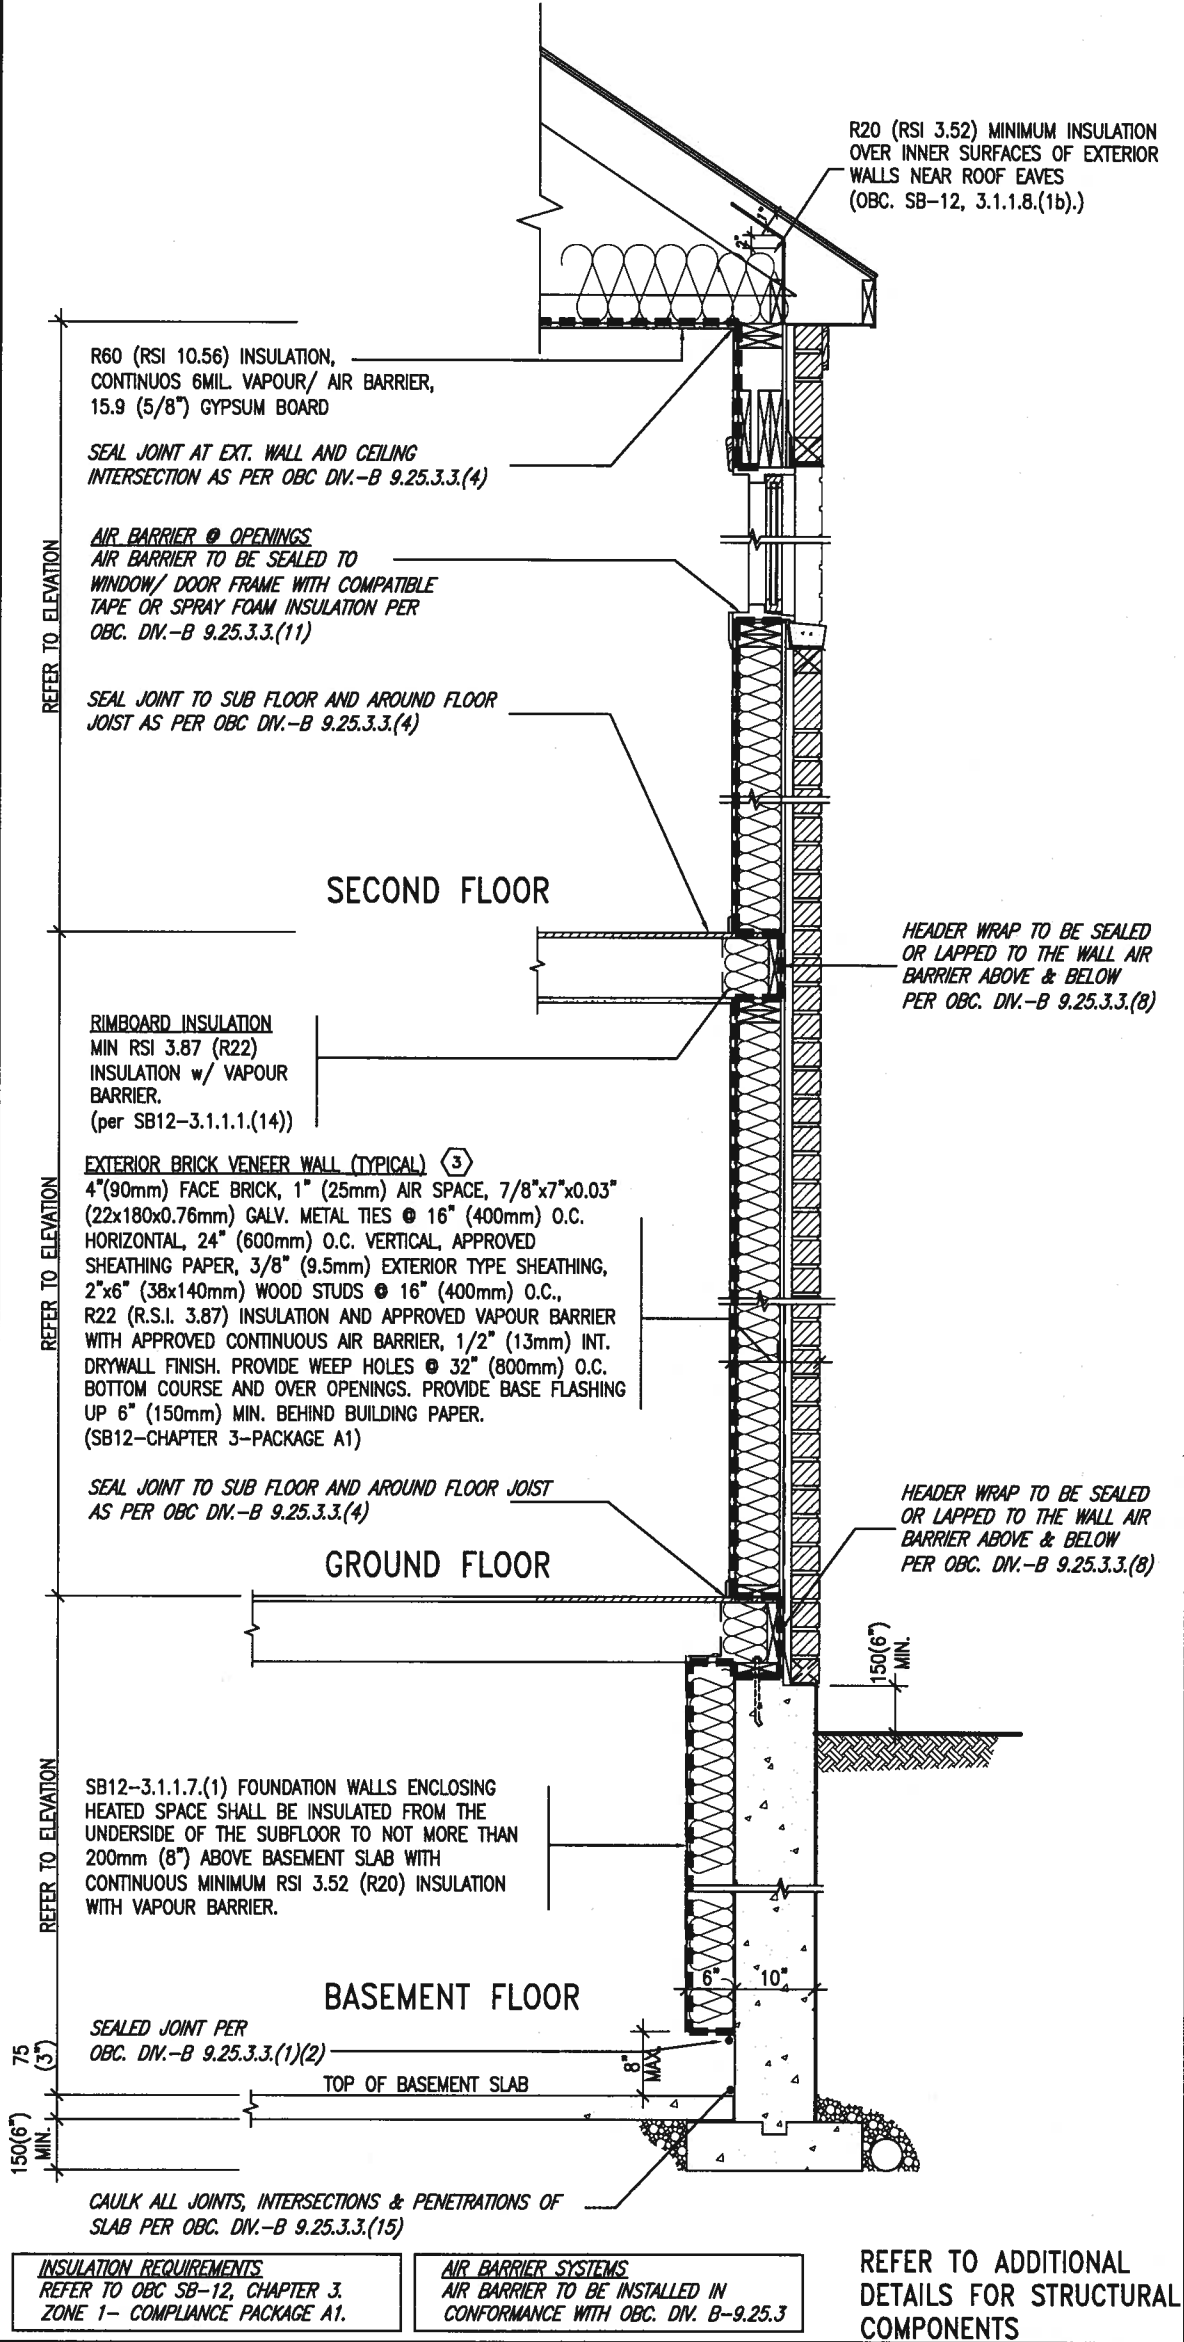

EW TYPICAL EXT. WALL AIR BARRIER CONTINUITY SECTION w/ BRICK VENEER (PACKAGE A1) 10" FOUNDATION WALL SCALE: N.T.S.

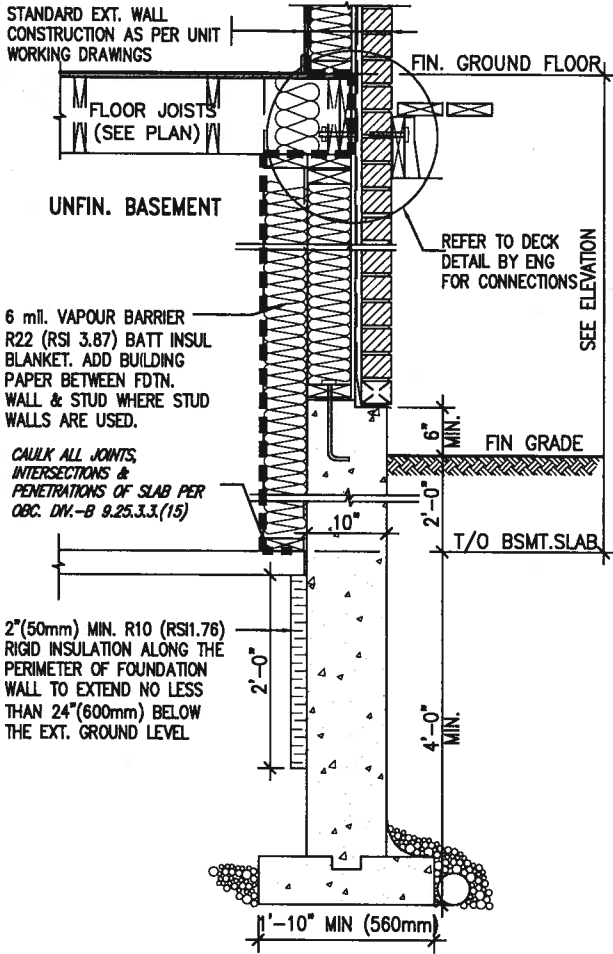

SECTION AT W.O.D/W.O.B. SCALE: N.T.S.

9.				The undersigned has reviewed and takes responsibility for this design and has the qualifications and meets the requirements set out in the Ontario Building Code to be a Designer.		255 Consumers Rd Suite 120 Toronto ON M2J 1R4 t 416.630.2255 f 416.630.4782 va3design.com	BAYVIEW WELLINGTON GREEN VALLEY EAST	CONST NOTE	project no. 16023
8.				qualification information					
7.				Wellington Jno-Baptiste 25591					
6.				name					
5.				registration information					
4.				VA3 Design Inc. 42658					
3.									
2.	UPDATE TO 2018	JAN 11-18	RC	Contractor must verify all dimensions on the job and report any discrepancy to the Designer before proceeding with the work. All drawings and specifications are instruments of service and the property of the Designer which must be returned at the completion of the work. Drawings are not to be scaled.					
1.	ISSUE FOR CLIENT REVIEW	AUG 04-17	RC						
no.	description	date	by						

CONSTRUCTION NOTES


16023-CN-A1

CN6

Richard - H:\ARCHIVE\WORKING\2016\16023.BW\Units\CN NOTES\16023-CN-A1.dwg - Thu - Jan 11 2018 - 10:10 AM



SB12-COMPLIANCE PACKAGE 'A1'

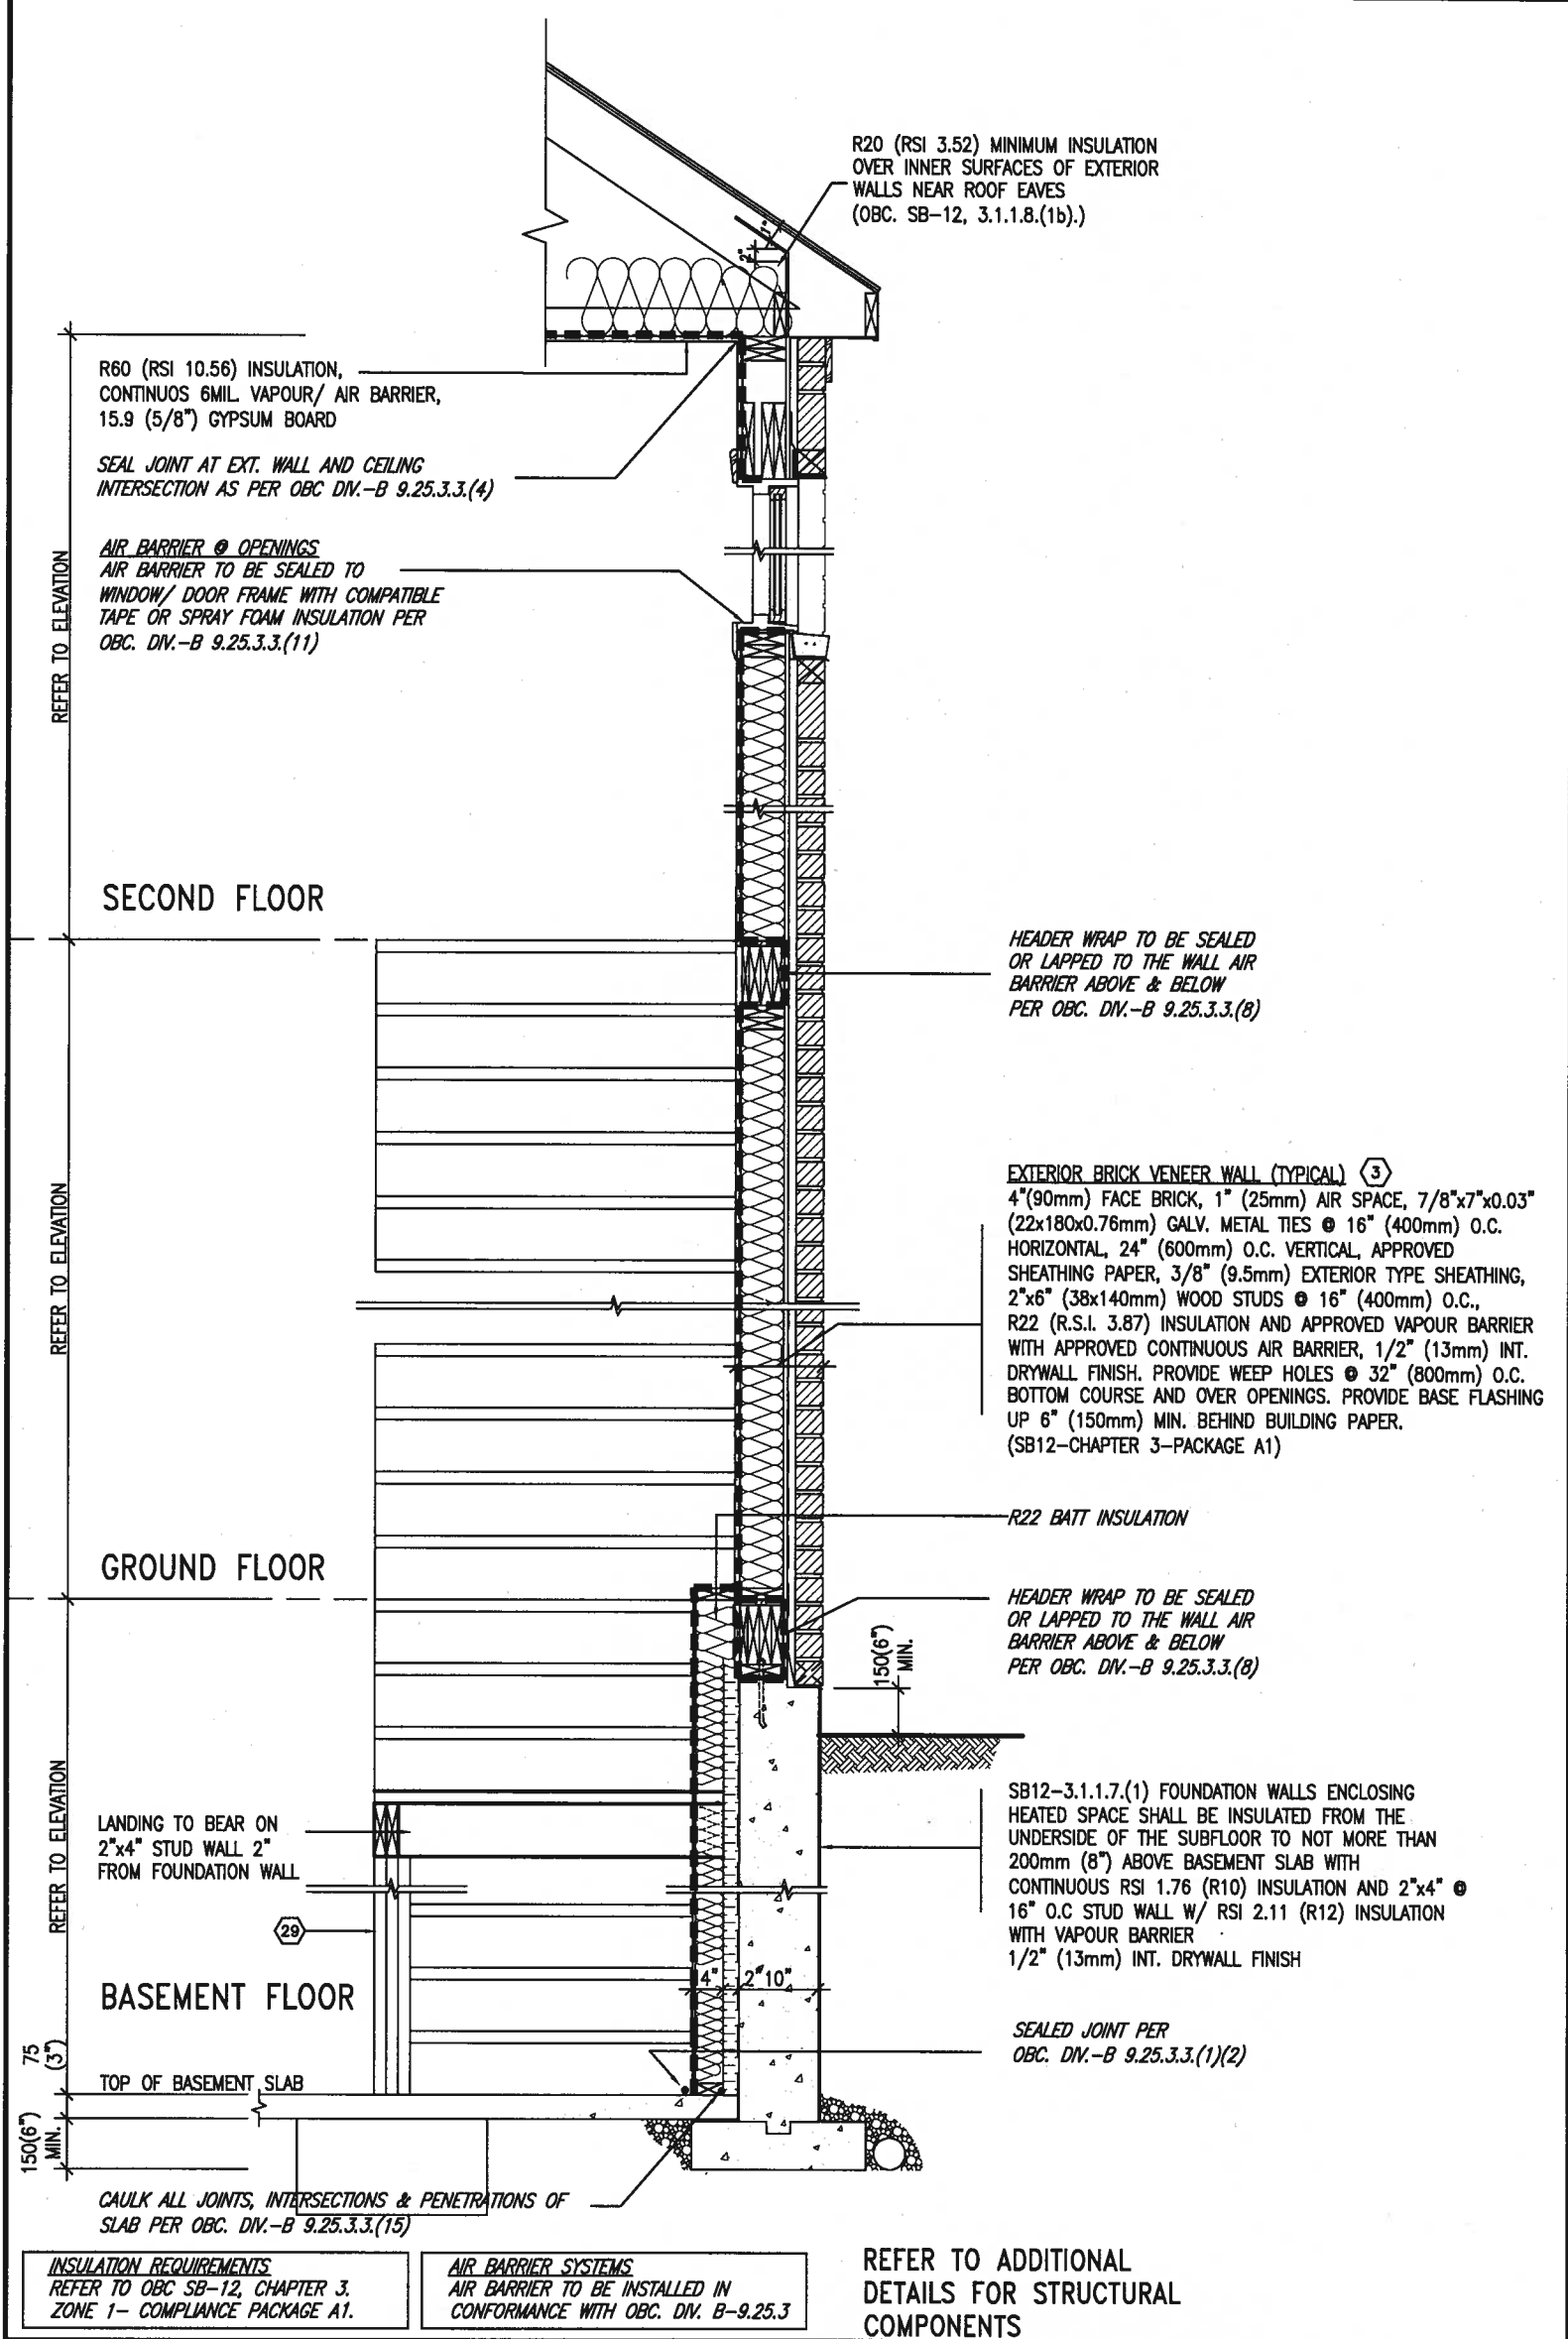


  
JAN 11, 2018

**EW STR** TYPICAL EXT. WALL AIR BARRIER CONTINUITY SECTION w/  
BRICK VENEER AT STAIR AND SUNKEN COND (PACKAGE A1)  
10" FOUNDATION WALL  
SCALE: N.T.S.

9.			The undersigned has reviewed and takes responsibility for this design and has the qualifications and meets the requirements set out in the Ontario Building Code to be a Designer.			 <div>255 Consumers Rd Suite 120 Toronto ON M2J 1R4 t 416.630.2255 f 416.630.4782 va3design.com</div>	BAYVIEW WELLINGTON		CONST NOTE	
8.			qualification information				project name		project no.	
7.			Wellington Jno-Baptiste 25591				GREEN VALLEY EAST		16023	
6.			name				municipality			
5.			signature				BRADFORD			
4.			BCN			date		CONSTRUCTION NOTES		drawing no.
3.			VA3 Design Inc. 42658			MAY 2016		16023-CN-A1		CN7
2. UPDATE TO 2018			JAN 11-18 RC			drum by		checked by		scale
1. ISSUE FOR CLIENT REVIEW			AUG 04-17 RC			RC		-		3/16" = 1'-0"
no. description			date by			RICHARD - H:\ARCHIVE\WORKING\2016\16023.BW\Units\CN NOTES\16023-CN-A1.dwg - Thu - Jan 11 2018 - 10:10 AM				

COMPLIANCE TO OBC SB-12 2.1.1.1(11)

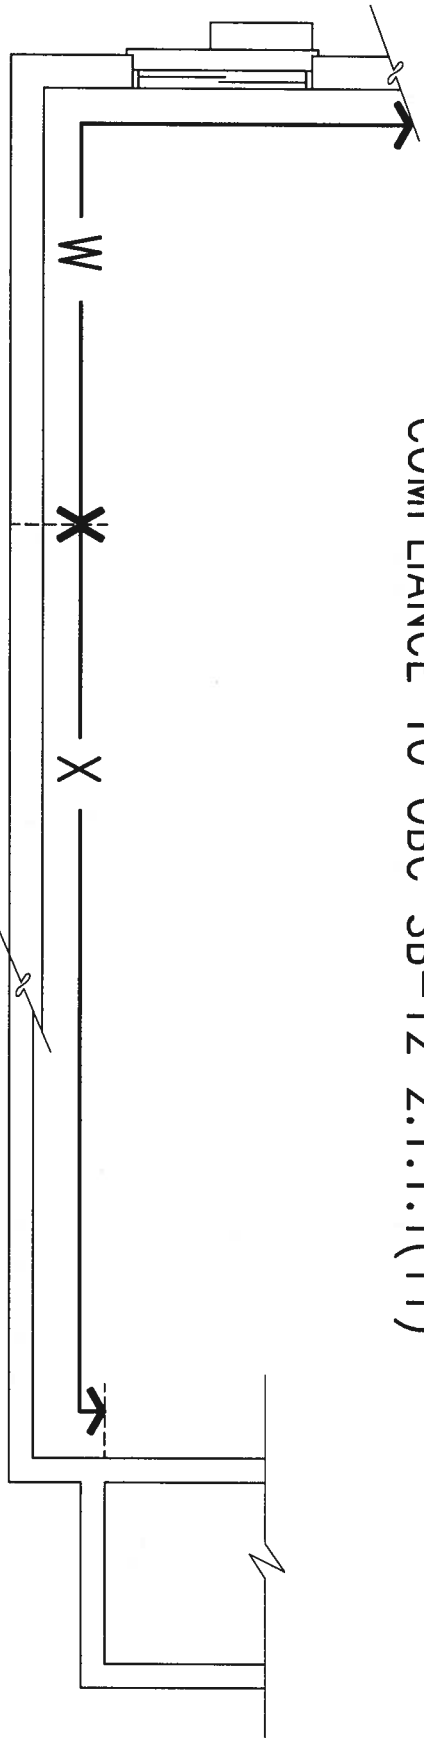

JAN 11, 2018


WOB PLAN

FINISHED SECOND FLOOR

FINISHED GROUND FLOOR

FINISHED FLOOR

U/S OF FLOOR JOIST

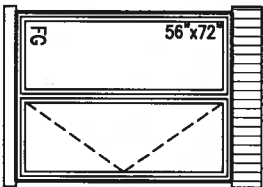

B

W

A

MID-POINT OF BASEMENT HEIGHT 'B'

X

FINISHED GRADE

FINISHED BASEMENT FLOOR

WOB SIDE ELEVATION

WHEN EXPOSED WALL "A" IS GREATER THAN 50% OF BASEMENT WALL HEIGHT "B" INSULATION VALUE FOR WALL IN SECTION "W" IS NOT LESS THAN IS REQUIRED FOR ABOVE GRADE WALL AS REQUIRED BY TABLE 2.1.1.2A

WHEN EXPOSED WALL "A" IS LESS THAN 50% OF BASEMENT WALL HEIGHT "B" INSULATION VALUE FOR WALL IN SECTION "X" IS NOT LESS THAN BASEMENT WALL AS REQUIRED BY TABLE 2.1.1.2A

9.	.	.	.
8.	.	.	.
7.	.	.	.
6.	.	.	.
5.	.	.	.
4.	.	.	.
3.	.	.	.
2.	UPDATE TO 2018	JAN 11-18	RC
1.	ISSUE FOR CLIENT REVIEW	AUG 04-17	RC
no.	description	date	by

The undersigned has reviewed and takes responsibility for this design and has the qualifications and meets the requirements set out in the Ontario Building Code to be a Designer.			
qualification information			
Wellington Jno-Baptiste	signature	25591	BCN
name			
registration information			
VA3 Design Inc.			
42658			
Contractor must verify all dimensions on the job and report any discrepancy to the Designer before proceeding with the work. All drawings and specifications are instruments of service and the property of the Designer which must be returned at the completion of the work. Drawings are not to be scaled.			

**VA3**  
**DESIGN**

255 Consumers Rd Suite 120  
Toronto ON M2J 1R4  
t 416.630.2255 f 416.630.4782  
va3design.com

**BAYVIEW WELLINGTON**  
project name  
**GREEN VALLEY EAST**  
multiplicity  
**BRADFORD**


date  
**MAY 2016**  
drawn by  
**RC**  
checked by  
**-**  
scale  
**3/16" = 1'-0"**

**CONSTRUCTION NOTES**  
file name  
**16023-CN-A1**


project no.  
**16023**  
drawing no.  
**CN8**

**CONST NOTE**



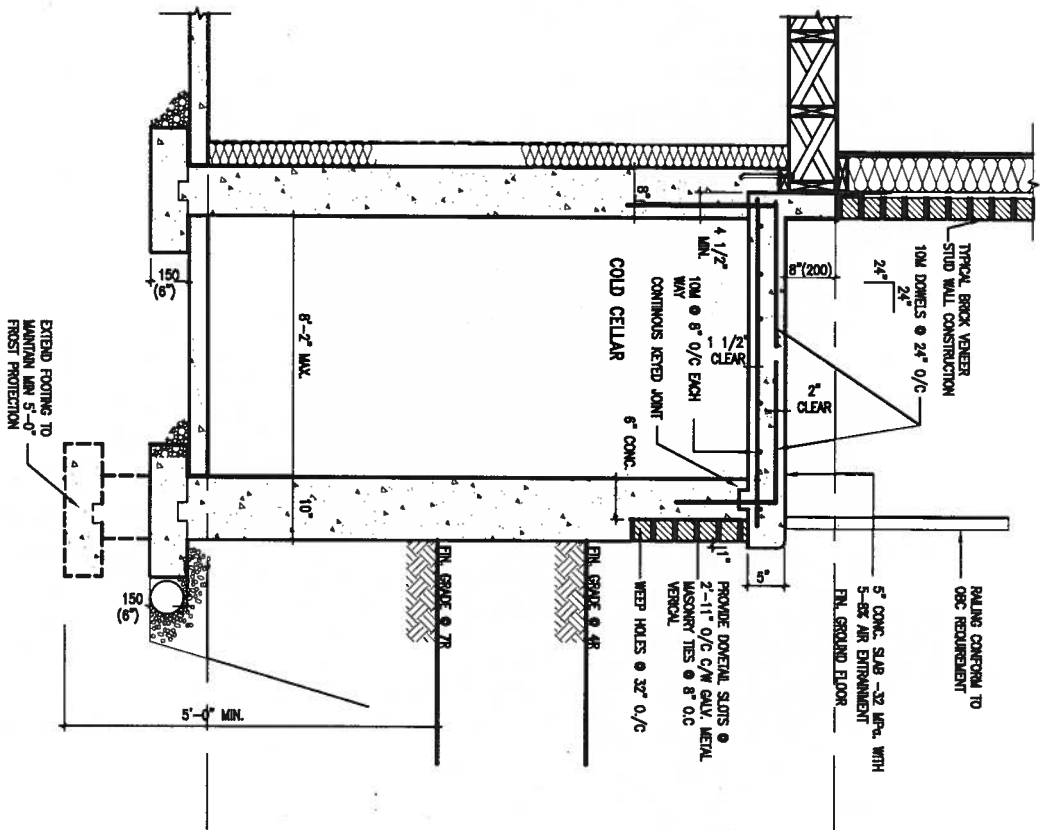

**X1** SECTION AT PORCH FOR 4-7R CONDITION  
SCALE: N.T.S.

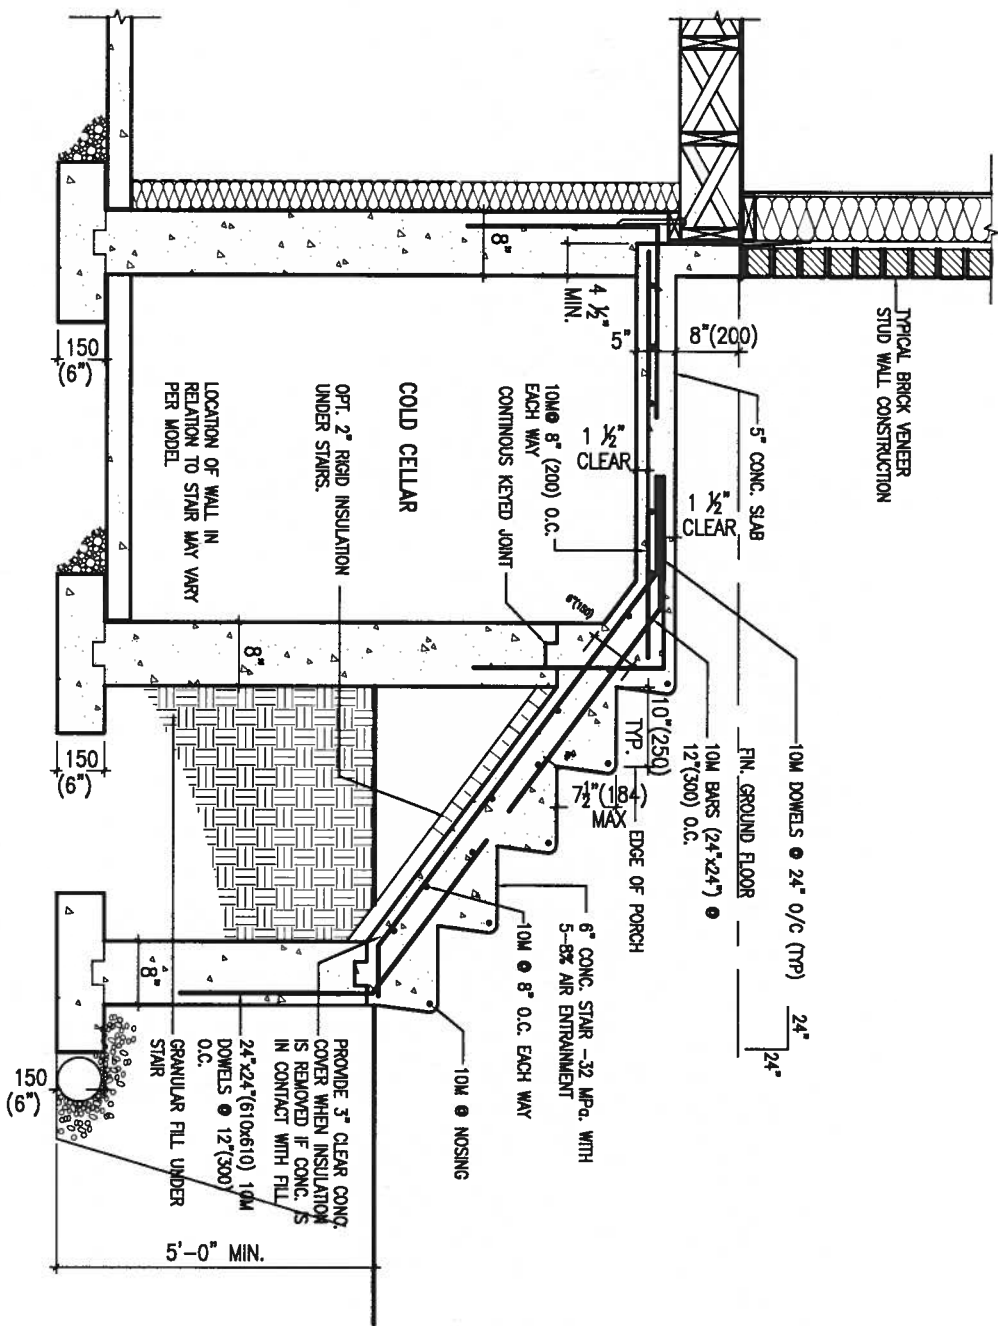

**X2** EXTERIOR CONC. STAIR DETAIL (6 RISERS/ 7 RISERS SIMILAR)  
SCALE: N.T.S.



JAN 11, 2018

9.			
8.			
7.			
6.			
5.			
4.			
3.			
2.	UPDATE TO 2018	JAN 11-18	RC
1.	ISSUE FOR CLIENT REVIEW	AUG 04-17	RC
no.	description	date	by

The undersigned has reviewed and takes responsibility for this design and has the qualifications and meets the requirements set out in the Ontario Building Code to be a Designer.			
qualification information			
Wellington Jno-Baptiste	25591	BCN	
name registration information			
VA3 Design Inc.	42658		
Contractor must verify all dimensions on the job and report any discrepancy to the Designer before proceeding with the work. All drawings and specifications are instruments of service and the property of the Designer which must be returned at the completion of the work. Drawings are not to be scaled.			

**VA3 DESIGN**

255 Consumers Rd Suite 120  
Toronto ON M2J 1R4  
t 416.630.2255 f 416.630.4782  
va3design.com

**BAYVIEW WELLINGTON**

project name: GREEN VALLEY EAST  
municipality: BRADFORD


date: MAY 2016  
drawn by: RC  
checked by: -  
scale: 3/16" = 1'-0"

**CONST NOTE**


project no. 16023

**CONSTRUCTION NOTES**


file name: 16023-CN-A1  
drawing no. **CN9**

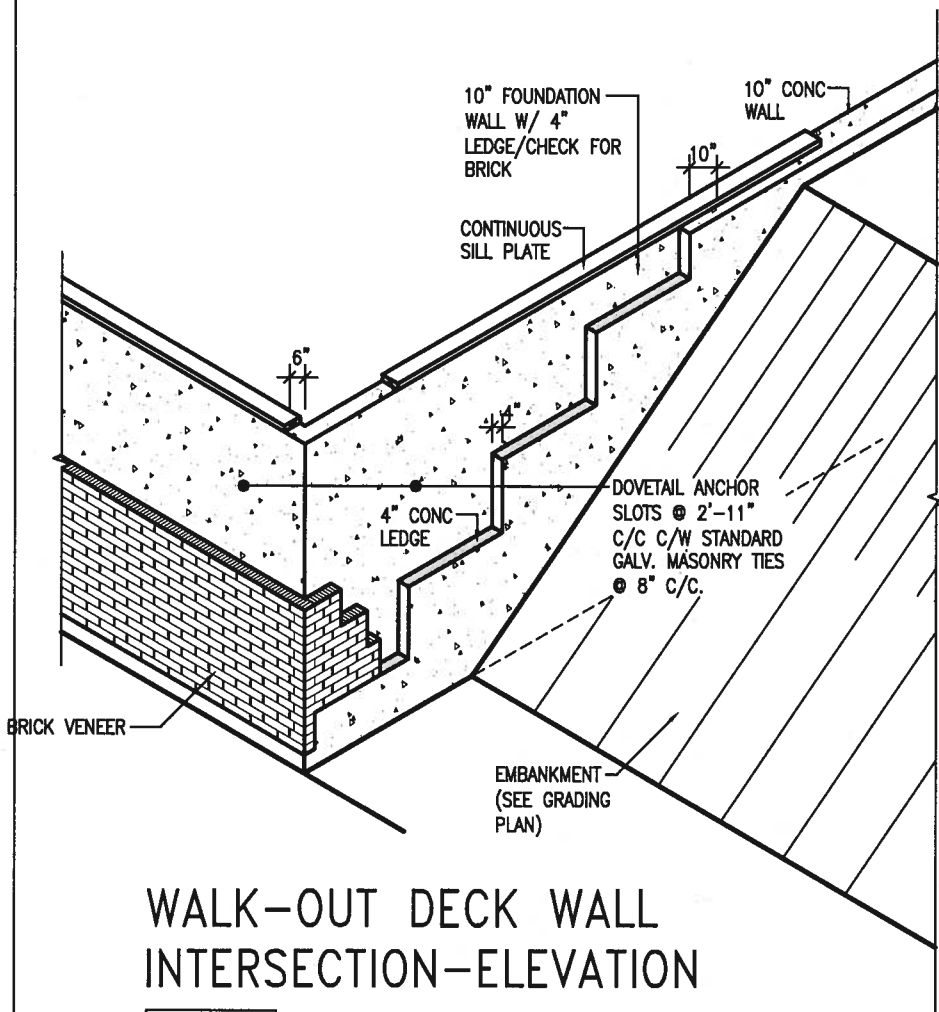


WALK-OUT DECK WALL  
INTERSECTION-ELEVATION  
NOT TO SCALE

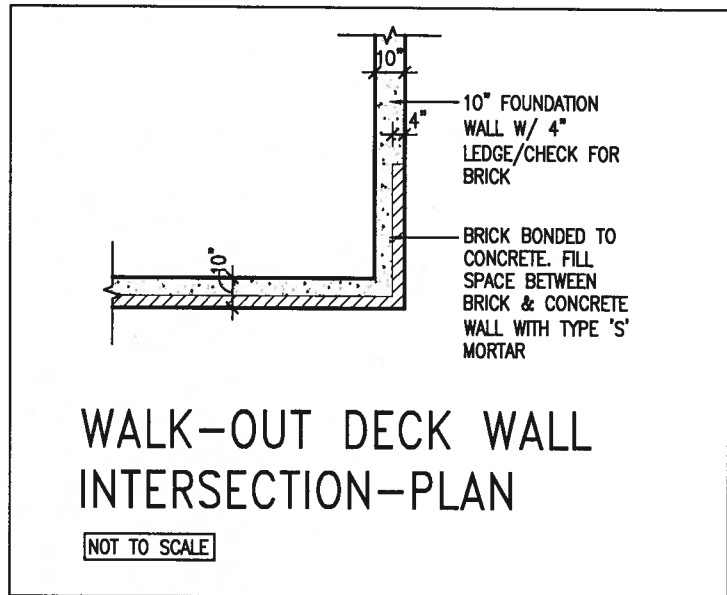

WALK-OUT DECK WALL  
INTERSECTION-PLAN  
NOT TO SCALE  
(10" FOUNDATION WALL)

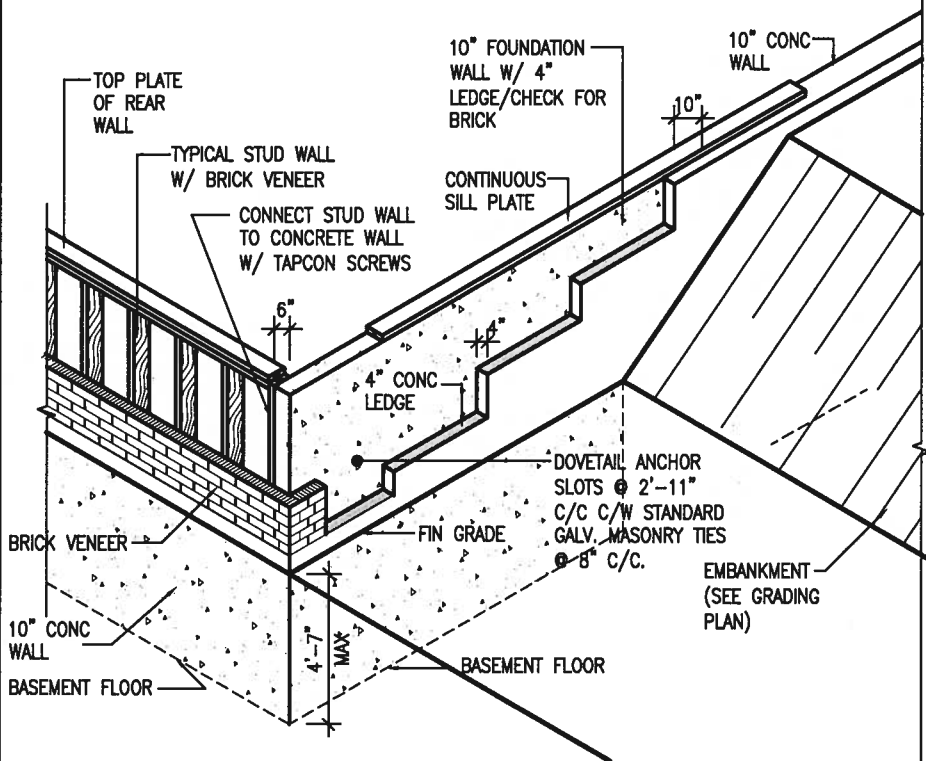

WALK-OUT DECK WALL  
INTERSECTION-ELEVATION MAX  
4'-7" BACKFILL  
NOT TO SCALE

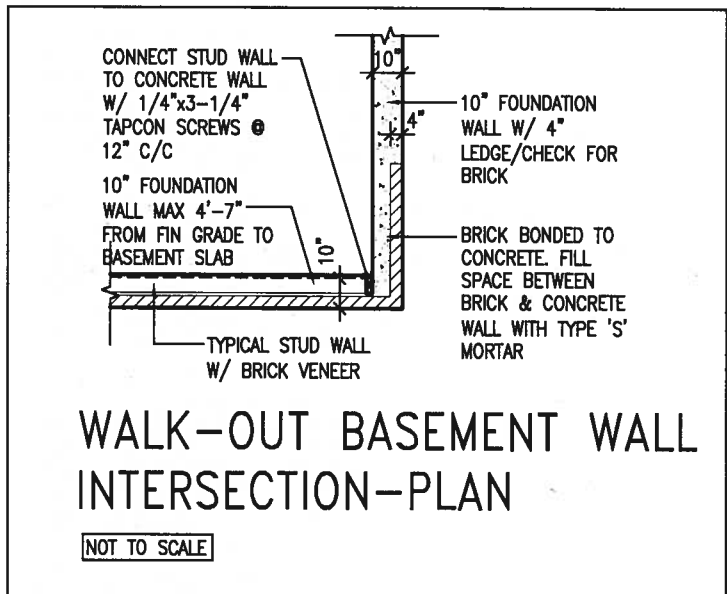

WALK-OUT BASEMENT WALL  
INTERSECTION-PLAN  
NOT TO SCALE  
(10" FOUNDATION WALL)



JAN 11, 2018

9.					
8.					
7.					
6.					
5.					
4.					
3.					
2.	UPDATE TO 2018	JAN 11-18	RC		
1.	ISSUE FOR CLIENT REVIEW	AUG 04-17	RC		
no.	description	date	by		

The undersigned has reviewed and takes responsibility for this design and has the qualifications and meets the requirements set out in the Ontario Building Code to be a Designer.

qualification information  
Wellington Jno-Baptiste 25591  
name  
registration information  
VA3 Design Inc. 42658

Contractor must verify all dimensions on the job and report any discrepancy to the Designer before proceeding with the work. All drawings and specifications are instruments of service and the property of the Designer which must be returned at the completion of the work. Drawings are not to be scaled.

**VA3**  
**DESIGN**

255 Consumers Rd Suite 120  
Toronto ON M2J 1R4  
t 416.630.2255 f 416.630.4782  
va3design.com

**BAYVIEW WELLINGTON**  
**GREEN VALLEY EAST**

project name  
municipality  
BRADFORD

**CONST NOTE**

project no.  
16023


**CONSTRUCTION NOTES**

file name  
16023-CN-A1

drawing no.  
**CN10**


date  
MAY 2016  
drawn by  
RC  
checked by  
-  
scale  
3/16" = 1'-0"  
RICHARD - H:\ARCHIVE\WORKING\2016\16023.BW\Units\CN NOTES\16023-CN-A1.dwg - Thu - Jan 11 2018 - 10:09 AM



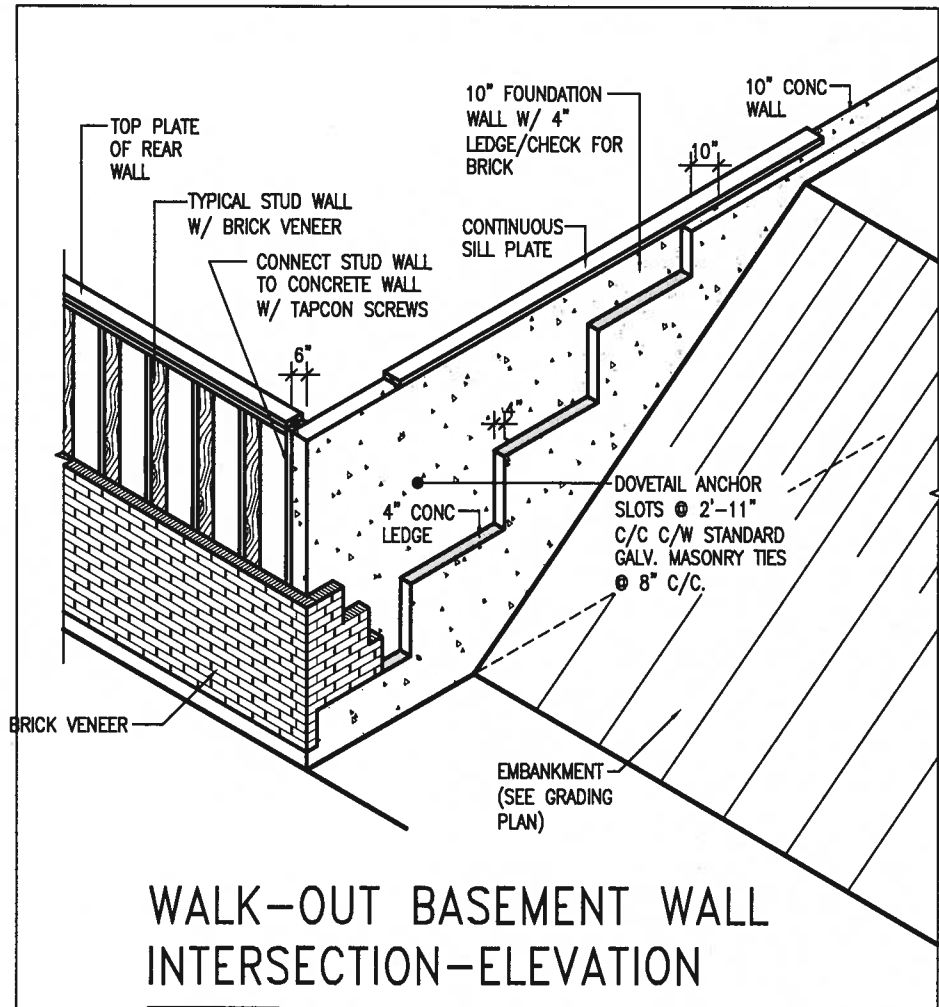

WALK-OUT BASEMENT WALL  
INTERSECTION-ELEVATION


NOT TO SCALE

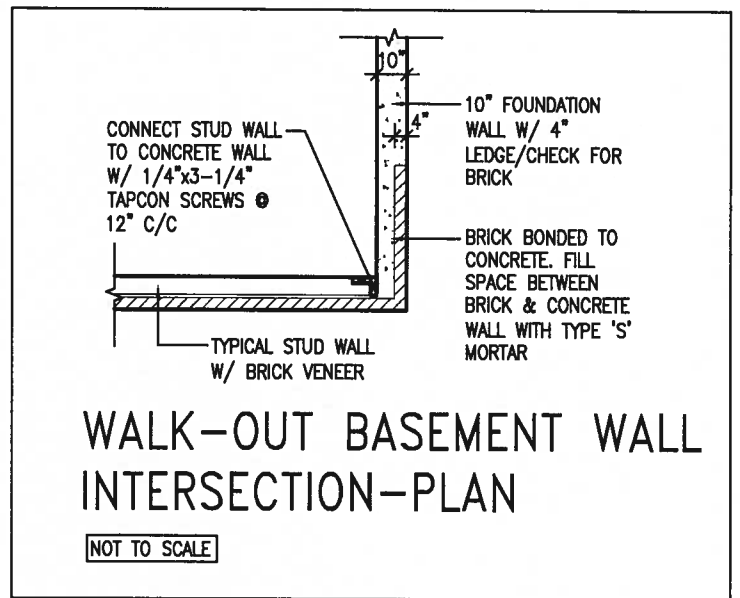

WALK-OUT BASEMENT WALL  
INTERSECTION-PLAN

NOT TO SCALE


(10" FOUNDATION WALL)

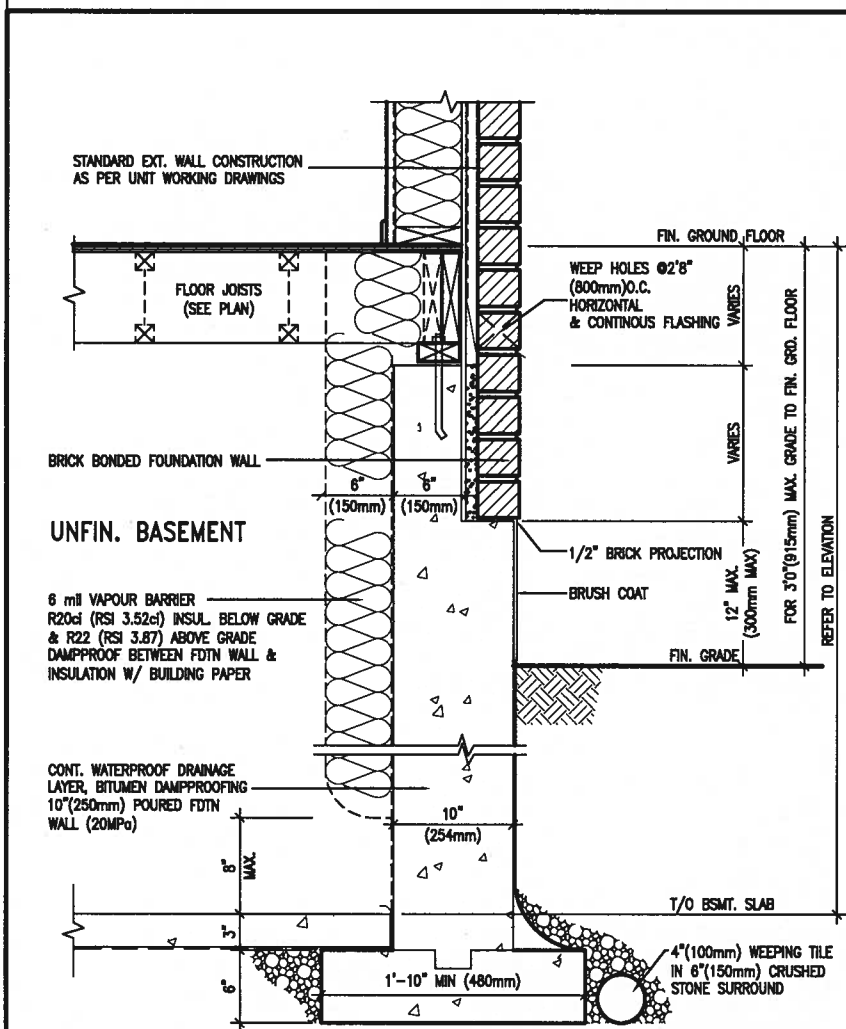

EW3.06x  
PKG A1

WALL SECTION FOR GRADE TO FIN.  
FLOOR MORE THAN 4'7" (1400mm)  
HEIGHT DIFFERENCE

SCALE: N.T.S.

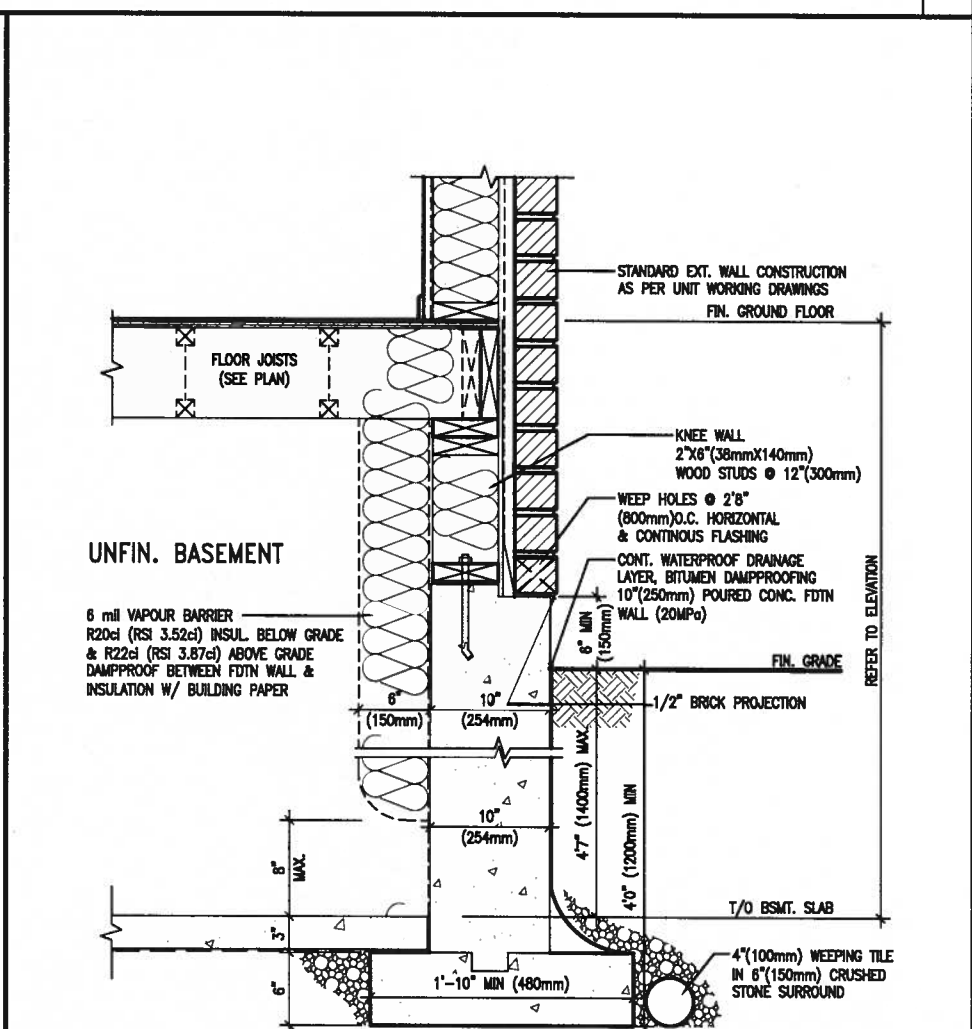

EW3.07x  
PKG A1

WALL SECTION FOR GRADE TO BASEMENT  
SLAB 4'7" (1400mm)  
MAX. HEIGHT DIFFERENCE

SCALE: N.T.S.



9.					
8.					
7.					
6.					
5.					
4.					
3.					
2.	UPDATE TO 2018	JAN 11-18	RC		
1.	ISSUE FOR CLIENT REVIEW	AUG 04-17	RC		
no.	description	date	by		

**VA3 DESIGN**

255 Consumers Rd Suite 120  
Toronto ON M2J 1R4  
t 416.630.2255 f 416.630.4782  
va3design.com

**BAYVIEW WELLINGTON**

**GREEN VALLEY EAST**

project name  
municipality  
BRADFORD

date  
MAY 2016

drawn by  
RC

checked by  
-

scale  
3/16" = 1'-0"

CONSTRUCTION NOTES

file name  
16023-CN-A1

drawing no.  
CN11

**CONST NOTE**

project no.  
16023

drawing no.  
CN11

PREFIN. METAL ROOF  
CAP OVER WATERPROOF  
MEMBRANE

5/8" T&G PLYWOOD  
SHEATHING ON 2"x4"  
SLOPED TO FRONT

2"x12" LEDGER

2"x12" @ HEADER

3"x3"x1 1/16" GALVANIZED  
STANLEY CORNER BRACE  
C/W (4) No. 10x1 1/2"  
SCREWS AT 4'-0" O.C.

PREFIN. ALUM. FASCIA  
AND SOFFIT AT U/S

DRIP EDGE

STL. LINTEL

TYPICAL BRICK VENEER  
WALL CONSTRUCTION

HEATED SPACE

ENG. FLOOR JOIST

SECOND FLOOR

MIN. 6" PREFIN. METAL FLASHING W/  
CAULKING TO MATCH BRICK/STONE

BUILT-UP CANOPY BOLTED THRU  
LVL/WOOD BEAM (SEE UNIT PLANS) W/  
1/2" Ø BOLTS STAGGERED @ 24" O.C.  
W/ SOLID WD. BLK. BETWEEN STUDS

1

CN12

SECTION THROUGH CANOPY

SCALE 1/2" = 1'-0"




JAN 11, 2018

9	.	.	.	The undersigned has reviewed and takes responsibility for this design and has the qualifications and meets the requirements set out in the Ontario Building Code to be a Designer. qualification information Wellington Jno-Baptiste <i>J. Baptiste</i> 25591 name <i>signature</i> BCN registration information VA3 Design Inc. 42658	<b>VA3 DESIGN</b> 255 Consumers Rd Suite 120 Toronto ON M2J 1R4 t 416.630.2255 f 416.630.4782 va3design.com	<b>BAYVIEW WELLINGTON</b> project name <b>GREEN VALLEY EAST</b> drawing no. <b>CN12</b>	<b>CONST NOTE</b> - project no. 16023
8	.	.	.				
7	.	.	.				
6	.	.	.				
5	.	.	.				
4	.	.	.				
3	.	.	.				
2	UPDATE TO 2018	JAN 11-18	RC				
1	ISSUE FOR CLIENT REVIEW	AUG 04-17	RC				
no.	description	date	by				

All drawings specifications, related documents and design are the copyright property of VA3 DESIGN. Reproduction of this property in whole or in part is strictly prohibited without VA3 DESIGN's written permission.



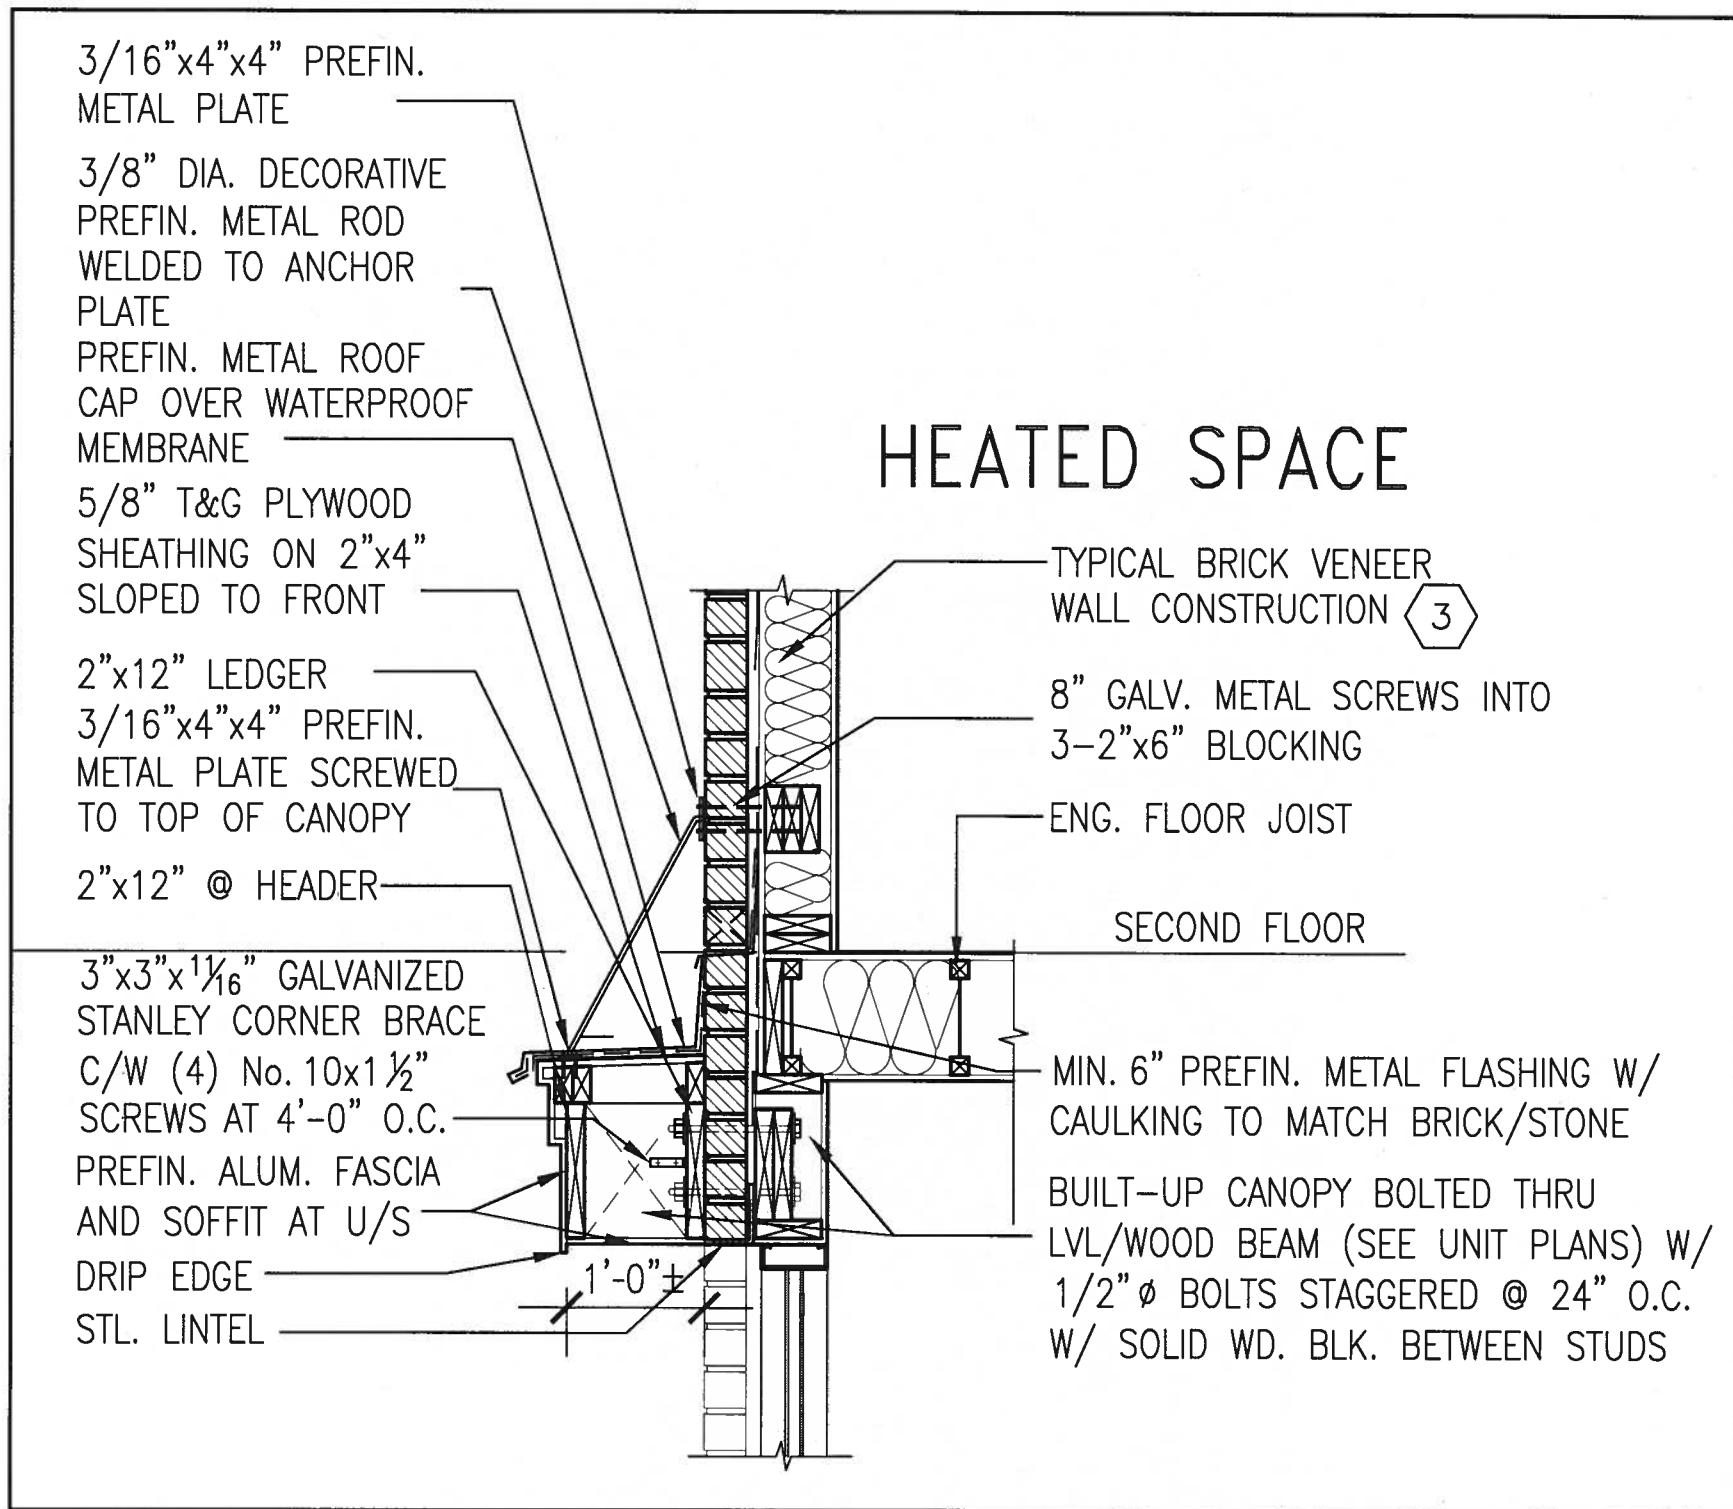

1  
CN13

## SECTION THROUGH CANOPY

W/ DECORATIVE ROD

SCALE 1/2" = 1'-0"



JAN 11, 2018

9.	.	.	<div>The undersigned has reviewed and takes responsibility for this design and has the qualifications and meets the requirements set out in the Ontario Building Code to be a Designer.</div> <div>qualification information</div> <div>Wellington Jno-Baptiste  25591</div> <div>name</div> <div>BCIN</div> <div>registration information</div> <div>VA3 Design Inc. 42658</div>	<div></div> <div>255 Consumers Rd Suite 120</div> <div>Toronto ON M2J 1R4</div> <div>t 416.630.2255 f 416.630.4782</div> <div>va3design.com</div>	<div><b>BAYVIEW WELLINGTON</b></div> <div>project name</div> <div><b>GREEN VALLEY EAST</b></div> <div>municipality</div> <div><b>BRADFORD</b></div> <div>project no.</div> <div><b>16023</b></div>	<div><b>CONST NOTE</b></div> <div>-</div> <div>drawing no.</div> <div><b>CN13</b></div>					
8.	.	.									
7.	.	.									
6.	.	.									
5.	.	.									
4.	.	.									
3.	.	.									
2.	UPDATE TO 2018	JAN 11-18	RC	Contractor must verify all dimensions on the job and report any discrepancy to the Designer before proceeding with the work. All drawings and specifications are instruments of service and the property of the Designer which must be returned at the completion of the work. Drawings are not to be scaled.	date	MAY 2016	checked by	scale	3/16" = 1'-0"	file name	16023-CN-A1
1	ISSUE FOR CLIENT REVIEW	AUG 04-17	RC		RC						
no.	description	date	by								

3/16"x4"x4" PREFIN.  
METAL PLATE

3/8" DIA. DECORATIVE  
PREFIN. METAL ROD  
WELDED TO ANCHOR  
PLATE

PREFIN. METAL ROOF  
CAP OVER WATERPROOF  
MEMBRANE

5/8" T&G PLYWOOD  
SHEATHING ON 2"x4"  
SLOPED TO FRONT

2"x12" LEDGER

3/16"x4"x4" PREFIN.  
METAL PLATE SCREWED  
TO TOP OF CANOPY

2"x12" @ HEADER

3"x3"x1 1/8" GALVANIZED  
STANLEY CORNER BRACE  
C/W (4) No. 10x1 1/2"  
SCREWS AT 4'-0" O.C.

PREFIN. ALUM. FASCIA  
AND SOFFIT AT U/S

DRIP EDGE

STL. LINTEL

8" GALV. METAL SCREWS INTO  
3-2"x6" BLOCKING

PREFINISHED METAL FLASHING  
OVER WATERPROOF MEMBRANE

2"x6" @ 12" O.C. NAILED TO  
2"x8" JOIST BELOW

CANT STRIP

ROOF NOTE R1

SINGLE PLY ROOF MEMBRANE

W/5/8" EXTERIOR GRADE

SHEATHING W/ 2"x4" @ 12"

O.C. DIAGONALLY CUT CROSS

PURLINS 2"x8" @ 16" O.C. W/

MIN. 6" PREFIN. METAL FLASHING W/  
CAULKING TO MATCH BRICK/STONE

BUILT-UP CANOPY BOLTED THRU

LVL/WOOD BEAM (SEE UNIT PLANS) W/

1/2" Ø BOLTS STAGGERED @ 24" O.C.

W/ SOLID WD. BLK. BETWEEN STUDS

1

CN14

## SECTION THROUGH CANOPY

W/ DECORATIVE ROD

SCALE 1/2" = 1'-0"



JAN 11, 2018

9.				The undersigned has reviewed and takes responsibility for this design and has the qualifications and meets the requirements set out in the Ontario Building Code to be a Designer.	
8.				qualification information	
7.				Wellington Jno-Baptiste 25591	
6.				name	
5.				signature	
4.				registration information	
3.				VA3 Design Inc. 42658	
2.	UPDATE TO 2018	JAN 11-18	RC	Contractor must verify all dimensions on the job and report any discrepancy to the Designer before proceeding with the work. All drawings and specifications are instruments of service and the property of the Designer which must be returned at the completion of the work. Drawings are not to be scaled.	
1.	ISSUE FOR CLIENT REVIEW	AUG 04-17	RC		
no.	description	date	by		

<b>VA3 DESIGN</b>	<b>BAYVIEW WELLINGTON</b>	<b>CONST NOTE</b>
255 Consumers Rd Suite 120 Toronto ON M2J 1R4 t 416.630.2255 f 416.630.4782 va3design.com	<b>GREEN VALLEY EAST</b>	<b>BRADFORD</b>
date MAY 2018	checked by RC	scale 3/16" = 1'-0"
CONSTRUCTION NOTES		file name 16023-CN-A1
RICHARD - H:\ARCHIVE\WORKING\2016\16023.BW\Units\CN NOTES\16023-CN-A1.dwg - Thu - Jan 11 2018 - 10:19 AM		drawing no. <b>CN14</b>