
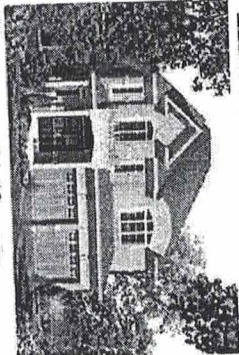
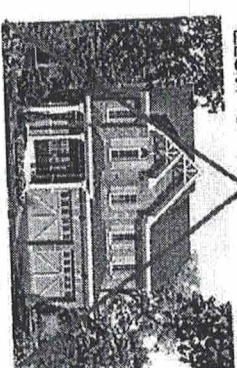


see Attached Extra LOT# 31D

THE Cedar RIDGE-4

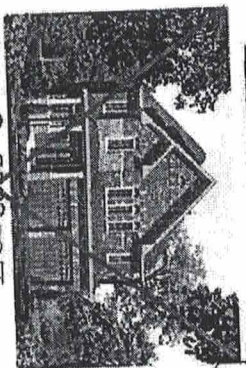


Elev. - B - 2572 SQ.FT.



40 ft.

E.&O.E.



MAIN FLOOR

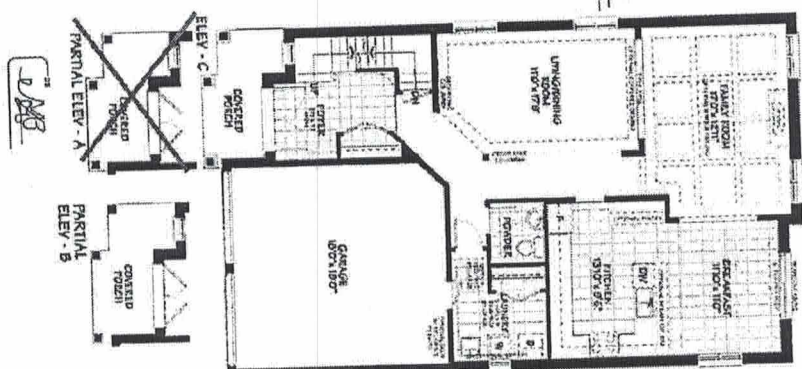


SECOND FLOOR

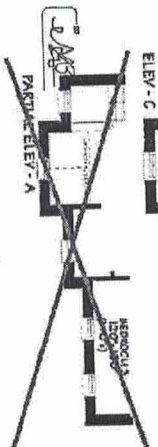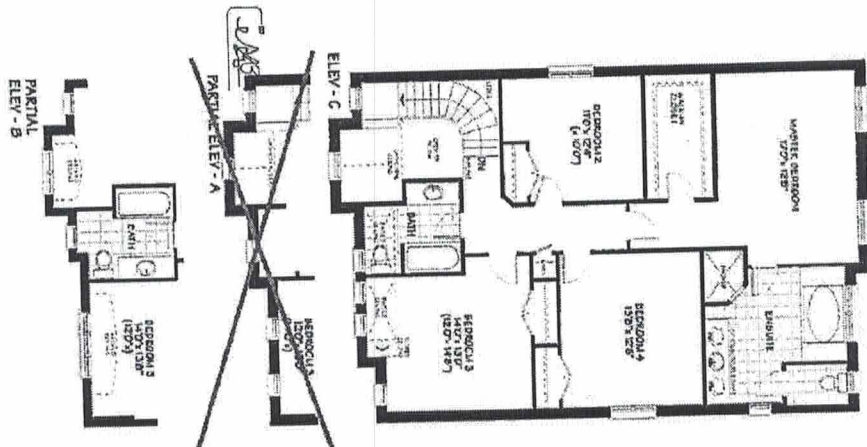

OPT. SECOND FLOOR

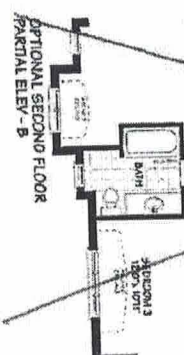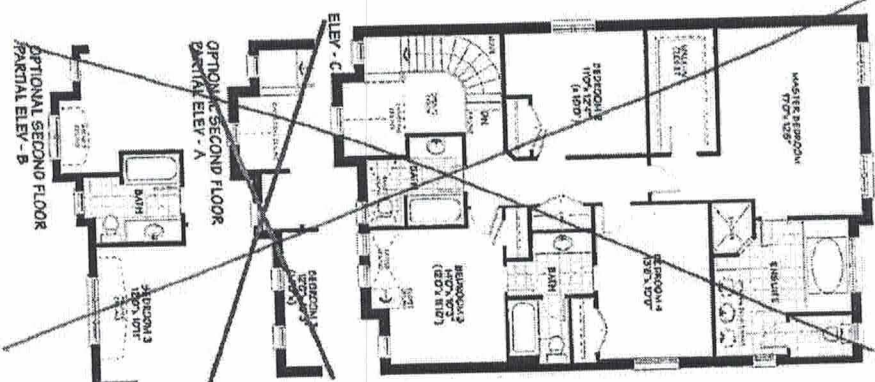

BASEMENT

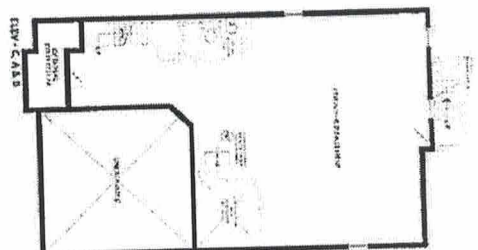

Schedule D-

As plans, dimensions, and quantities are approximate and subject to change without notice, As-built values may vary from the listed floor area.

As-built concept E & D.C.




DEL PARK
HOMES




CEDAR
Rapids
IN SUTTON

—DS

2/23

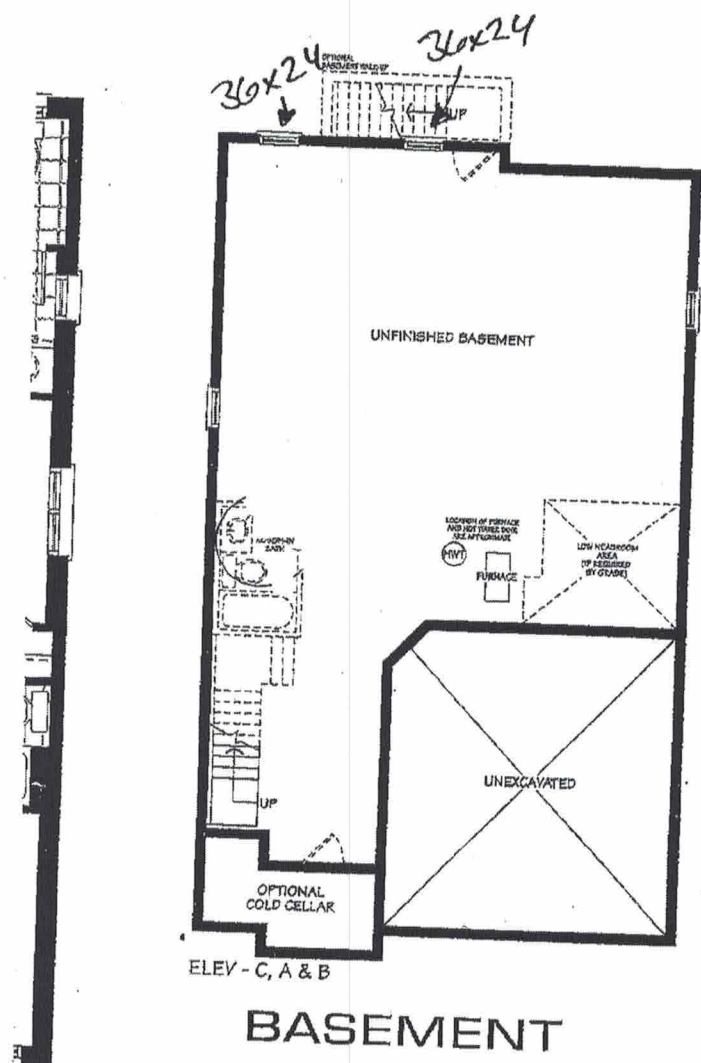

A/C unit

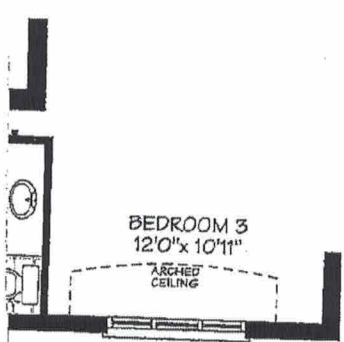

DELPARK HOMES

All plans, dimensions and specifications are approximate and subject to change without notice. Actual usable floorspace may vary from the stated floor area.
Artist concept E.&O.E.


JUN 09 2023

Cedar Ridge 4
Lot 31D MB

4

Undermount sink
 Quartz countertop
 42" Extended Upper
 Fridge Upper w/gable
 R/I water

Oak Stairs
 Upg Stain

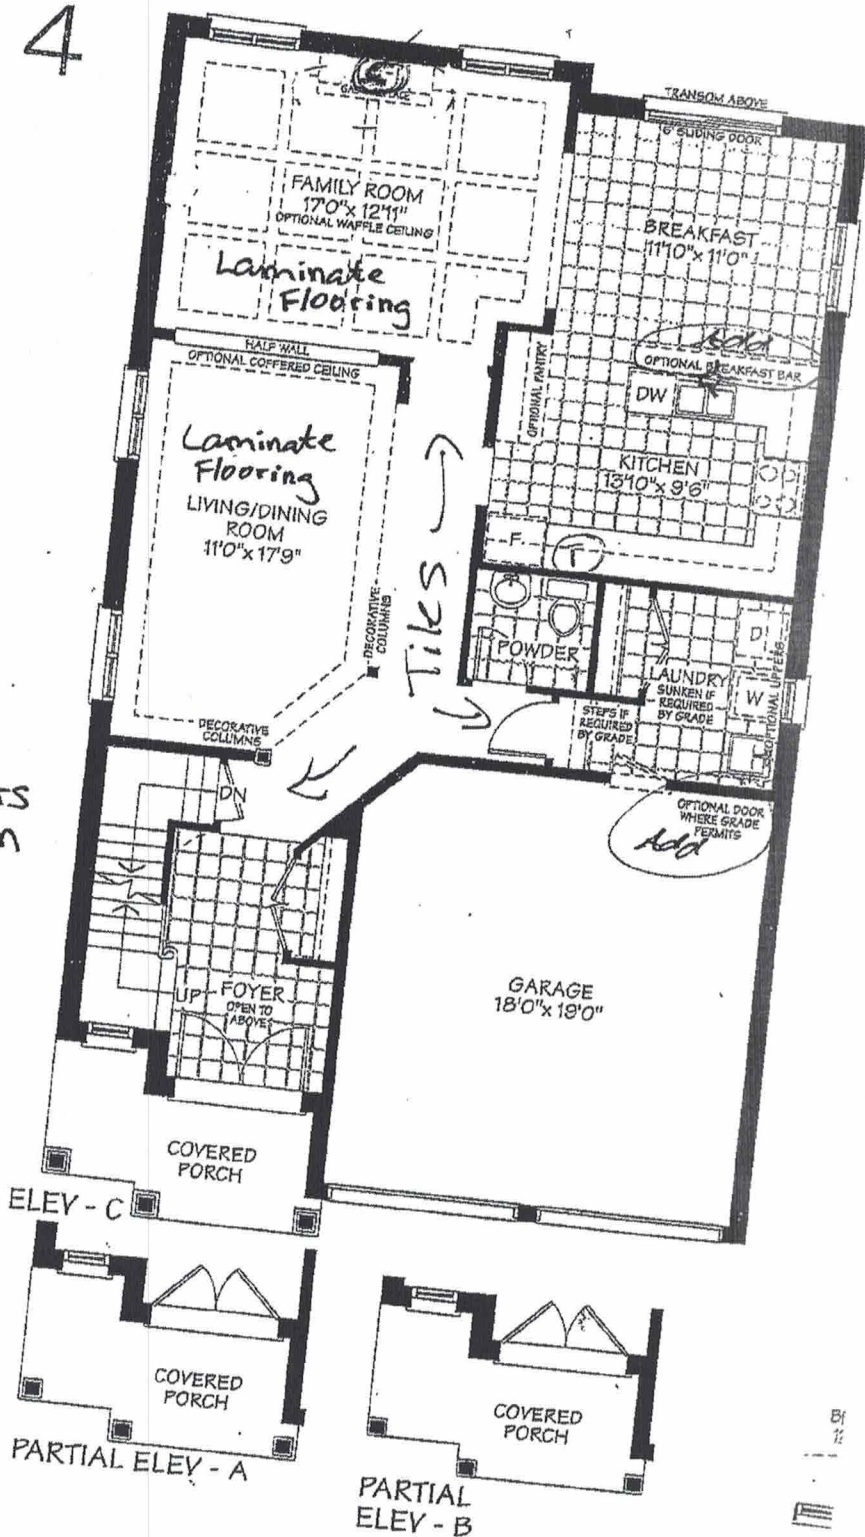


① Telephone R/I
 ② Cable R/I
 ⓪ Ceiling box

MAIN FLOOR

JUN 09 2023

Cedar Ridge - 4
 Lot 31D
 Nazari MB

Frameless Glass
Enclosure

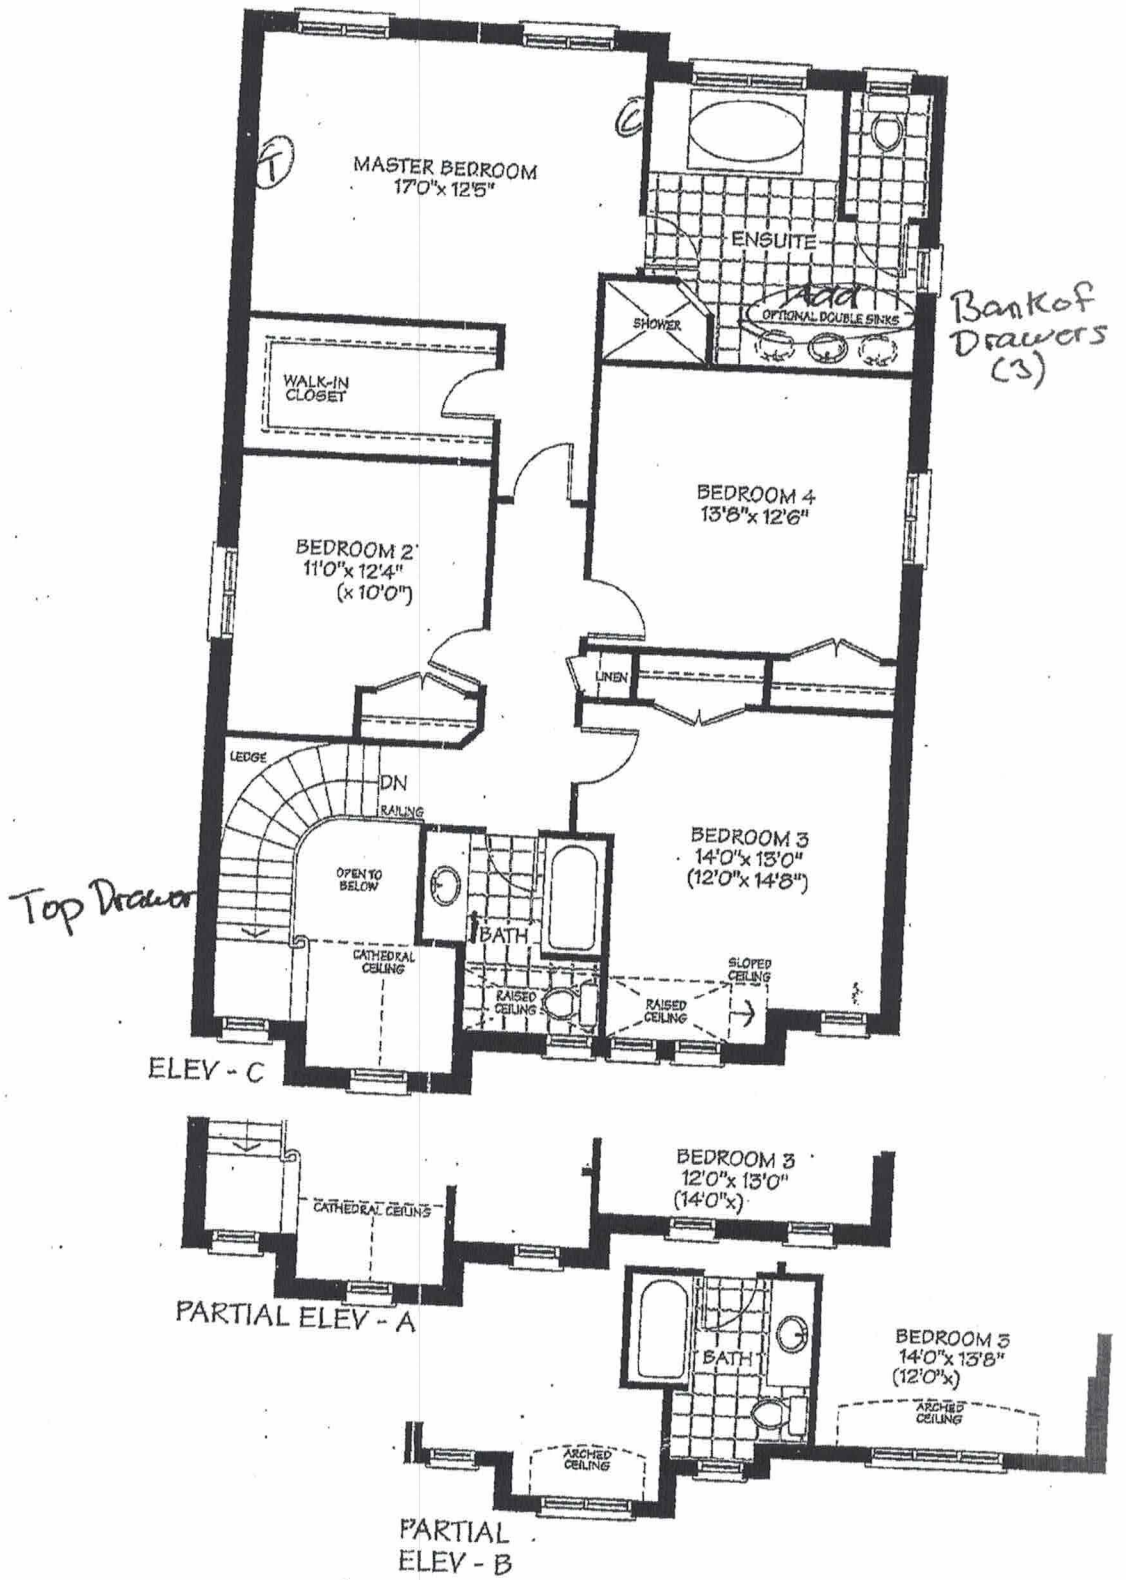

SECOND FLOOR

JUN 09 2023

Cedar Ridge-4
Lot 31D

MB