

Brampton Encore - 105 - 1 - 38-3 Elev.A HAYDN
CENTRAL VAC AND WIRING

Inv.448	1 - FAMILY ROOM: INSTALL CAT 6 WIRING - UPGRADE AN OUTLET STANDAR CAT 5 IN FAMILY ROOM TO CAT 6-SEE SKETCH
Line5416	Note:
25Apr16 / 27May16	
Inv.448	1 - BEDROOM #2: INSTALL RG 6 WIRING ROUGH-IN IN BED #2. SEE SKETCH
Line5417	Note:
25Apr16 / 27May16	
Inv.448	1 - FAMILY ROOM: INSTALL ROUGH-IN WIRING FOR ONE PAIR OF SPEAKERS - TO GO IN FAMILY ROOM. SEE SKETCH
Line5423	Note:
25Apr16 / 27May16	
Inv.448	1 - UPPER HALL: INSTALL ROUGH-IN WIRING FOR ONE PAIR OF SPEAKERS - IN UPPER HALL
Line5424	Note:
25Apr16 / 27May16	

CERAMIC

Inv.881	1 - FOYER: ISNTALL Floor Upgrade 4 Foyer Vestibule Floor
Line12227	Note:
30Oct16 / 21Oct16	
Inv.881	1 - KITCHEN/BREAKFAST: INSTLL Floor Upgrade 4 Kitchen and Breakfast Floor
Line12228	Note:
30Oct16 / 21Oct16	
Inv.881	1 - POWDER ROOM: INSTALL Floor Upgrade 4 Powder Room Floor
Line12230	Note:
30Oct16 / 21Oct16	
Inv.881	1 - MASTER ENSUITE: INSTALL Floor Upgrade 2 Ensuite Bath Floor
Line12231	Note:
30Oct16 / 21Oct16	
Inv.881	1 - MASTER ENSUITE: INSTALL Floor Upgrade 1 Ensuite Bath Shower Ceiling
Line12232	Note:
30Oct16 / 21Oct16	
Inv.881	1 - MASTER ENSUITE: INSTALL Floor Upgrade 1 Ensuite Bath Shower Walls
Line12233	Note:
30Oct16 / 21Oct16	
Inv.881	1 - MASTER ENSUITE: INSTALL Floor Upgrade 1 Ensuite Bath Tub Deck Face
Line12234	Note:
30Oct16 / 21Oct16	
Inv.881	1 - MASTER ENSUITE: INSTALL Floor Upgrade 1 Ensuite Bath Tub Deck Top
Line12235	Note:
30Oct16 / 21Oct16	
Inv.881	1 - MASTER ENSUITE: INSTALL Floor Upgrade 1 Ensuite Bath 2 Rows
Line12236	Note:
30Oct16 / 21Oct16	

Brampton Encore - 105 - 1 - 38-3 Elev.A HAYDN

Inv.881	1 - ENSUTTE 2: INSTALL Floor Upgrade 1 Bath 2 Floor
Line12237	Note:
3Oct16 / 21Oct16	
Inv.881	1 - TWIN BATH: INSTALL Floor Upgrade 1 Bath 3 4 Floor
Line12238	Note:
3Oct16 / 21Oct16	

ELECTRICAL

Inv.448	1 - TELEPHONE AND CABLE ROUGH-IN LOCATIONS
Line5414	Note:
25Apr16 / 27May16	
Inv.448	1 - EXTERIOR: INSTALL ADDITIONAL FESTIVE SOFFIT PLUG WITH SWITCH FOR EXTERIOR HOLIDAY LIGHTS - SEE SKETCH
Line5418	Note: IN ADDITION TO BUILDER'S STANDARD HOLIDAY LIGHT SWITCH
25Apr16 / 27May16	
Inv.448	1 - KITCHEN CABINET STRIP VALANCE LIGHTS (UNDER CABINETS) - ROUGH - IN - DOES NOT INCLUDE (AND REQUIRES) KITCHEN UPGRADE PRICING
Line5419	Note:
25Apr16 / 27May16	

EXTERIOR COLOURS

Inv.426	1 - EXTERIOR COLOUR PACKAGE 9
Line6307	Note:
14Apr16 / 27May16	

FORMING

Inv.448	1 - SIDE DOOR- HOME TO EXTERIOR- AS PER PLAN AND GRADE PERMITTING
Line5420	Note:
25Apr16 / 27May16	

FRAMING

Inv.426	1 - MANDOOR - GARAGE TO HOUSE- AS PER PLAN AND GRADE PERMITTING
Line6308	Note: AS PER APS- BONUS PACKAGE
14Apr16 / 27May16	

GRANITE MARBLE QUARTZ

Inv.881	1 - KITCHEN: INSTALL 2 CM GRP 2 Kitchen with Island
Line12216	Note:
3Oct16 / 21Oct16	
Inv.881	1 - KITCHEN: INSTALL 2 CM GRP 2 Optional Flush BBar
Line12217	Note:
3Oct16 / 21Oct16	

HARDWOOD

Inv.881	1 - DINING ROOM: INSTALL Upgrade 2 PREVERCO, DISTINCTION IN ESPRESSO LEVEL 1 IN Dining
Line12221	Note:
3Oct16 / 21Oct16	

Brampton Encore - 105 - 1 - 38-3 Elev.A HAYDN

Inv.881	1 - FAMILY ROOM: INSTALL Upgrade 2 PREVERCO, DISTINCTION IN ESPRESSO LEVEL I IN Family
Line12222	Note:
30Oct16 / 21Oct16	
Inv.881	1 - MAIN HALL: INSTALL Upgrade 2 PREVERCO, DISTINCTION IN ESPRESSO LEVEL I IN Main Hall
Line12223	Note:
30Oct16 / 21Oct16	
Inv.881	1 - LANDING: INSTALL Upgrade 2 PREVERCO, DISTINCTION IN ESPRESSO LEVEL I ON Landing
Line12224	Note:
30Oct16 / 21Oct16	
Inv.881	1 - UPPER HALL: INSTALL Upgrade 2 PREVERCO, DISTINCTION IN ESPRESSO LEVEL I IN Upper Hall, IN LIEU OF STANDARD CARPET
Line12225	Note:
30Oct16 / 21Oct16	

INTERIOR TRIM AND DOORS

Inv.448	4 - MAIN FLOOR: INSTALL FOUR (4) STANDARD DOOR EXTENDED HEIGHT 96" (PRICE PER DOOR) MAIN FLOOR. TO GO ON BASEMENT, CLOSETS AND POWDER ROOM DOORS. SEE SKETCH
Line5421	Note:
25Apr16 / 27May16	
Inv.448	5 - MAIN FLOOR: INSTALL EXTENDED HEIGHT ARCHWAYS (PRICE PER DOORWAY) -SEE SKETCH
Line5422	Note:
25Apr16 / 27May16	

KITCHEN AND BATH CABINETRY

Inv.881	1 - KITCHEN: INSTALL Handles Kitchen
Line12218	Note:
30Oct16 / 21Oct16	
Inv.881	1 - KITCHEN: INSTALL Oak PVC 59 Upper Corner Diagonal 100cm h. SEE SKETCH
Line12219	Note:
30Oct16 / 21Oct16	
Inv.881	1 - KITCHEN: INSTALL UPG 1 GRP III Opt Light Valance
Line12220	Note:
30Oct16 / 21Oct16	

MISC.

Inv.426	1 - BONUS PACKAGE: \$3322.20 (INCLUDING TAXES) WORTH OF UPGRADES FROM GOLD PARK HOMES DÉCOR CENTRE IS BEING APPLIED TOWARD THE STRUCTURAL APPOINTMENT. PURCHASER HAS A REMAINING AMOUNT OF \$6677.80 (INCLUDING TAXES) TO BE USED TOWARD THE COLOUR APPOINTMENT
Line5105	Note:
14Apr16 / 27May16	
Inv.426	1 - Purchasers are aware & accepts that ANY changes made to upgrades after signing this Purchasers Extra Form are subject to a minimum administration fee of \$500. PLUS a 10% holdback fee
Line5106	Note:
14Apr16 / 27May16	

Brampton Encore - 105 - 1 - 38-3 Elev.A HAYDN

Inv.448	1 - BONUS PACKAGE: \$6192.40 (INCLUDING TAXES) WORTH OF UPGRADES FROM GOLD PARK HOMES DÉCOR CENTRE IS BEING APPLIED TOWARD THE STRUCTURAL APPOINTMENT. PURCHASER HAS A REMAINING AMOUNT OF \$485.40 (INCLUDING TAXES) TO BE USED TOWARD THE COLOUR APPOINTMENT
Line5425	Note:
25Apr16 / 27May16	
Inv.448	1 - Purchaser has attended a Structural appointment at the Decor Centre & has DECLINED any additional upgrades and accepts and acknowledges that there will be no further structural changes/additions/deletions to be made upon signing on April 25, 2016
Line5426	Note:
25Apr16 / 27May16	
Inv.448	1 - Purchasers are aware & accepts that ANY changes made to upgrades after signing this Purchasers Extra Form are subject to a minimum administration fee of \$500. PLUS a 10% holdback fee
Line5427	Note:
25Apr16 / 27May16	
Inv.881	1 - BONUS PACKAGE: \$485.40 (INCLUDING TAXES) WORTH OF UPGRADES FROM GOLD PARK HOMES DÉCOR CENTRE IS BEING APPLIED TOWARD THE COLOUR APPOINTMENT
Line12239	Note:
30Oct16 / 21Oct16	
Inv.881	1 - Purchaser has attended a Colour appointment at the Decor Centre & has DECLINED any additional upgrades and accepts and acknowledges that there will be no further structural changes/additions/deletions to be made upon signing on October 3, 2016
Line12240	Note:
30Oct16 / 21Oct16	
Inv.881	1 - Purchasers are aware & accepts that ANY changes made to upgrades after signing this Purchasers Extra Form are subject to a minimum administration fee of \$500. PLUS a 10% holdback fee
Line12241	Note:
30Oct16 / 21Oct16	

PAINTING

Inv.881	1 - STAIRCASE: Stain Staircase 2 Storey Model (Euroline Pickets Charged Separately)
Line12226	Note:
30Oct16 / 21Oct16	

PLUMBING

Inv.426	1 - BASEMENT: INSTALL ROUGH-IN - 3PC BASEMENT ROUGH-IN, AS PER PLAN
Line5101	Note:
14Apr16 / 27May16	

WINDOWS - BASEMENT

Inv.426	1 - BASEMENT WINDOWS - UPGRADE EXISTING BASEMENT WINDOW TO 46 INCH X 32 INCH EGRESS - MAY REQUIRE INSTALLATION OF WINDOW WELL. TO BE APPROVED BY CONSTRUCTION
Line5107	Note:
14Apr16 / 27May16	
Inv.426	2 - BASEMENT: TWO (2) BASEMENT WINDOWS - UPGRADE EXISTING BASEMENT WINDOW TO 30 INCH X 24 INCH - MAY REQUIRE INSTALLATION OF WINDOW WELL
Line5104	Note:
14Apr16 / 27May16	

WINDOWS AND DOORS

Brampton Encore - 105 - 1 - 38-3 Elev.A HAYDN

Inv.426	1 - MAN DOOR GARAGE TO HOUSE - OPTIONAL - IF GRADE PERMITS
Line6309	Note: AS PER APS-BONUS PACKAGE
14Apr16 / 27May16	

Purchaser: Helen Osayangbon

Property: 105 of Plan -

Telephone Res. / Bus: (905) 454-4294

Project: Fieldwalk Investments Inc.

Decor Advisor: Terri Parisani

Model and Elevation: 38-3 Elev.A HAYDN

Layout Changes: ☒ Yes ☐ No

Sketch Attached: ☒ Yes ☐ No

Exterior Colour Scheme:
1. Cabinetry

	Style and Colour	Counter	Hardware
Kitchen / Breakfast	Siena (oak) Greystone	*Upp.2 #9241 Caesarstone Edge: C-30	*CH51
Laundry Room			
Powder Room			
TWIN BATH	Siena (oak) Greystone	4588K-07 Kalahari Topez Laminate	cs1-23
Master Ensuite Bathroom	Siena (oak) Greystone	4562K-07 Sandy Topez Laminate	cs1-25
Second Ensuite Bathroom (If Applicable)	Siena (oak) Greystone	4588K-07 Kalahari Topez Laminate	cs1-23
Dishwasher Cabinet			

Comment
2. Floor Tile

	Selection	Grout	Threshold
Entrance Vestibule	*Upp.4 Must Polished, Ivory 18 x 18	N/A	N/A
Main Hall			
Kitchen / Breakfast	*Upp.4 Must Polished, Ivory 18 x 18	N/A	N/A
Laundry Room	Serpentine Krem, 13 x 13	N/A	N/A
Powder Room	*Upp.4 Must Polished, Ivory 18 x 18	N/A	N/A
TWIN BATH	*Upp.1 Venus Beige, 13 x 13	N/A	N/A
Master Ensuite Bathroom	*Upp.2 Zenith Beige, 12 x 24	N/A	N/A
Second Ensuite Bathroom (If Applicable)	*Upp.1 Venus Beige, 13 x 13	N/A	N/A
Lower Landing (If Applicable)			

Comment
3. Wall Tile

	Selection	Listello/Inserts	Describe
TWIN BATH	Venus Beige, 8 x 10	<input type="radio"/> Yes <input checked="" type="radio"/> No	
Master Ensuite Bathroom			
Tub Deck	Upp.1, Costa Glossy Ivory 10x16	<input type="radio"/> Yes <input checked="" type="radio"/> No	
Shower Stall	Upp.1, Costa Glossy Ivory 10x16	<input type="radio"/> Yes <input checked="" type="radio"/> No	
Bathroom Walls	Upp.1, Costa Glossy Ivory 10x16	<input type="radio"/> Yes <input checked="" type="radio"/> No	
Second Ensuite Bathroom (If Applicable)	Venus Beige, 8 x 10	<input type="radio"/> Yes <input checked="" type="radio"/> No	
		<input type="radio"/> Yes <input checked="" type="radio"/> No	
Kitchen Backsplash	<input type="radio"/> Yes <input checked="" type="radio"/> No	Backsplash Behind Fridge	No

Comment

Purchaser: Helen Osayangbon

Property: 105 of Plan -

Telephone Res. / Bus: (905) 454-4294

Project: Fieldwalk Investments Inc.

Decor Advisor: Terri Parisani

Model and Elevation: 38-3 Elev.A HAYDN

4. Plumbing Fixtures

<input type="text"/>	Second Ensuite	<input type="text"/>	Powder Room	<input type="text"/>
Master Ensuite Bathroom	<input type="text"/>	Other Room - Specify	<input type="text"/>	Other Washroom
Comment	<input type="text"/>			

ALL PLUMBING FIXTURES ARE STANDARD

5. Hardwood Flooring

	Type and Stain		Type and Stain
Main Hall	*Upg.2PrevercoDestinctionEspres	Upper Landing	*Upg.2PrevercoDestinctionEspres
Kitchen / Breakfast	<input type="text"/>	Upper Hall	*Upg.2PrevercoDestinctionEspres
Living Room	<input type="text"/>	Master Bedroom	<input type="text"/>
Dining Room	*Upg.2PrevercoDestinctionEspres	Bedroom #2	<input type="text"/>
Family Room	*Upg.2PrevercoDestinctionEspres	Bedroom #3	<input type="text"/>
Den/Library	<input type="text"/>	Bedroom #4	<input type="text"/>
Entrance Vestibule	<input type="text"/>	Bedroom #5	<input type="text"/>
Lower Landing (If Applicable)	<input type="text"/>	Other Room - Specify	<input type="text"/>

Comment
6. Carpeting

	Upgrade	Description
Main Hall	<input type="checkbox"/>	<input type="text"/>
Living Room	<input type="checkbox"/>	<input type="text"/>
Dining Room	<input type="checkbox"/>	<input type="text"/>
Family Room	<input type="checkbox"/>	<input type="text"/>
Den/Library	<input type="checkbox"/>	<input type="text"/>
Upper Hall	<input type="checkbox"/>	<input type="text"/>
Master Bedroom	<input type="checkbox"/>	T-15
Bedroom #2	<input type="checkbox"/>	T-15
Bedroom #3	<input type="checkbox"/>	T-15
Bedroom #4	<input type="checkbox"/>	T-15
Bedroom #5	<input type="checkbox"/>	<input type="text"/>
<input type="text"/>	<input type="checkbox"/>	<input type="text"/>
Upper Landing (If Applicable)	<input type="checkbox"/>	<input type="text"/>
Lower Landing (If Applicable)	<input type="checkbox"/>	<input type="text"/>

Upgrade Underpad	Type	Area
	no	<input type="text"/>
Carpet on Stairs	Capped	Runner - *Upgrade
	no	<input type="text"/>

Comment

Purchaser: Helen Osayangbon

Property: 105 of Plan -

Telephone Res. / Bus: (905) 454-4294

Project: Fieldwalk Investments Inc.

Decor Advisor: Terri Parisani

Model and Elevation: 38-3 Elev.A HAYDN

7. Fireplace

	Living Room			Family Room			Other Room - Specify		
	Purchased	As Per Plan	N/A	Purchased	As Per Plan	N/A	Purchased	As Per Plan	N/A
Fireplace Type	<input type="radio"/>	<input type="radio"/>	<input checked="" type="radio"/>	<input type="radio"/>	<input checked="" type="radio"/>	<input type="radio"/>	<input type="radio"/>	<input type="radio"/>	<input checked="" type="radio"/>
Mantle Type				STANDARD					
Colour / Stain				NF-23					
Surround				WHITE PAINT-GRADE					
Hearth				TRAVERTINO CLASSICO					
Comment				NONE					

8. Trim Carpentry

Interior Doors	Std Extended	Front Door Glass Inserts	STANDARD	Door Handles	STANDARD
Interior Trim	STANDARD				
Comment					

9. Plaster Mouldings and Medallions

Entrance Vestibule	N/A		Kitchen/Breakfast	N/A	
Main Hall	N/A		Den/Library	N/A	
Living Room	N/A		Lower Landing	N/A	
Dining Room	N/A		Other Room - Specify	N/A	
Family Room	N/A				
Comment					

10. Railings and Spindles

Railing Package	*EUROLINE 1 WITH V-GROVE HANDRAIL		
Railing Colour	*ESPRESSO	Spindle Colour	*ESPRESSO
Stringer / Riser	*ESPRESSO	Treads	*ESPRESSO
Comment	Oak Stairs <input checked="" type="radio"/> Yes <input type="radio"/> No		

11. Wall Paint

Main & Upper Hall	OYSTER	Master Bedroom	OYSTER
Living Room	OYSTER	Bedroom #2	OYSTER
Dining Room	OYSTER	Bedroom #3	OYSTER
Kitchen / Breakfast	OYSTER	Bedroom #4	OYSTER
Family Room	OYSTER	Bedroom #5	
Powder Room	OYSTER	Master Ensuite	OYSTER
Laundry Room	OYSTER	TWIN BATH	OYSTER
Den/Library	OYSTER	Second Ensuite	OYSTER
Trim Paint	WHITE		
Comment	Smooth Ceilings First Floor		

Purchaser: Helen Osayangbon

Property: 105 of Plan -

Telephone Res. / Bus: (905) 454-4294

Project: Fieldwalk Investments Inc.

Decor Advisor: Terri Parisani

Model and Elevation: 38-3 Elev.A HAYDN

12. Electrical

Plugs and Switches ☒ White ☐ Ivory

Hood Fan ☐ White ☐ Ivory

Appliances Built in Cooktop

☐ Yes ☒ No

Built in Oven

☐ Yes ☒ No

Above Kitchen Cabinet Light ☐ Yes ☒ No

Below Kitchen Cabinet Light ☒ Yes ☐ No

Gas Stove

☐ Yes ☒ No

Microwave

☐ Yes ☒ No

Comment

STANDARD HOOD FAN: STAINLESS STEEL

13. Heating and Air Conditioning

Air Conditioning

Gas Provisions Dryer

Gas Provisions Stove

Gas Provisions Barbecue

Comment

GAS LINE FORR BBQ IS STANDARD

14. Additional Comments

15. Disclaimers and Notes



- 1) Colours of all materials are as close as possible to builder's selection, but not necessarily identical due to variances in manufacturing.
- 2) Any extras listed above are null and void unless accompanied by a separate invoice/amendment. Said invoice must be paid in full.
- 3) The Purchaser acknowledges that after Interior Colour Selection form is signed and dated, no further changes will be permitted other than re-selection due to unavailability. _____ Purchaser's Initials
- 4) The Purchaser acknowledges reading and accepting the "Gold Park Homes Decor Centre Disclaimers" form. This document contains other miscellaneous disclaimers.

This Interior Colour Selection is final and approved by:

Signature:  Date: Oct 3rd 2016

The Haydn 38' SERIES


Elevation A • 2,454 sq.ft. | Elevation B • 2,448 sq.ft.

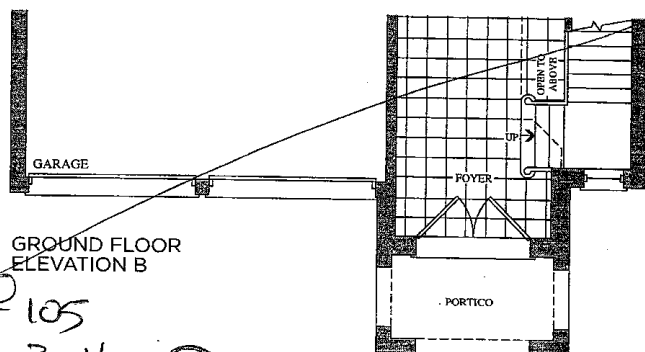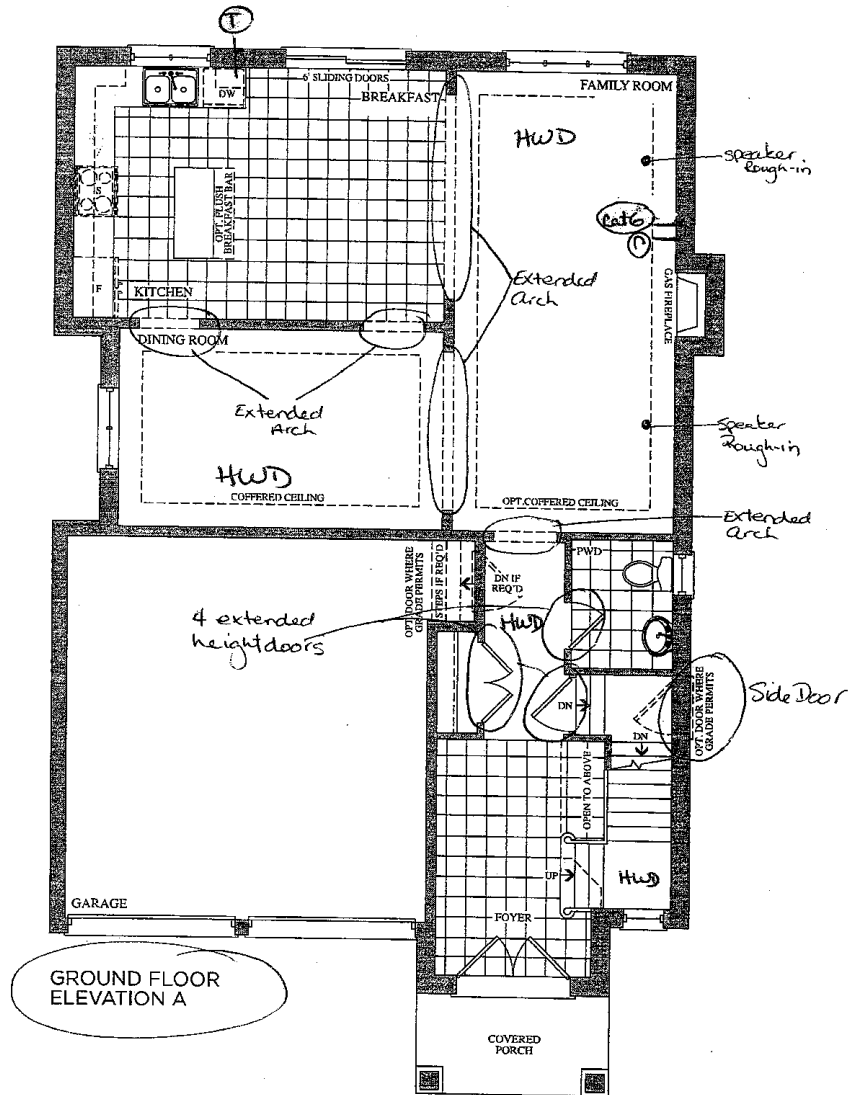


Lot 105
Oct. 3, 16

Lot 105
April 25, 2016



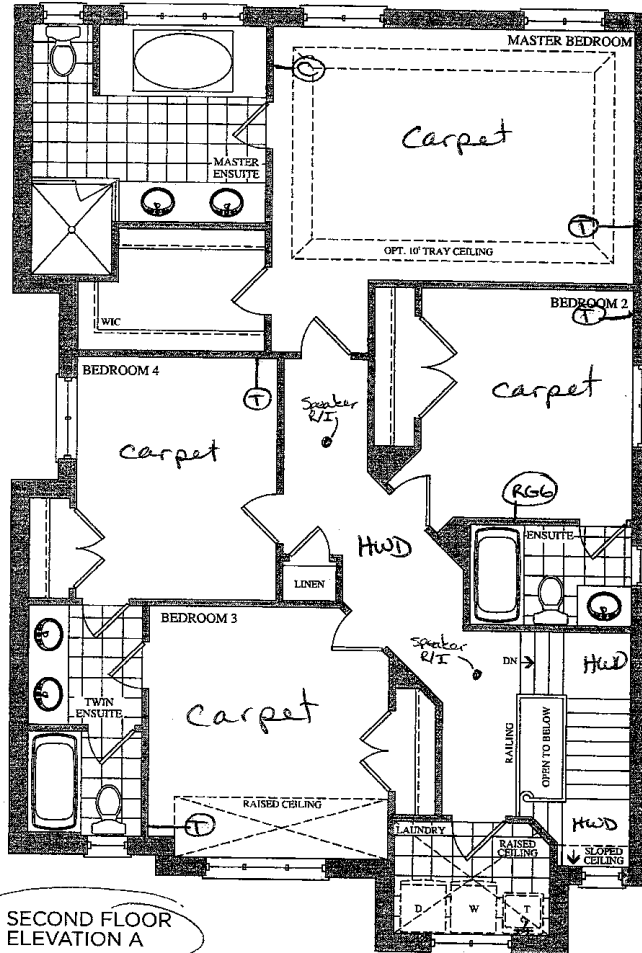

SECOND FLOOR
ELEVATION A

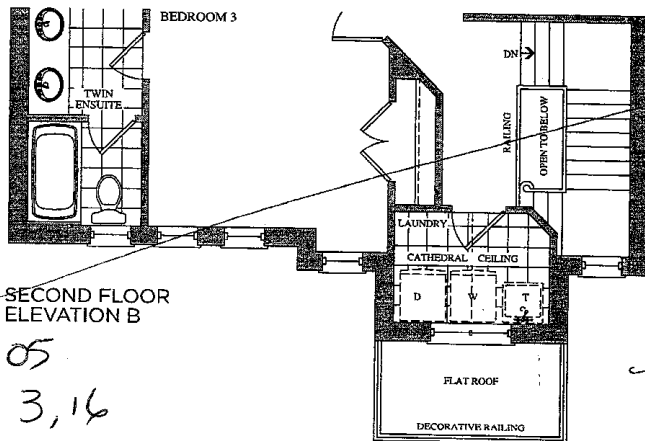

SECOND FLOOR
ELEVATION B

Lot 105
Oct. 3, 16

Lot 105
April 25, 2016

CORTINA

KITCHENS INC.
19 Regent Road, Woodbridge, Ontario L4L 8L6
Tel: 905-264-5454 Fax: 905-264-5954
www.CortinaKitchens.com





QUOTATION

Date: 06/23/16

Trade Name: Gold Park Homes	Site location: Brampton	Model: 38-3
Address:	Project: Encore	Phase:

This layout has been explained to the purchaser by Cortina Kitchens Inc. and is understood by the purchaser.

Upper Diamond
Corner

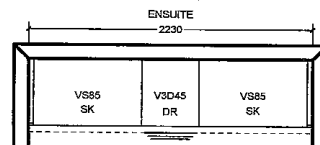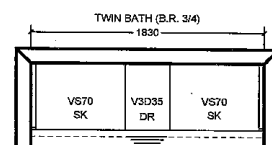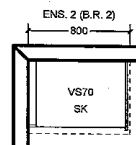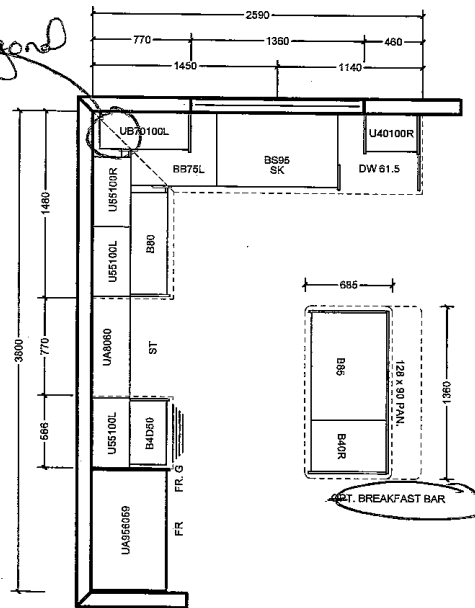

All prices subject to confirmation from head office.
This quotation is subject to the terms & conditions set out
in Cortina's Agreement of Purchase and Sale.

All agreements are contingent upon strikes, accidents, and delay beyond our control.
Please provide our installer with template for sinkholes or \$150.00 will be charged for callback.

ACCEPTED DATE: 06/30/2016

CUSTOMER SIGNATURE

INSTALLER SIGNATURE

CORTINA HEAD OFFICE APPROVAL

ITEM A. Wood grain and colour are characteristics of the product, we cannot guarantee that such grain and colour will always match.
ITEM B. Cortina Kitchens reserves the right to alter dimensions and make technical changes without notice.

CORTINA

77 Regina Road Woodbridge ON L4L 8L6
905-264-6464

DARK STAIN INFORMATION

Builder... Gold Park Homes Project... Encore Lot #... 105

Cortina Kitchens offers a wide variety of finishes, applied to oak and maple products. The subject finishes include the spray stains **Cocoa**, **Espresso**, **Graphite** as well as wiping stain **Ebony**.

Due to the very dark stains applied on natural maple and oak doors and joints, several characteristics are important to be noted when purchasing these products.

1. Shadow lines may be visible at the interior profile edges of a door or drawer front. If movement occurs shadow lines may increase or decrease, depending on the style and/or size of a door or drawer front.
2. Variation and unevenness may be visible in the finish.
3. Hairline cracks at the joints are created over time due to the nature of natural wood, caused by usage, humidity, or dryness. They tend to be more visible to darker stains, than lighter wood stains.

Please be advised that Cortina Kitchens will not replace doors nor parts that exhibit the above characteristics associated with this finish. These characteristics are not avoidable and are a result of the natural characteristics of wood and wood veneer, and the characteristics of darker stains on wood.

Thank you for your understanding.


I am well informed of this information, and agree to the purchase of any of the subject finishes listed above.

Purchaser: 


Date: Oct 3rd 2006

STANDARD HARDWARE


STANDARD HARDWARE

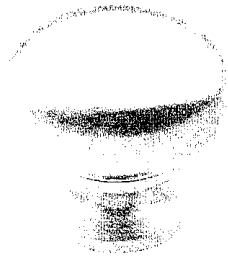


CSI-6

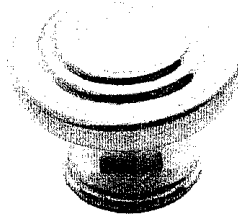

CSI-10

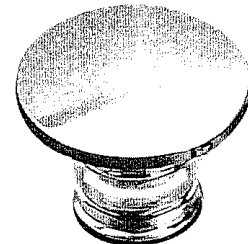


CSI-14

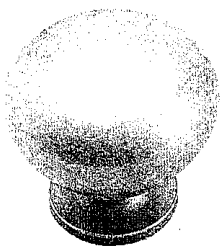


CSI-16




CSI-18

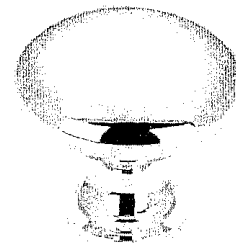


CSI-19

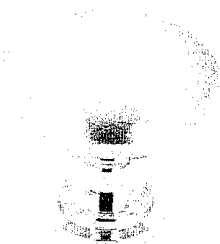

CSI-20

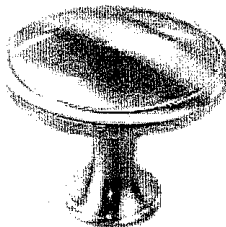

CSI-21

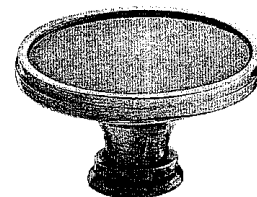


CSI-22




CSI-23

*Twin Bath
Ens. 2*

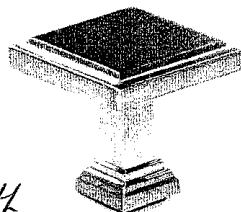

CSI-24

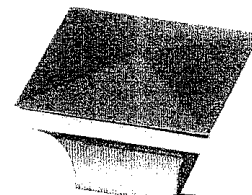

CSI-25

*master
Ens.*

*NOTES:

- IMAGES ARE FOR QUICK REFERENCE PURPOSES ONLY
- ACTUAL SIZES AND FINISHES AS PER HARDWARE
- SAMPLE BOARD PROVIDED TO DECOR CENTRE

*Lot 105
Oct. 3, 16*


(H)

CORTINA


MODIFIED: 19/05/16 (4)

UPGRADE HARDWARE


UPGRADE HARDWARE

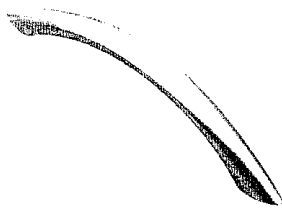


CH-32

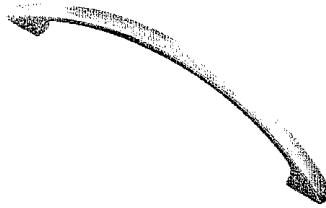


CH-38

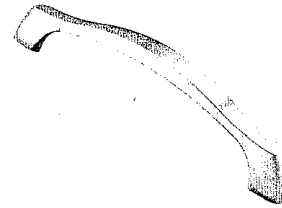


CH-44

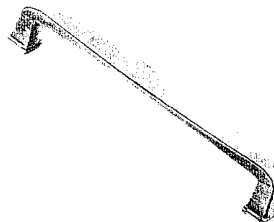


CH-45

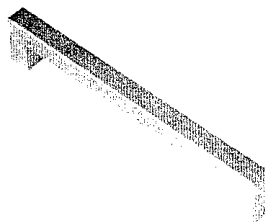


CH-46

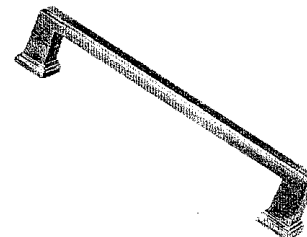


CH-47

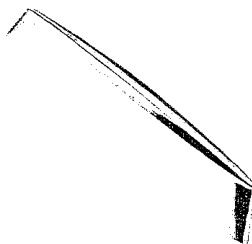

CH-48

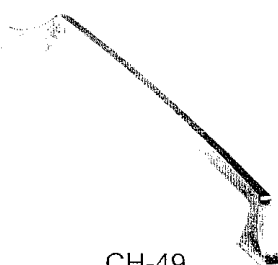


CH-49

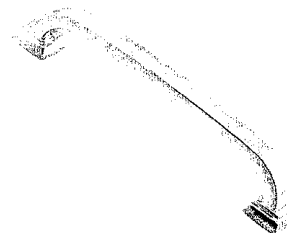


CH-50



CH-51

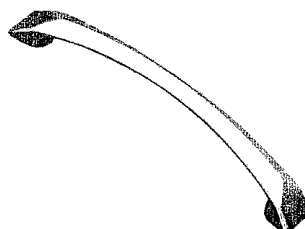

CH-52

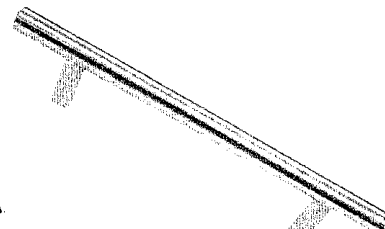

CH-53

*NOTES:

- IMAGES ARE FOR QUICK REFERENCE PURPOSES ONLY
- ACTUAL SIZES AND FINISHES AS PER HARDWARE SAMPLE BOARD PROVIDED TO DECOR CENTRE

Lot 105
Oct. 3, 16






Granite, Marble, Quartz
(Edge Profiles)


Lot 105
Oct. 3, 16

HP


20mm (3/4") Profiles

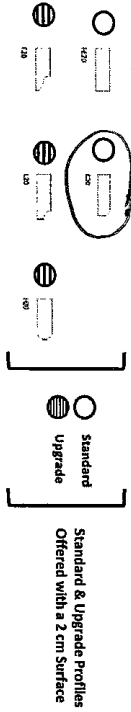

30mm (1 1/4") Profiles

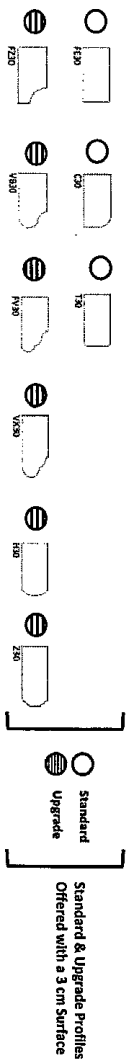

40mm (1 1/2") Profiles

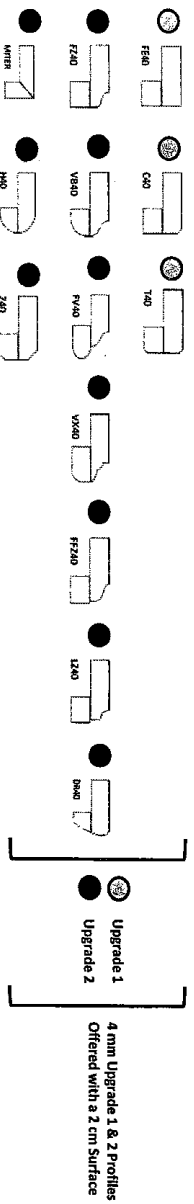

Note: All colours may not be available in 30mm at time ordered.
Vendor reserves the right to use 40mm edges (by limitation process).