

CONSTRUCTION SUMMARY

20 - 1 - 38-3 Elev.A HAYDN

CENTRAL VAC AND WIRING

Inv.546	1 - TELEPHONE AND CABLE ROUGH-IN LOCATIONS
Line6632	Note:
7Jun16 / 27Sep16	
Inv.546	1 - FAMILY ROOM: INSTALL CONDUIT PIPE- FOR TELEVISION- MUST SPECIFY LOCATION AND TERMINATION POINT, ABOVE FIREPLACE
Line6634	Note:
7Jun16 / 27Sep16	
Inv.546	1 - BEDROOM #2: INSTALL RG 6 ROUGH-IN IN BED #2. SEE SKETCH
Line6636	Note:
7Jun16 / 27Sep16	
Inv.546	1 - BEDROOM #3: INSTALL RG 6 ROUGH-IN IN BED #3. SEE SKETCH
Line6637	Note:
7Jun16 / 27Sep16	
Inv.546	1 - BEDROOM #4: INSTALL RG 6 ROUGH-IN IN BED #4. SEE SKETCH
Line6638	Note:
7Jun16 / 27Sep16	
Inv.546	1 - KITCHEN: INSTALL VAC PAN UNDER KITCHEN SINK
Line6639	Note:
7Jun16 / 27Sep16	

ELECTRICAL

Inv.546	1 - FAMILY ROOM: INSTALL 110V WALL RECEPTACLE ON DEDICATED CIRCUIT -ABOVE FIREPLACE SEE SKETCH
Line6635	Note:
7Jun16 / 27Sep16	
Inv.546	1 - KITCHEN: INSTALL KITCHEN CABINET STRIP VALANCE LIGHTS (UNDER CABINETS) - ROUGH - IN - DOES NOT INCLUDE (AND REQUIRES) KITCHEN UPGRADE PRICING
Line6640	Note:
7Jun16 / 27Sep16	

EXTERIOR COLOURS

Inv.546	1 - EXTERIOR COLOUR PACKAGE 7
Line12039	Note:
7Jun16 / 27Sep16	

FORMING

Inv.546	1 - EXTERIOR: INSTALL SIDE DOOR- HOME TO EXTERIOR- AS PER PLAN AND GRADE PERMITTING
Line6642	Note: GRADING DOES NOT PERMIT PER SITING DATED AUGUST 2, 2016 - CREDIT DUE TO PURCHASER
7Jun16 / 27Sep16	

FRAMING

Inv.546	1 - GARAGE: INSTALL MANDOOR - GARAGE TO HOUSE- AS PER PLAN AND GRADE PERMITTING
Line6641	Note: GIVEN IN AGREEMENT OF PURCHASE AND SALE
7Jun16 / 27Sep16 GRADING PERMITS PER SITING DATED AUGUST 2, 2016	

CONSTRUCTION SUMMARY

20 - 1 - 38-3 Elev.A HAYDN

HVAC

Inv.546	1 - KITCHEN: INSTALL GAS LINE ROUGH - MAIN FLOOR FOR STOVE
Line6644	Note:
7Jun16 / 27Sep16	
Inv.546	1 - BASEMENT: INSTALL TANKLESS HWT CONNECTION - HWT ON RENTAL BASIS / TANK NOT INCLUDED
Line6645	Note:
7Jun16 / 27Sep16	

KITCHEN AND BATH CABINETRY

Inv.546	1 - KITCHEN: INSTALL KITCHEN CABINET STRIP VALANCE LIGHTS (UNDER CABINETS) - ROUGH - IN - DOES NOT INCLUDE (AND REQUIRES) KITCHEN UPGRADE PRICING
Line12038	Note:
7Jun16 / 27Sep16	

MISC.

Inv.546	1 - BONUS PACKAGE: \$7130.30 (INCLUDING TAXES) WORTH OF UPGRADES FROM GOLD PARK HOMES DÉCOR CENTRE IS BEING APPLIED TOWARD THE STRUCTURAL APPOINTMENT. PURCHASER HAS A REMAINING AMOUNT OF \$2869.70 (INCLUDING TAXES) TO BE USED TOWARD THE COLOUR APPOINTMENT
Line6648	Note:
7Jun16 / 27Sep16	
Inv.546	1 - Purchaser has attended a Structural appointment at the Decor Centre & has DECLINED any additional upgrades and accepts and acknowledges that there will be no further structural changes/additions/deletions to be made upon signing on June 7, 2016
Line6649	Note:
7Jun16 / 27Sep16	
Inv.546	1 - Purchasers are aware & accepts that ANY changes made to upgrades after signing this Purchasers Extra Form are subject to a minimum administration fee of \$500. PLUS a 10% holdback fee
Line6650	Note:
7Jun16 / 27Sep16	

PLUMBING

Inv.546	1 - ROUGH-IN - WATERLINE FOR FIRDGE
Line6647	Note:
7Jun16 / 27Sep16	

WINDOWS - BASEMENT


Inv.546	3 - BASEMENT: INSTALL THREE (X3) BASEMENT WINDOWS - UPGRADE EXISTING BASEMENT WINDOW TO 30 INCH X 16 INCH. SEE SKETCH
Line6643	Note: WINDOW AT ROUGH-IN LOCATION TO REMAIN STANDARD SIZE
7Jun16 / 27Sep16	

encore
BRANTON

Telephone — (T)
Cable — (C)
Electrical — (E)

The Haydn 38' SERIES

Elevation A • 2,454 sq.ft. | Elevation B • 2,448 sq.ft.

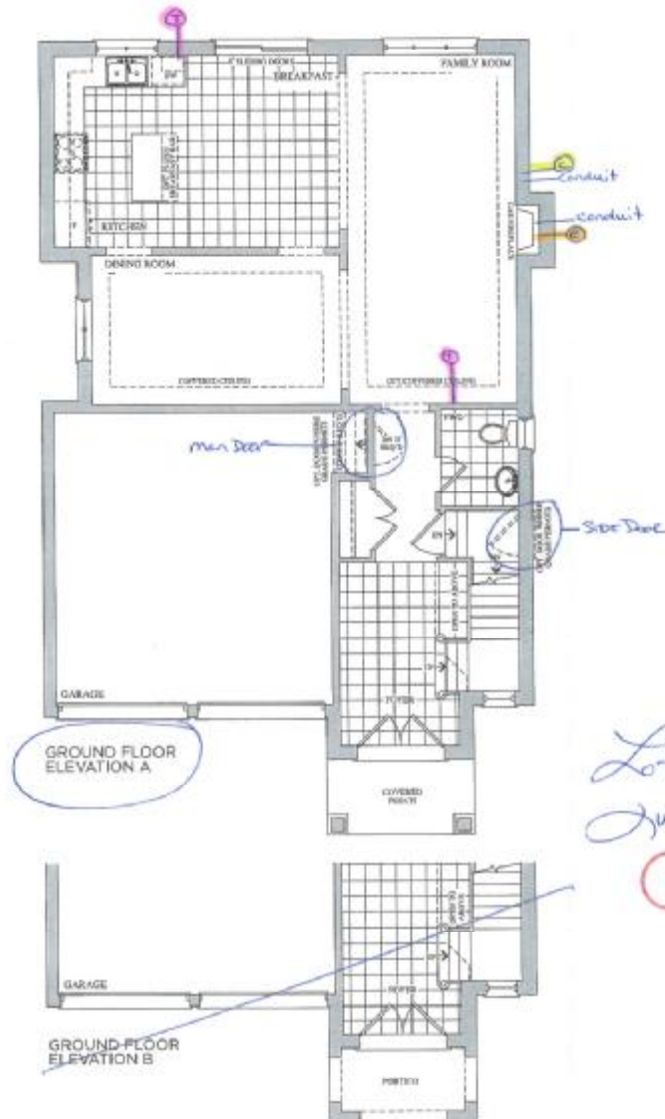

Prices, figures, illustrations, plans, features and finishes are subject to change without notice. L.M.O.E. Area and dimensions are approximate and actual usable floor space may vary from the stated area. Layout may be revised at the discretion of the manufacturer. E. & O.E.


GOLDPARK
H O M E S

encore
BRAMPTON

Telephone — (T)
Cable — (C)

The Haydn 38' SERIES

Elevation A • 2,454 sq.ft. | Elevation B • 2,448 sq.ft.

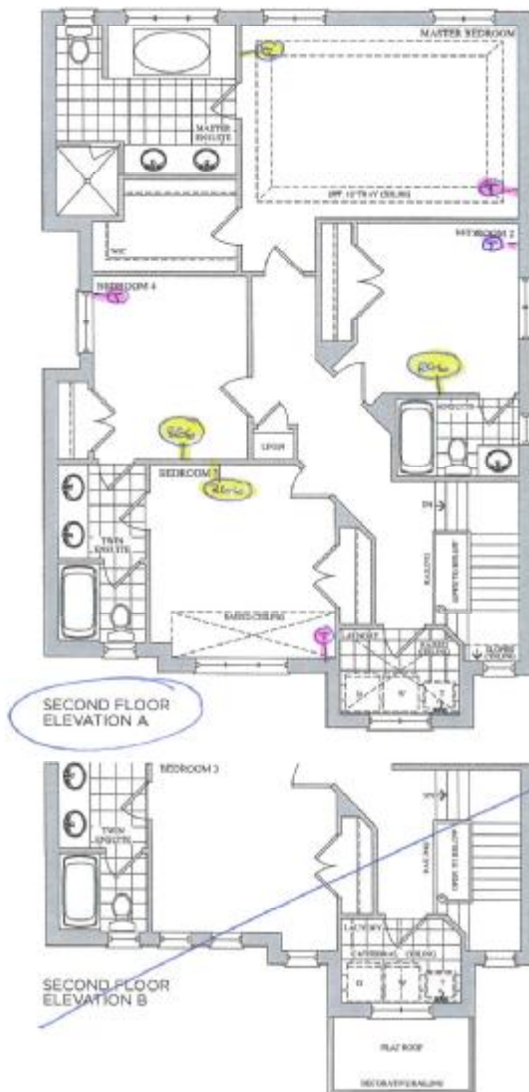

Lot 20
June 6, 16
○○

Prices, figures, illustrations, room features and layouts are subject to change without notice. C.A.R.O.L. Areas and dimensions are approximate and actual. Available floor space may vary from the stated area. Layout may be reverse of the unit purchased. E & O.E.


GOLDPARK
H O M E S

encore
BRANDTOWN

The
Haydn
38' SERIES

Elevation A • 2,454 sq.ft. | Elevation B • 2,448 sq.ft.

Basement Windows
3x 30" x 16"

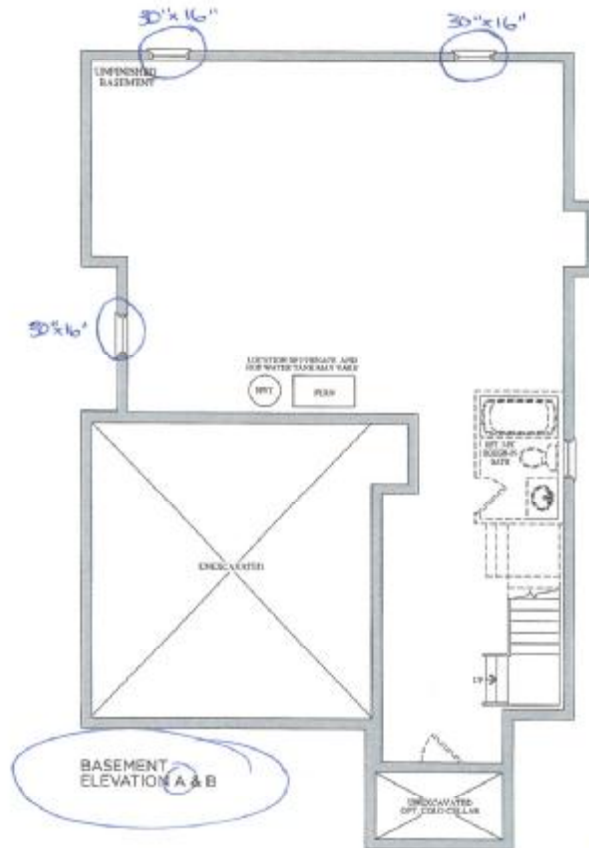

Lot 20
June 6, 16
OO

Prices, figures, illustrations, areas, features and fittings are subject to change without notice. C.E.D.L. Areas and dimensions are approximate and actual usable floor space may vary from the stated area. Layout may be revised at the unit purchased. E. & D.E.


GOLDPARK
HOMES

encore
BRANTON

Telephone — (T)
Cable — (C)
Electrical — (E)

The Haydn 38' SERIES

Elevation A - 2,454 sq.ft. | Elevation B - 2,448 sq.ft.

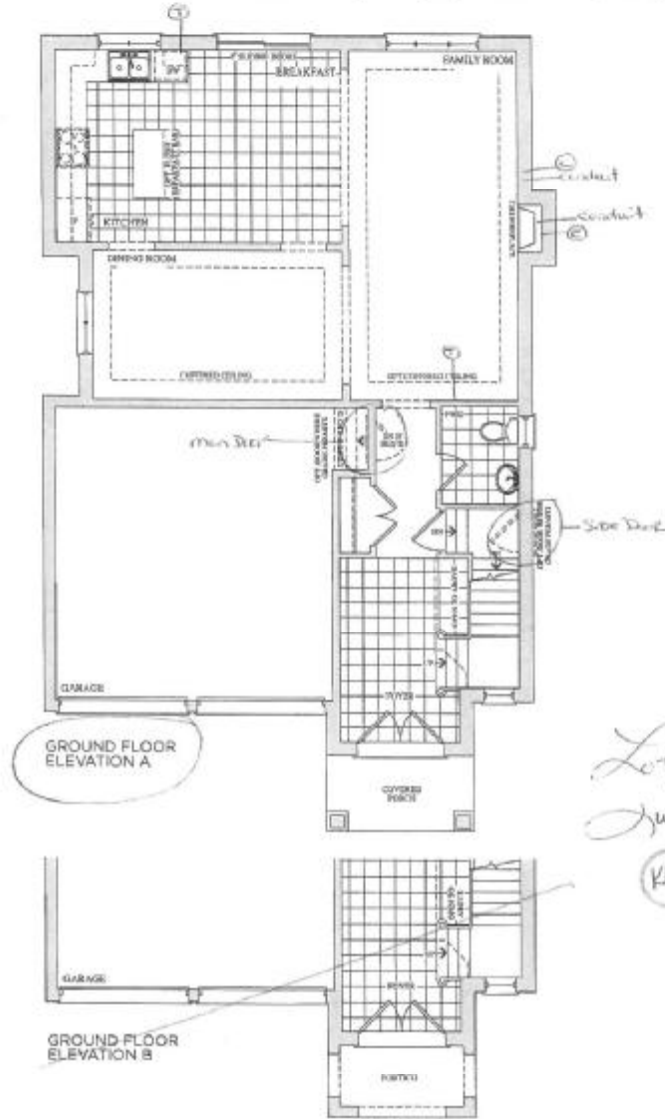

Prices, figures, materials, sizes, features and finishes are subject to change without notice. L.M.D.E. Areas and dimensions are approximate and actual usable floor space may vary from the stated area. Layout may be diverse of the one illustrated. S. & S.S.


goldpark
HOMES

encore
BRAMPTON

Telephone — (T)
Cable — (C)

The Haydn 38' SERIES

Elevation A • 2,454 sq.ft. | Elevation B • 2,448 sq.ft.

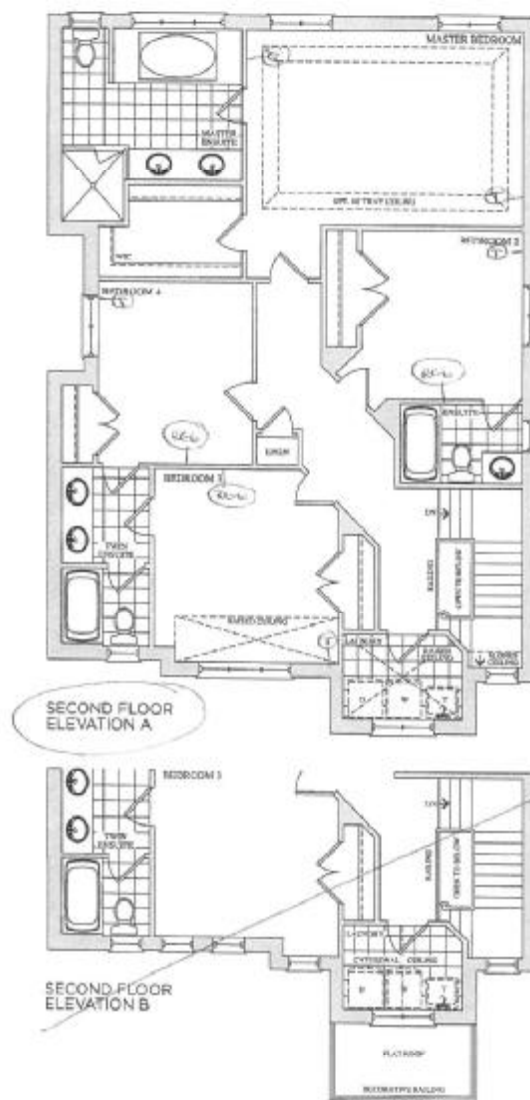

Lot 20
June 6, 16

KRM

ALM

Prices, features, finishes and floor plans are subject to change without notice. E.O.E. Areas and dimensions are approximate and actual. Available floor space may vary from the stated area. Legend may be revised at the discretion of E.O.E.

goldpark
HOMES


encore
BRAMPTON

The Haydn 38' SERIES

Elevation A • 2,454 sq.ft. | Elevation B • 2,448 sq.ft.

Basement Windows

3x 30" x 16"

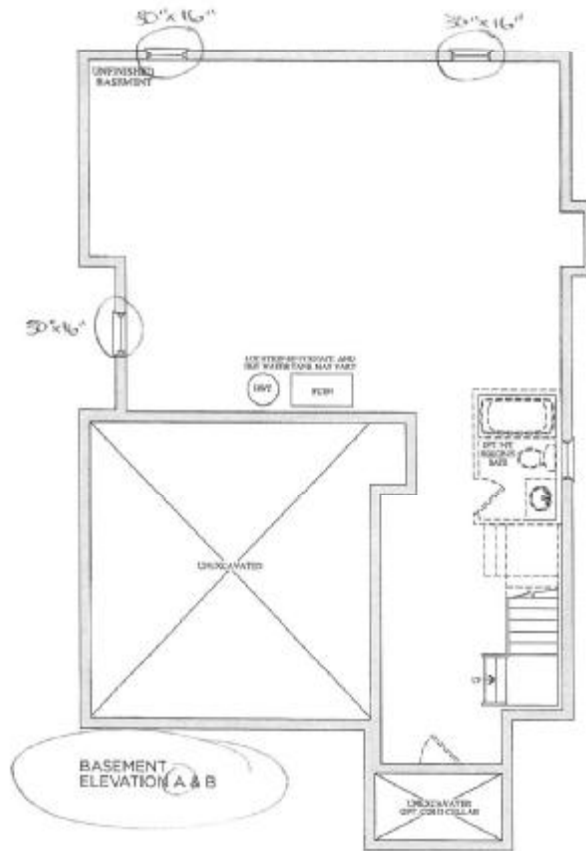

Lot 20
June 6, 16
KBM ABM

Prices, figures, descriptions, notes, features and floor plans are subject to change without notice. L.B.D.L. Notes and documents are standards and actual results may vary from the stated ones. Layout may be revised at the discretion of the architect. E & D.E.

GOLDPARK
HOME