

CONSTRUCTION SUMMARY

Brampton Encore - 77 - 1 - 41-4 Elev.A BACH CENTRAL VAC AND WIRING

Inv.519	1 - TELEPHONE AND CABLE ROUGH-IN LOCATIONS.
Line6246	Note:
26May16 / 26Sep16	

EXTERIOR COLOURS

Inv.519	1 - EXTERIOR COLOUR PACKAGE 6
Line11983	Note:
26May16 / 26Sep16	

FORMING

Inv.519	1 - EXTERIOR; INSTALL SIDE DOOR- HOME TO EXTERIOR- AS PER PLAN AND GRADE PERMITTING
Line6251	Note: YES, GRADING PERMITS PER SITING DATED AUGUST 2, 2016
26May16 / 26Sep16	

FRAMING

Inv.519	1 - GARAGE: INSTALL MANDOOR - GARAGE TO HOUSE- AS PER PLAN AND GRADE PERMITTING
Line6248	Note: GIVEN, AS PER AGREEMENT OF PURCHASE AND SALE
26May16 / 26Sep16 YES, GRADING PERMITS PER SITING DATED AUGUST 2, 2016	

INTERIOR TRIM AND DOORS


Inv.519	6 - MAIN FLOOR: INSTALL SIX (X6) STANDARD DOORS EXTENDED HEIGHT 96" (PRICE PER DOOR)- GROUND FLOOR 2 STOREY MODELS. TO GO ON CLOSETS, POWDER ROOM, DEN AND BASEMENT. SEE SKETCH
Line6252	Note:
26May16 / 26Sep16	

MISC.

Inv.519	1 - BONUS PACKAGE: \$5904.25 (INCLUDING TAXES) WORTH OF UPGRADES FROM GOLD PARK HOMES DÉCOR CENTRE IS BEING APPLIED TOWARD THE STRUCTURAL APPOINTMENT. PURCHASER HAS A REMAINING AMOUNT OF \$4095.75 (INCLUDING TAXES) TO BE USED TOWARD THE COLOUR APPOINTMENT
Line6253	Note:
26May16 / 26Sep16	
Inv.519	1 - Purchaser has attended a Structural appointment at the Decor Centre & has DECLINED any additional upgrades and accepts and acknowledges that there will be no further structural changes/additions/deletions to be made upon signing on May 26, 2016
Line6254	Note:
26May16 / 26Sep16	
Inv.519	1 - Purchasers are aware & accepts that ANY changes made to upgrades after signing this Purchasers Extra Form are subject to a minimum administration fee of \$500. PLUS a 10% holdback fee.
Line6255	Note:
26May16 / 26Sep16	

PLUMBING

Inv.519	1 - BASEMENT: INSTALL ROUGH-IN - 3PC BASEMENT ROUGH-IN, AS PER PLAN
Line6250	Note:
26May16 / 26Sep16	

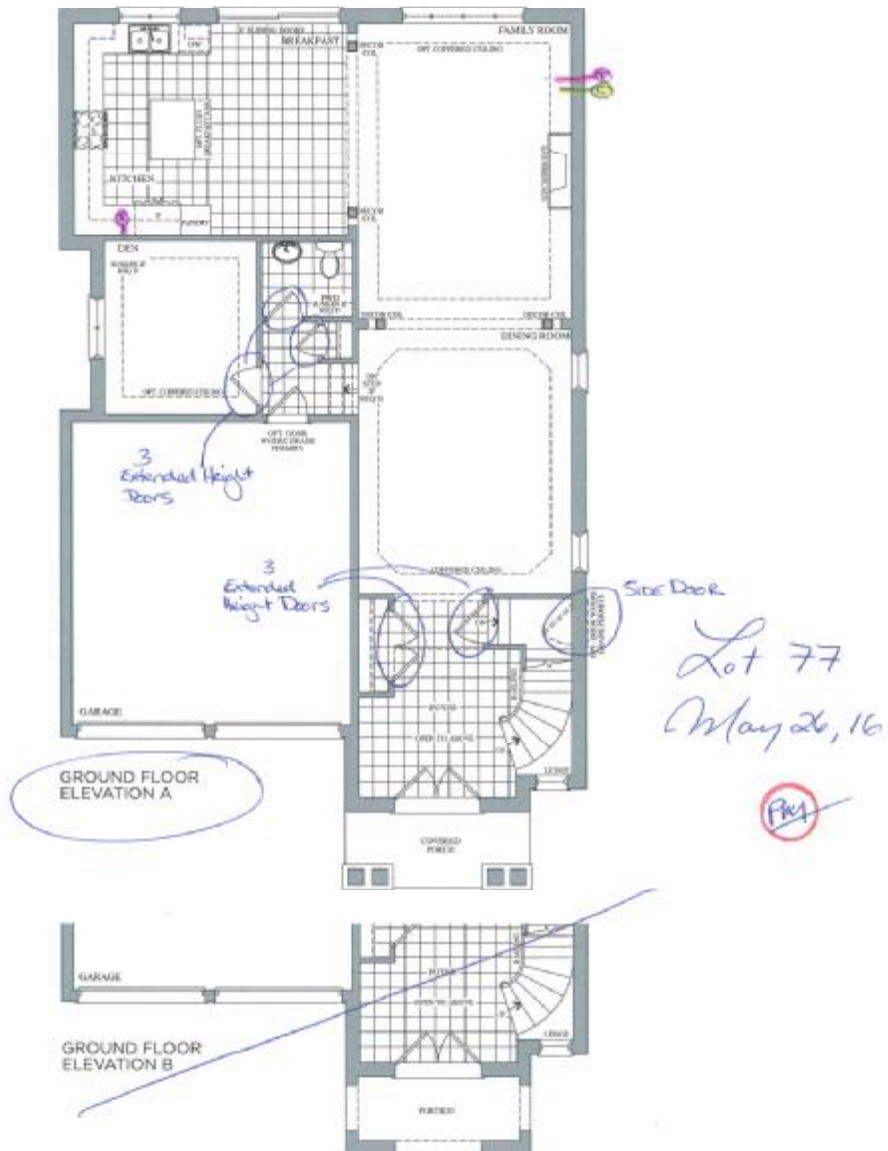

encore
BRAMPTON

Telephones — (P)
Cable — (C)

The Bach 41' SERIES

Elevation A • 3,046 sq.ft. | Elevation B • 3,046 sq.ft.




Project, figures, illustrations, sizes, features and finishes are subject to change without notice. E&OE. Areas and dimensions are approximate and actual usable floor space may vary from the stated area. Layout may be reverse of the unit purchased. E. & O.E.

GOLDPARK
HOMES

encore
BRAMPTON

The
Bach
41' SERIES

Elevation A • 3,046 sq.ft. | Elevation B • 3,046 sq.ft.

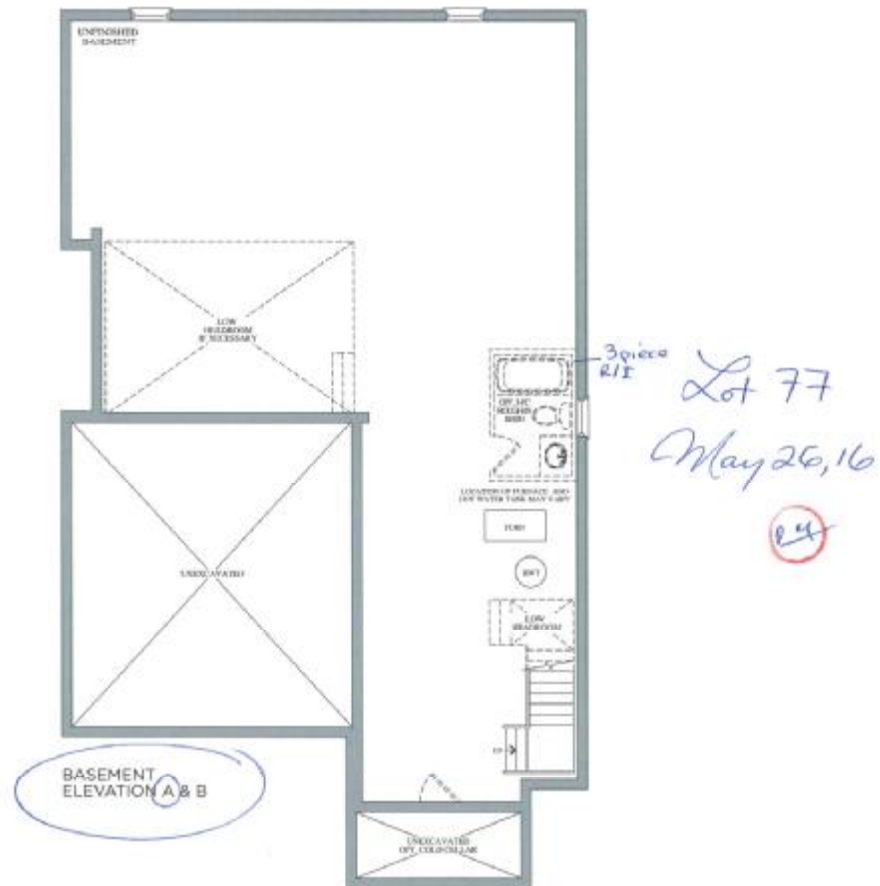

Prices, figures, illustrations, sizes, features and finishes are subject to change without notice. S.O.L.E. Areas and dimensions are approximate and actual usable floor space may vary from the stated area. Layout may be reverse of the unit purchased. B. & B.

GOLDPARK
HOMES



Stacey Corleto
Project Coordinator



Claude Azzopardi
Contracts Manager



Nancy McCorporate



Model	38.1 The Bizet		
Elevation	Circle One	A	2389.6 Square Feet
		B	2388.7 Square Feet
Optional Layouts	Circle All that Apply		

Model	38.2 The Ravel		
Elevation	Circle One	A	2371.5 Square Feet
		B	2278.7 Square Feet
Optional Layouts	Circle All that Apply		

Model	38.3 The Haydn		
Elevation	Circle One	A	2394.5 Square Feet
		B	2388.8 Square Feet
Optional Layouts	Circle All that Apply		

Model	38.4 The Vivaldi		
Elevation	Circle One	A	2459.1 Square Feet
		B	2459.1 Square Feet
Optional Layouts	Circle All that Apply		

Model	38.5 The Handel		
Elevation	Circle One	A	2549.2 Square Feet
		B	2554.7 Square Feet
Optional Layouts	Circle All that Apply		

Model	38.9 The Puccini		
Elevation	Circle One	A	3628.9 Square Feet
		B	3634.7 Square Feet
Optional Layouts	Circle All that Apply	GFA1	GROUND FLOOR Optional Alternative Layout

Model	38.6 The Scarlatti		
Elevation	Circle One	A	3525.1 Square Feet
		B	3508.5 Square Feet
Optional Layouts	Circle All that Apply	GFA1	GROUND FLOOR Optional Alternative Layout

Model	38.7 The Schubert		
Elevation	Circle One	A	3593.8 Square Feet
		B	3610.5 Square Feet
Optional Layouts	Circle All that Apply	GFA1	GROUND FLOOR Optional Alternative Layout
		SFA4	SECOND FLOOR Additional Bedroom

Model	38.8 The Corelli		
Elevation	Circle One	A	3801.5 Square Feet
		B	3801.5 Square Feet
Optional Layouts	Circle All that Apply	GFA2	GROUND FLOOR Optional Alternative Layout
		SFA4	SECOND FLOOR Additional Bedroom w/ Ensuite

Model	41.1 The Strauss		
Elevation	Circle One	A	2554.2 Square Feet
		B	2571.2 Square Feet
Optional Layouts	Circle All that Apply	SFA1	SECOND FLOOR Shower in Use of Tub B2

Model	41.2 The Mozart		
Elevation	Circle One	A	2725.9 Square Feet
		B	2731.1 Square Feet
Optional Layouts	Circle All that Apply	SFA1	SECOND FLOOR Shower in Use of Tub B2

Model	41.3 The Chopin		
Elevation	Circle One	A	2800.0 Square Feet
		B	2810.5 Square Feet
Optional Layouts	Circle All that Apply		

Model	41.4 The Bach		
Elevation	Circle One	A	2894.4 Square Feet
		B	2894.5 Square Feet
Optional Layouts	Circle All that Apply		

Model	41.5 The Brahms		
Elevation	Circle One	A	3948.1 Square Feet
		B	3948.1 Square Feet
Optional Layouts	Circle All that Apply	GFA1	GROUND FLOOR Optional Alternative Layout
		SFA2	SECOND FLOOR Shower in Use of Tub B4
		SFA3	SECOND FLOOR Optional Laundry Layout

Model	41.6 The Verdi		
Elevation	Circle One	A	3862.5 Square Feet
		B	3866.4 Square Feet
Optional Layouts	Circle All that Apply	GFA1	GROUND FLOOR Optional Alternative Layout
		SFA3	SECOND FLOOR Optional Laundry Layout

May 26, 16
P-1