

CONSTRUCTION SUMMARY

78 - 1 - 41-4 Elev.B BACH

CENTRAL VAC AND WIRING

Inv.520	1 - TELEPHONE AND CABLE ROUGH-IN LOCATIONS.
Line6245	Note:
26May16 / 26Sep16	
Inv.520	1 - BEDROOM 4: INSTALL RG 6 ROUGH-IN IN BED #4, SEE SKETCH
Line6247	Note:
26May16 / 26Sep16	

EXTERIOR COLOURS

Inv.520	1 - EXTERIOR COLOUR PACKAGE 9
Line11986	Note:
26May16 / 26Sep16	

FORMING

Inv.520	1 - EXTERIOR: INSTALL SIDE DOOR- HOME TO EXTERIOR- AS PER PLAN AND GRADE PERMITTING
Line6257	Note: GRADING PERMITS PER SITING DATED AUGUST 9, 2016
26May16 / 26Sep16	

FRAMING

Inv.520	1 - EXTERIOR: INSTALL MANDOOR - GARAGE TO HOUSE- AS PER PLAN AND GRADE PERMITTING
Line6249	Note: GIVEN, AS PER AGREEMENT OF PURCHASE AND SALE
26May16 / 26Sep16 GRADING PERMITS PER SITING DATED AUGUST 9, 2016	
Inv.520	1 - BASEMENT: INCREASE BASEMENT CEILING BY ONE FOOT
INCLUDES EXTRA RISERS/RAILING, 10" FOUNDATION WALLS AND LARGER BASEMENT WINDOWS (3 X 30" X 14")	
Line6256	Note:
26May16 / 26Sep16	

INTERIOR TRIM AND DOORS

Inv.520	6 - INSTALL SIX (X6) STANDARD DOORS EXTENDED HEIGHT 96" (PRICE PER DOOR)- GROUND FLOOR 2 STOREY MODELS. TO GO IN POWDER ROOM, CLOSETS, BASEMENT AND DEN
Line6259	Note:
26May16 / 26Sep16	

MISC.

Inv.520	1 - Purchaser has attended a Structural appointment at the Decor Centre & has DECLINED any additional upgrades and accepts and acknowledges that there will be no further structural changes/additions/deletions to be made upon signing on May 26, 2016.
Line6262	Note:
26May16 / 26Sep16	
Inv.520	1 - BASEMENT: INSTALL OPTIONAL COLD CELLAR - AS PER PLAN
Line6260	Note:
26May16 / 26Sep16	

CONSTRUCTION SUMMARY

78 - 1 - 41-4 Elev.B BACH

Inv.520	1 - BONUS PACKAGE: \$10,000.00 (INCLUDING TAXES) WORTH OF UPGRADES FROM GOLD PARK HOMES DÉCOR CENTRE IS BEING APPLIED TOWARD THE STRUCTURAL APPOINTMENT.
Line6261	Note:
26May16 / 26Sep16	
Inv.520	1 -
	Purchasers are aware & accepts that ANY changes made to upgrades after signing this Purchasers Extra Form are subject to a minimum administration fee of \$500. PLUS a 10% holdback fee
Line6263	Note:
26May16 / 26Sep16	

PLUMBING

Inv.520	1 - BASEMENT: INSTALL ROUGH-IN - 2PC BASEMENT ROUGH-IN, AS PER PLAN
Line6258	Note:
26May16 / 26Sep16	

STAIRS AND RAILINGS

Inv.520	1 - BASEMENT: INCREASE BASEMENT CEILING BY ONE FOOT
	INCLUDES EXTRA RISERS/RAILING, 10" FOUNDATION WALLS AND LARGER BASEMENT WINDOWS (3 X 30" X 14")
Line11985	Note:
26May16 / 26Sep16	

WINDOWS - BASEMENT

Inv.520	1 - BASEMENT: INCREASE BASEMENT CEILING BY ONE FOOT
	INCLUDES EXTRA RISERS/RAILING, 10" FOUNDATION WALLS AND LARGER BASEMENT WINDOWS (3 X 30" X 14")
Line11984	Note:
26May16 / 26Sep16	
Inv.520	1 - LARGER BASEMENT WINDOWS (3 X 30" X 14")
Line11376	Note:
26May16 / 26Sep16	


encore
BRAMPTON

Telephone — (P)

Cable — (C)

The Bach 41' SERIES

Elevation A • 3,046 sq.ft. | Elevation B • 3,046 sq.ft.

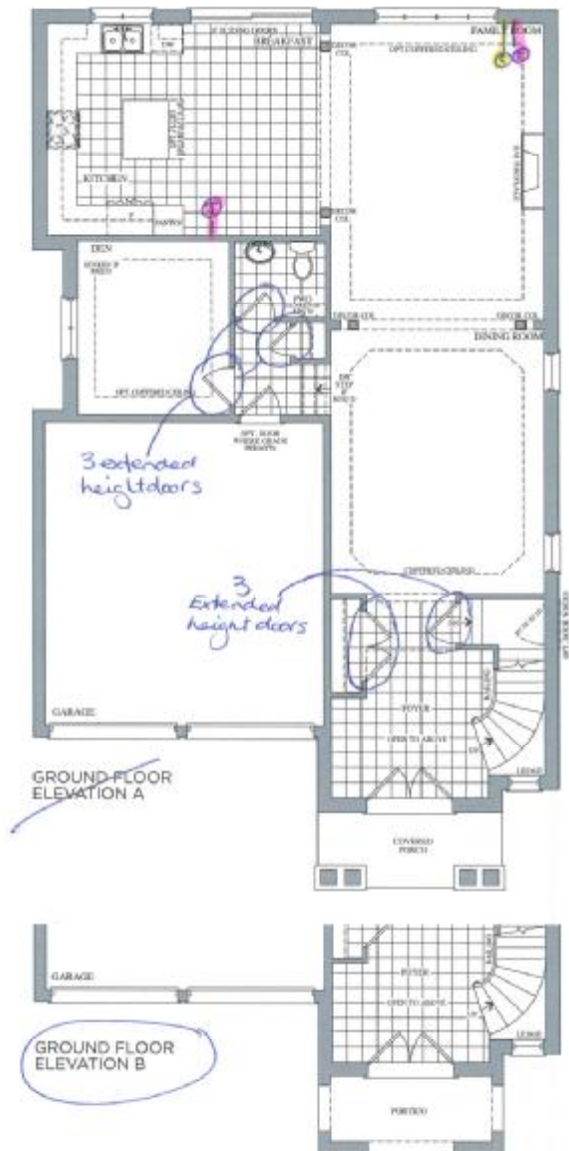

Lot 78
May 26, 16

Prices, figures, illustrations, sizes, features and features are subject to change without notice. C&G E. Areas and dimensions are approximate and actual usable floor space may vary from the stated area. Layout may be reverse of the unit purchased. E & D.E.


GOLDPARK
HOMES

encore
BRAMPTON

Telephone — (T)
Cable — (C)

The Bach 41' SERIES

Elevation A • 3,046 sq.ft. | Elevation B • 3,046 sq.ft.

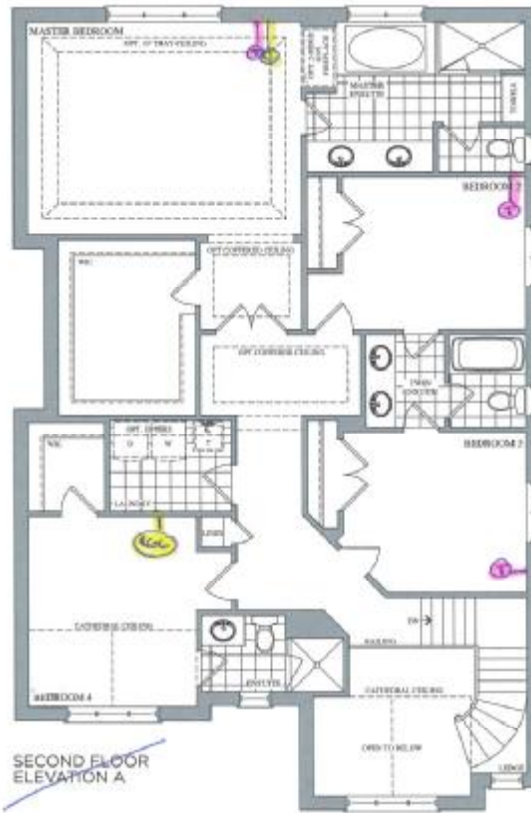


Lot 78
May 26, 16
RCA

Prices, figures, illustrations, plans, features and finishes are subject to change without notice. E&OE. Areas and dimensions are approximate and actual usable floor space may vary from the stated area. Layout may be reverse of the unit purchased. E. & O.E.

GOLDPARK
HOMES

Elevation A • 3,046 sq.ft. | Elevation B • 3,046 sq.ft.

- Increase ceiling height by 1'
- Basement Windows 3x=30"x14"

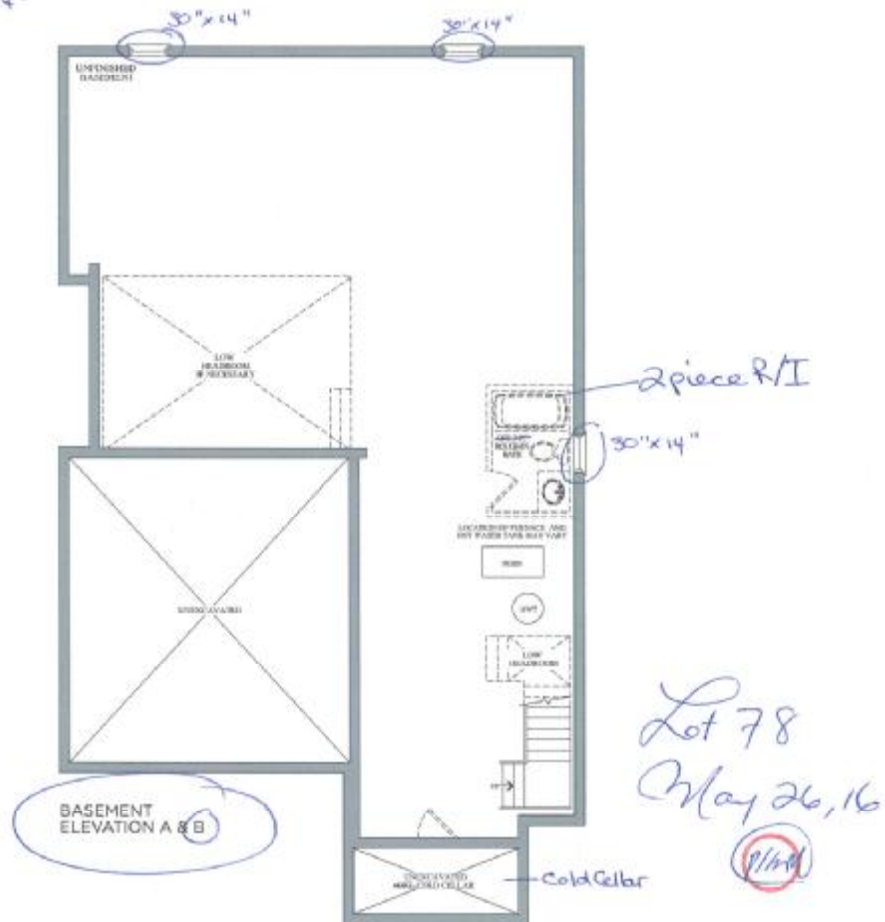

Stacey Corle
Project Coordinator

Claude Azzopardi
Contracts Manager

Nancy Mc
Corporate C

78
Lot #



38.1 The Bizet			
Elevation	Circle One	A	2189.6 Square Feet
		B	2186.7 Square Feet
Optional Layouts	Circle All that Apply		

38.2 The Ravel			
Elevation	Circle One	A	2271.5 Square Feet
		B	2273.7 Square Feet
Optional Layouts	Circle All that Apply		

38.3 The Haydn			
Elevation	Circle One	A	2394.5 Square Feet
		B	2388.3 Square Feet
Optional Layouts	Circle All that Apply		

38.4 The Vivaldi			
Elevation	Circle One	A	2456.1 Square Feet
		B	2458.3 Square Feet
Optional Layouts	Circle All that Apply		

38.5 The Handel			
Elevation	Circle One	A	2548.2 Square Feet
		B	2554.7 Square Feet
Optional Layouts	Circle All that Apply		

38.9 The Puccini			
Elevation	Circle One	A	3628.0 Square Feet
		B	3654.7 Square Feet
Optional Layouts	Circle All that Apply	GFA1	GROUND FLOOR Optional Alternative Layout

38.6 The Scarlatti			
Elevation	Circle One	A	3521.1 Square Feet
		B	3506.1 Square Feet
Optional Layouts	Circle All that Apply	GFA1	GROUND FLOOR Optional Alternative Layout

38.7 The Schubert			
Elevation	Circle One	A	3593.8 Square Feet
		B	3616.5 Square Feet
Optional Layouts	Circle All that Apply	GFA1	GROUND FLOOR Optional Alternative Layout
		SFA4	SECOND FLOOR Additional Bedroom

38.8 The Corelli			
Elevation	Circle One	A	3801.5 Square Feet
		B	3803.5 Square Feet
Optional Layouts	Circle All that Apply	GFA1	GROUND FLOOR Optional Alternative Layout
		SFA4	SECOND FLOOR Additional Bedroom w/ Ensuite

41.1 The Strauss			
Elevation	Circle One	A	2594.2 Square Feet
		B	2571.2 Square Feet
Optional Layouts	Circle All that Apply	SFA1	SECOND FLOOR Shower in Lieu of Tub B2

41.2 The Mozart			
Elevation	Circle One	A	2725.9 Square Feet
		B	2731.1 Square Feet
Optional Layouts	Circle All that Apply	SFA1	SECOND FLOOR Shower in Lieu of Tub B2

41.3 The Chopin			
Elevation	Circle One	A	2880.0 Square Feet
		B	2810.5 Square Feet
Optional Layouts	Circle All that Apply		

41.4 The Bach			
Elevation	Circle One	A	2894.4 Square Feet
		B	2894.5 Square Feet
Optional Layouts	Circle All that Apply		

41.5 The Brahms			
Elevation	Circle One	A	3048.1 Square Feet
		B	3049.1 Square Feet
Optional Layouts	Circle All that Apply	GFA1	GROUND FLOOR Optional Alternative Layout
		SFA2	SECOND FLOOR Shower in Lieu of Tub B4
		SFA3	SECOND FLOOR Optional Laundry Layout

41.6 The Verdi			
Elevation	Circle One	A	3862.3 Square Feet
		B	3865.4 Square Feet
Optional Layouts	Circle All that Apply	GFA1	GROUND FLOOR Optional Alternative Layout
		SFA3	SECOND FLOOR Optional Laundry Layout

May 26, 16
P/M