

Brampton Encore - 88 - 1 - 41-6 Elev.A VERDI OPT - GAF1 AND SFA3
CENTRAL VAC AND WIRING

Inv.470	1 - FAMILY ROOM: INSTALL CONDUIT PIPE- FOR TELEVISION- MUST SPECIFY LOCATION AND TERMINATION POINT. SEE SKETCH
Line5656	Note:
28Apr16 / 14Nov16	
Inv.470	1 - BEDROOM #2: INSTALL RG 6 ROUGH-IN. TO GO IN BEDROOM #2. SEE SKETCH
Line5658	Note:
28Apr16 / 14Nov16	
Inv.470	1 - BEDROOM #3: INSTALL RG 6 ROUGH-IN. TO GO IN BEDROOM #3. SEE SKETCH
Line5659	Note:
28Apr16 / 14Nov16	
Inv.470	1 - BEDROOM #4: INSTALL RG 6 ROUGH-IN. TO GO IN BEDROOM #4. SEE SKETCH
Line5660	Note:
28Apr16 / 14Nov16	
Inv.470	1 - GROUND FLOOR-REC ROOM: INSTALL RG 6 ROUGH-IN. TO GO IN BEDROOM #4. SEE SKETCH
Line5661	Note:
28Apr16 / 14Nov16	
Inv.470	1 - REVIEW SKETCH FOR LOCATIONS OF CABLE AND TELEPHONE ETC.
Line12006	Note:
28Apr16 / 14Nov16	

DRYWALL

Inv.470	1 - MASTER ENSUITE: INSTALL SAFE AND SOUND INSULATION PER SQ FT FOR INTERIOR WALLS AND CEILING- IN MASTER ENSUITE
Line6285	Note:
28Apr16 / 14Nov16	
Inv.470	1 - TWIN ENSUITE: INSTALL SAFE AND SOUND INSULATION PER SQ FT FOR INTERIOR WALLS AND CEILING- IN TWIN ENSUITE
Line6286	Note:
28Apr16 / 14Nov16	
Inv.470	1 - ENSUITE #2: INSTALL SAFE AND SOUND INSULATION PER SQ FT FOR INTERIOR WALLS AND CEILING- IN ENSUITE #2
Line6287	Note:
28Apr16 / 14Nov16	
Inv.470	1 - POWDER ROOM: INSTALL SAFE AND SOUND INSULATION PER SQ FT FOR INTERIOR WALLS AND CEILING- IN POWDER ROOM
Line6288	Note:
28Apr16 / 14Nov16	

ELECTRICAL

Inv.470	1 - FAMILY ROOM: INSTALL 110V WALL RECEPTACLE ON DEDICATED CIRCUIT - ABOVE FIREPLACE. SEE SKETCH
Line5657	Note:
28Apr16 / 14Nov16	
Inv.470	1 - KITCHEN: INSTALL 110V WALL RECEPTACLE ON DEDICATED CIRCUIT - FOR MICROWAVE - MICROWAVE NOT INCLUDED. ABOVE STOVE
Line5662	Note:
28Apr16 / 14Nov16	

Brampton Encore - 88 - 1 - 41-6 Elev.A VERDI OPT - GAF1 AND SFA3

Inv.470	1 - BASEMENT: INSTALL 200 AMP ELECTRICAL SERVICE, IN LIEU OF STANDARD 100 AMPS
Line5663	Note:
28Apr16 / 14Nov16	
Inv.470	1 - LIVING ROOM: INSTALL ADDITIONAL STANDARD FIXTURE ON SAME SWITCH AS BUILDER'S STANDARD SWITCH CONTROLLED RECEPTICAL. SEE SKETCH
Line5676	Note:
28Apr16 / 14Nov16	

EXTERIOR COLOURS

Inv.470	1 - EXTERIOR COLOUR PACKAGE 5
Line12005	Note:
28Apr16 / 14Nov16	

FRAMING

Inv.470	1 - GARAGE: INSTALL MANDOOOR - GARAGE TO HOUSE- AS PER PLAN AND GRADE PERMITTING
Line6284	Note: GIVEN AS PER AGREEMENT OF PURCHASE AND SALE
28Apr16 / 14Nov16	
Inv.973	1 - OPTIONAL LAUNDRY
Line13900	Note:
14Nov16 / 14Nov16	
Inv.973	1 - OPTIONAL GROUND FLOOR
Line13899	Note:
14Nov16 / 14Nov16	

HVAC

Inv.470	1 - KITCHEN: INSTALL GAS LINE ROUGH - MAIN FLOOR - (3 STOREY MODELS) FOR STOVE
Line5684	Note:
28Apr16 / 14Nov16	

MISC.

Inv.470	1 - BONUS PACKAGE: \$10,000.00 (INCLUDING TAXES) WORTH OF UPGRADES FROM GOLD PARK HOMES DÉCOR CENTRE IS BEING APPLIED TOWARD THE STRUCTURAL APPOINTMENT.
Line6289	Note:
28Apr16 / 14Nov16	
Inv.470	1 - Purchaser has attended a Structural appointment at the Decor Centre & has DECLINED any additional upgrades and accepts and acknowledges that there will be no further structural changes/additions/deletions to be made upon signing on May 26, 2016
Line6290	Note:
28Apr16 / 14Nov16	
Inv.470	1 - Purchasers are aware & accepts that ANY changes made to upgrades after signing this Purchasers Extra Form are subject to a minimum administration fee of \$500. PLUS a 10% holdback fee
Line6388	Note:
28Apr16 / 14Nov16	
Inv.470	1 - EXTERIOR: INSTALL SIDE DOOR- HOME TO EXTERIOR- AS PER PLAN AND GRADE PERMITTING
Line6295	Note: GRADE DOES NOT PERMIT PER SITING DATED AUGUST 9, 2016 - CREDIT DUE TO PURCHASER
28Apr16 / 14Nov16	

PLUMBING



CONSTRUCTION SUMMARY

Brampton Encore - 88 - 1 - 41-6 Elev.A VERDI OPT - GAF1 AND SFA3


Inv.470	1 - KITCHEN: INSTALL ROUGH-IN - WATERLINE FOR FRIDGE
Line5689	Note:
28Apr16 / 14Nov16	

encore
BRAMPTON


Telephone — (T)
Cable — (C)
Electrical — (E)

The Verdi 41' SERIES

Elevation A • 3,940 sq.ft. | Elevation B • 3,940 sq.ft.

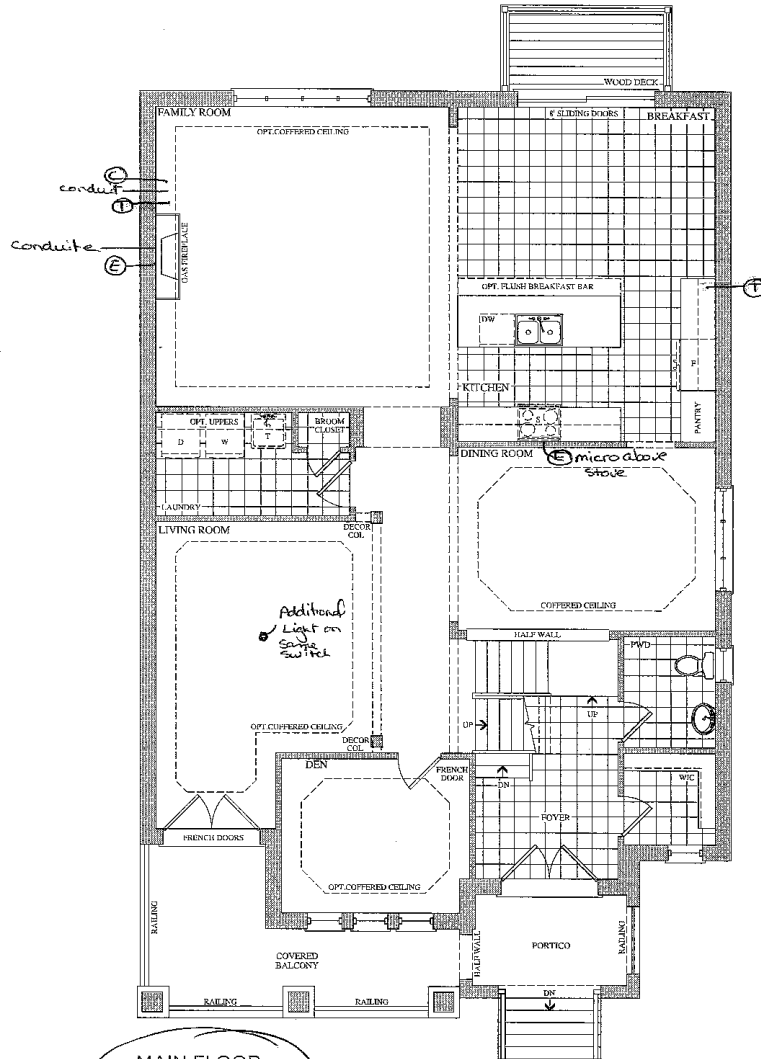

MAIN FLOOR
ELEVATION A

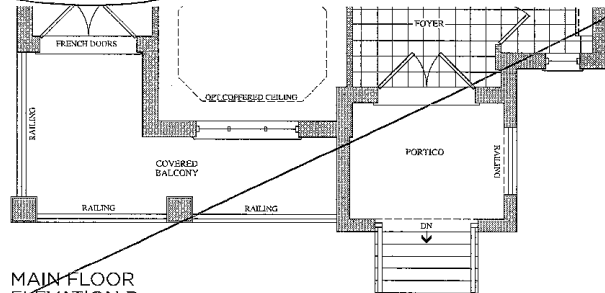

MAIN FLOOR
ELEVATION B

Lot 88
April 28, 16



Prices, figures, illustrations, sizes, features and finishes are subject to change without notice. E.&O.E. Areas and dimensions are approximate and actual usable floor space may vary from the stated area. Layout may be reverse of the unit purchased. E. & O.E.


GOLDPARK
HOMES

encore
BRAMPTON


Telephone — (T)
Cable — (C)
Electrical — (E)

The Verdi 41' SERIES

Elevation A • 3,940 sq.ft. | Elevation B • 3,940 sq.ft.

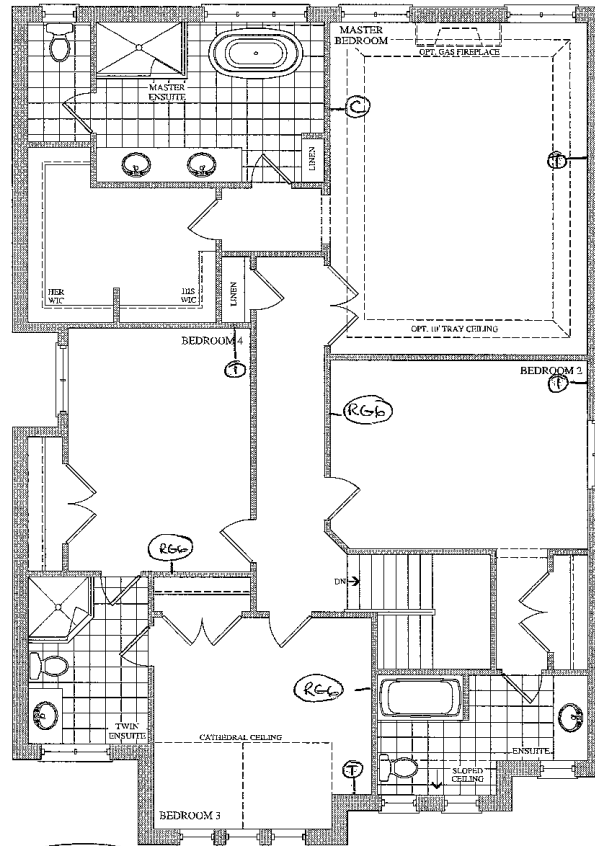

SECOND FLOOR
ELEVATION A

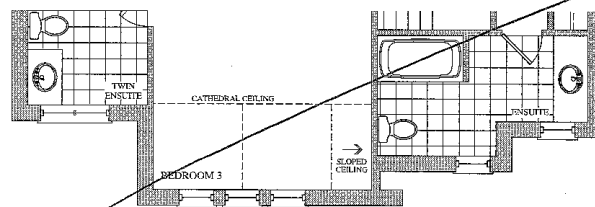

SECOND FLOOR
ELEVATION B

Lot 88
May 26, 16
OO


Prices, figures, illustrations, sizes, features and finishes are subject to change without notice. E.&O.E. Areas and dimensions are approximate and actual usable floor space may vary from the stated area. Layout may be reverse of the unit purchased. E. & O.E.

GOLDPARK
HOMES

Telephone — (T)
Cable — (C)


**The
Verdi
41' SERIES**

Elevation A • 3,940 sq.ft. | Elevation B • 3,940 sq.ft.

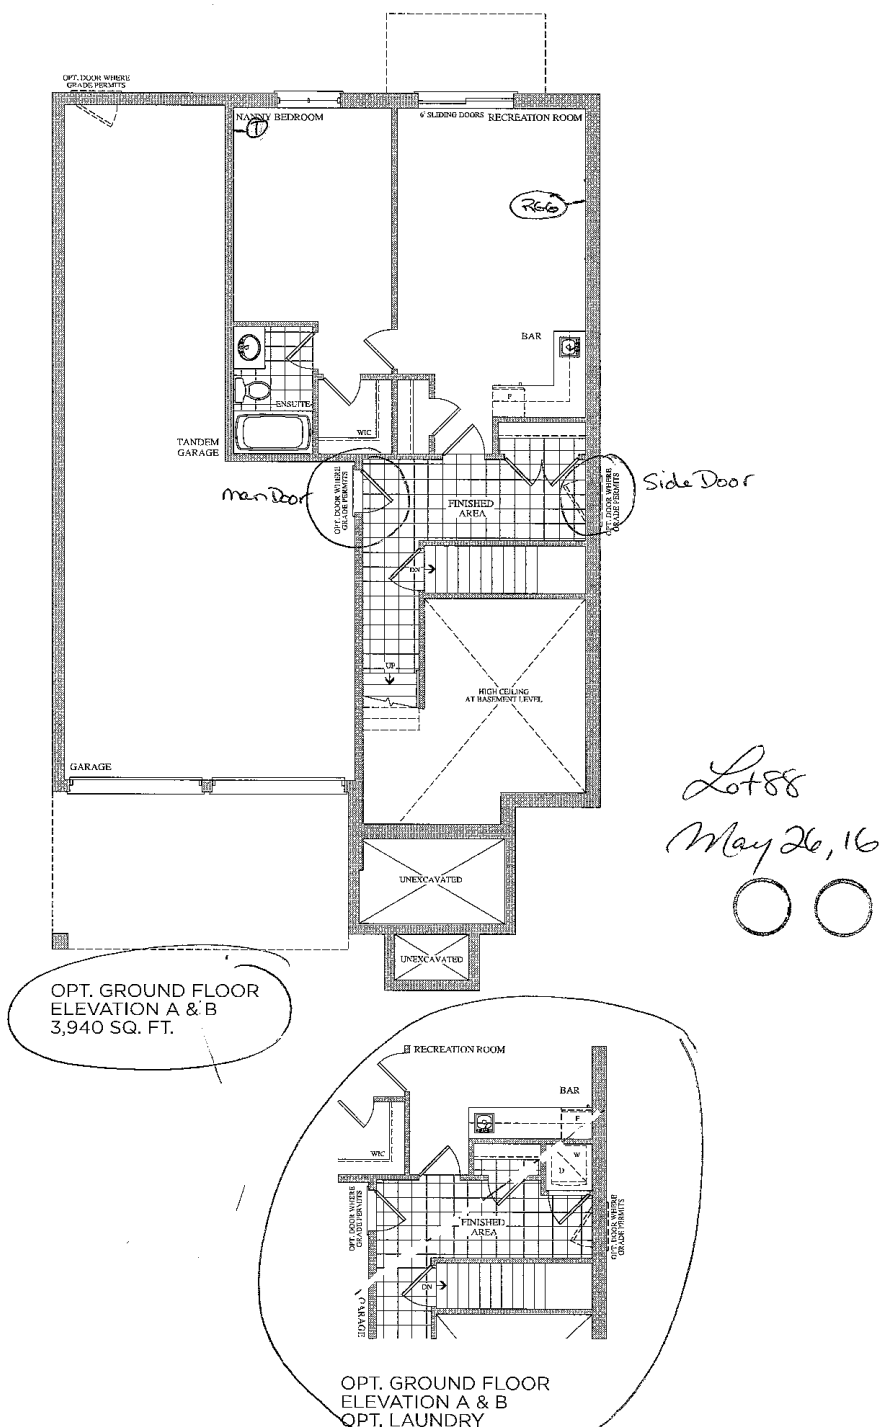

Prices, figures, illustrations, sizes, features and finishes are subject to change without notice. E.&O.E. Areas and dimensions are approximate and actual usable floor space may vary from the stated area. Layout may be reverse of the unit purchased. E. & O.E.

GOLD PARK
HOMES

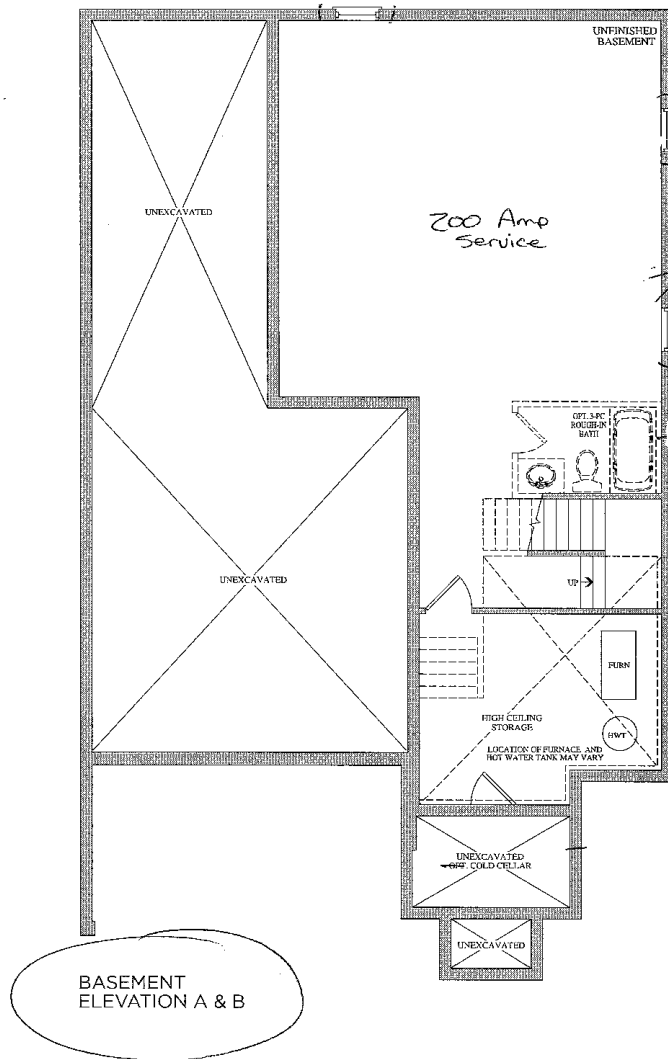

Lot 88
May 26, 16

