

CONSTRUCTION SUMMARY

120 - 1 - 38-4 Elev.B VIVALDI

CENTRAL VAC AND WIRING

Inv.606	1 - TELEPHONE AND CABLE ROUGH-IN LOCATIONS.
Line7437	Note:
27Jun16 / 27Sep16	

CERAMIC

Inv.606	1 - MASTER ENSUITE: DELETE THREE FEET OF THE MASTER ENSUITE VANITY TO ACCOMODATE A BIDET. VANITY TO STILL HAVE DOUBLE SINK. SEE SKETCH
Line12015	Note:
27Jun16 / 27Sep16	

ELECTRICAL

Inv.606	1 - KITCHEN: INSTALL KITCHEN CABINET STRIP VALANCE LIGHTS (UNDER CABINETS) - ROUGH - IN - DOES NOT INCLUDE (AND REQUIRES) KITCHEN UPGRADE PRICING
Line7438	Note:
27Jun16 / 27Sep16	
Inv.606	1 - BASEMENT: INSTALL 200 AMP ELECTRICAL SERVICE
Line7446	Note:
27Jun16 / 27Sep16	

EXTERIOR COLOURS

Inv.606	1 - EXTERIOR COLOUR PACKAGE 7
Line12012	Note:
27Jun16 / 27Sep16	

FORMING

Inv.606	1 - EXTERIOR: SIDE DOOR- HOME TO EXTERIOR- AS PER PLAN AND GRADE PERMITTING
Line7440	Note: GRADING PERMITS PER SITING DATED AUGUST 9, 2016
27Jun16 / 27Sep16	

FRAMING

Inv.606	1 - GARAGE: INSTALL MANDOOR - GARAGE TO HOUSE- AS PER PLAN AND GRADE PERMITTING
Line7439	Note: GIVEN IN AGREEMENT OF PURCHASE AND SALE
27Jun16 / 27Sep16 GRADING PERMITS PER SITING DATED AUGUST 9, 2016	
Inv.606	1 - FAMILY ROOM: INSTALL OPTIONAL COFFERED CEILING - FAMILY ROOM (PER ROOM AS PER PLAN)
Line7447	Note:
27Jun16 / 27Sep16	
Inv.606	1 - MAIN FLOOR: INSTALL FOUR (X4) STANDARD DOOR EXTENDED HEIGHT 96" (PRICE PER DOOR)- GROUND FLOOR 2 STOREY MODELS. FOR CLOSETS, POWDER ROOM AND BASEMENT DOORS
Line12016	Note:
27Jun16 / 27Sep16	

INTERIOR TRIM AND DOORS

CONSTRUCTION SUMMARY

120 - 1 - 38-4 Elev.B VIVALDI

Inv.606	4 - MAIN FLOOR: INSTALL FOUR (X4) STANDARD DOOR EXTENDED HEIGHT 96" (PRICE PER DOOR)- GROUND FLOOR 2 STOREY MODELS. FOR CLOSETS, POWDER ROOM AND BASEMENT DOORS
Line7444	Note:
27Jun16 / 27Sep16	

KITCHEN AND BATH CABINETRY

Inv.606	1 - KITCHEN: INSTALL KITCHEN CABINET STRIP VALANCE LIGHTS (UNDER CABINETS) - ROUGH - IN - DOES NOT INCLUDE (AND REQUIRES) KITCHEN UPGRADE PRICING
Line12013	Note:
27Jun16 / 27Sep16	

Inv.606	1 - MASTER ENSUITE: DELETE THREE FEET OF THE MASTER ENSUITE VANITY TO ACCOMMODATE A BIDET. VANITY TO STILL HAVE DOUBLE SINK. SEE SKETCH
Line12014	Note:
27Jun16 / 27Sep16	

MISC.

Inv.606	1 - BONUS PACKAGE: \$10,000.00 (INCLUDING TAXES) WORTH OF UPGRADES FROM GOLD PARK HOMES DÉCOR CENTRE IS BEING APPLIED TOWARD THE STRUCTURAL APPOINTMENT. PURCHASER HAS A REMAINING AMOUNT OF \$00 (INCLUDING TAXES) TO BE USED TOWARD THE COLOUR APPOINTMENT
Line7448	Note:
27Jun16 / 27Sep16	

Inv.606	1 - Purchaser has attended a Structural appointment at the Decor Centre & has DECLINED any additional upgrades and accepts and acknowledges that there will be no further structural changes/additions/deletions to be made upon signing on June 27, 2016
Line7449	Note:
27Jun16 / 27Sep16	

Inv.606	1 - Purchasers are aware & accepts that ANY changes made to upgrades after signing this Purchasers Extra Form are subject to a minimum administration fee of \$500. PLUS a 10% holdback fee
Line7450	Note:
27Jun16 / 27Sep16	

PLUMBING

Inv.606	1 - MASTER ENSUITE: DELETE THREE FEET OF THE MASTER ENSUITE VANITY TO ACCOMMODATE A BIDET. VANITY TO STILL HAVE DOUBLE SINK. SEE SKETCH
Line7441	Note:
27Jun16 / 27Sep16	

Inv.606	1 - MASTER ENSUITE: INSTALL BIDET - COMPLETE (INCLUDES FIXTURE)
Line7442	Note:
27Jun16 / 27Sep16	

Inv.606	1 - BASEMENT: INSTALL ROUGH-IN - 3PC BASEMENT ROUGH-IN, AS PER PLAN
Line7445	Note:
27Jun16 / 27Sep16	

WINDOWS - BASEMENT

Inv.606	2 - BASEMENT: INSTALL TWO (X2) BASEMENT WINDOWS - UPGRADE EXISTING BASEMENT WINDOW TO 30 INCH X 24 INCH - MAY REQUIRE INSTALLATION OF WINDOW WELL
Line7443	Note:
27Jun16 / 27Sep16	

CONSTRUCTION SUMMARY

120 - 1 - 38-4 Elev.B VIVALDI


Page 3 of 3

encore
BRAMPTON

Telephone — T
Cable — C

The Vivaldi 38' SERIES

Elevation A - 2,518 sq.ft. | Elevation B - 2,518 sq.ft.

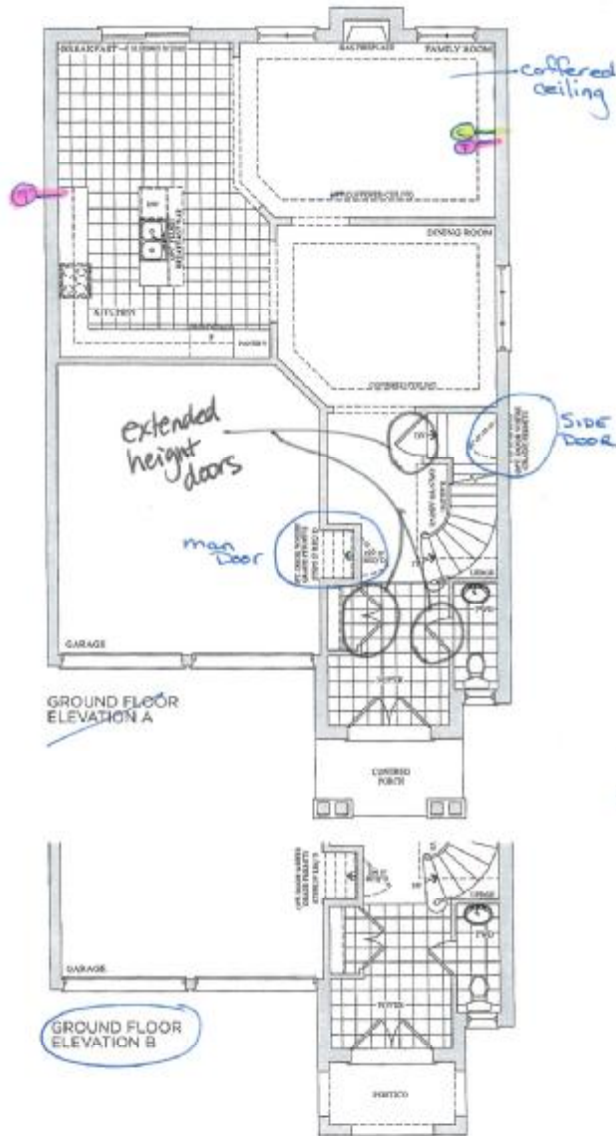

Lot 120
June 27, 16



Prices, figures, illustrations, sizes, features and finishes are subject to change without notice. L.A.D.L. Areas and dimensions are approximate and actual. Please refer to the actual floor plan for details. The layout may be revised at any time. Please refer to the actual floor plan for details.

goldpark
HOMES

GOLDPARK
HOMES


encore
BRAMPTON

The
Vivaldi
38' SERIES

Elevation A • 2,518 sq.ft. | Elevation B • 2,518 sq.ft.

Basement Windows

2 x 30"x24"

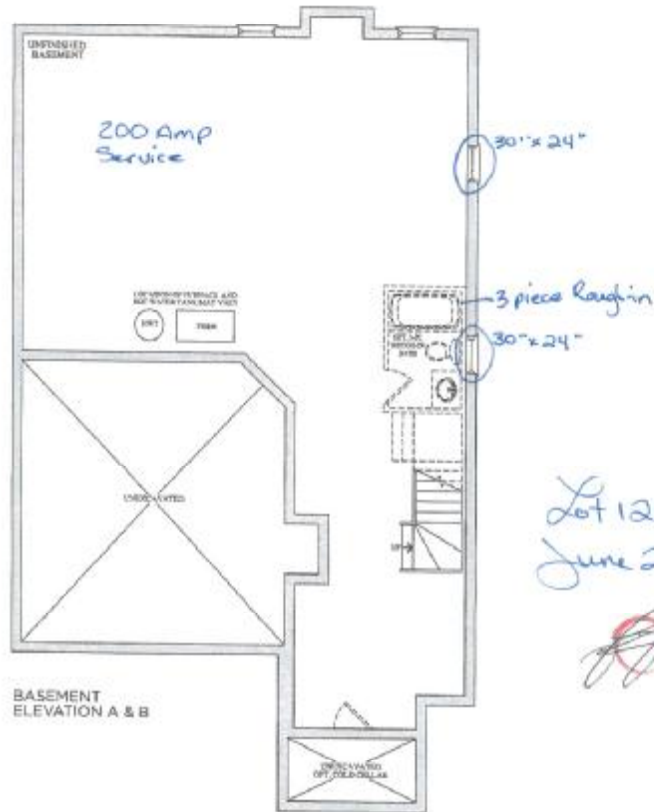

Lot 120
June 27, 16

These figures are estimates only and are subject to change without notice. All dimensions are approximate and actual square foot areas may vary from the stated area. Layout may be revised at the discretion of the architect. C & D.S.

GOLDPARK
HOMES