

Schedule 1: Designer Information

Use one form for each individual who reviews and takes responsibility for design activities with respect to the project.

A. Project Information			
Building number, street name		Unit no. 38-05 'A'	Lot/con. 7
Municipality BRAMPTON	Postal code	Plan number/ other description 43M-2005	
B. Individual who reviews and takes responsibility for design activities			
Name Julio Pinzon		Firm RN Design Limited	
Street address 8395 Jane Street		Unit no. 203	Lot/con.
Municipality Vaughan	Postal code L4K 5Y2	Province Ontario	E-mail julio@rndesign.com
Telephone number (905) 738-3177	Fax number (905) 738-5449	Cell number	
C. Design activities undertaken by individual identified in Section B. [Building Code Division C, Part 3 Table 3.5.2.1]			
<input checked="" type="checkbox"/> House <input type="checkbox"/> Small Buildings <input type="checkbox"/> Large Buildings <input type="checkbox"/> Complex Buildings		<input type="checkbox"/> HVAC – House <input type="checkbox"/> Building Services <input type="checkbox"/> Detection, Lighting and Power <input type="checkbox"/> Fire Protection	
		<input type="checkbox"/> Building Structural <input type="checkbox"/> Plumbing – House <input type="checkbox"/> Plumbing – All Buildings <input type="checkbox"/> On-site Sewage Systems	
Description of designer's work Review of the site plan design and working drawings for Lot 7 model HANDEL 38-05 'A' STD door to garage. Design responsibility excludes any structural design and specifications outside of the scope of Part 9 of the OBC.			
D. Declaration of Designer			
I, <u>Julio Pinzon</u>		declare that (choose one as appropriate):	
(print name)			
<input checked="" type="checkbox"/> I review and take responsibility for the design work on behalf of a firm registered under Division C, Part 3, subsection 3.2.4. of the Building Code. I am qualified, and the firm is registered, in the appropriate classes/categories: Individual BCIN: <u>38688</u> Firm BCIN: <u>26995</u>			
<input type="checkbox"/> I review and take responsibility for the design work and am qualified in the appropriate category as an "other designer" under Division C, Part 3, subsection 3.2.5 of the Building Code. Individual BCIN: _____ Basis for exemption from registration: _____			
<input type="checkbox"/> The design work is exempt from the registration and qualification requirements of the Building Code. Basis for exemption from registration and qualification: _____			
I certify that:			
1. The information contained in this schedule is true to the best of my knowledge.			
2. I have authority to bind the corporation or partnership (if applicable).			
May 3, 2016		 Signature of Designer	
Date			

*For the purposes of this form, "individual" means the "person" referred to in Division C, Part 3, Clause 3.2.4.7. (1)(d), Division C, Part 3, Article 3.2.5.1, and all other persons who are exempt from qualification under Division C, Part 3, Subsections 3.2.4. and 3.2.5.

NOTE:

1. Firm and Individual BCIN numbers are not required for building permit applications submitted prior to January 1, 2006
2. Schedule 1 does not need to be completed by architects, or holders of a Certificate of Practice or a Temporary License under the *Architects Act*

John G. Williams Limited, Architect



SITE PLAN

REG. PLAN No.	43M-2005
ZONE	R1FSD-39FT
LOT NUMBER	7
LOT AREA(sq. ft.)	314.42
BUDO AREA(sq. ft.)	N/A
LOT COVERAGE(%)	N/A
No. OF STOREYS	2
MEAN HEIGHT(m)	8.55
INT. GARAGE DIMS(m)	5.49m x 5.90m
GARAGE DOOR WIDTH(m)	2 x 2.44m

FTE	FINISHED FLOOR ELEVATION
TFW	TOP OF FOUNDATION WALL
TBS	TOP OF BASEMENT SLAB
USF	UNDER SIDE FOOTING
USFR	UNDER SIDE FOOTING @ REAR
USFG	UNDER SIDE FOOTING @ GARAGE
TEF	TOP OF ENGINEERED FILL
R	NUMBER OF RISERS TO GRADE
WDO	WALKOUT DECK
LOB	LOOKOUT BASEMENT
WOB	WALK OUT BASEMENT
REV	REVERSE PLAN
STO	STANDARD PLAN
△	DOOR
○	WINDOW
☒	BELL PEDISTAL
⊠	CABLE PEDISTAL
□	CATCH BASIN
▢	DBL. CATCH BASIN
★	ENGINEERED FILL
+	HYDRO CONNECTION
◆	FIRE HYDRANT
⬆	STREET LIGHT
✉	MAIL BOX
⚡	TRANSFORMER
⦿	WATER VALVE
⋈	WATER CONNECTION
▽	SEWER CONNECTIONS TIE
∇	SEWER CONNECTIONS LOFT
◻	AIR CONDITIONING
→	DOWN SLOPE TO DRAINAGE
→	SAWLE DIRECTION
- - - X - - -	CHAIN LINK FENCE
- - -	PRIVACY FENCE
- - - ○ - - -	WOOD BARRIER
- - -	FOOTING TO BE EXTENDED TO EXISTING FOUNDATION GROUP


[illegible]

LOT NO.	DESCRIPTION	QTY	UNIT	PRICE	TOTAL
1
2
RN design
imagine • inspire • create
 TEL (905) 739-3177
 FAX (905) 739-9449
 DWG@RNDESIGN.CC

6

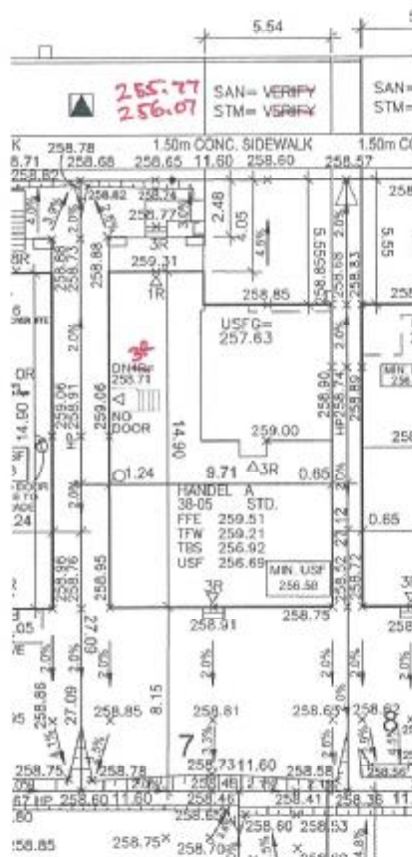

- 1) No final utility location information is at this time. Unearthed will be responsible for future changes to design. Builder should notify customer's that street hardware and above ground utility furniture may be added or removed from their footcages.
- 2) Builder to lower underside of footings where adjacent to R/LCB levels. Exact depth to be determined on site during footing excavation.
- 3) Builder to stake out driveway/curb depressions at time of curb installation.
- 4) Builder to verify location of all hydrants, street lights, transformers and other services. If not dimensions are not maintained in per City standards, builder is to relocate at his own expense.
- 5) Builder to confirm service connection elevations and review for abundance conflict prior to footing excavation.
- 6) Final fence design has not been provided at this time. Purchaser to be advised that actual fencing details may not be as shown on this plan.

We certify that the proposed grades at the lot corners are correct, and that the lot grading of the subject lot is in conformity to the approved subdivision grading plans and City standards.

REVIEWED BY: MMW DATE: 4/27/16