
This is to certify that these plans comply with the applicable Architectural Design Guidelines approved by the City of BRAMPTON.

ARCHITECTURAL REVIEW & APPROVAL

JUN 3 Q 2016

John G. Williams Limbs, Architect

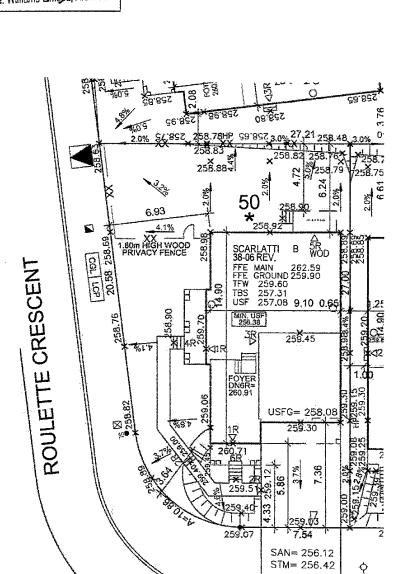

ROULETTE CRESCENT



URBANTECH NOTES:

 No final utility location information at this time, Urbantech will not be responsible for future changes to design, Builder should notify purchase that street hardware and above ground utility furniture may be added or removed from their frontages. ved from their frontages.

5,56

Builder to lower underside of footings where adjacent to RLCB lea act depth to be determined on site during footing excavation.

4) Builder to verify location of all hydrants, street lights, transformers an other services, if min, dimensions are not maintained as per City standa oulder is to relocate at his own expense.

Builder to confirm service connection elevations and review for ab conflict prior to footing excavation.

Final fence design have not been provided at this time, Purchaser to be advised that actual fencing details may not be as shown on this plan,

URBANTECH CONSULTING

We certify that the proposed grades at the lot corners are correct, and that the lot grading of the subject lot is in conformity to the approved subdivision gracing plans and City standards.

REVIEWED BY: M.L. DATE: JULE 29, 2016

IOTE: BUILDER TO VERIFY LOCATION OF ALL HYDRANTS, STREET IGHTS, TRANSFORMERS AND OTHER SERVICES, IF MIN, INMENSIONS ARE NOT MAINTAINED BUILDER IS TO RELOCATE AT ISS OWN EXPENSE

GOLD PARK HOMES

PROJECT/LOCATION MCLAUGHLIN AND MAYFIELD BRAMPTON, ON

DRAWING

SITE PLAN

	CONTRACTOR CONTRACTOR AND			
BUILDING STATISTICS				
REG. PLAN No.	43M-2005			
ZONE	R1F-9.0			
LOT NUMBER	50			
LOT AREA(m) ²	418 48			
BLDG AREA(m) ²	N/A			
LOT COVERAGE(%)	N/A			
No, OF STOREYS	2			
MEAN HEIGHT(m)	11.00			
INT. GARAGE DIMS(m)	5,49 X 6,10			
GARAGE DOOR WIDTH(m)	2 X 2,44			

LEGEND				
FFE	FINISHED FLOOR ELEVATION			
TFW	TOP OF FOUNDATION WALL			
TBS	TOP OF BASEMENT SLAB			
USF	UNDER SIDE FOOTING			
USFR	UNDER SIDE FOOTING @ REAR			
USFG	UNDER SIDE FOOTING @ GARAGE			
TEF	TOP OF ENGINEERED FILL			
R	NUMBER OF RISERS TO GRADE			
WOD	WALKOUT DECK			
LOB	LOOKOUT BASEMENT			
WOB	WALK OUT BASEMENT			
REV	REVERSE PLAN			
STD	STANDARD PLAN			
Δ	DOOR			
<u>o</u>	WINDOW			
☒	BELL PEDISTAL			
	CABLE PEDISTAL			
	CATCH BASIN			
	DBL, CATCH BASIN			
*	ENGINEERED FILL			
- - 	HYDRO CONNECTION			
Ŷ	FIRE HYDRANT			
\$ SL	STREET LIGHT			
\bowtie	MAIL BOX			
V	TRANSFORMER			
8	WATER VALVE			
•	WATER CONNECTION			
∇	SEWER CONNECTIONS 2 LOTS			
7	SEWER CONNECTIONS 1 LOT			
AG	AIR CONDITIONING			
⊕+	DOWN SPOUT TO SPLASH PAD			
\rightarrow	SWALE DIRECTION			
x-x-x-x-	CHAINLINK FENCE			
-xx-xx-xx	PRIVACY FENCE			
->>>->>>->>>->>>->>>->>>->>>->>->>->>->	SOUND BARRIER			
	FOOTING TO BE EXTENDED TO 1 25 (MIN) BELOW GRADE			

NO.	SUED OR REVISION DESCRIPTION	<u> </u>	OWN	***********
1,	ISSUED FOR REVIEW	FEB,02/16	MA	JP
2,	ISSUED FOR ENG, REVIEW	FEB, 16/16	MA	JP
3,	ISSUED FOR FINAL	MAR, 01/16	MA	JP
4,	REISSUED FOR FINAL	JUN, 09/16	MA	JP
5,	REV, AS PER ENG, COMMENTS REISSUED FOR FINAL	JUN . 28/16	МА	JP
		<u> </u>		
		 		<u> </u>
		1	-	-
		1		-
		1		

1, JULIO PINZON , DECLARE THAT I HAVE REVIEWED AND TAKE DESIGN RESPONSIBILITY FOR THE DESIGN WORK ON BEHALF OF RN DESIGN LIMITED, UNDER DIVISION C, PART 3, SUBSECTION 3.24. OF THE BUILDING CODE, I AM QUALIFIED, AND THE FIRM IS REGISTERED, IN THE APPROPRIATE CLASSES/CATEGORIES, OLD LIBERTON DESIGNED POINT 38688 38688

QUALIFIED DESIGNER BCIN

26995

JUL/11/2016

ATURE

DRAWN BY MA

SCALE 1:250

PROJECT No. 13098

LOT NUMBER 50



Imagine - Inspire - Create

Schedule 1: Designer Information Use one form for each individual who reviews and takes responsibility for design activities with respect to the project. **Project Information** Building number, street name Unit no. Lot/con. 38-06 'B' 50 Municipality Postal code Plan number/ other description **BRAMPTON** 43M-2005 Individual who reviews and takes responsibility for design activities Name Julio Pinzon **RN Design Limited** Street address Unit no. Lot/con. 8395 Jane Street 203 Postal code Municipality Province E-mail Vaughan **L4K 5Y2** juliop@rndesign.com Ontario Telephone number Fax number Cell number <u>(905) 738-3177</u> (905) 738-5449 Design activities undertaken by individual identified in Section B. [Building Code Division C, Part 3 Table 3.5.2.1 ☐ HVAC – House House Building Structural Small Buildings **Building Services** Plumbing – House Large Buildings Detection, Lighting and Power Plumbing – All Buildings Complex Buildings Fire Protection On-site Sewage Systems Description of designer's work Review of the site plan design and working drawings for Lot 50 model SCARLATTI 38-06 'B' REV door to garage. Design responsibility excludes any structural design and specifications outside of the scope of Part 9 of the OBC. D. **Declaration of Designer** Julio Pinzon 1 declare that (choose one as appropriate): ☐ I review and take responsibility for the design work on behalf of a firm registered under Division C, Part 3. subsection 3.2.4. of the Building Code. I am qualified, and the firm is registered, in the appropriate classes/categories: Individual BCIN: 38688 Firm BCIN: 26995 ☐ I review and take responsibility for the design work and am qualified in the appropriate category as an "other designer" under Division C, Part 3, subsection 3.2.5 of the Building Code. Individual BCIN: Basis for exemption from registration: The design work is exempt from the registration and qualification requirements of the Building Code. Basis for exemption from registration and qualification: I certify that: The information contained in this schedule is true to the best of my knowledge. I have authority to bind the corporation or partnership (if applicable). 1-17-

*For the purposes of this form, "individual" means the "person" referred to in Division C, Part 3, Clause 3.2.4.7. (1)(d), Division C, Part 3, Article 3.2.5.1. and all other persons who are exempt from qualification under Division C, Part 3, Subsections 3.2.4. and 3.2.5.

Signature of Designer

NOTE:

- 1. Firm and Individual BCIN numbers are not required for building permit applications submitted prior to January 1, 2006
- Schedule 1 does not need to be completed by architects, or holders of a Certificate of Practice or a Temporary License under the Architects
 Act