

John G. Williams Limited, Architects



SITE PLAN

GARAGE DOOR WIDTH(m)	N/A
----------------------	-----


--- SOUND BARRIER

[illegible]


92



DWG@RNDESIGN.COM

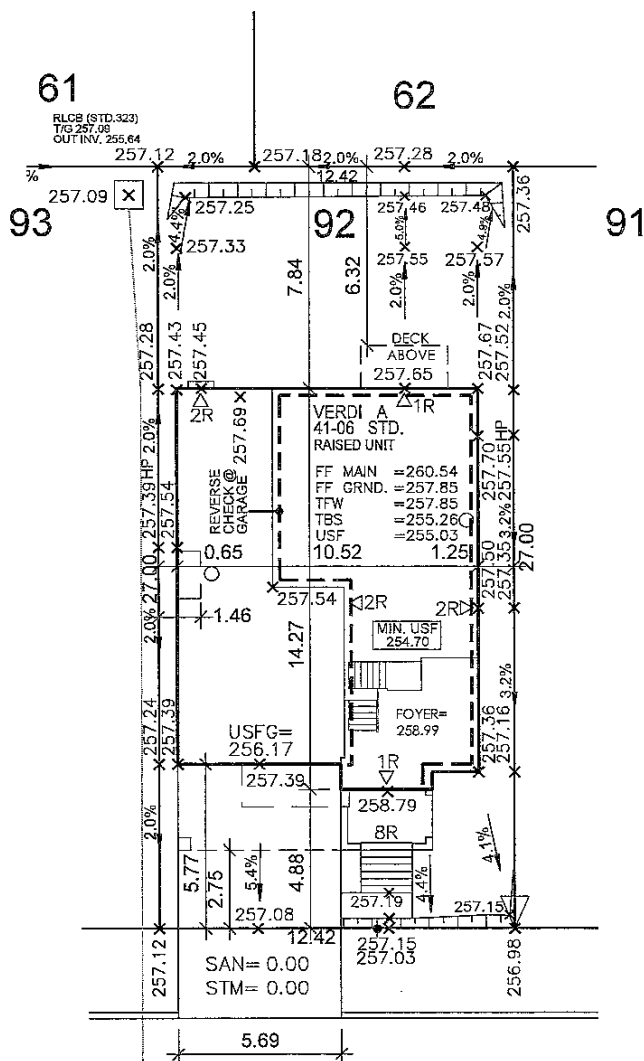

REVERSE CHECK DETAIL

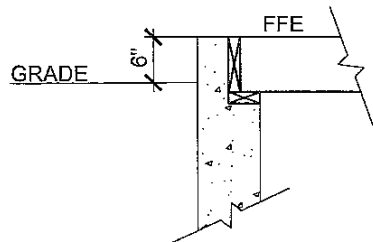

ROULETTE CRESCENT

6) Final fence design have not been provided at this time. Purchaser to be advised that actual fencing details may not be as shown on this plan.

REVIEWED BY: G.S DATE: FEB 26 116

92