



CONSTRUCTION SUMMARY

Brampton Encore - 43 - 1 - 38-6 Elev.B SCARLATTI OPT- GFA1
CENTRAL VAC AND WIRING

Inv.471	1 - FAMILY ROOM: INSTALL CONDUIT PIPE- FOR TELEVISION- MUST SPECIFY LOCATION AND TERMINATION POINT
Line5665	Note:
28Apr16 / 28Jul16	
Inv.471	1 - BEDROOM #2: INSTALL RG 6 ROUGH-IN. TO GO IN BEDROOM #2. SEE SKETCH
Line5667	Note:
28Apr16 / 28Jul16	
Inv.471	1 - BEDROOM #3: INSTALL RG 6 ROUGH-IN. TO GO IN BEDROOM #3. SEE SKETCH
Line5668	Note:
28Apr16 / 28Jul16	
Inv.471	1 - BEDROOM #4: INSTALL RG 6 ROUGH-IN. TO GO IN BEDROOM #4. SEE SKETCH
Line5669	Note:
28Apr16 / 28Jul16	
Inv.471	1 - GROUND FLOOR/ REC ROOM: INSTALL RG 6 ROUGH-IN. TO GO IN GROUND FLOOR REC ROOM. SEE SKETCH
Line5670	Note:
28Apr16 / 28Jul16	

ELECTRICAL

Inv.471	1 - TELEPHONE AND CABLE ROUGH-IN LOCATION
Line5664	Note:
28Apr16 / 28Jul16	
Inv.471	1 - FAMILY ROOM: INSTALL 110V WALL RECEPTACLE ON DEDICATED CIRCUIT - ABOVE FIREPLACE SEE SKETCH
Line5666	Note:
28Apr16 / 28Jul16	
Inv.471	1 - KITCHEN: INSTALL 110V WALL RECEPTACLE ON DEDICATED CIRCUIT - FOR MICROWAVE - MICROWAVE NOT INCLUDED TO GO ABOVE STOVE
Line5671	Note:
28Apr16 / 28Jul16	
Inv.471	1 - BASEMENT: INSTALL 200 AMP ELECTRICAL SERVICE, IN LIEU OF STANDARD 100 AMP
Line5672	Note:
28Apr16 / 28Jul16	
Inv.471	1 - LIVING ROOM: INSTALL ADDITIONAL STANDARD FIXTURE ON SAME SWITCH AS BUILDER'S STANDARD SWITCH CONTROLLED RECEPTICAL. SEE SKETCH
Line5673	Note:
28Apr16 / 28Jul16	

EXTERIOR COLOURS

Inv.471	1 - EXTERIOR COLOUR PACKAGE 9 /
Line9460	Note:
28Apr16 / 28Jul16	

FORMING

Inv.471	1 - EXTERIOR: INSTALL SIDE DOOR- HOME TO EXTERIOR- AS PER PLAN AND GRADE PERMITTING
Line6296	Note:
28Apr16 / 28Jul16	



CONSTRUCTION SUMMARY

Brampton Encore - 43 - 1 - 38-6 Elev.B SCARLATTI OPT- GFA1

FRAMING

Inv.471	1 - GARAGE: INSTALL MANDOOR - GARAGE TO HOUSE- AS PER PLAN AND GRADE PERMITING
Line6283	Note: GIVEN, AS PER AGREEMENT OF PURCHASE AND SALE
28Apr16 / 28Jul16	

HVAC

Inv.471	1 - KITCHEN: INSTALL GAS LINE ROUGH - MAIN FLOOR - (3 STOREY MODELS) FOR STOVE
Line5685	Note:
28Apr16 / 28Jul16	

MISC.

Inv.471	1 - BONUS PACKAGE: \$6503.15 (INCLUDING TAXES) WORTH OF UPGRADES FROM GOLD PARK HOMES DÉCOR CENTRE IS BEING APPLIED TOWARD THE STRUCTURAL APPOINTMENT. PURCHASER HAS A REMAINING AMOUNT OF \$3496.85 (INCLUDING TAXES) TO BE USED TOWARD THE COLOUR APPOINTMENT
Line6387	Note:
28Apr16 / 28Jul16	
Inv.471	1 - Purchaser has attended a Structural appointment at the Decor Centre & has DECLINED any additional upgrades and accepts and acknowledges that there will be no further structural changes/additions/deletions to be made upon signing on May 26, 2016
Line6293	Note:
28Apr16 / 28Jul16	
Inv.471	1 - Purchasers are aware & accepts that ANY changes made to upgrades after signing this Purchasers Extra Form are subject to a minimum administration fee of \$500. PLUS a 10% holdback fee.
Line6294	Note:
28Apr16 / 28Jul16	

PLUMBING



Inv.471	1 - KITCHEN: INSTALL ROUGH-IN - WATERLINE FOR FRIDGE
Line5686	Note:
28Apr16 / 28Jul16	

encore
BRAMPTON

Telephone — (T)
Cable — (C)
Electrical — (E)

The
Scarlatti
38' SERIES

Elevation A • 3,591 sq.ft. | Elevation B • 3,578 sq.ft.

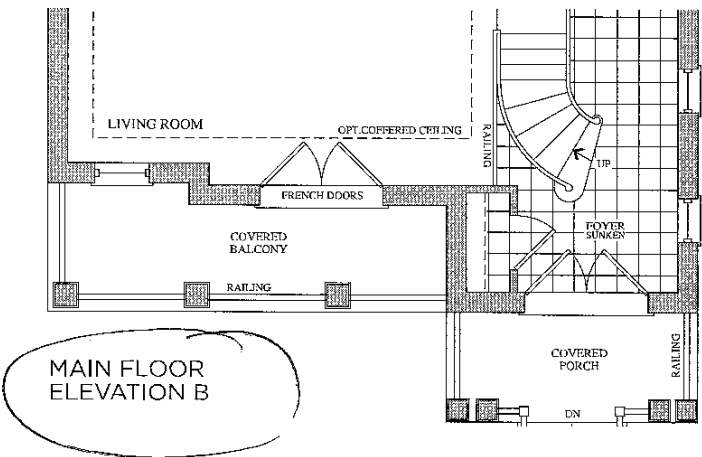
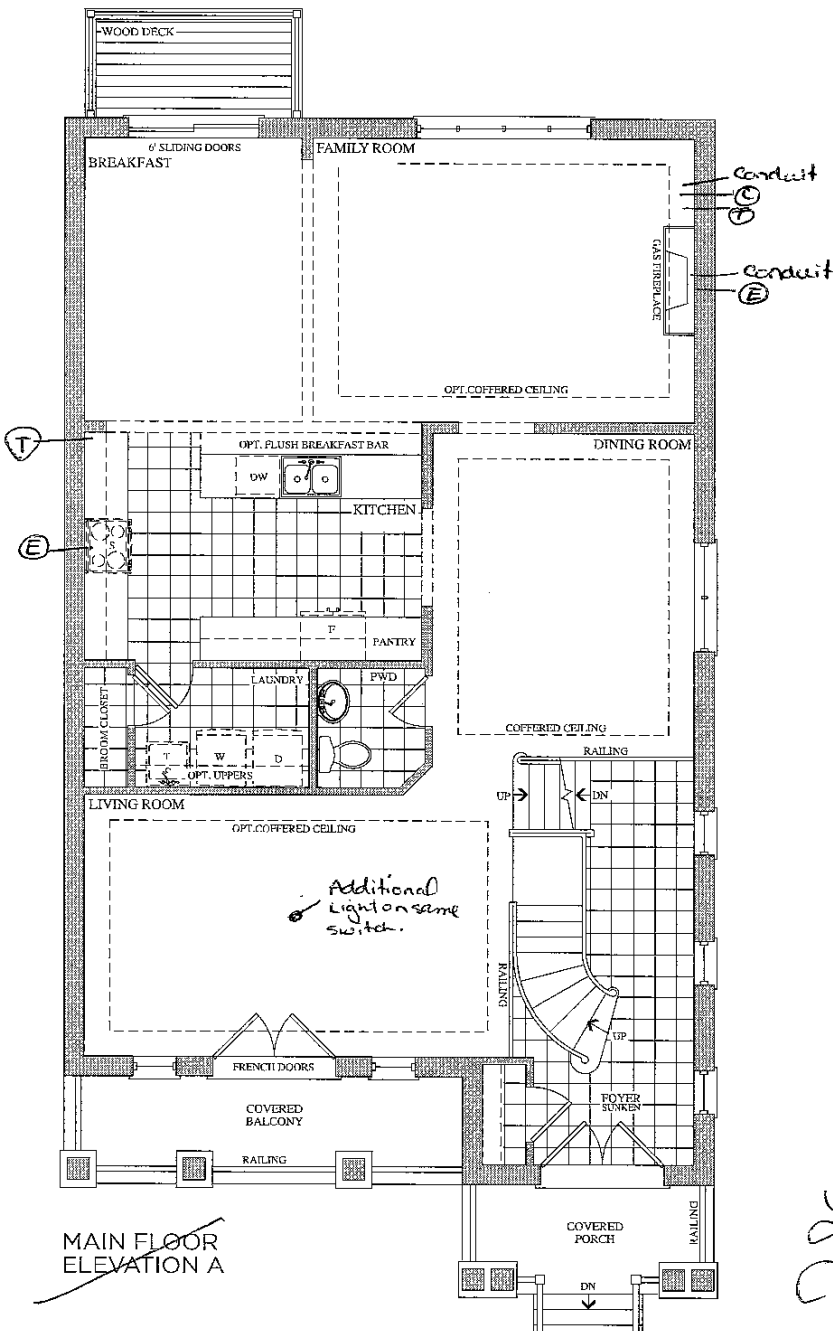


Lot 43
May 26, 16
○○

Prices, figures, illustrations, sizes, features and finishes are subject to change without notice. E.&O.E. Areas and dimensions are approximate and actual usable floor space may vary from the stated area. Layout may be reverse of the unit purchased. E. & C.E.

The
Scarlatti
38' SERIES

Elevation A • 3,591 sq.ft. | Elevation B • 3,578 sq.ft.

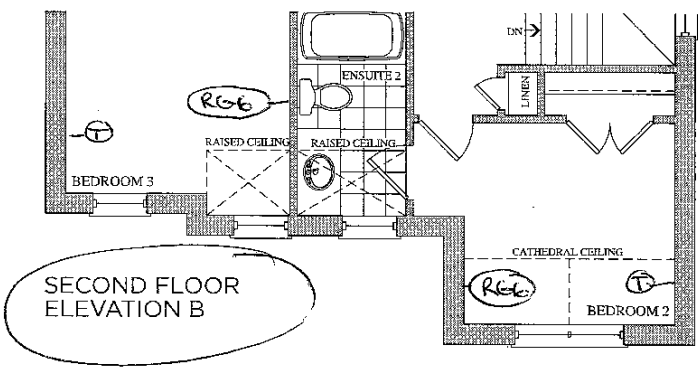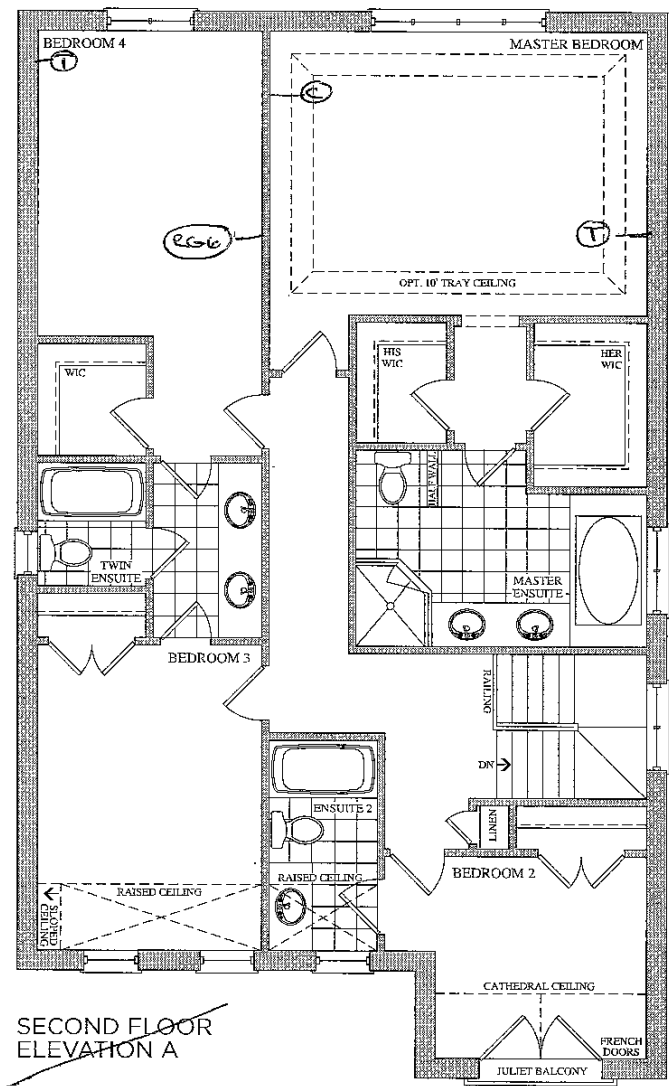

Lot 43
May 26, 16



encore
BRAMPTON


Telephone — (T)

Cable — (C)

The Scarlatti

38' SERIES

Elevation A • 3,591 sq.ft. | Elevation B • 3,578 sq.ft.

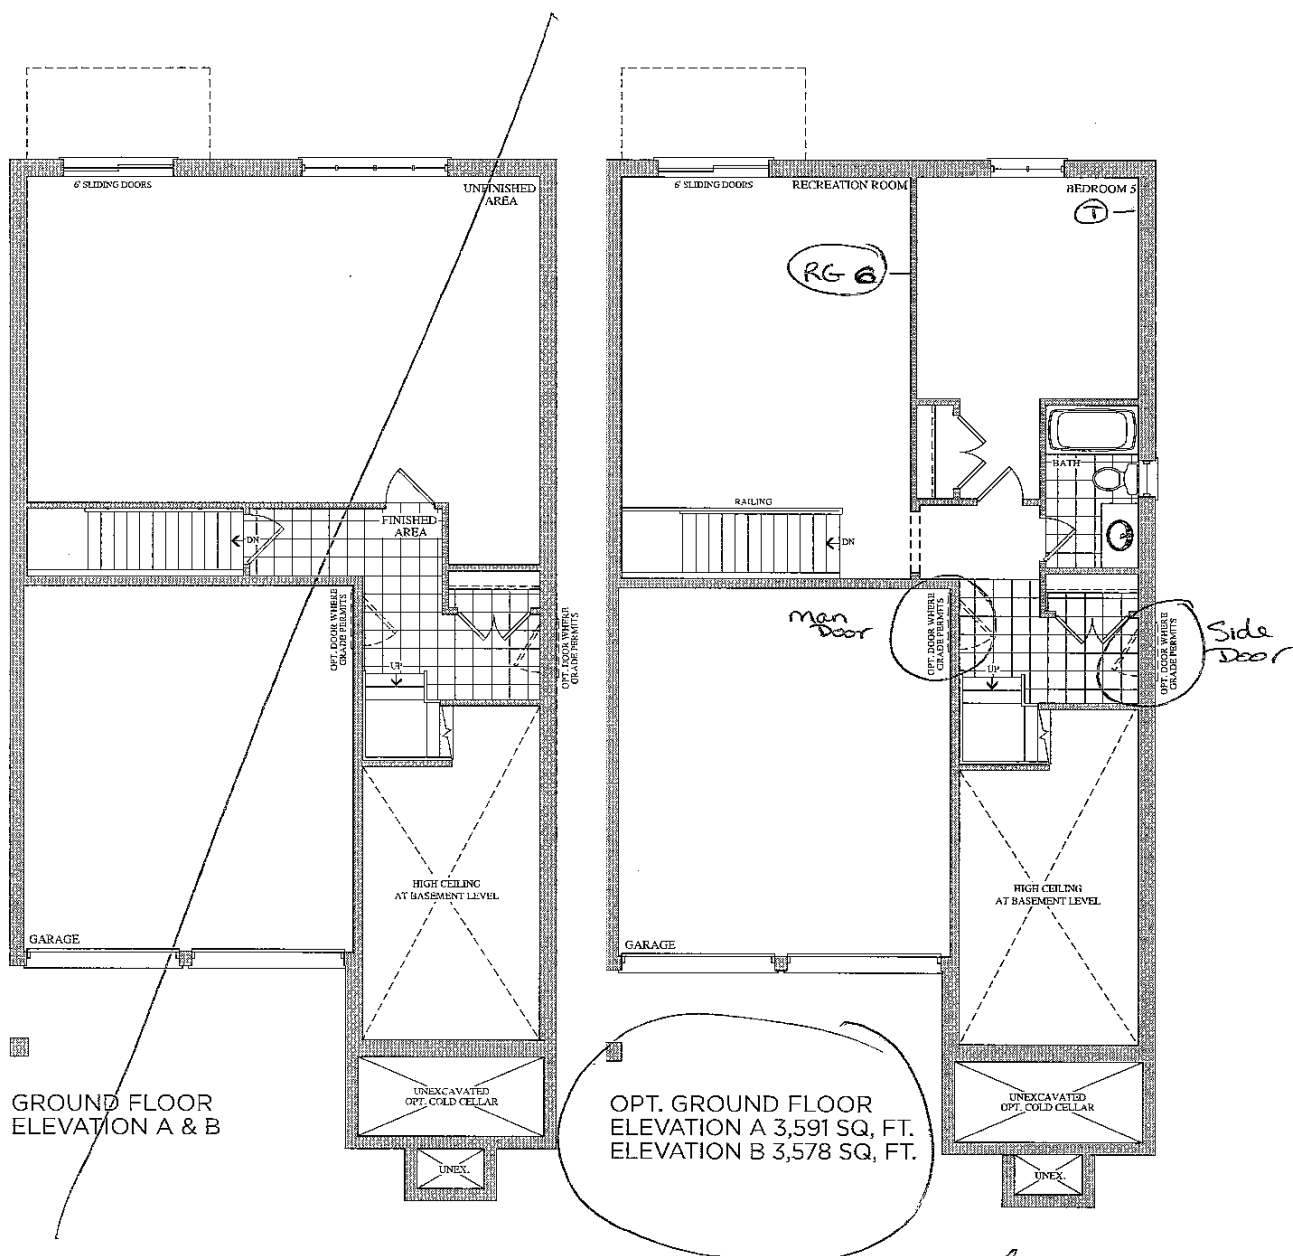

Lot 43

May 26, 14



Prices, figures, illustrations, sizes, features and finishes are subject to change without notice. E.&O.E. Areas and dimensions are approximate and actual usable floor space may vary from the stated area. Layout may be reverse of the unit purchased. E. & O.E.

GOLDPARK
HOMES



UNFINISHED BASEMENT

200 Amp Service

UP

UNEXCAVATED

HTWT

LOCATION OF FURNACE AND HOT WATER TANK MAY VARY


FURN

HIGH CEILING

UNEXCAVATED OPT. COLD CELLAR

UNEX

BASEMENT ELEVATION A & B

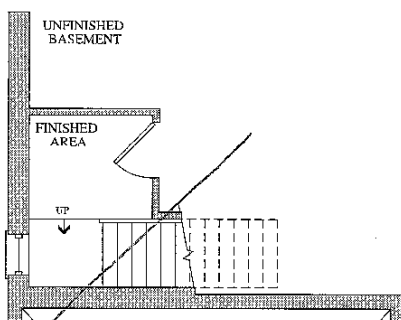

Lot 43
May 26, 16



GOLDPARK
HOMES



Stacey Carlete
Project Coordinator



Claude Azzopardi
Contracts Manager



Nancy Mc
Corporate C

43
Lot #



38.1 The Bizet			
Elevation	Circle One	A	2189.6 Square Feet
		B	2186.7 Square Feet
Optional Layouts	Circle All that Apply		

38.2 The Ravel			
Elevation	Circle One	A	2271.5 Square Feet
		B	2273.7 Square Feet
Optional Layouts	Circle All that Apply		

38.3 The Haydn			
Elevation	Circle One	A	2394.5 Square Feet
		B	2388.3 Square Feet
Optional Layouts	Circle All that Apply		

38.4 The Vivaldi			
Elevation	Circle One	A	2459.1 Square Feet
		B	2459.1 Square Feet
Optional Layouts	Circle All that Apply		

38.5 The Handel			
Elevation	Circle One	A	2549.2 Square Feet
		B	2554.7 Square Feet
Optional Layouts	Circle All that Apply		

38.9 The Puccini			
Elevation	Circle One	A	3628.0 Square Feet
		B	3634.7 Square Feet
Optional Layouts	Circle All that Apply	GFA1	GROUND FLOOR Optional Alternative Layout

38.6 The Scarlatti			
Elevation	Circle One	A	3521.1 Square Feet
		B	3508.1 Square Feet
Optional Layouts	Circle All that Apply	GFA1	GROUND FLOOR Optional Alternative Layout

38.7 The Schubert			
Elevation	Circle One	A	3593.8 Square Feet
		B	3610.5 Square Feet
Optional Layouts	Circle All that Apply	GFA1	GROUND FLOOR Optional Alternative Layout
		SFA4	SECOND FLOOR Additional Bedroom

38.8 The Corelli			
Elevation	Circle One	A	3801.5 Square Feet
		B	3801.5 Square Feet
Optional Layouts	Circle All that Apply	GFA1	GROUND FLOOR Optional Alternative Layout
		SFA4	SECOND FLOOR Additional Bedroom w/ Ensuite

41.1 The Strauss			
Elevation	Circle One	A	2554.2 Square Feet
		B	2571.2 Square Feet
Optional Layouts	Circle All that Apply	SFA1	SECOND FLOOR Shower in Lieu of Tub B2

41.2 The Mozart			
Elevation	Circle One	A	2725.9 Square Feet
		B	2711.1 Square Feet
Optional Layouts	Circle All that Apply	SFA1	SECOND FLOOR Shower in Lieu of Tub B2

41.3 The Chopin			
Elevation	Circle One	A	2800.0 Square Feet
		B	2810.5 Square Feet
Optional Layouts	Circle All that Apply		

41.4 The Bach			
Elevation	Circle One	A	2894.4 Square Feet
		B	2894.5 Square Feet
Optional Layouts	Circle All that Apply		

41.5 The Brahms			
Elevation	Circle One	A	3948.1 Square Feet
		B	3949.1 Square Feet
Optional Layouts	Circle All that Apply	GFA1	GROUND FLOOR Optional Alternative Layout
		SFA2	SECOND FLOOR Shower in Lieu of Tub B4
		SFA3	SECOND FLOOR Optional Laundry Layout

41.6 The Verdi			
Elevation	Circle One	A	3862.5 Square Feet
		B	3866.4 Square Feet
Optional Layouts	Circle All that Apply	GFA1	GROUND FLOOR Optional Alternative Layout
		SFA3	SECOND FLOOR Optional Laundry Layout

May 26, 16

