



CONSTRUCTION SUMMARY

* Structural *

Brampton Encore - 62 - 1 - 41-1 Elev.Á STRAUSS

ELECTRICAL

Inv.441	1 - TELEPHONE AND CABLE ROUGH-IN LOCATIONS
Line5338	Note:
20Apr16 / 26Jul16	
Inv.441	1 - BASEMENT: INSTALL 200 AMP ELECTRICAL SERVICE, IN LIEU OF STANDARD 100 AMPS
Line5339	Note:
20Apr16 / 26Jul16	

EXTERIOR COLOURS

Inv.441	1 - EXTERIOR COLOUR PACKAGE 3 /
Line9308	Note:
20Apr16 / 26Jul16	

FORMING

Inv.441	1 - EXTERIOR: INSTALL SIDE DOOR- HOME TO EXTERIOR- AS PER PLAN AND GRADE PERMITTING
Line5343	Note:
20Apr16 / 26Jul16	

HVAC

Inv.441	1 - KITCHEN: INSTALL GAS LINE ROUGH-IN - MAIN FLOOR - (2 STOREY MODELS) FOR STOVE
Line5341	Note:
20Apr16 / 26Jul16	

MISC.

Inv.441	1 - BONUS PACKAGE: \$6876.05 (INCLUDING TAXES) WORTH OF UPGRADES FROM GOLD PARK HOMES DÉCOR CENTRE IS BEING APPLIED TOWARD THE STRUCTURAL APPOINTMENT. PURCHASER HAS A REMAINING AMOUNT OF \$8123.94 (INCLUDING TAXES) TO BE USED TOWARD THE COLOUR APPOINTMENT
Line5345	Note:
20Apr16 / 26Jul16	
Inv.441	1 - Purchaser has attended a Structural appointment at the Decor Centre & has DECLINED any additional upgrades and accepts and acknowledges that there will be no further structural changes/additions/deletions to be made upon signing on April 20,2016
Line5346	Note:
20Apr16 / 26Jul16	
Inv.441	1 - Purchasers are aware & accepts that ANY changes made to upgrades after signing this Purchasers Extra Form are subject to a minimum administration fee of \$500. PLUS a 10% holdback fee.
Line5347	Note:
20Apr16 / 26Jul16	

PLUMBING

Inv.441	1 - BASEMENT: INSTALL ROUGH-IN - 3PC BASEMENT ROUGH-IN, AS PER PLAN
Line5342	Note:
20Apr16 / 26Jul16	

WINDOWS - BASEMENT

Inv.441	1 - BASEMENT: INSTALL FOUR (4) BASEMENT WINDOWS - UPGRADE EXISTING BASEMENT WINDOW TO 30 INCH X 24 INCH - MAY REQUIRE INSTALLATION OF WINDOW WELL
Line5340	Note:
20Apr16 / 26Jul16	



CONSTRUCTION SUMMARY

Brampton Encore - 62 - 1 - 41-1 Elev.A STRAUSS



WINDOWS AND DOORS

Inv.441	1 - MAN DOOR GARAGE TO HOUSE - OPTIONAL - IF GRADE PERMITS
Line9307	Note: As per APS Bonus Package
20Apr16 / 26Jul16	

Telephone — ①
Cable — ②

The Strauss 41' SERIES




Elevation A • 2,607 sq.ft. | Elevation B • 2,625 sq.ft.

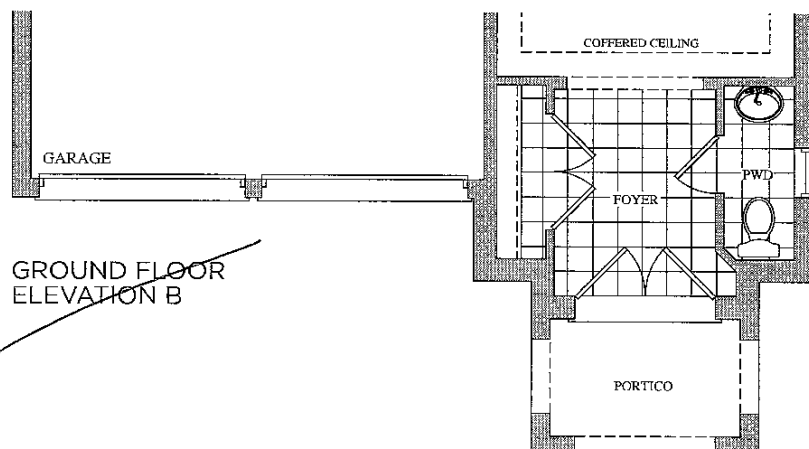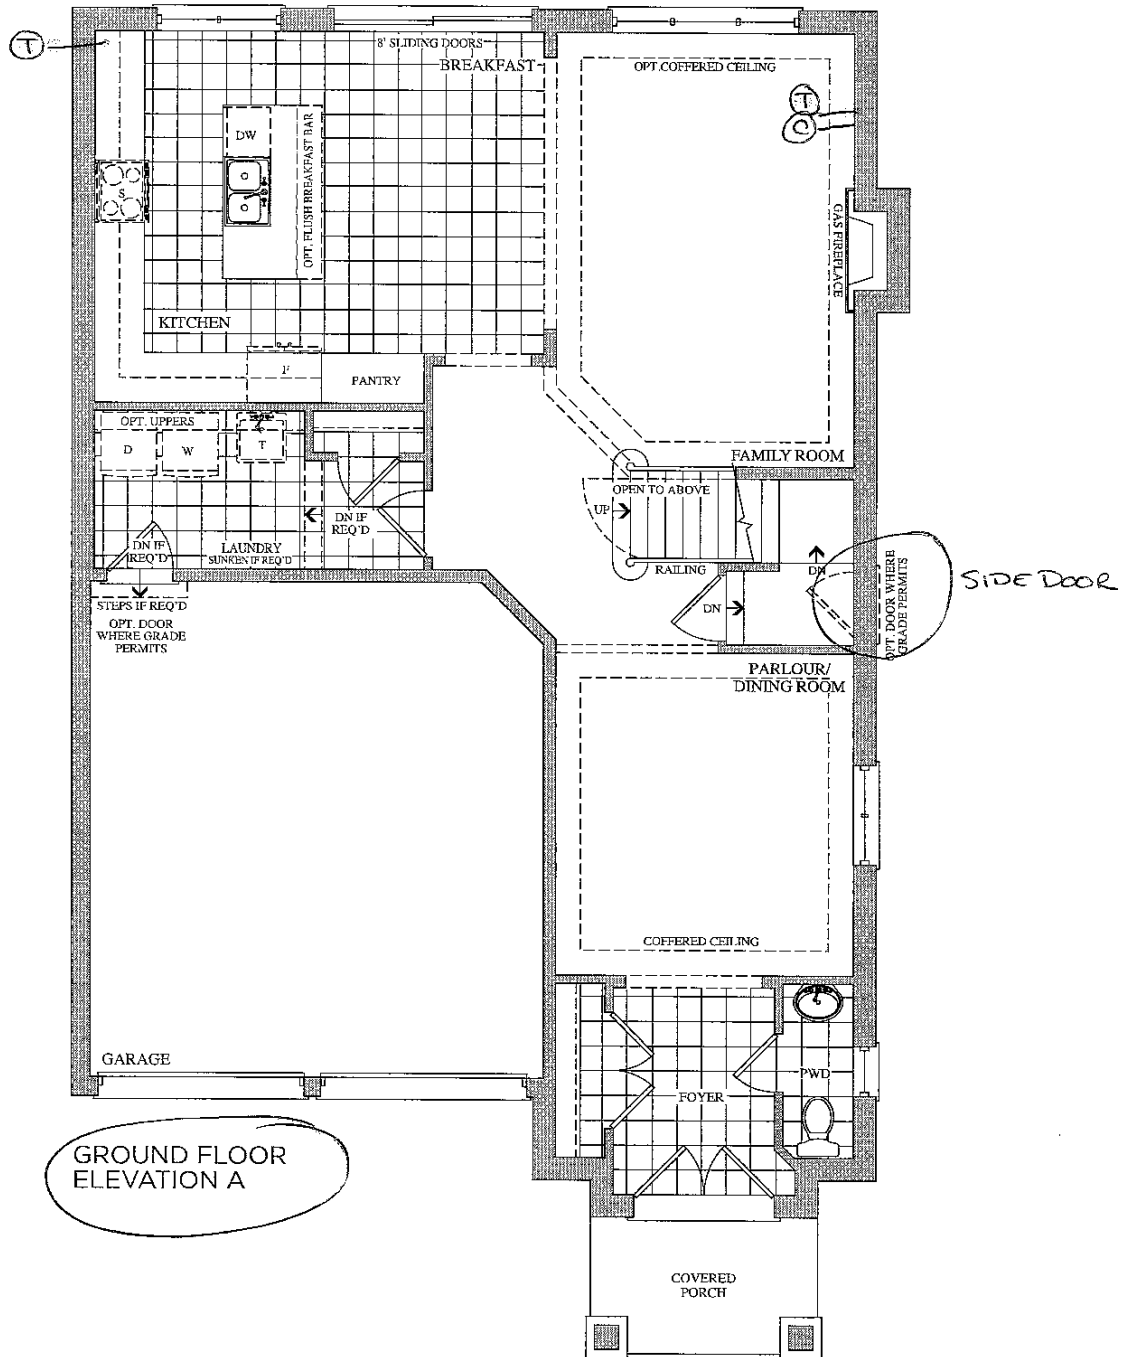

The Strauss

41' SERIES

Elevation A • 2,607 sq.ft. | Elevation B • 2,625 sq.ft.

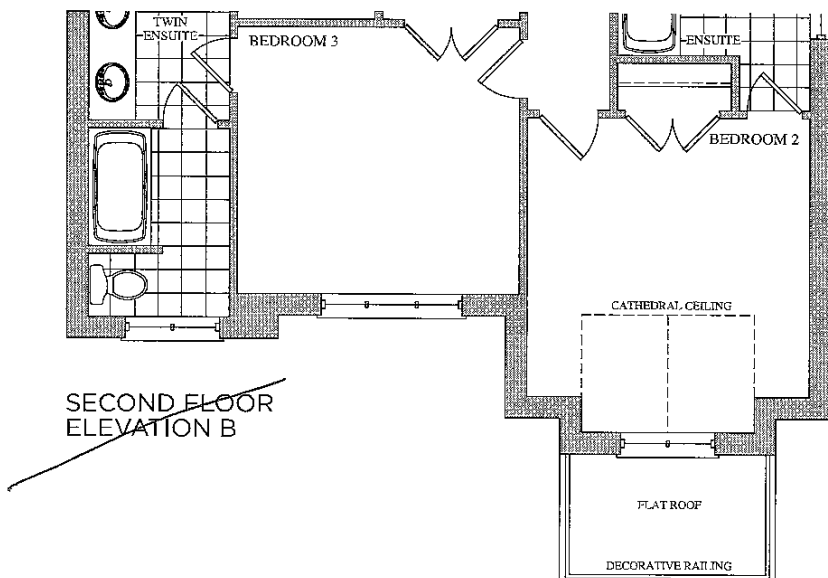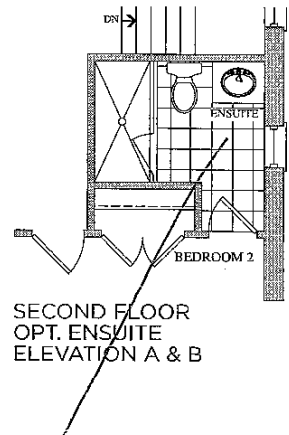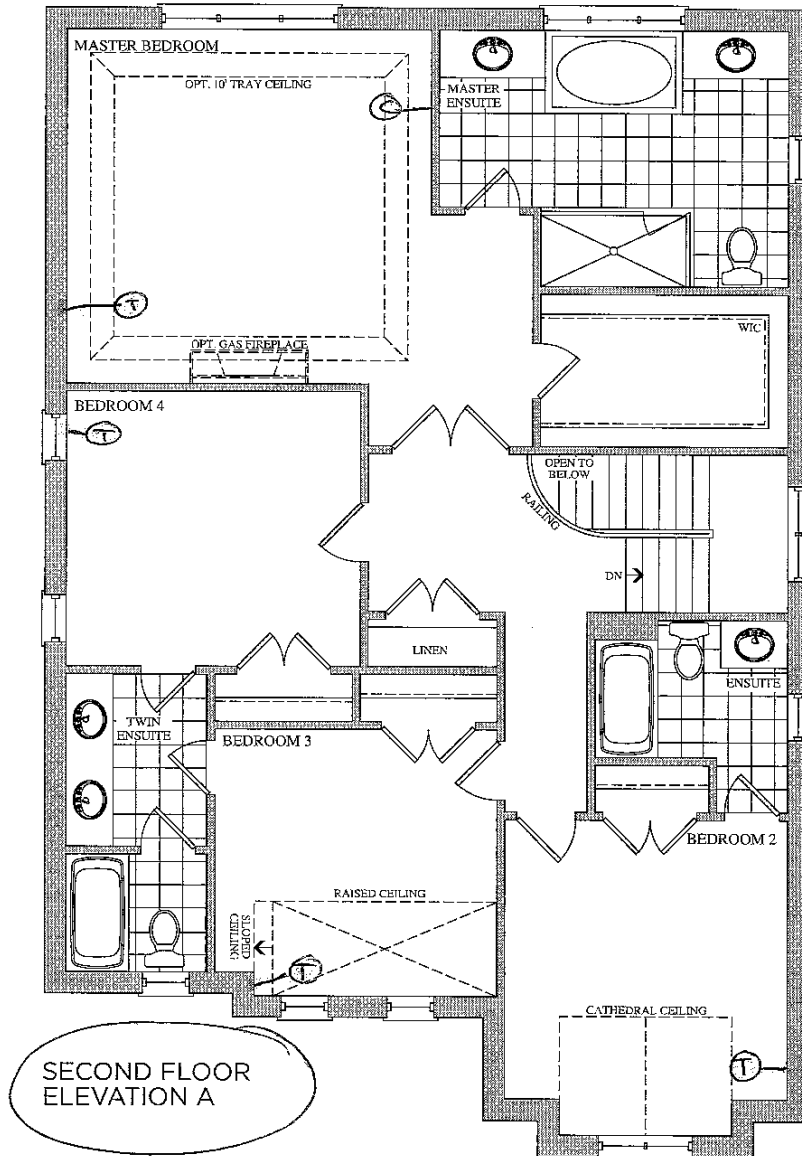


Lot 62
April 20, 2016

② ②

BSMNT WINDOWS
4x 30"x24"

Elevation A • 2,607 sq.ft. | Elevation B • 2,625 sq.ft.

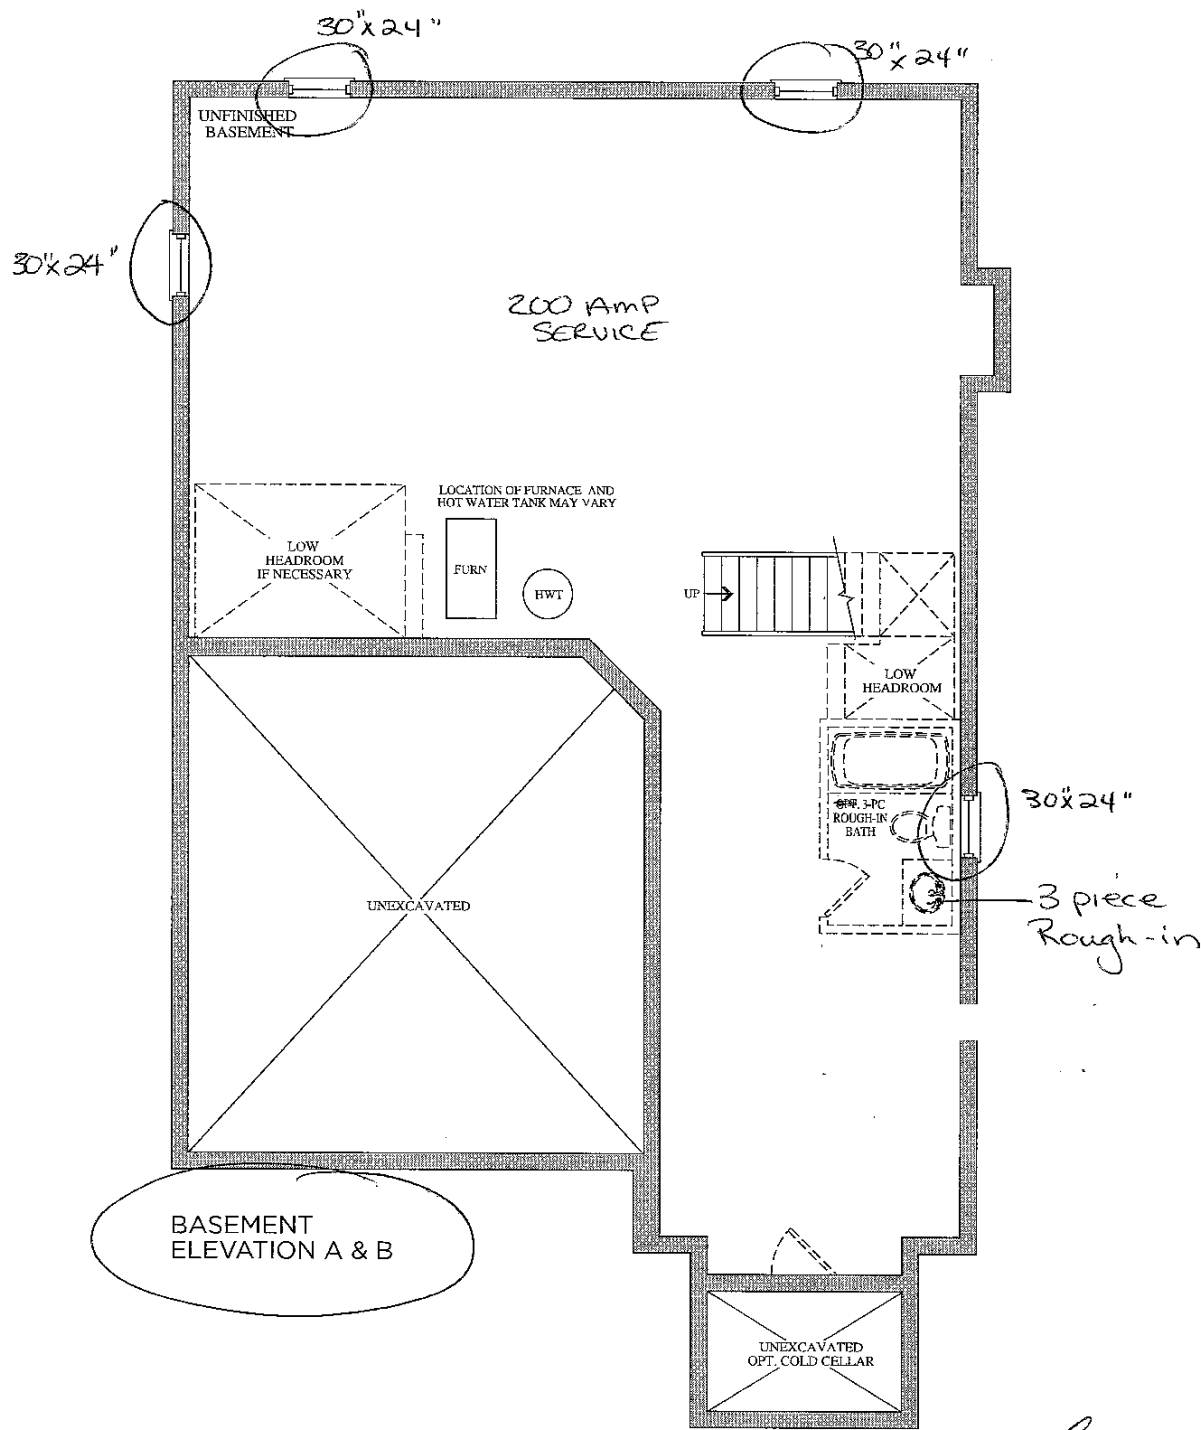

Lot 62
April 20, 2016

Per W.K.



Stacey Carlete
Project Coordinator



Claude Azzopardi
Contracts Manager



Nancy Mc
Corporate

41
Lot #



38.1 The Bizet			
Elevation	Circle One	A	2189.6 Square Feet
		B	2186.7 Square Feet
Optional Layouts	Circle All that Apply		

38.2 The Ravel			
Elevation	Circle One	A	2271.5 Square Feet
		B	2273.7 Square Feet
Optional Layouts	Circle All that Apply		

38.3 The Haydn			
Elevation	Circle One	A	2394.5 Square Feet
		B	2388.3 Square Feet
Optional Layouts	Circle All that Apply		

38.4 The Vivaldi			
Elevation	Circle One	A	2459.1 Square Feet
		B	2459.1 Square Feet
Optional Layouts	Circle All that Apply		

38.5 The Handel			
Elevation	Circle One	A	2549.2 Square Feet
		B	2554.7 Square Feet
Optional Layouts	Circle All that Apply		

38.9 The Puccini			
Elevation	Circle One	A	3628.0 Square Feet
		B	3634.7 Square Feet
Optional Layouts	Circle All that Apply	GFA1	GROUND FLOOR Optional Alternative Layout

38.6 The Scarlatti			
Elevation	Circle One	A	3521.1 Square Feet
		B	3508.1 Square Feet
Optional Layouts	Circle All that Apply	GFA1	GROUND FLOOR Optional Alternative Layout

38.7 The Schubert			
Elevation	Circle One	A	3593.8 Square Feet
		B	3610.5 Square Feet
Optional Layouts	Circle All that Apply	GFA1	GROUND FLOOR Optional Alternative Layout
		SFA4	SECOND FLOOR Additional Bedroom

38.8 The Corelli			
Elevation	Circle One	A	3801.5 Square Feet
		B	3801.5 Square Feet
Optional Layouts	Circle All that Apply	GFA1	GROUND FLOOR Optional Alternative Layout
		SFA4	SECOND FLOOR Additional Bedroom w/ Ensuite

41.1 The Strauss			
Elevation	Circle One	A	2554.2 Square Feet
		B	2571.2 Square Feet
Optional Layouts	Circle All that Apply	SFA1	SECOND FLOOR Shower in Lieu of Tub B2

41.2 The Mozart			
Elevation	Circle One	A	2725.9 Square Feet
		B	2711.1 Square Feet
Optional Layouts	Circle All that Apply	SFA1	SECOND FLOOR Shower in Lieu of Tub B2

41.3 The Chopin			
Elevation	Circle One	A	2800.0 Square Feet
		B	2810.5 Square Feet
Optional Layouts	Circle All that Apply		

41.4 The Bach			
Elevation	Circle One	A	2894.4 Square Feet
		B	2894.5 Square Feet
Optional Layouts	Circle All that Apply		

41.5 The Brahms			
Elevation	Circle One	A	3948.1 Square Feet
		B	3949.1 Square Feet
Optional Layouts	Circle All that Apply	GFA1	GROUND FLOOR Optional Alternative Layout
		SFA2	SECOND FLOOR Shower in Lieu of Tub B4
		SFA3	SECOND FLOOR Optional Laundry Layout

41.6 The Verdi			
Elevation	Circle One	A	3862.5 Square Feet
		B	3866.4 Square Feet
Optional Layouts	Circle All that Apply	GFA1	GROUND FLOOR Optional Alternative Layout
		SFA3	SECOND FLOOR Optional Laundry Layout

April 20, 2016

