

Brampton Encore - 91 - 1 - 41-5 Elev.B BRAHMS OPT - GFA1
CENTRAL VAC AND WIRING

Inv.439	1 - INSTALL VAC PAN UNDER KITCHEN SINK
Line5304	Note:
19Apr16 / 27Jul16	
Inv.439	1 - BEDROOM #4: INSTALL RG 6 ROUGH-IN IN BED #4. SEE SKETCH
Line5309	Note:
19Apr16 / 27Jul16	
Inv.439	1 - GROUND FLOOR REC ROOM: INSTALL RG 6 ROUGH-IN. SEE SKETCH
Line5312	Note:
19Apr16 / 27Jul16	
Inv.439	1 - FAMILY ROOM: INSTALL CONDUIT PIPE- FOR TELEVISION- MUST SPECIFY LOCATION AND TERMINATION POINT. SEE SKETCH
Line5313	Note:
19Apr16 / 27Jul16	

ELECTRICAL

Inv.439	1 - TELEPHONE AND CABLE ROUGH-IN LOCATION.
Line5303	Note:
19Apr16 / 27Jul16	
Inv.439	1 - FAMILY ROOM: INSTALL 110V WALL RECEPTACLE ON DEDICATED CIRCUIT - ABOVE FIREPLACE SEE SKETCH
Line5314	Note:
19Apr16 / 27Jul16	
Inv.439	1 - KITCHEN: INSTALL 110V WALL RECEPTACLE ON DEDICATED CIRCUIT - FOR MICROWAVE - MICROWAVE NOT INCLUDED. FOR FUTURE WALL OVEN/MICROWAVE UNIT. CABINETRY TO ACCOMODATE APPLIANCE TO BE PURCHASED AT THE TIME OF COLOURS
Line5317	Note:
19Apr16 / 27Jul16	
Inv.439	1 - KITCHEN: INSTALL 220V WALL RECEPTICAL ON DEDICATED CIRCUIT- FOR 4 WIRE BUILT-IN WALL OVEN - MUST SPECIFY LOCATION. FOR FUTURE WALL OVEN/MICROWAVE UNIT. CABINETRY TO ACCOMODATE APPLIANCE TO BE PURCHASED AT THE TIME OF COLOURS
Line5318	Note:
19Apr16 / 27Jul16	
Inv.439	1 - LIVING ROOM: ROUGH - IN CEILING OUTLET & SWITCH (WITH COVER PLATE) - DOES NOT INCLUDE FIXTURE - MUST SPECIFY LOCATION. NOTE STANDARD LOCATION OF DINING ROOM LIGHT. IN ADDITION TO BUILDER'S STANDARD SWITCH CONTROLLED RECEPTICAL.
Line5319	Note:
19Apr16 / 27Jul16	
Inv.439	1 - KITCHEN CABINET STRIP VALANCE LIGHTS (UNDER CABINETS) - ROUGH - IN - DOES NOT INCLUDE (AND REQUIRES) KITCHEN UPGRADE PRICING
Line5320	Note:
19Apr16 / 27Jul16	

EXTERIOR COLOURS

Inv.439	1 - EXTERIOR COLOUR PACKAGE 1
Line9325	Note:
19Apr16 / 27Jul16	

FIREPLACE

Brampton Encore - 91 - 1 - 41-5 Elev.B BRAHMS OPT - GFA1

Inv.439	1 - MASTER BEDROOM: INSTALL OPTIONAL FIREPLACE IN MASTER ENSUITE. STANDARD FIREPLACE INCLUDES WHITE MANTLE AND MARBLE SURROUND.
Line5311	Note:
19Apr16 / 27Jul16	

FORMING

Inv.439	1 - SIDE DOOR- HOME TO EXTERIOR- AS PER PLAN AND GRADE PERMITTING
Line5321	Note:
19Apr16 / 27Jul16	

FRAMING

Inv.439	1 - GROUND FLOOR: SMOOTH CEILINGS - (3-Story Design) GROUND FLOOR
Line5322	Note:
19Apr16 / 27Jul16	
Inv.439	1 - FAMILY ROOM: INSTALL OPTIONAL COFFERED CEILING - FAMILY ROOM (PER ROOM AS PER PLAN)
Line5323	Note:
19Apr16 / 27Jul16	
Inv.439	1 - TWIN ENSUITE: INSTALL SHOWER STALL SEAT
Line5324	Note:
19Apr16 / 27Jul16	
Inv.439	1 - TWIN ENSUITE: INSTALL SHOWER STALL SHAMPOO SHELF
Line5326	Note:
19Apr16 / 27Jul16	
Inv.439	1 - TWIN ENSUITE: INSTALL SHOWER IN LIEU OF TUB- INCLUDES FRAMED GLASS SHOWER ENCLOSURE- INCLUDES POT LIGHT
Line5328	Note:
19Apr16 / 27Jul16	
Inv.439	1 - MASTER ENSUITE: INSTALL SHOWER STALL SHAMPOO SHELF
Line5330	Note:
19Apr16 / 27Jul16	
Inv.439	1 - OPTIONAL GROUND FLOOR PLAN
Line9329	Note:
19Apr16 / 27Jul16	

HVAC

Inv.439	1 - MASTER BEDROOM: INSTALL GAS LINE ROUGH - 2ND FLOOR- (3-STOREY MODELS) FOR FIREPLACE IN MASTER BEDROOM
Line5310	Note:
19Apr16 / 27Jul16	

INTERIOR TRIM AND DOORS

Inv.439	5 - MAIN FLOOR: INSTALL STANDARD DOOR EXTENDED HEIGHT 96" (PRICE PER DOOR) MAIN FLOOR 3 STOREY MODELS -FOR WALK-IN CLOSET, POWDER ROOM, BROOM CLOSET AND PANTRY
Line5332	Note:
19Apr16 / 27Jul16	
Inv.439	2 - MAIN FLOOR DEN: INSTALL STANDARD FRENCH DOORS- EXTENDED HEIGHT 96" (PRICE PER DOOR) MAIN FLOOR 3 STOREY MODELS - IN DEN
Line5333	Note:
19Apr16 / 27Jul16	

Brampton Encore - 91 - 1 - 41-5 Elev.B BRAHMS OPT - GFA1

MISC.

Inv.439	1 - BONUS PACKAGE: \$10,000.00 (INCLUDING TAXES) WORHT OF UPGRADES FROM GOLD PARK HOMES DÉCOR CENTRE IS BEING APPLIED TOWARD THE STRUCTURAL APPOINTMENT.
Line5335	Note:
19Apr16 / 27Jul16	
Inv.439	1 - Purchaser has attended a Structural appointment at the Decor Centre & has DECLINED any additional upgrades and accepts and acknowledges that there will be no further structural changes/additions/deletions to be made upon signing on April 19,2016
Line5336	Note:
19Apr16 / 27Jul16	
Inv.439	1 - Purchasers are aware & accepts that ANY changes made to upgrades after signing this Purchasers Extra Form are subject to a minimum administration fee of \$500. PLUS a 10% holdback fee.
Line5337	Note:
19Apr16 / 27Jul16	

PLUMBING

Inv.439	1 - KITCHEN: ROUGH-IN - WATERLINE FOR FRIDGE
Line5334	Note:
19Apr16 / 27Jul16	

WINDOWS - BASEMENT

Inv.439	3 - BASEMENT: INSTALL THREE (3) BASEMENT WINDOWS - UPGRADE EXISTING BASEMENT WINDOW TO 30 INCH X 24 INCH - MAY REQUIRE INSTALLATION OF WINDOW WELL
Line5331	Note:
19Apr16 / 27Jul16	

WINDOWS AND DOORS

Inv.439	1 - MAN DOOR GARAGE TO HOUSE - OPTIONAL - IF GRADE PERMITS
Line9326	Note: AS PER APS BONUS PACKAGE
19Apr16 / 27Jul16	



CONSTRUCTION SUMMARY

Brampton Encore - 101 - 1 - 41-6 Elev.A VERDI OPT - GFA1
CENTRAL VAC AND WIRING

Inv.500	1 - GROUND FLOOR-REC ROOM: INSTALL RG 6 ROUGH-IN IN REC ROOM. SEE SKETCH
Line6075	Note:
17May16 / 27Jul16	

ELECTRICAL

Inv.500	1 - TELEPHONE AND CABLE ROUGH-IN LOCATIONS
Line6074	Note:
17May16 / 27Jul16	
Inv.500	1 - LIVING ROOM: INSTALL ADDITIONAL STANDARD FIXTURE WITH SWITCH - IN ADDITION TO BUILDER'S STANDARD SWITCH CONTROLLED RECEPTICAL
Line6077	Note:
17May16 / 27Jul16	

EXTERIOR COLOURS

Inv.458	1 - EXTERIOR COLOUR PACKAGE 1
Line9384	Note:
26Apr16 / 27Jul16	

FORMING

Inv.458	1 - EXTERIOR: INSTALL SIDE DOOR- HOME TO EXTERIOR- AS PER PLAN AND GRADE PERMITTING
Line5702	Note:
26Apr16 / 27Jul16	

FRAMING

Inv.500	1 - GARAGE: INSTALL MANDOOR - GARAGE TO HOUSE- AS PER PLAN AND GRADE PERMITING
Line6078	Note:
17May16 / 27Jul16	

MISC.

Inv.458	1 - BONUS PACKAGE: \$5723.45 (INCLUDING TAXES) WORTH OF UPGRADES FROM GOLD PARK HOMES DÉCOR CENTRE IS BEING APPLIED TOWARD THE STRUCTURAL APPOINTMENT. PURCHASER HAS A REMAINING AMOUNT OF \$4276.55 (INCLUDING TAXES) TO BE USED TOWARD THE COLOUR APPOINTMENT.
Line5483	Note:
26Apr16 / 27Jul16	
Inv.458	1 - Purchasers are aware & accepts that ANY changes made to upgrades after signing this Purchasers Extra Form are subject to a minimum administration fee of \$500. PLUS a 10% holdback fee
Line5484	Note:
26Apr16 / 27Jul16	
Inv.500	1 - BONUS PACKAGE: \$4276.55 (INCLUDING TAXES) WORTH OF UPGRADES FROM GOLD PARK HOMES DÉCOR CENTRE IS BEING APPLIED TOWARD THE STRUCTURAL APPOINTMENT.
Line6081	Note:
17May16 / 27Jul16	
Inv.500	1 - Purchaser has attended a Structural appointment at the Decor Centre & has DECLINED any additional upgrades and accepts and acknowledges that there will be no further structural changes/additions/deletions to be made upon signing on May 17, 2016
Line6082	Note:
17May16 / 27Jul16	



CONSTRUCTION SUMMARY

Brampton Encore - 101 - 1 - 41-6 Elev.A VERDI OPT - GFA1

Inv.500	1 - Purchasers are aware & accepts that ANY changes made to upgrades after signing this Purchasers Extra Form are subject to a minimum administration fee of \$500. PLUS a 10% holdback fee.
Line6083	Note:
17May16 / 27Jul16	

PLUMBING

Inv.458	1 - BASEMENT: INSTALL ROUGH-IN - 3PC BASEMENT ROUGH-IN, AS PER PLAN
Line5480	Note:
26Apr16 / 27Jul16	
Inv.500	1 - KITCHEN: INSTALL ROUGH-IN - WATERLINE FOR FRIDGE
Line6079	Note:
17May16 / 27Jul16	
Inv.500	1 - BASEMENT: INSTALL ROUGH-IN LAUNDRY IN BASEMENT WITHOUT TUB
Line6080	Note:
17May16 / 27Jul16	




WINDOWS - BASEMENT

Inv.458	2 - BASEMENT: INSTALL TWO (2) BASEMENT WINDOWS - UPGRADE EXISTING BASEMENT WINDOW TO 30 INCH X 24 INCH - MAY REQUIRE INSTALLATION OF WINDOW WELL. SEE SKETCH
Line5481	Note:
26Apr16 / 27Jul16	
Inv.458	1 - BASEMENT: INSTALL ONE (1) BASEMENT WINDOWS - UPGRADE EXISTING BASEMENT WINDOW TO 53 INCH X 16 INCH. TO BE APPROVED BY CONSTRUCTION. SEE SKETCH
Line5482	Note:
26Apr16 / 27Jul16	

Telephone — (T)
Cable — (C)

The
Brahms
41' SERIES



Elevation A • 4,038 sq.ft. | Elevation B • 4,038 sq.ft.

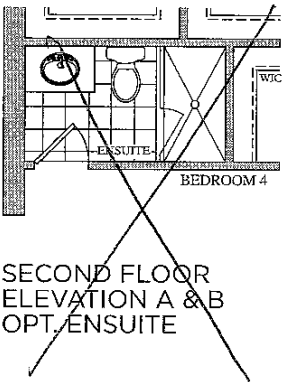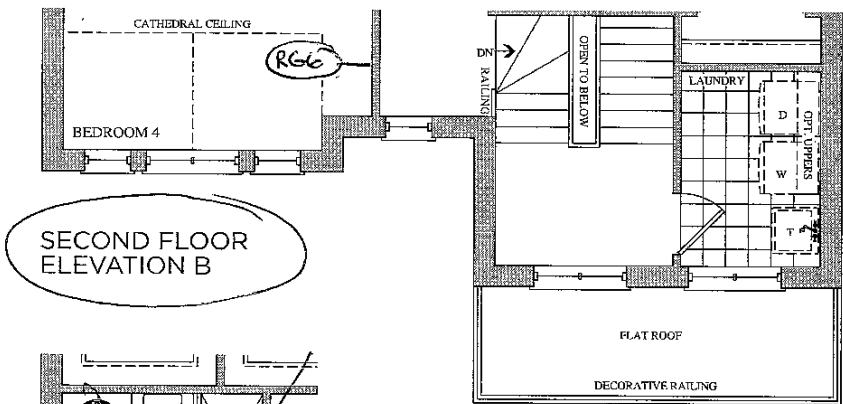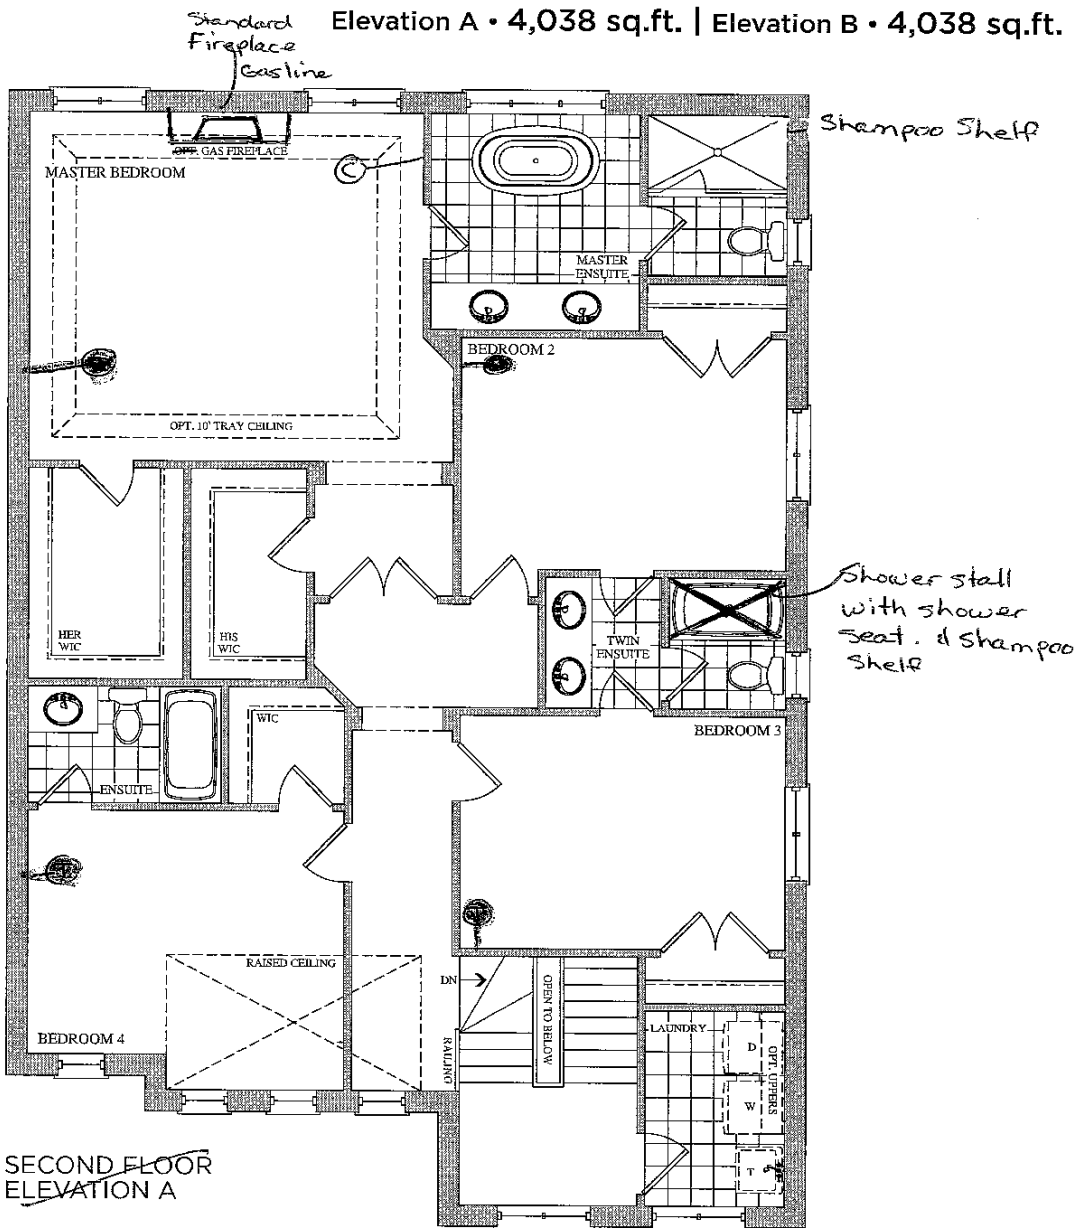


Lot 91
April 19, 2016
KS SS

**The
Brahms**
41' SERIES

Elevation A • 4,038 sq.ft. | Elevation B • 4,038 sq.ft.

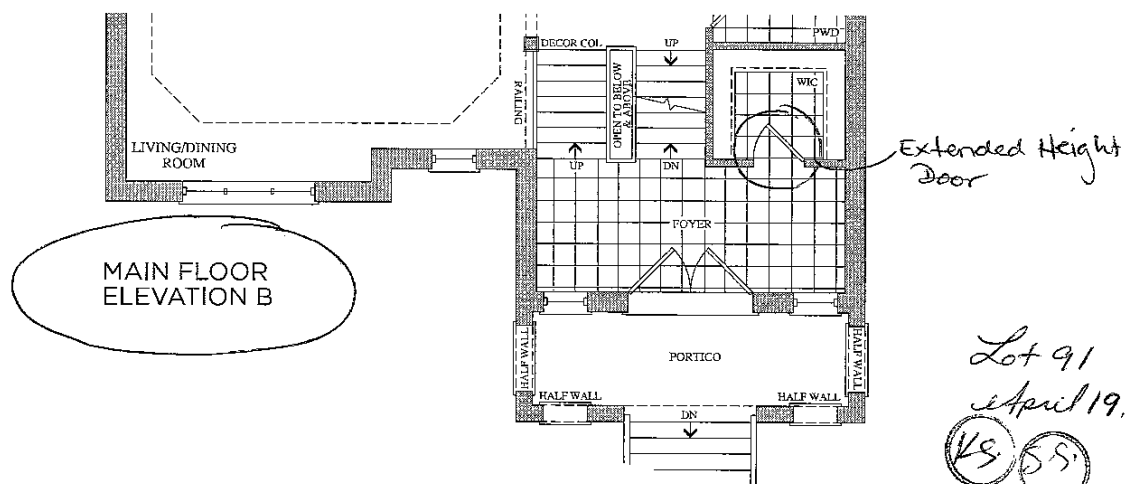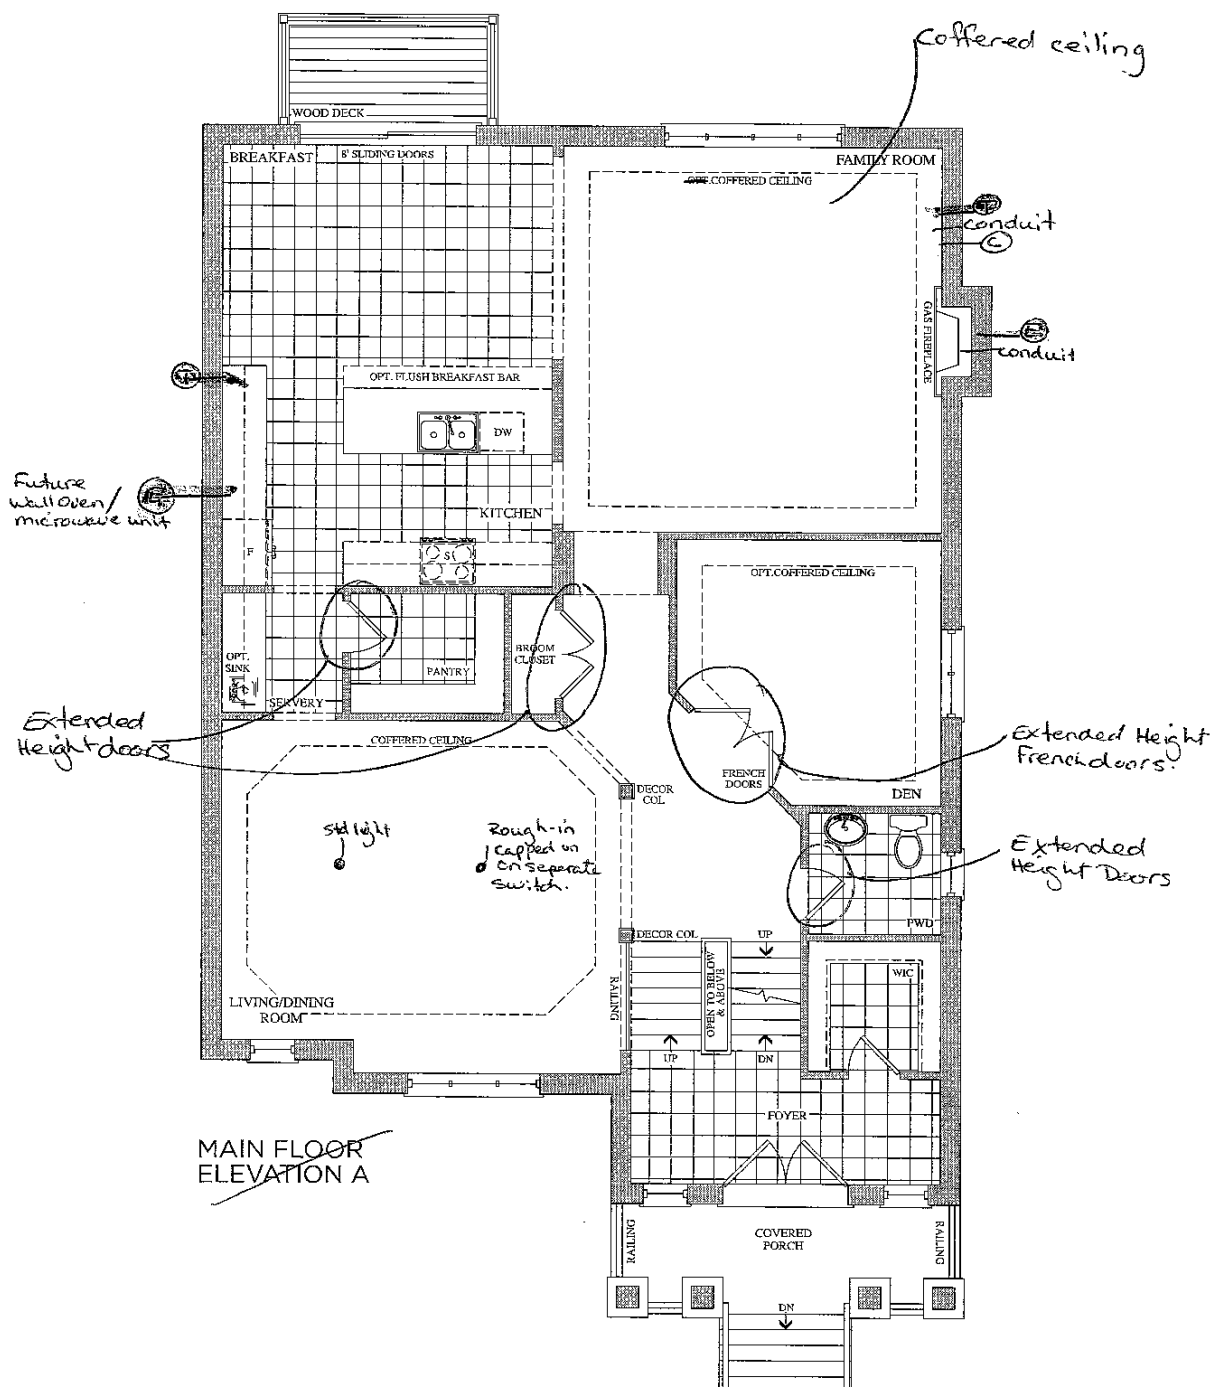


Lot 91
April 19, 2016



Telephone — (T)
Cable — (C)



The
Brahms
41' SERIES

Elevation A • 4,038 sq.ft. | Elevation B • 4,038 sq.ft.

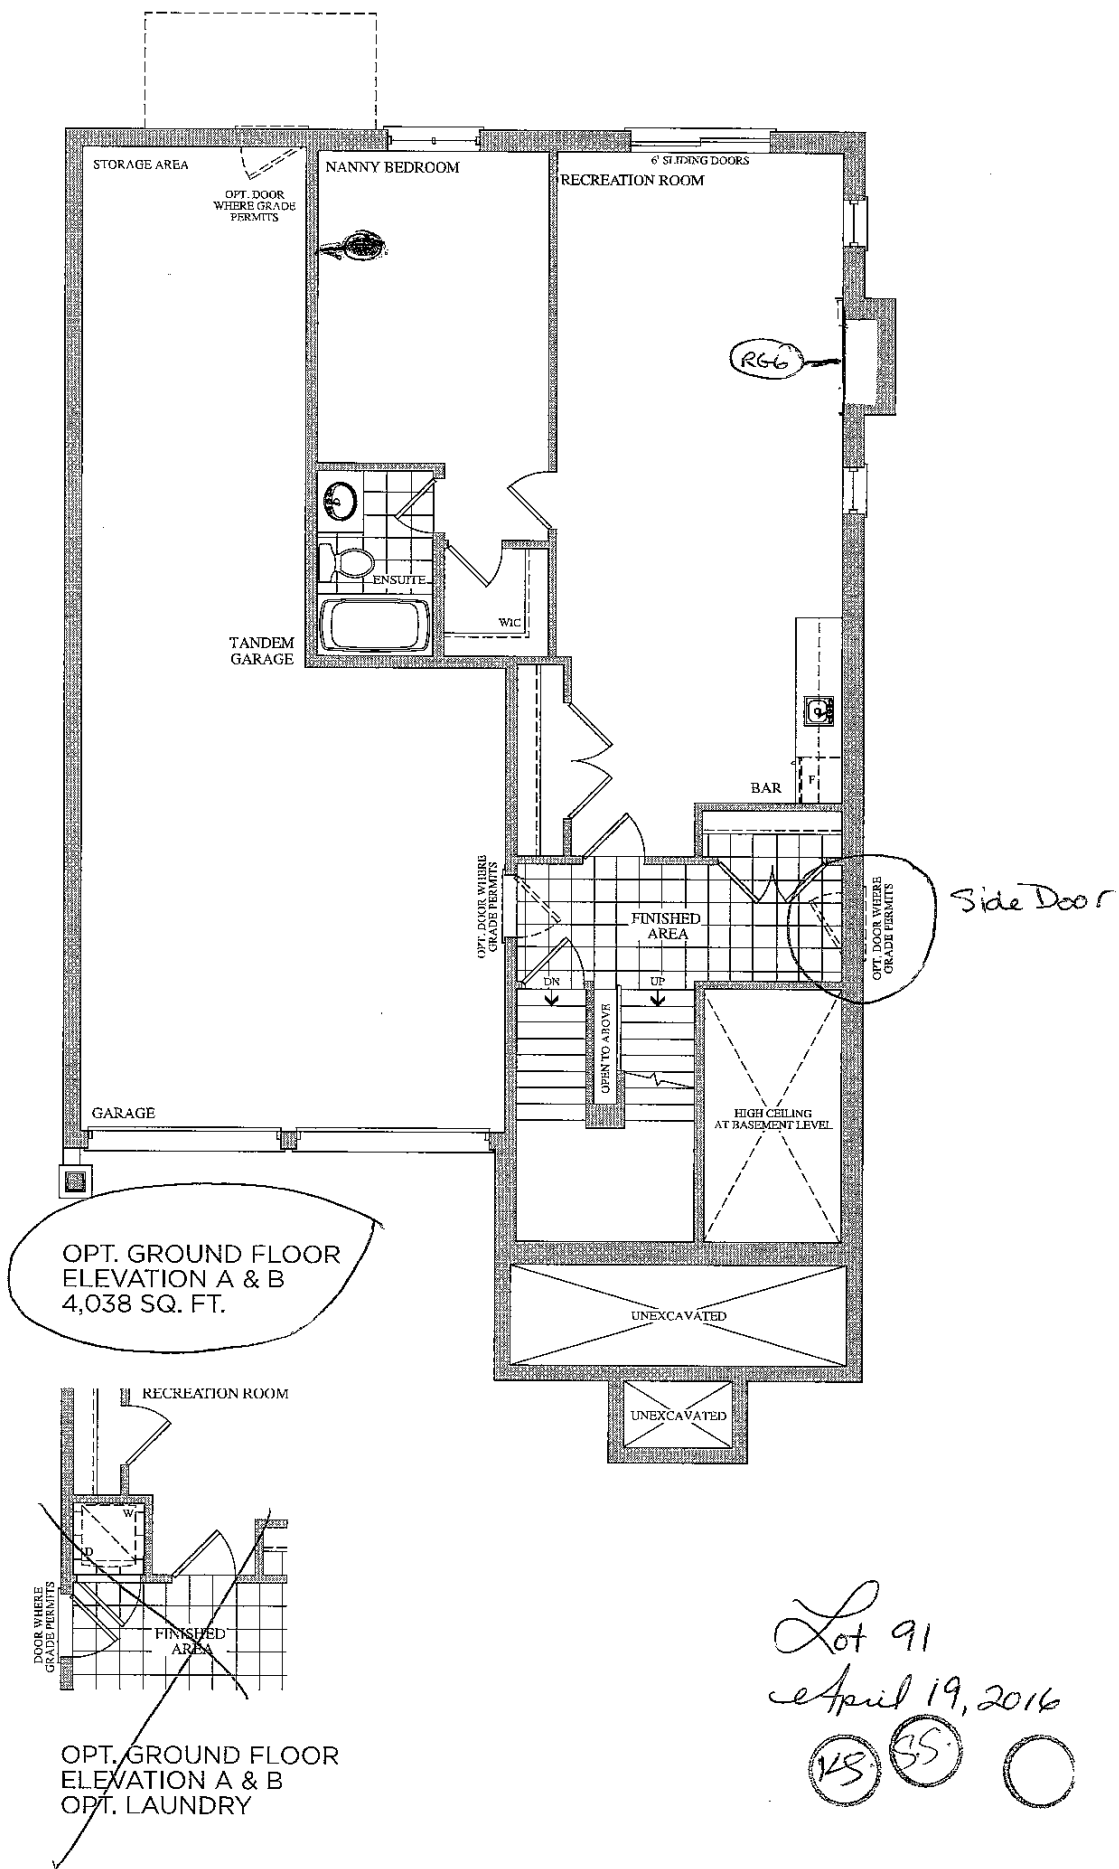

**The
Brahms**
41' SERIES

Elevation A • 4,038 sq.ft. | Elevation B • 4,038 sq.ft.

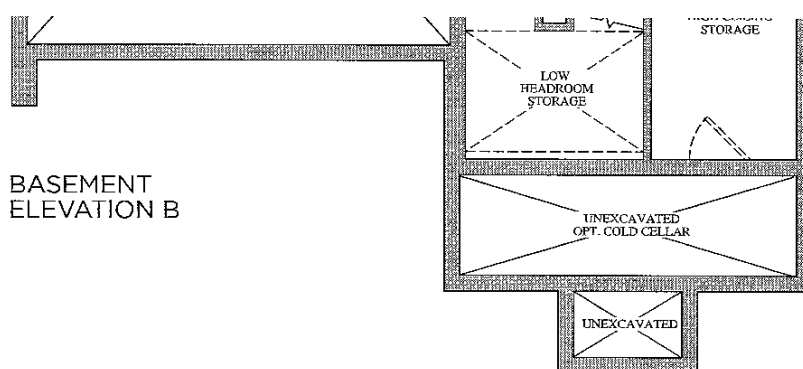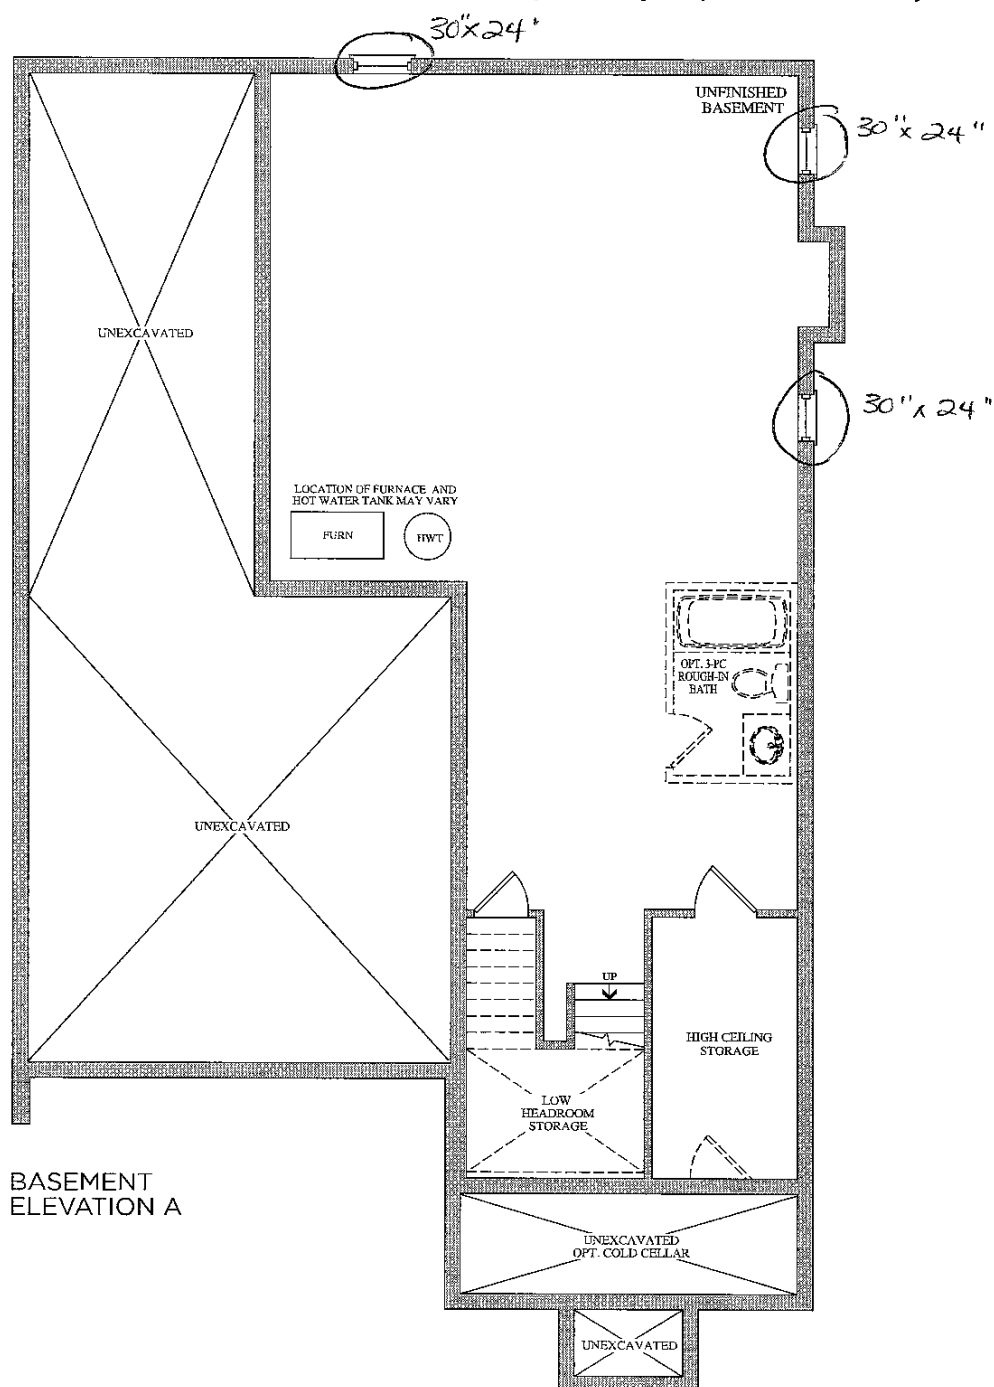

Lot 91
April 19, 2016
125 55 0



Stacey Carlete
Project Coordinator



Claude Azzopardi
Contracts Manager



Nancy Mc
Corporate C

91
Lot #



Model	38.1 The Bizet		
Elevation	Circle One	A	2189.6 Square Feet
		B	2186.7 Square Feet
Optional Layouts	Circle All that Apply		

Model	38.2 The Ravel		
Elevation	Circle One	A	2271.5 Square Feet
		B	2273.7 Square Feet
Optional Layouts	Circle All that Apply		

Model	38.3 The Haydn		
Elevation	Circle One	A	2394.5 Square Feet
		B	2388.3 Square Feet
Optional Layouts	Circle All that Apply		

Model	38.4 The Vivaldi		
Elevation	Circle One	A	2459.1 Square Feet
		B	2459.1 Square Feet
Optional Layouts	Circle All that Apply		

Model	38.5 The Handel		
Elevation	Circle One	A	2549.2 Square Feet
		B	2554.7 Square Feet
Optional Layouts	Circle All that Apply		

Model	38.9 The Puccini		
Elevation	Circle One	A	3628.0 Square Feet
		B	3634.7 Square Feet
Optional Layouts	Circle All that Apply	GFA1	GROUND FLOOR Optional Alternative Layout

Model	38.6 The Scarlatti		
Elevation	Circle One	A	3521.1 Square Feet
		B	3508.1 Square Feet
Optional Layouts	Circle All that Apply	GFA1	GROUND FLOOR Optional Alternative Layout

Model	38.7 The Schubert		
Elevation	Circle One	A	3593.8 Square Feet
		B	3610.5 Square Feet
Optional Layouts	Circle All that Apply	GFA1	GROUND FLOOR Optional Alternative Layout
		SFA4	SECOND FLOOR Additional Bedroom

Model	38.8 The Corelli		
Elevation	Circle One	A	3801.5 Square Feet
		B	3801.5 Square Feet
Optional Layouts	Circle All that Apply	GFA1	GROUND FLOOR Optional Alternative Layout
		SFA4	SECOND FLOOR Additional Bedroom w/ Ensuite

Model	41.1 The Strauss		
Elevation	Circle One	A	2554.2 Square Feet
		B	2571.2 Square Feet
Optional Layouts	Circle All that Apply	SFA1	SECOND FLOOR Shower in Lieu of Tub B2

Model	41.2 The Mozart		
Elevation	Circle One	A	2725.9 Square Feet
		B	2711.1 Square Feet
Optional Layouts	Circle All that Apply	SFA1	SECOND FLOOR Shower in Lieu of Tub B2

Model	41.3 The Chopin		
Elevation	Circle One	A	2800.0 Square Feet
		B	2810.5 Square Feet
Optional Layouts	Circle All that Apply		

Model	41.4 The Bach		
Elevation	Circle One	A	2894.4 Square Feet
		B	2894.5 Square Feet
Optional Layouts	Circle All that Apply		

Model	41.5 The Brahms		
Elevation	Circle One	A	3948.1 Square Feet
		B	3949.1 Square Feet
Optional Layouts	Circle All that Apply	GFA1	GROUND FLOOR Optional Alternative Layout
		SFA2	SECOND FLOOR Shower in Lieu of Tub B4
		SFA3	SECOND FLOOR Optional Laundry Layout

Model	41.6 The Verdi		
Elevation	Circle One	A	3862.5 Square Feet
		B	3866.4 Square Feet
Optional Layouts	Circle All that Apply	GFA1	GROUND FLOOR Optional Alternative Layout
		SFA3	SECOND FLOOR Optional Laundry Layout

April 19, 2016
KS SS