

ELECTRICAL

Inv.603	1 - TELEPHONE AND CABLE ROUGH-IN LOCATIONS
Line7412	Note:
23Jun16 / 28Jul16	
Inv.603	1 - BASEMENT: INSTALL 200 AMP ELECTRICAL SERVICE
Line7430	Note:
23Jun16 / 28Jul16	

EXTERIOR COLOURS

Inv.709	1 - EXTERIOR COLOUR PACKAGE 3 ✓
Line9484	Note:
28Jul16 / 28Jul16	

FORMING

Inv.603	1 - EXTERIOR: INSTALL SIDE DOOR- HOME TO EXTERIOR- AS PER PLAN AND GRADE PERMITTING
Line7414	Note:
23Jun16 / 28Jul16	

FRAMING

Inv.603	1 - GARAGE: INSTALL MANDOOR - GARAGE TO HOUSE- AS PER PLAN AND GRADE PERMITTING
Line7413	Note: GIVEN IN AGREEMENT OF PURCHASE AND SALE
23Jun16 / 28Jul16	

GLASS AND MIRROR

Inv.603	1 - MASTER ENSUITE: CONVERT FRAMED SHOWER TO 10MM FRAMLESS SHOWER ENCLOSURE WITH DOOR. IN MASTER ENSUITE
Line7415	Note:
23Jun16 / 28Jul16	

INTERIOR TRIM AND DOORS

Inv.603	4 - MAIN FLOOR: INSTALL FOUR (X4) STANDARD DOOR EXTENDED HEIGHT 96" (PRICE PER DOOR)- MAIN FLOOR 2 STOREY MODELS. FOR CLOSET, POWDER ROOM AND BASEMENT
Line7424	Note:
23Jun16 / 28Jul16	

MISC.

Inv.603	1 - BONUS PACKAGE: \$13,836.85 (INCLUDING TAXES) WORTH OF UPGRADES FROM GOLD PARK HOMES DÉCOR CENTRE IS BEING APPLIED TOWARD THE STRUCTURAL APPOINTMENT. PURCHASER HAS A REMAINING AMOUNT OF \$1163.15 (INCLUDING TAXES) TO BE USED TOWARD THE COLOUR APPOINTMENT
Line7427	Note:
23Jun16 / 28Jul16	
Inv.603	1 - Purchaser has attended a Structural appointment at the Decor Centre & has DECLINED any additional upgrades and accepts and acknowledges that there will be no further structural changes/additions/deletions to be made upon signing on June 23, 2016
Line7428	Note:
23Jun16 / 28Jul16	



CONSTRUCTION SUMMARY

Brampton Encore - 107 - 1 - 38-4 Elev.A VIVALDI

Inv.603	1 - Purchasers are aware & accepts that ANY changes made to upgrades after signing this Purchasers Extra Form are subject to a minimum administration fee of \$500. PLUS a 10% holdback fee
Line7429	Note:
23Jun16 / 28Jul16	

PLUMBING



Inv.603	1 - BASEMENT: INSTALL ROUGH-IN - 3PC BASEMENT ROUGH-IN, AS PER PLAN
Line7425	Note:
23Jun16 / 28Jul16	
Inv.603	1 - BASEMENT: INSTALL ROUGH-IN LAUNDRY IN BASEMENT, INCLUDING TUB. SEE SKETCH
Line7426	Note:
23Jun16 / 28Jul16	

WINDOWS - BASEMENT

Inv.603	3 - BASEMENT: INSTALL THREE (X3) BASEMENT WINDOWS - UPGRADE EXISTING BASEMENT WINDOW TO 30 INCH X 24 INCH - MAY REQUIRE INSTALLATION OF WINDOW WELL
Line7419	Note:
23Jun16 / 28Jul16	

Elevation A • 2,518 sq.ft. | Elevation B • 2,518 sq.ft.


① — TELEPHONE
② — CABLE

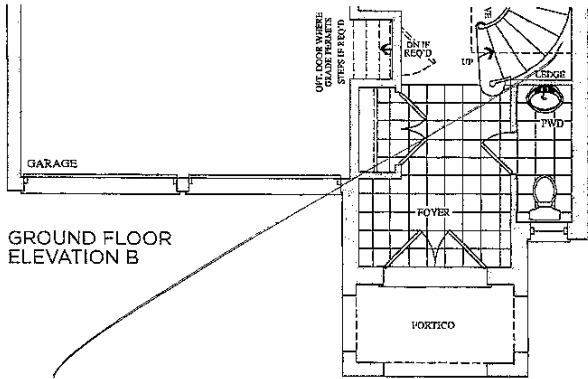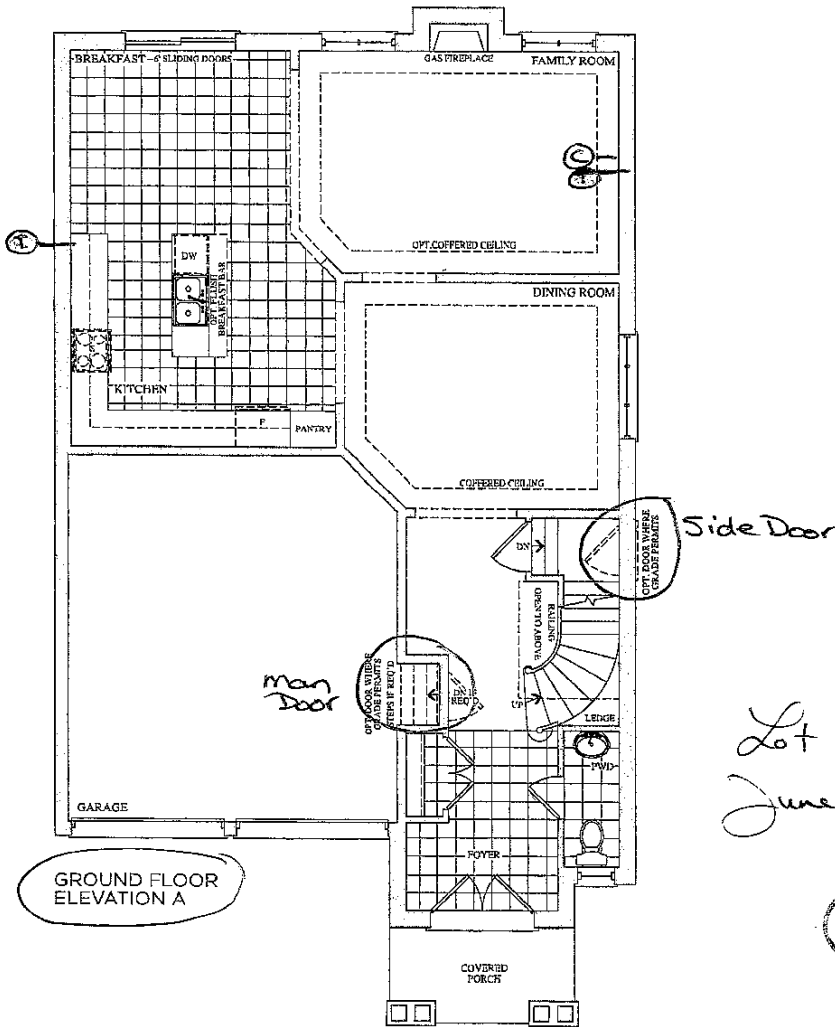

Prices, figures, illustrations, sizes, features and finishes are subject to change without notice. L&O.E. Areas and dimensions are approximate and actual usable floor space may vary from the stated area. Layout may be reverse of the unit purchased. E. & O.E.

The
Vivaldi
38' SERIES


Elevation A • 2,518 sq.ft. | Elevation B • 2,518 sq.ft.

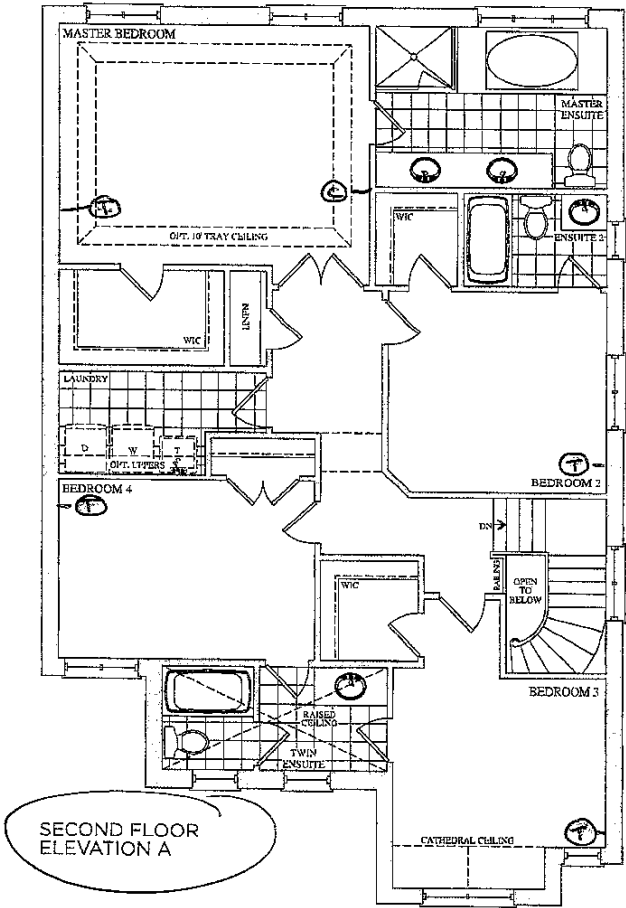

- Ⓣ — TELEPHONE
- Ⓢ — CABLE

SECOND FLOOR
ELEVATION A

Lot 107
June 23, 16

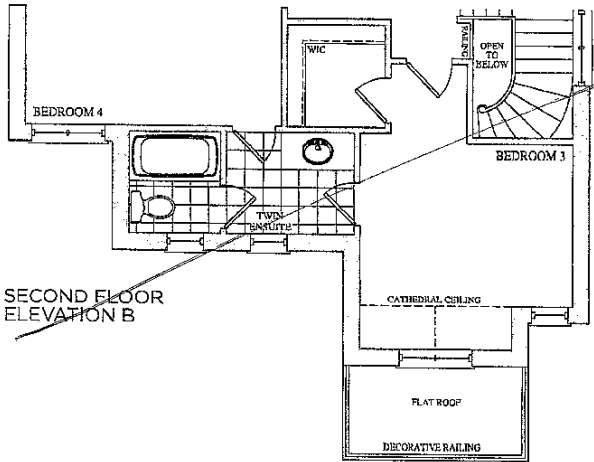

SECOND FLOOR
ELEVATION B


Prices, figures, illustrations, sizes, features and finishes are subject to change without notice. E.O.E. Areas and dimensions are approximate and actual usable floor space may vary from the stated area. Layout may be reverse of the unit purchased. E. & O.E.

encore
BRAMPTON

The
Vivaldi
38' SERIES

Elevation A • 2,518 sq.ft. | Elevation B • 2,518 sq.ft.

Basement Windows
3x 30" x 24"

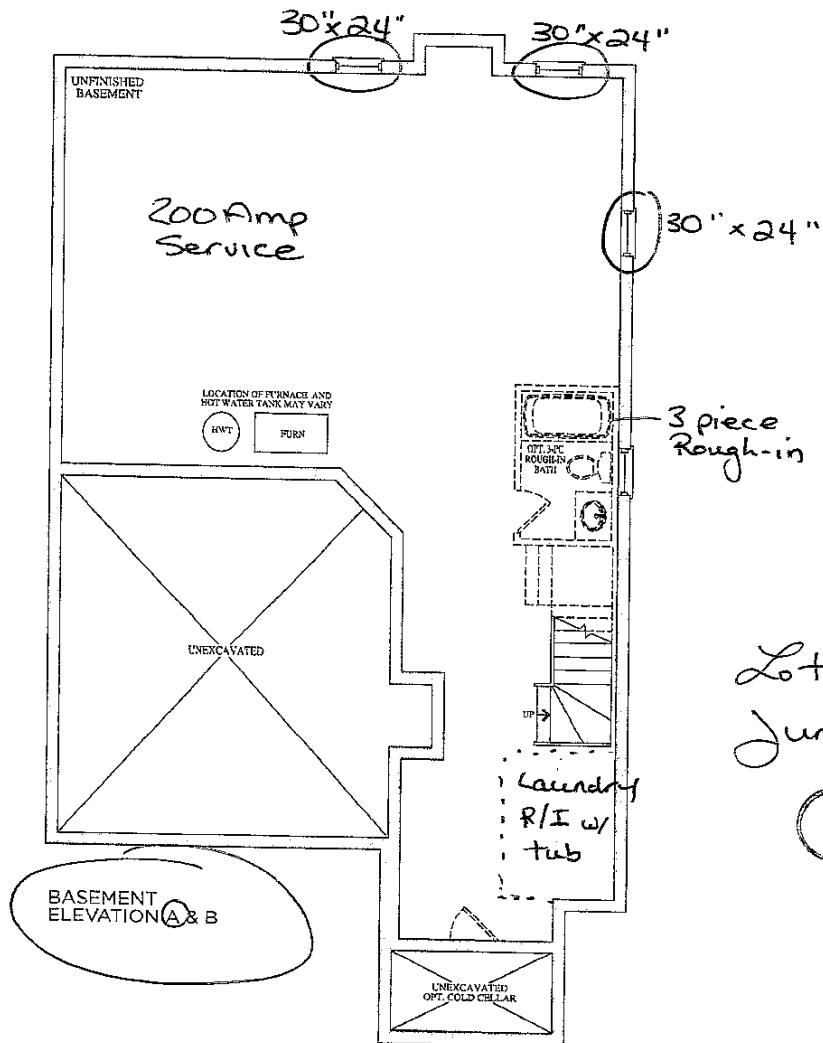

Lot 107
June 23, 16



Prices, figures, illustrations, sizes, features and finishes are subject to change without notice. E.&O.E. Areas and dimensions are approximate and actual usable floor space may vary from the stated area. Layout may be reverse of the unit purchased. C. & O.E.

GOLDPARK
HOMES



Stacey Carlete
Project Coordinator



Claude Azzopardi
Contracts Manager



Nancy Mc
Corporate

107
Lot #



38.1 The Bizet			
Elevation	Circle One	A	2189.6 Square Feet
		B	2186.7 Square Feet
Optional Layouts	Circle All that Apply		

38.2 The Ravel			
Elevation	Circle One	A	2271.5 Square Feet
		B	2273.7 Square Feet
Optional Layouts	Circle All that Apply		

38.3 The Haydn			
Elevation	Circle One	A	2394.5 Square Feet
		B	2388.3 Square Feet
Optional Layouts	Circle All that Apply		

38.4 The Vivaldi			
Elevation	Circle One	A	2459.1 Square Feet
		B	2459.1 Square Feet
Optional Layouts	Circle All that Apply		

38.5 The Handel			
Elevation	Circle One	A	2549.2 Square Feet
		B	2554.7 Square Feet
Optional Layouts	Circle All that Apply		

38.9 The Puccini			
Elevation	Circle One	A	3628.0 Square Feet
		B	3634.7 Square Feet
Optional Layouts	Circle All that Apply	GFA1	GROUND FLOOR Optional Alternative Layout

38.6 The Scarlatti			
Elevation	Circle One	A	3521.1 Square Feet
		B	3508.1 Square Feet
Optional Layouts	Circle All that Apply	GFA1	GROUND FLOOR Optional Alternative Layout

38.7 The Schubert			
Elevation	Circle One	A	3593.8 Square Feet
		B	3610.5 Square Feet
Optional Layouts	Circle All that Apply	GFA1	GROUND FLOOR Optional Alternative Layout
		SFA4	SECOND FLOOR Additional Bedroom

38.8 The Corelli			
Elevation	Circle One	A	3801.5 Square Feet
		B	3801.5 Square Feet
Optional Layouts	Circle All that Apply	GFA1	GROUND FLOOR Optional Alternative Layout
		SFA4	SECOND FLOOR Additional Bedroom w/ Ensuite

41.1 The Strauss			
Elevation	Circle One	A	2554.2 Square Feet
		B	2571.2 Square Feet
Optional Layouts	Circle All that Apply	SFA1	SECOND FLOOR Shower in Lieu of Tub B2

41.2 The Mozart			
Elevation	Circle One	A	2725.9 Square Feet
		B	2711.1 Square Feet
Optional Layouts	Circle All that Apply	SFA1	SECOND FLOOR Shower in Lieu of Tub B2

41.3 The Chopin			
Elevation	Circle One	A	2800.0 Square Feet
		B	2810.5 Square Feet
Optional Layouts	Circle All that Apply		

41.4 The Bach			
Elevation	Circle One	A	2894.4 Square Feet
		B	2894.5 Square Feet
Optional Layouts	Circle All that Apply		

41.5 The Brahms			
Elevation	Circle One	A	3948.1 Square Feet
		B	3949.1 Square Feet
Optional Layouts	Circle All that Apply	GFA1	GROUND FLOOR Optional Alternative Layout
		SFA2	SECOND FLOOR Shower in Lieu of Tub B4
		SFA3	SECOND FLOOR Optional Laundry Layout

41.6 The Verdi			
Elevation	Circle One	A	3862.5 Square Feet
		B	3866.4 Square Feet
Optional Layouts	Circle All that Apply	GFA1	GROUND FLOOR Optional Alternative Layout
		SFA3	SECOND FLOOR Optional Laundry Layout

June 23, 16

