

CONSTRUCTION SUMMARY

109 - 1 - 38-6 Elev. A SCARLATTI OPT- GFA1

CENTRAL VAC AND WIRING

Inv.479	1 - GROUND FLOOR: INSTALL RG 6 ROUGH-IN ON GROUND FLOOR
Line5765	Note:
3May16 / 20May16	
Inv.479	1 - GROUND FLOOR: INSTALL ROUGH-IN WIRING FOR ONE PAIR OF SPEAKERS - IN GROUND FLOOR. SEE SKETCH
Line5766	Note:
3May16 / 20May16	

ELECTRICAL

Inv.479	1 - TELEPHONE AND CABLE ROUGH-IN LOCATIONS
Line5764	Note:
3May16 / 20May16	
Inv.479	1 - LIVING ROOM: INSTALL ADDITIONAL STANDARD FIXTURE ON SAME SWITCH AS THE SWITCH CONTROLLED RECEPTICAL IN LIVING ROOM. SEE SKETCH
Line5767	Note:
3May16 / 20May16	
Inv.479	1 - KITCHEN: INSTALL KITCHEN CABINET STRIP VALANCE LIGHTS (UNDER CABINETS) - ROUGH - IN - DOES NOT INCLUDE (AND REQUIRES) KITCHEN UPGRADE PRICING
Line5768	Note:
3May16 / 20May16	
Inv.479	1 - KITCHEN: INSTALL 110V WALL RECEPTACLE ON DEDICATED CIRCUIT - FOR MICROWAVE - MICROWAVE NOT INCLUDED IN KITCHEN. SEE SKETCH
Line5775	Note:
3May16 / 20May16	

EXTERIOR COLOURS

Inv.479	1 - EXTERIOR COLOUR PACKAGE 9
Line6149	Note:
3May16 / 20May16	

FORMING

Inv.479	1 - EXTERIOR: INSTALL SIDE DOOR- HOME TO EXTERIOR- AS PER PLAN AND GRADE PERMITTING
Line5769	Note:
3May16 / 20May16	

FRAMING

Inv.479	1 - MAN DOOR GARAGE TO HOUSE - OPTIONAL - IF GRADE PERMITS
Line6151	Note: AS PER APS BONUS PKG
3May16 / 20May16	

HVAC

Inv.479	1 - KITCHEN: INSTALL GAS LINE ROUGH-IN - MAIN FLOOR - (3 STOREY MODELS) FOR STOVE
Line5770	Note:
3May16 / 20May16	

MISC.

CONSTRUCTION SUMMARY

109 - 1 - 38-6 Elev.A SCARLATTI OPT- GFA1

Inv.479	1 - BONUS PACKAGE: \$6887.35 (INCLUDING TAXES) WORTH OF UPGRADES FROM GOLD PARK HOMES DÉCOR CENTRE IS BEING APPLIED TOWARD THE STRUCTURAL APPOINTMENT. PURCHASER HAS A REMAINING AMOUNT OF \$3112.65 (INCLUDING TAXES) TO BE USED TOWARD THE COLOUR APPOINTMENT
Line5776	Note:
3May16 / 20May16	
Inv.479	1 - Purchasers are aware & accepts that ANY changes made to upgrades after signing this Purchasers Extra Form are subject to a minimum administration fee of \$500. PLUS a 10% holdback fee
Line5778	Note:
3May16 / 20May16	
Inv.479	1 - Purchaser has attended a Structural appointment at the Decor Centre & has DECLINED any additional upgrades and accepts and acknowledges that there will be no further structural changes/additions/deletions to be made upon signing on May 3, 2016
Line5777	Note:
3May16 / 20May16	

PLUMBING

Inv.479	1 - KITCHEN: INSTALL ROUGH-IN - WATERLINE FOR FRIDGE
Line5773	Note:
3May16 / 20May16	
Inv.479	1 - BASEMENT: INSTALL ROUGH-IN - 3PC BASEMENT ROUGH-IN, AS PER PLAN
Line5774	Note:
3May16 / 20May16	



WINDOWS AND DOORS

Inv.479	1 - MAN DOOR GARAGE TO HOUSE - OPTIONAL - IF GRADE PERMITS
Line6150	Note: AS PER APS BONUS PKG
3May16 / 20May16	

The Scarlatti

38' SERIES

Elevation A • 3,591 sq.ft. | Elevation B • 3,578 sq.ft.

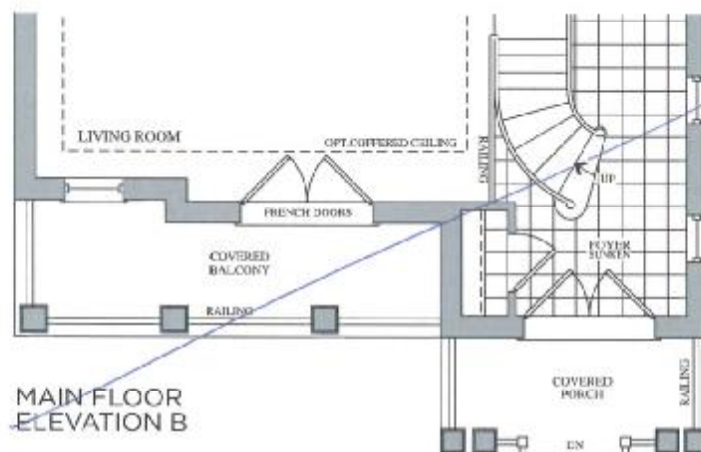
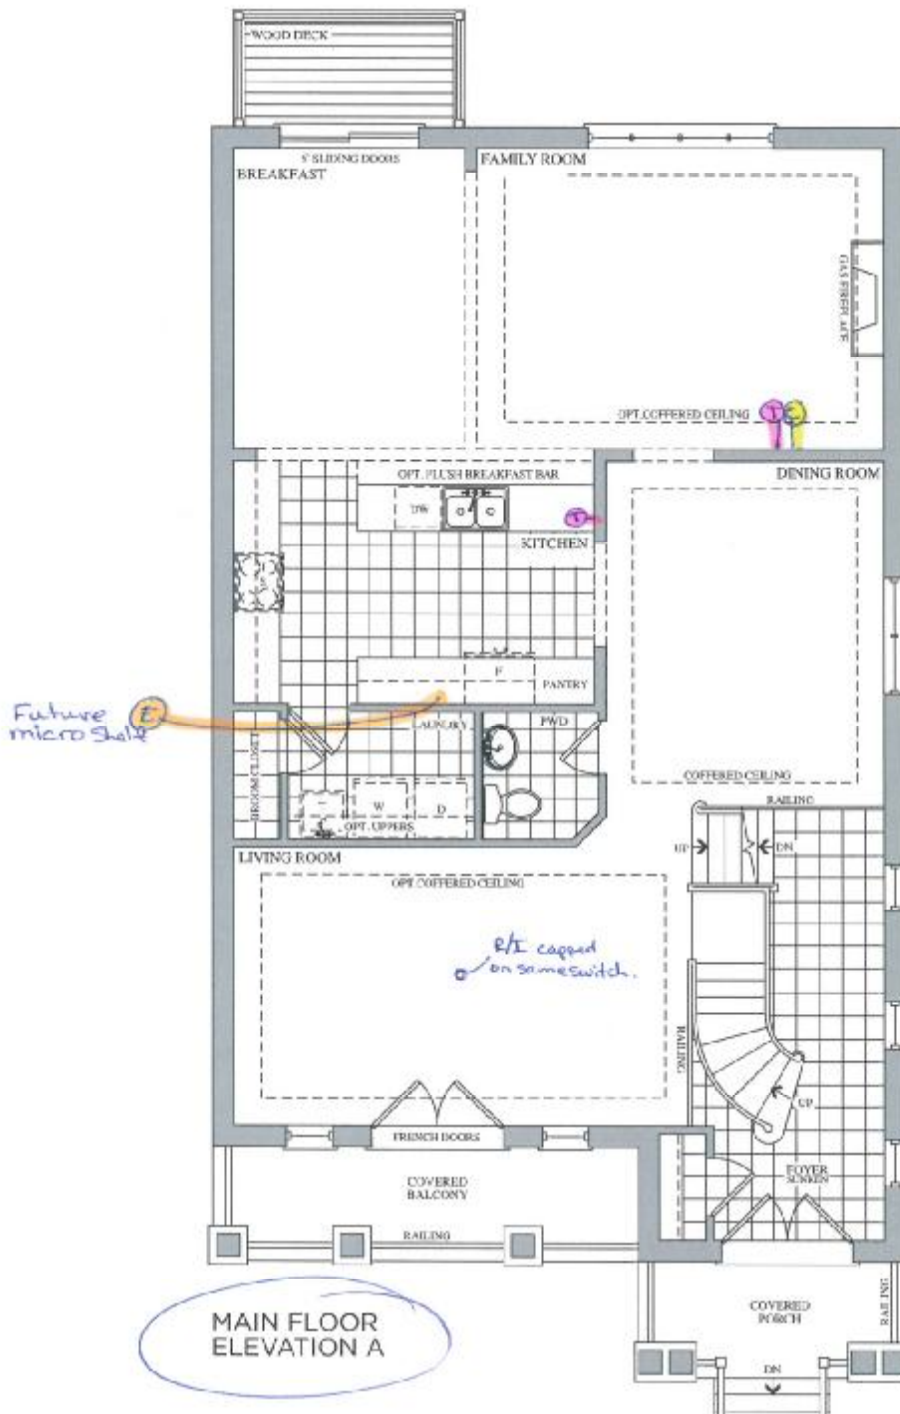


Lot 109
May 3, 18

OK

The Scarlatti 38' SERIES

Elevation A • 3,591 sq.ft. | Elevation B • 3,578 sq.ft.

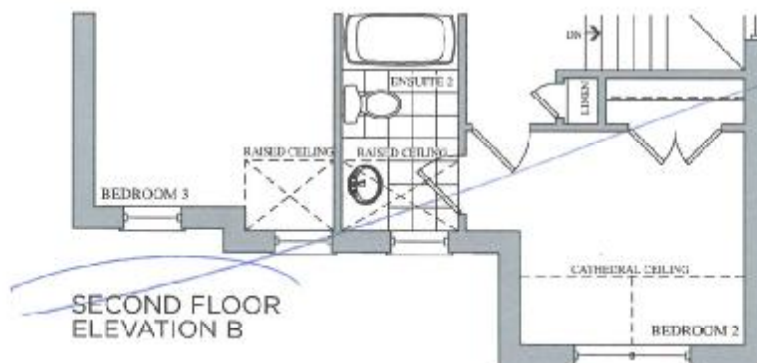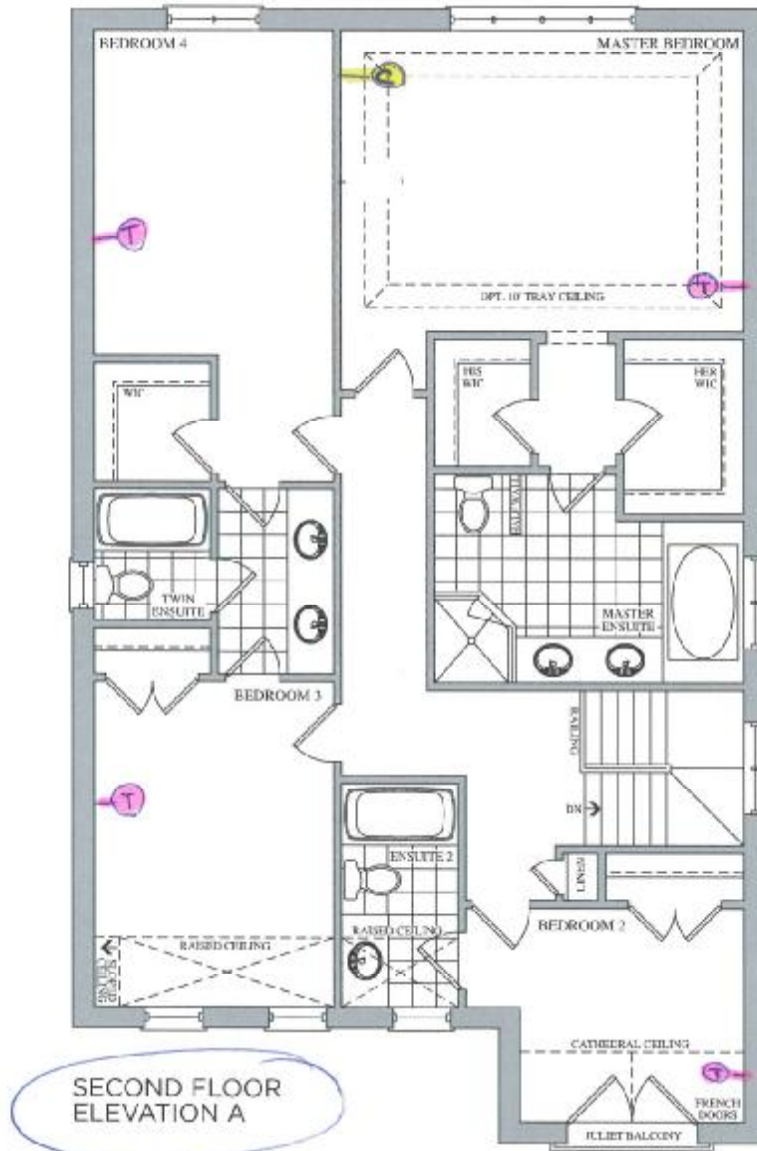


Lot 109
May 3, 16

DB


**The
Scarlatti**
38' SERIES

Elevation A • 3,591 sq.ft. | Elevation B • 3,578 sq.ft.

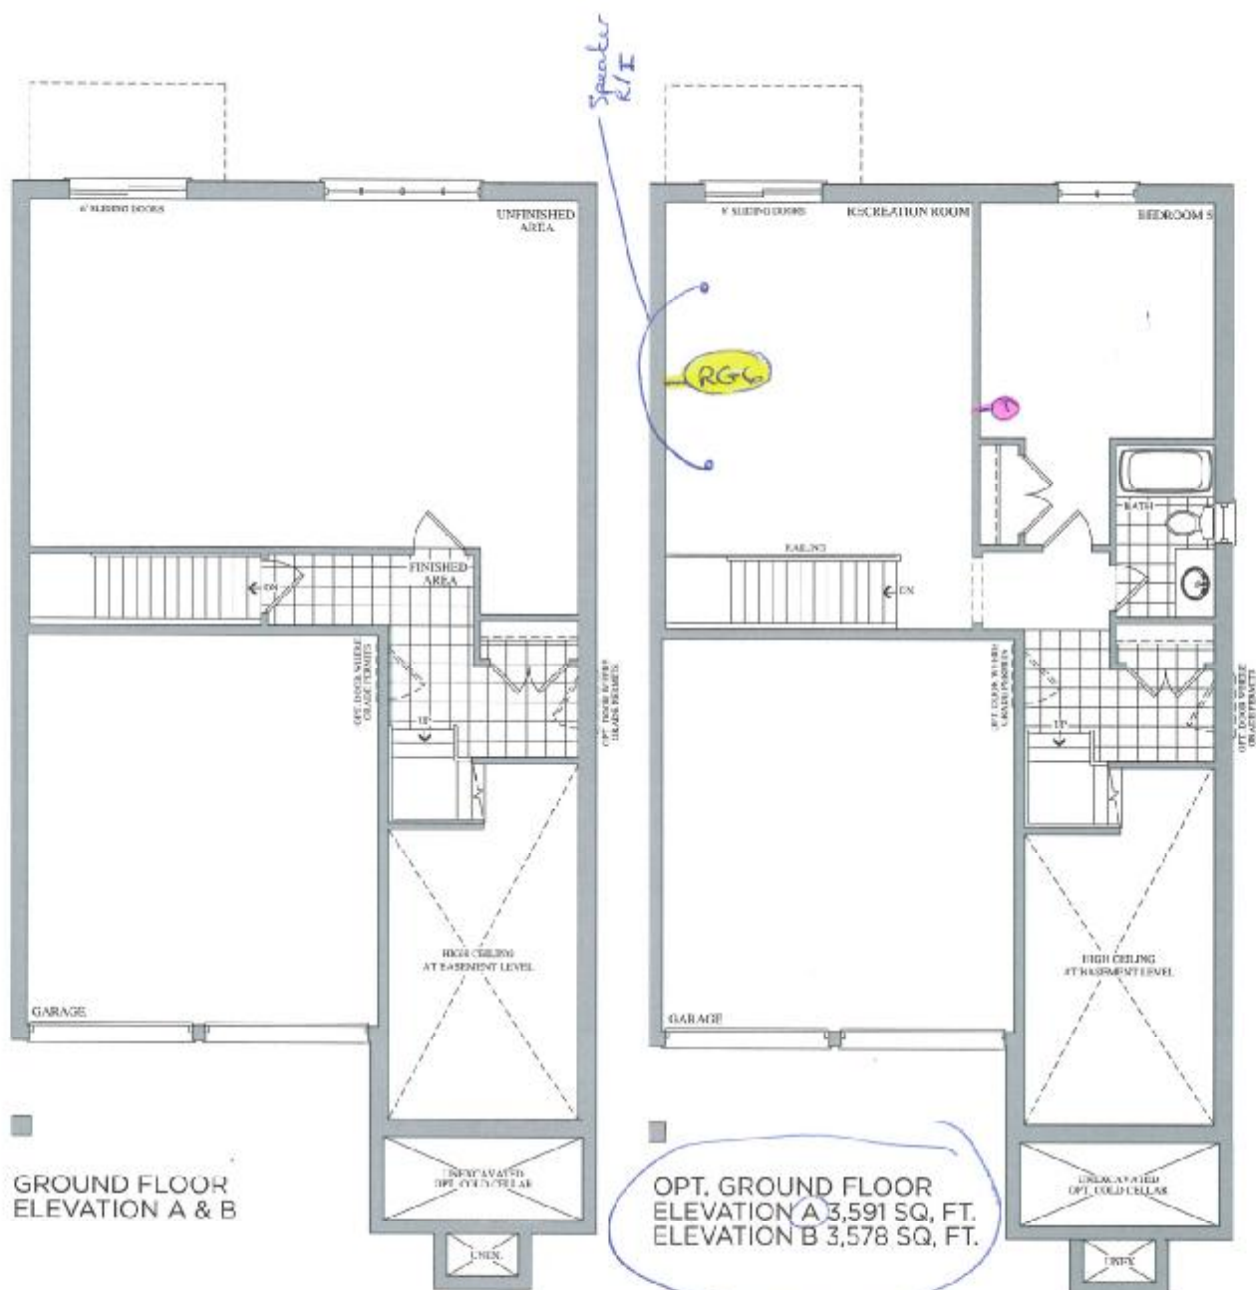

Lot 109
May 3, 16



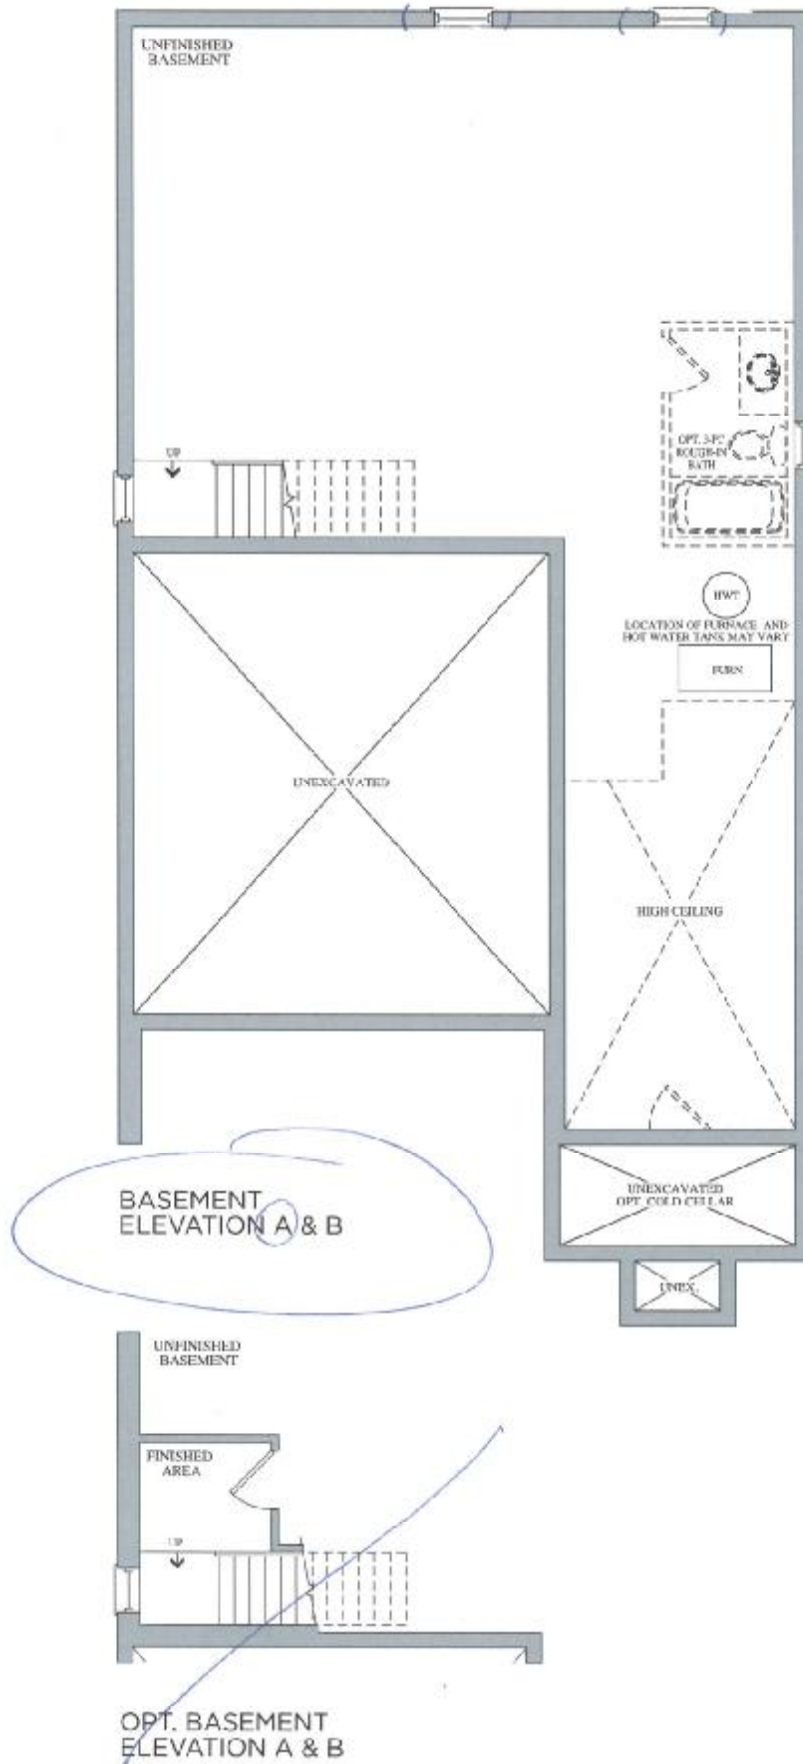

Lot 109
May 3, 16

OB

OB



Stacey Carlete
Project Coordinator



Claude Azzopardi
Contracts Manager



Nancy Mc
Corporate

109
Lot #



Model	38.1 The Bizet		
Elevation	Circle One	A	2189.6 Square Feet
		B	2185.7 Square Feet
Optional Layouts	Circle All that Apply		

Model	38.2 The Ravel		
Elevation	Circle One	A	2271.5 Square Feet
		B	2273.7 Square Feet
Optional Layouts	Circle All that Apply		

Model	38.3 The Haydn		
Elevation	Circle One	A	2394.5 Square Feet
		B	2388.3 Square Feet
Optional Layouts	Circle All that Apply		

Model	38.4 The Vivaldi		
Elevation	Circle One	A	2459.1 Square Feet
		B	2459.1 Square Feet
Optional Layouts	Circle All that Apply		

Model	38.5 The Handel		
Elevation	Circle One	A	2549.2 Square Feet
		B	2554.7 Square Feet
Optional Layouts	Circle All that Apply		

Model	38.9 The Puccini		
Elevation	Circle One	A	3628.0 Square Feet
		B	3634.7 Square Feet
Optional Layouts	Circle All that Apply	GFA1	GROUND FLOOR Optional Alternative Layout

Model	38.6 The Scarlatti		
Elevation	Circle One	A	3521.1 Square Feet
		B	3508.1 Square Feet
Optional Layouts	Circle All that Apply	GFA1	GROUND FLOOR Optional Alternative Layout

Model	38.7 The Schubert		
Elevation	Circle One	A	3593.8 Square Feet
		B	3610.5 Square Feet
Optional Layouts	Circle All that Apply	GFA1	GROUND FLOOR Optional Alternative Layout
		SFA4	SECOND FLOOR Additional Bedroom

Model	38.8 The Corelli		
Elevation	Circle One	A	3801.5 Square Feet
		B	3801.5 Square Feet
Optional Layouts	Circle All that Apply	GFA1	GROUND FLOOR Optional Alternative Layout
		SFA4	SECOND FLOOR Additional Bedroom w/ Ensuite

Model	41.1 The Strauss		
Elevation	Circle One	A	2554.2 Square Feet
		B	2571.2 Square Feet
Optional Layouts	Circle All that Apply	SFA1	SECOND FLOOR Shower in Lieu of Tub B2

Model	41.2 The Mozart		
Elevation	Circle One	A	2725.9 Square Feet
		B	2711.1 Square Feet
Optional Layouts	Circle All that Apply	SFA1	SECOND FLOOR Shower in Lieu of Tub B2

Model	41.3 The Chopin		
Elevation	Circle One	A	2800.0 Square Feet
		B	2810.5 Square Feet
Optional Layouts	Circle All that Apply		

Model	41.4 The Bach		
Elevation	Circle One	A	2894.4 Square Feet
		B	2894.5 Square Feet
Optional Layouts	Circle All that Apply		

Model	41.5 The Brahms		
Elevation	Circle One	A	3948.1 Square Feet
		B	3949.1 Square Feet
Optional Layouts	Circle All that Apply	GFA1	GROUND FLOOR Optional Alternative Layout
		SFA2	SECOND FLOOR Shower in Lieu of Tub B4
		SFA3	SECOND FLOOR Optional Laundry Layout

Model	41.6 The Verdi		
Elevation	Circle One	A	3862.5 Square Feet
		B	3866.4 Square Feet
Optional Layouts	Circle All that Apply	GFA1	GROUND FLOOR Optional Alternative Layout
		SFA3	SECOND FLOOR Optional Laundry Layout

Lot 109
May 3, 16

DB