

CONSTRUCTION SUMMARY

9 - 1 - 38-6 Elev.A SCARLATTI

CENTRAL VAC AND WIRING

Inv.499	1 - TELEPHONE AND CABLE ROUGH-IN LOCATIONS
Line6062	Note:
16May16 / 20Sep16	

ELECTRICAL

Inv.499	1 - KITCHEN: INSTALL 110V WALL RECEPTACLE ON DEDICATED CIRCUIT - FOR MICROWAVE - MICROWAVE NOT INCLUDED- ABOVE STOVE
Line6063	Note:
16May16 / 20Sep16	

Inv.499	1 - MASTER ENSUITE: INSTALL BATHROOM FAN DELAY- ONE UNIT- IN MASTER ENSUITE
Line6065	Note:
16May16 / 20Sep16	

Inv.499	4 - LIVING ROOM: INSTALL FOUR (X4) POT LIGHTS: 4 INCH HALOGEN POT LIGHT - 440 WH- IN LIVING ROOM, ON SEPERATE SWITCH. IN ADDITION TO THE SWITCH CONTROLLED RECEPTICAL
Line6066	Note:
16May16 / 20Sep16	

Inv.499	6 - KITCHEN: INSTALL SIX (X6) POT LIGHTS: 4 INCH HALOGEN POT LIGHT - 440 WH- IN KITCHEN, IN ADDITION TO STANDARD LIGHT. ON SEPERATE SWITCH
Line6067	Note:
16May16 / 20Sep16	

EXTERIOR COLOURS

Inv.499	1 - EXTERIOR COLOUR PACKAGE 2
Line10533	Note:
16May16 / 20Sep16	

Inv.499	1 - EXTERIOR COLOUR PACKAGE 2
Line11637	Note:
16May16 / 20Sep16	

FORMING

Inv.499	1 - EXTERIOR: INSTALL SIDE DOOR- HOME TO EXTERIOR- AS PER PLAN AND GRADE PERMITTING
Line6070	Note: GRADING DOES NOT PERMIT SIDE DOOR (NOR MAN DOOR) PER SITING AUGUST 2, 2016 - CREDIT FOR SIDE DOOR DUE TO PURCHASER
16May16 / 20Sep16	

HVAC

Inv.499	1 - KITCHEN: INSTALL GAS LINE ROUGH - 2ND FLOOR- (3-STOREY MODELS) FOR STOVE
Line6071	Note:
16May16 / 20Sep16	

MISC.

Inv.499	1 - BONUS PACKAGE: \$8786.80 (INCLUDING TAXES) WORTH OF UPGRADES FROM GOLD PARK HOMES DÉCOR CENTRE IS BEING APPLIED TOWARD THE STRUCTURAL APPOINTMENT. PURCHASER HAS A REMAINING AMOUNT OF \$1213.20 (INCLUDING TAXES) TO BE USED TOWARD THE COLOUR APPOINTMENT
Line6107	Note:
16May16 / 20Sep16	

CONSTRUCTION SUMMARY

9 - 1 - 38-6 Elev.A SCARLATTI

Inv.499	1 - Purchaser has attended a Structural appointment at the Decor Centre & has DECLINED any additional upgrades and accepts and acknowledges that there will be no further structural changes/additions/deletions to be made upon signing on May 18, 2016
Line6108	Note:
16May16 / 20Sep16	
Inv.499	1 - Purchasers are aware & accepts that ANY changes made to upgrades after signing this Purchasers Extra Form are subject to a minimum administration fee of \$500. PLUS a 10% holdback fee
Line6109	Note:
16May16 / 20Sep16	



PLUMBING

Inv.499	1 - KITCHEN: INSTALL ROUGH-IN - WATERLINE FOR FRIDGE
Line6072	Note:
16May16 / 20Sep16	
Inv.499	1 - BASEMENT: INSTALL ROUGH-IN - 3PC BASEMENT ROUGH-IN, AS PER PLAN
Line6073	Note:
16May16 / 20Sep16	

The Scarlatti

38' SERIES

Elevation A • 3,591 sq.ft. | Elevation B • 3,578 sq.ft.

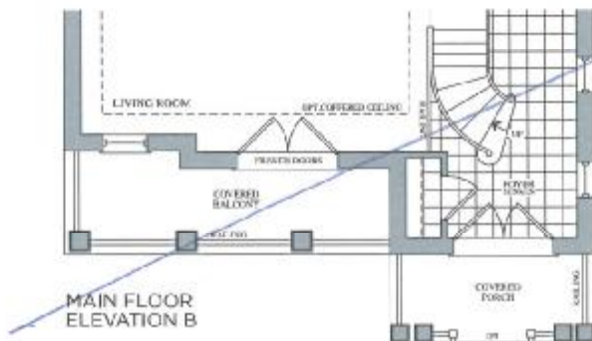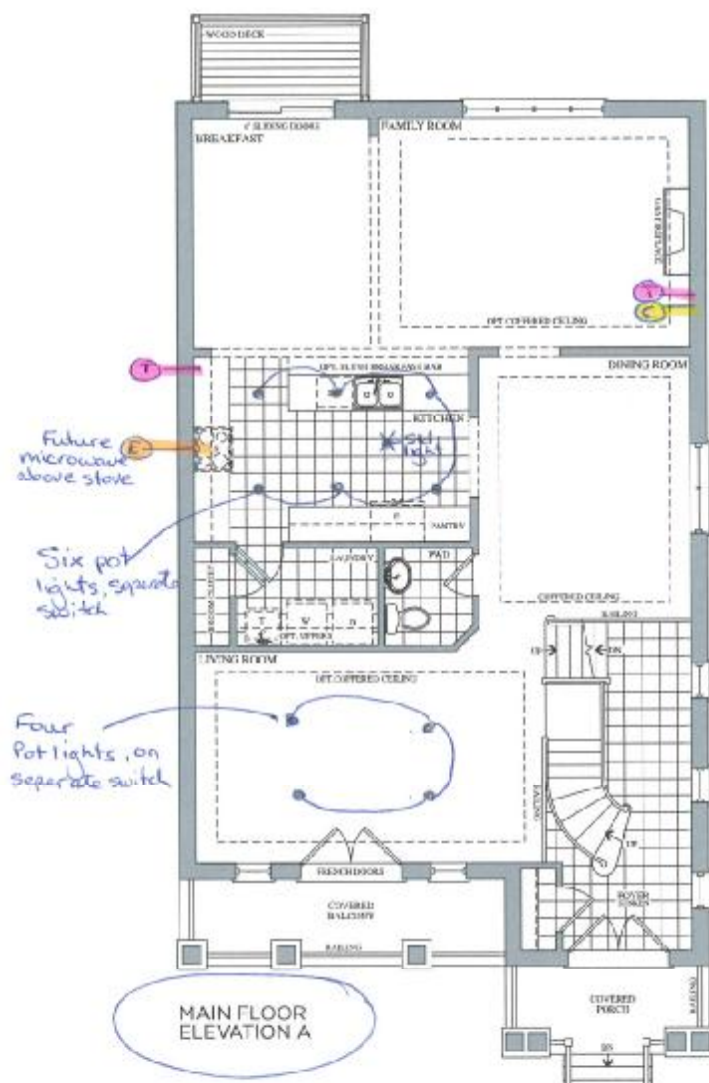



Lot 9
May 18, 16

SEE NEXT PAGE FOR SIGNATURE

The Scarlatti 38' SERIES

Elevation A • 3,591 sq.ft. | Elevation B • 3,578 sq.ft.

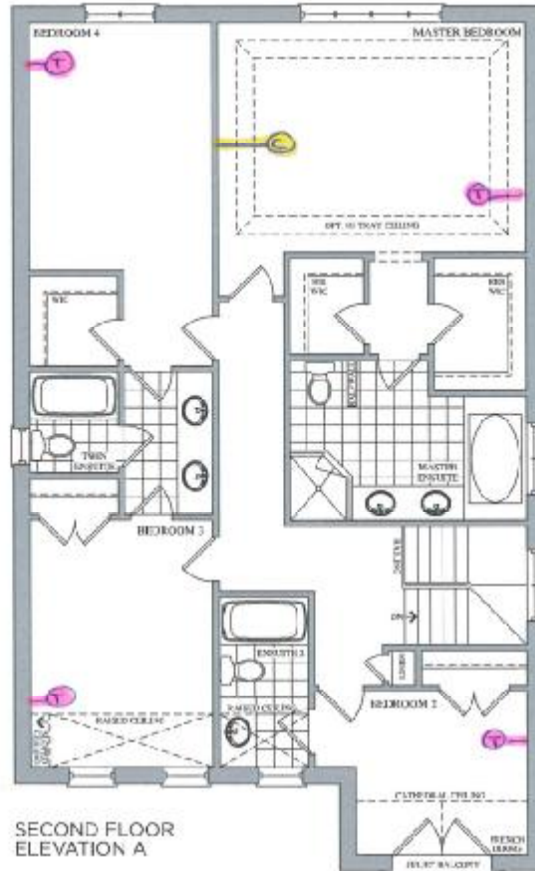


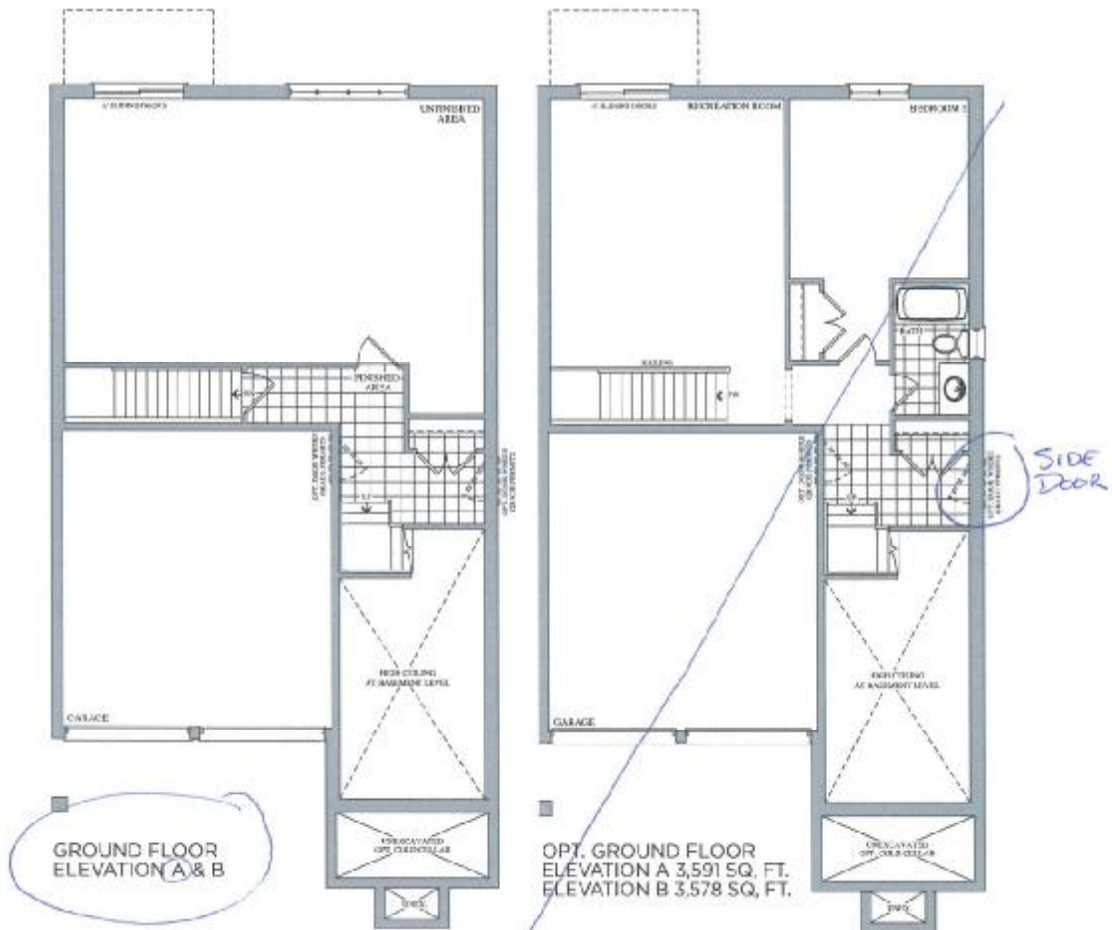


Lot 9
May 18, 2016



SEE NEXT PAGE FOR SIGNATURES.

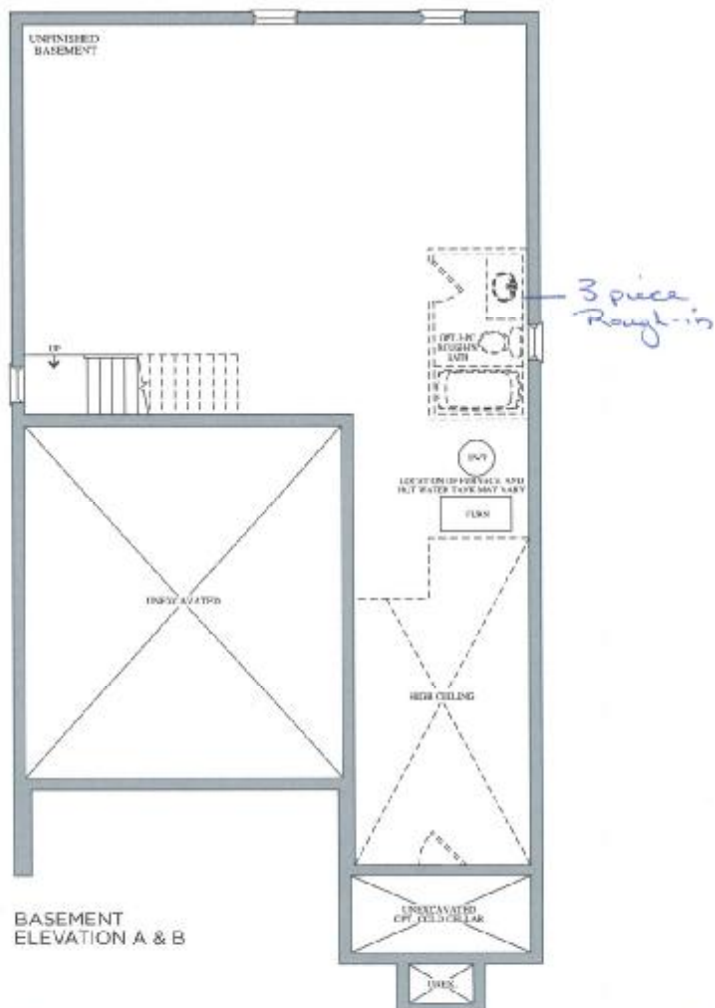

BASEMENT
ELEVATION A & B

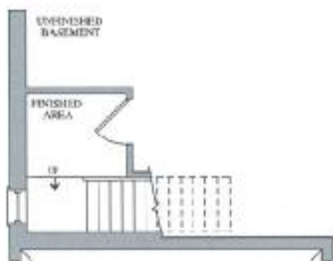

OPT. BASEMENT
ELEVATION A & B

Lot 9
May 18, 16



SEE NEXT PAGE FOR SIGNATURES