

CONSTRUCTION SUMMARY

13 - 1 - 38-8 Elev.A CORELLI OPT - GFA1

CENTRAL VAC AND WIRING

Inv.524	1 - TELEPHONE AND CABLE ROUGH-IN LOCATIONS
Line6311	Note:
30May16 / 20Sep16	
Inv.524	1 - FAMILY ROOM: INSTALL CONDUIT PIPE- FOR TELEVISION- MUST SPECIFY LOCATION AND TERMINATION POINT
Line6312	Note:
30May16 / 20Sep16	

ELECTRICAL

Inv.524	1 - FAMILY ROOM: INSTALL 110V WALL RECEPTACLE ON DEDICATED CIRCUIT - ABOVE FIREPLACE SEE SKETCH
Line6313	Note:
30May16 / 20Sep16	
Inv.524	1 - BASEMENT: INSTALL 200 AMP ELECTRICAL SERVICE
Line6314	Note:
30May16 / 20Sep16	

EXTERIOR COLOURS

Inv.524	1 - EXTERIOR COLOUR PACKAGE 8
Line11642	Note:
30May16 / 20Sep16	

FORMING

Inv.524	1 - EXTERIOR: INSTALL SIDE DOOR- HOME TO EXTERIOR- AS PER PLAN AND GRADE PERMITTING
Line6316	Note: GRADE DOES NOT PERMIT - CREDIT DUE TO PURCHASER - PER SITING AUGUST 2, 2016
30May16 / 20Sep16	

FRAMING

Inv.524	1 - GARAGE: INSTALL MANDOOR - GARAGE TO HOUSE- AS PER PLAN AND GRADE PERMITTING
Line6315	Note: GIVEN IN AGREEMENT OF PURCHASE AND SALE
30May16 / 20Sep16 GRADE DOES NOT PERMIT - NO CREDIT TO PURCHASER - PER SITING AUGUST 2, 2016	

MISC.

Inv.524	1 - BONUS PACKAGE: \$7977.80 (INCLUDING TAXES) WORTH OF UPGRADES FROM GOLD PARK HOMES DÉCOR CENTRE IS BEING APPLIED TOWARD THE STRUCTURAL APPOINTMENT. PURCHASER HAS A REMAINING AMOUNT OF \$2022.20 (INCLUDING TAXES) TO BE USED TOWARD THE COLOUR APPOINTMENT
Line6321	Note:
30May16 / 20Sep16	
Inv.524	1 - Purchasers are aware & accepts that ANY changes made to upgrades after signing this Purchasers Extra Form are subject to a minimum administration fee of \$500. PLUS a 10% holdback fee
Line6323	Note:
30May16 / 20Sep16	
Inv.524	1 - Purchaser has attended a Structural appointment at the Decor Centre & has DECLINED any additional upgrades and accepts and acknowledges that there will be no further structural changes/additions/deletions to be made upon signing on May 30, 2016
Line6322	Note:
30May16 / 20Sep16	



CONSTRUCTION SUMMARY

13 - 1 - 38-8 Elev.A CORELLI OPT - GFA1

Inv.524	1 - THIS IS A MODEL 38-8 SCARLATTI ELEVATION A AND WAS PURCHASED WITH BOTH OPTIONAL GROUND FLOOR AND OPTIONAL SECOND FLOOR WITH 5TH BEDROOM
Line11641	Note:
30May16 / 20Sep16	

PLUMBING

Inv.524	1 - KITCHEN: INSTALL ROUGH-IN - WATERLINE FOR FRIDGE
Line6319	Note:
30May16 / 20Sep16	

Inv.524	1 - BASEMENT: INSTALL ROUGH-IN - 3PC BASEMENT ROUGH-IN, AS PER PLAN
Line6318	Note:
30May16 / 20Sep16	

WINDOWS - BASEMENT

Inv.524	2 - BASEMENT: INSTAL TWO (X2) BASEMENT WINDOWS - UPGRADE EXISTING BASEMENT WINDOW TO 46 INCH X 32 INCH - MAY REQUIRE INSTALLATION OF WINDOW WELL. TO BE APPROVED BY CONSTRUCTION
Line6320	Note:
30May16 / 20Sep16	

Telephone — (T)
Cable — (C)
Electrical — (E)

The
Corelli
38' SERIES

Elevation A • 3,878 sq.ft. | Elevation B • 3,878 sq.ft.




Prices, features, illustrations, sizes, features and finishes are subject to change without notice. E.O.C. Areas and dimensions are approximate and actual usable floor space may vary from the stated area. Layout may be reverse of the unit purchased. E. & O.E.

GOLDpark
HOMES

Telephone (T)

The
Corelli
38' SERIES


Elevation A • 3,878 sq.ft. | Elevation B • 3,878 sq.ft.

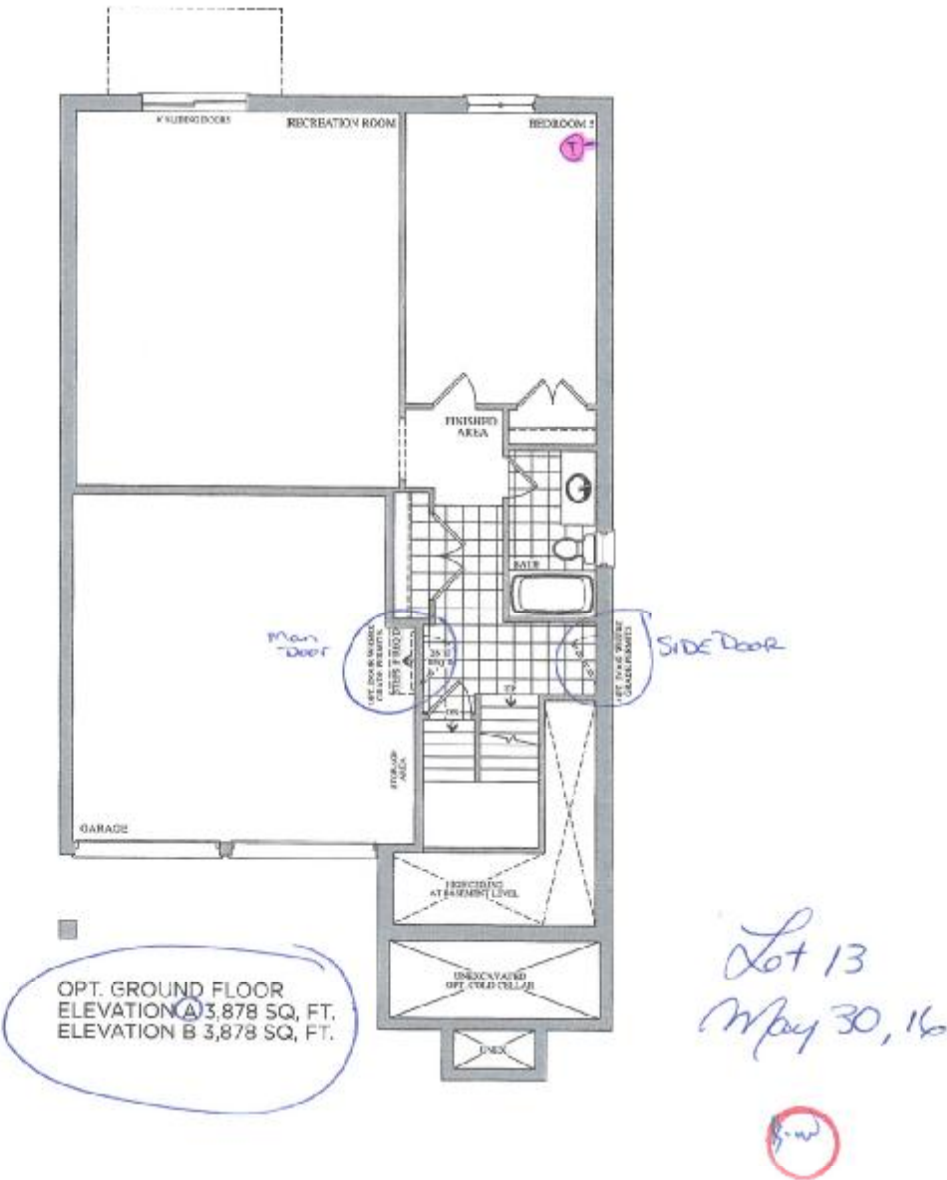

Please, figures, illustrations, sizes, features and finishes are subject to change without notice. E & O E. Areas are approximate and actual usable floor space may vary from the stated area. Layout may be reverse of the one purchased. E. & O.E.

Basement Windows

2x 46" x 32"

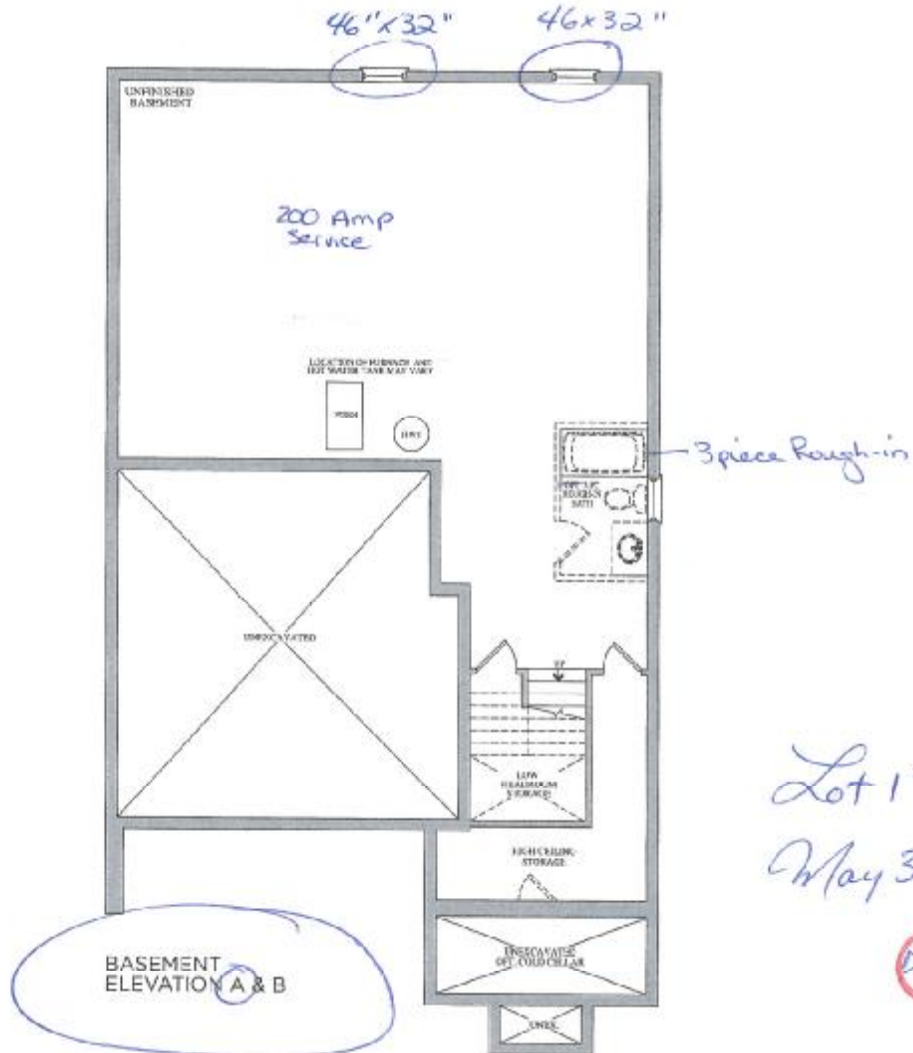

Lot 13
May 30, 16

D.W.



Stacey Corlete
Project Coordinator



Claude Azzopardi
Contracts Manager



Nancy Mc
Corporate C

13
Lot #



Model	38.1 The Bizet		
Elevation	Circle One	A	2189.6 Square Feet
		B	2186.7 Square Feet
Optional Layouts	Circle All that Apply		

Model	38.2 The Ravel		
Elevation	Circle One	A	2271.5 Square Feet
		B	2275.7 Square Feet
Optional Layouts	Circle All that Apply		

Model	38.3 The Haydn		
Elevation	Circle One	A	2394.5 Square Feet
		B	2388.3 Square Feet
Optional Layouts	Circle All that Apply		

Model	38.4 The Vivaldi		
Elevation	Circle One	A	2459.1 Square Feet
		B	2459.1 Square Feet
Optional Layouts	Circle All that Apply		

Model	38.5 The Handel		
Elevation	Circle One	A	2549.2 Square Feet
		B	2554.7 Square Feet
Optional Layouts	Circle All that Apply		

Model	38.9 The Puccini		
Elevation	Circle One	A	3628.0 Square Feet
		B	3634.7 Square Feet
Optional Layouts	Circle All that Apply	GFA1	GROUND FLOOR Optional Alternative Layout

Model	38.6 The Scarlatti		
Elevation	Circle One	A	3521.1 Square Feet
		B	3508.1 Square Feet
Optional Layouts	Circle All that Apply	GFA1	GROUND FLOOR Optional Alternative Layout

Model	38.7 The Schubert		
Elevation	Circle One	A	3595.8 Square Feet
		B	3610.5 Square Feet
Optional Layouts	Circle All that Apply	GFA1	GROUND FLOOR Optional Alternative Layout
		SFA4	SECOND FLOOR Additional Bedroom
Optional Layouts	Circle All that Apply		

Model	38.8 The Corelli		
Elevation	Circle One	A	3801.5 Square Feet
		B	3801.5 Square Feet
Optional Layouts	Circle All that Apply	GFA1	GROUND FLOOR Optional Alternative Layout
		SFA4	SECOND FLOOR Additional Bedroom w/ Ensuite
Optional Layouts	Circle All that Apply		

Model	41.1 The Strauss		
Elevation	Circle One	A	2554.2 Square Feet
		B	2571.2 Square Feet
Optional Layouts	Circle All that Apply	SFA1	SECOND FLOOR Shower in Lieu of Tub B2

Model	41.2 The Mozart		
Elevation	Circle One	A	2725.9 Square Feet
		B	2711.1 Square Feet
Optional Layouts	Circle All that Apply	SFA1	SECOND FLOOR Shower in Lieu of Tub B2

Model	41.3 The Chopin		
Elevation	Circle One	A	2800.0 Square Feet
		B	2810.5 Square Feet
Optional Layouts	Circle All that Apply		

Model	41.4 The Bach		
Elevation	Circle One	A	2894.4 Square Feet
		B	2894.5 Square Feet
Optional Layouts	Circle All that Apply		

Model	41.5 The Brahms		
Elevation	Circle One	A	3948.1 Square Feet
		B	3949.1 Square Feet
Optional Layouts	Circle All that Apply	GFA1	GROUND FLOOR Optional Alternative Layout
		SFA2	SECOND FLOOR Shower in Lieu of Tub B4
Optional Layouts	Circle All that Apply	SFA3	SECOND FLOOR Optional Laundry Layout

Model	41.6 The Verdi		
Elevation	Circle One	A	3852.5 Square Feet
		B	3856.4 Square Feet
Optional Layouts	Circle All that Apply	GFA1	GROUND FLOOR Optional Alternative Layout
		SFA3	SECOND FLOOR Optional Laundry Layout
Optional Layouts	Circle All that Apply		

May 30, 16
B.W.