

CONSTRUCTION SUMMARY

15 - 1 - 38-5 Elev.A HANDEL

CENTRAL VAC AND WIRING

Inv.599	1 - TELEPHONE AND CABLE ROUGH-IN LOCATIONS
Line7341	Note:
22Jun16 / 21Sep16	
Inv.599	1 - FAMILY ROOM: INSTALL CONDUIT PIPE- FOR TELEVISION- IN FAMILY ROOM, 5 FEET ABOVE FINISHED FLOOR. TERMINATION POINT TO BE BELOW. SEE SKETCH
Line7342	Note:
22Jun16 / 21Sep16	

ELECTRICAL

Inv.599	1 - FAMILY ROOM: INSTALL 110V WALL RECEPTACLE ON DEDICATED CIRCUIT IN FAMILY ROOM,- 4'-5" ABOVE FINISHED FLOOR. TERMINATION POINT TO BE BELOW. SEE SKETCH
Line7343	Note:
22Jun16 / 21Sep16	
Inv.599	1 - BASEMENT: INSTALL 200 AMP ELECTRICAL SERVICE
Line7344	Note:
22Jun16 / 21Sep16	

EXTERIOR COLOURS

Inv.599	1 - EXTERIOR COLOUR PACKAGE 6
Line11648	Note:
22Jun16 / 21Sep16	

FORMING

Inv.741	1 - EXTERIOR: INSTALL SIDE DOOR- HOME TO EXTERIOR- AS PER PLAN AND GRADE PERMITTING
Line10054	Note: GRADE PERMITS AS PER SITING AUGUST 2, 2016
11Aug16 / 21Sep16	

FRAMING

Inv.599	1 - GARAGE: INSTALL MANDOOOR - GARAGE TO HOUSE- AS PER PLAN AND GRADE PERMITTING
Line7345	Note: GIVEN IN AGREEMENT OF PURCHASE AND SALE
22Jun16 / 21Sep16 GRADING ALLOWS PER SITING DATED AUGUST 2, 2016	

MISC.

Inv.599	1 - BONUS PACKAGE: \$3186.60 (INCLUDING TAXES) WORTH OF UPGRADES FROM GOLD PARK HOMES DÉCOR CENTRE IS BEING APPLIED TOWARD THE STRUCTURAL APPOINTMENT. PURCHASER HAS A REMAINING AMOUNT OF \$6813.40 (INCLUDING TAXES) TO BE USED TOWARD THE COLOUR APPOINTMENT
Line7350	Note:
22Jun16 / 21Sep16	
Inv.599	1 - Purchaser has attended a Structural appointment at the Decor Centre & has DECLINED any additional upgrades and accepts and acknowledges that there will be no further structural changes/additions/deletions to be made upon signing on June 22, 2016
Line7351	Note:
22Jun16 / 21Sep16	
Inv.599	1 - Purchasers are aware & accepts that ANY changes made to upgrades after signing this Purchasers Extra Form are subject to a minimum administration fee of \$500. PLUS a 10% holdback fee
Line7352	Note:
22Jun16 / 21Sep16	

CONSTRUCTION SUMMARY

15 - 1 - 38-5 Elev.A HANDEL

Inv.741	1 - ADMIN FEE TO REOPEN FILE
Line10056	Note:
11Aug16 / 21Sep16	
Inv.741	1 - BONUS PACKAGE: \$2825.00 (INCLUDING TAXES) WORTH OF UPGRADES FROM GOLD PARK HOMES DÉCOR CENTRE IS BEING APPLIED TOWARD THE STRUCTURAL APPOINTMENT. PURCHASER HAS A REMAINING AMOUNT OF \$3988.40 (INCLUDING TAXES) TO BE USED TOWARD THE COLOUR APPOINTMENT
Line10057	Note:
11Aug16 / 21Sep16	
Inv.741	1 - Purchasers are aware & accepts that ANY changes made to upgrades after signing this Purchasers Extra Form are subject to a minimum administration fee of \$500. PLUS a 10% holdback fee
Line10058	Note:
11Aug16 / 21Sep16	

PLUMBING


Inv.599	1 - KITCHEN: INSTALL ROUGH-IN - WATERLINE FOR FRIDGE
Line7347	Note:
22Jun16 / 21Sep16	

WINDOWS - BASEMENT

Inv.599	2 - BASEMENT: INSTALL TWO (X2) BASEMENT WINDOWS - UPGRADE EXISTING BASEMENT WINDOW TO 30 INCH X 24 INCH - MAY REQUIRE INSTALLATION OF WINDOW WELL
Line7346	Note:
22Jun16 / 21Sep16	
Inv.599	1 - BASEMENT: INSTALL ONE (X1) BASEMENT WINDOWS - UPGRADE EXISTING BASEMENT WINDOW TO 30 INCH X 16 INCH. SEE SKETCH
Line7349	Note:
22Jun16 / 21Sep16	

The
Handel
38' SERIES

Elevation A • 2,603 sq.ft. | Elevation B • 2,603 sq.ft.

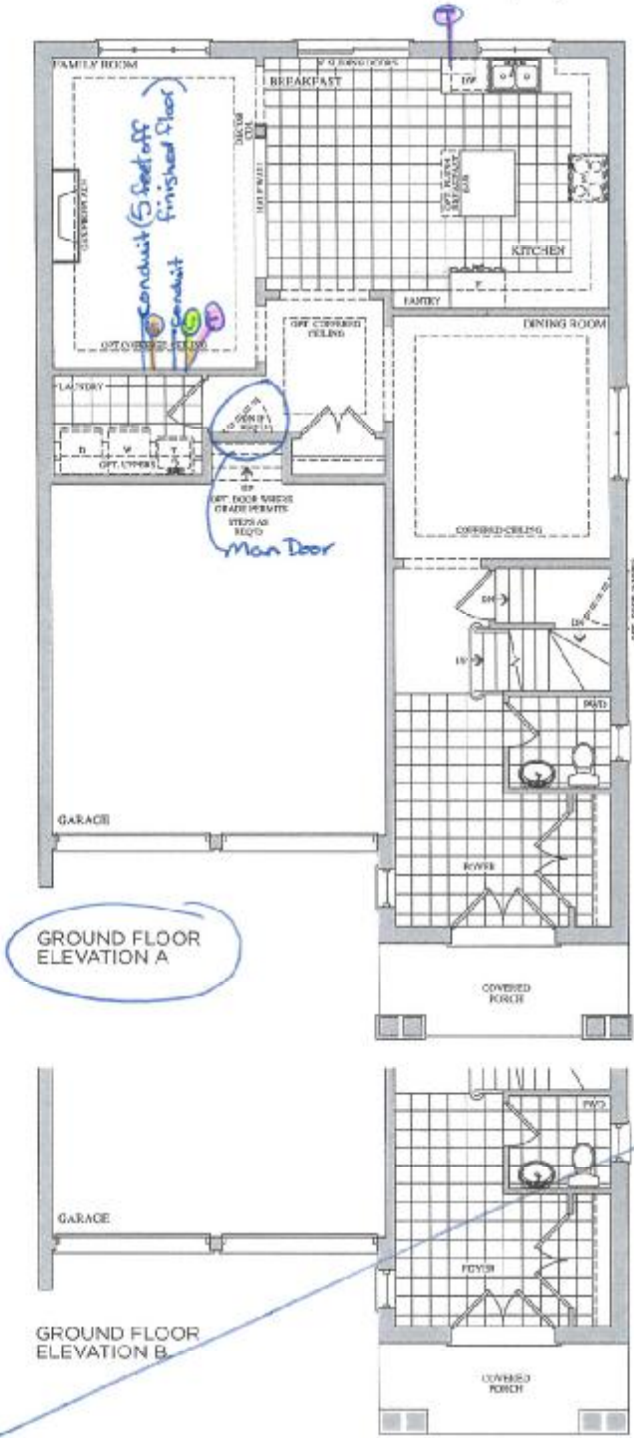

Replaced with
Aug 11, 2016.
Ney


Lot 15
June 22, 16


Prices, figures, illustrations, sizes, features and finishes are subject to change without notice. E&O.E. Areas and dimensions are approximate and actual usable floor space may vary from the stated area. Layout may be reverse of the unit purchased. E. & G.E.

The Handel

38' SERIES

Elevation A • 2,603 sq.ft. | Elevation B • 2,603 sq.ft.

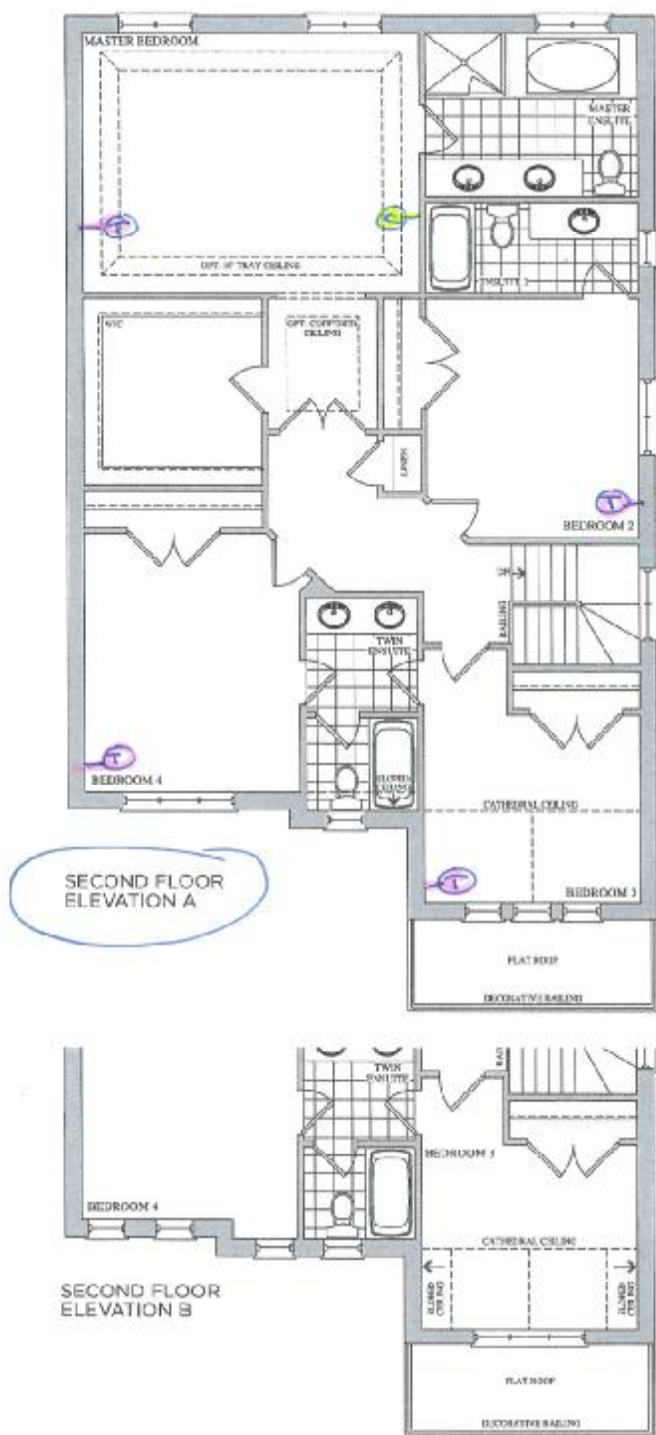


Lot 15
June 22, 16
~~OK~~ ~~OK~~

Basement Windows

2 x 30" x 24"

1 x 30" x 16"

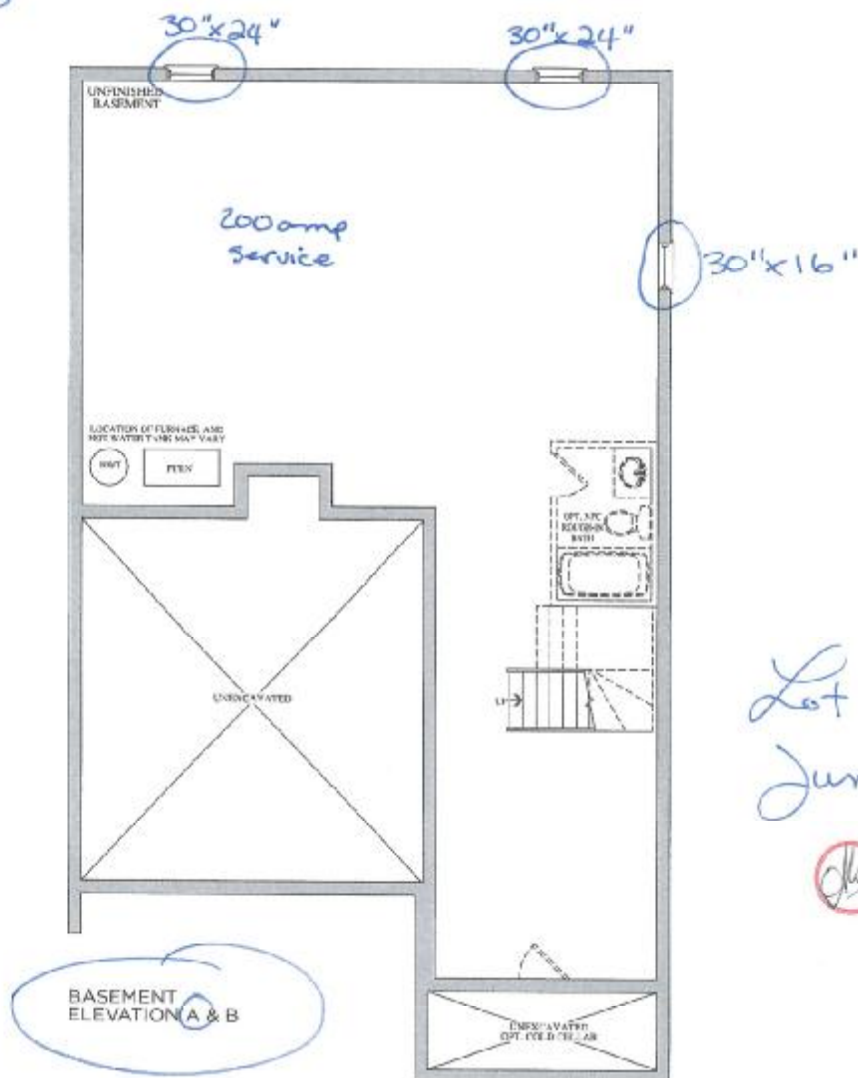

Lot 15
June 22, 16

(Signature)

(Signature)



Stacey Carlete
Project Coordinator



Claude Azzopardi
Contracts Manager



Nancy Mc
Corporate C



Model 38.1 The Bizet			
Elevation	Circle One	A	2189.6 Square Feet
		B	2188.7 Square Feet
Optional Layouts	Circle All that Apply		

Model 38.2 The Ravel			
Elevation	Circle One	A	2271.5 Square Feet
		B	2273.7 Square Feet
Optional Layouts	Circle All that Apply		

Model 38.3 The Haydn			
Elevation	Circle One	A	2394.5 Square Feet
		B	2368.3 Square Feet
Optional Layouts	Circle All that Apply		

Model 38.4 The Vivaldi			
Elevation	Circle One	A	2459.1 Square Feet
		B	2459.1 Square Feet
Optional Layouts	Circle All that Apply		

Model 38.5 The Handel			
Elevation	Circle One	A	2549.2 Square Feet
		B	2554.7 Square Feet
Optional Layouts	Circle All that Apply		

Model 38.9 The Puccini			
Elevation	Circle One	A	3628.0 Square Feet
		B	3634.7 Square Feet
Optional Layouts	Circle All that Apply	GFA1	GROUND FLOOR Optional Alternative Layout

Model 38.6 The Scarlatti			
Elevation	Circle One	A	3521.1 Square Feet
		B	3508.1 Square Feet
Optional Layouts	Circle All that Apply	GFA1	GROUND FLOOR Optional Alternative Layout

Model 38.7 The Schubert			
Elevation	Circle One	A	3593.8 Square Feet
		B	3610.5 Square Feet
Optional Layouts	Circle All that Apply	GFA1	GROUND FLOOR Optional Alternative Layout
		SFA4	SECOND FLOOR Additional Bedrooms
Optional Layouts	Circle All that Apply		

Model 38.8 The Corelli			
Elevation	Circle One	A	3801.5 Square Feet
		B	3801.5 Square Feet
Optional Layouts	Circle All that Apply	GFA1	GROUND FLOOR Optional Alternative Layout
		SFA4	SECOND FLOOR Additional Bedroom w/ Ensuite
Optional Layouts	Circle All that Apply		

Model 41.1 The Strauss			
Elevation	Circle One	A	2554.2 Square Feet
		B	2571.2 Square Feet
Optional Layouts	Circle All that Apply	SFA1	SECOND FLOOR Shower in Lieu of Tub B2

Model 41.2 The Mozart			
Elevation	Circle One	A	2725.8 Square Feet
		B	2711.1 Square Feet
Optional Layouts	Circle All that Apply	SFA1	SECOND FLOOR Shower in Lieu of Tub B2

Model 41.3 The Chopin			
Elevation	Circle One	A	2800.0 Square Feet
		B	2810.5 Square Feet
Optional Layouts	Circle All that Apply		

Model 41.4 The Bach			
Elevation	Circle One	A	2894.4 Square Feet
		B	2894.5 Square Feet
Optional Layouts	Circle All that Apply		

Model 41.5 The Brahms			
Elevation	Circle One	A	3948.1 Square Feet
		B	3949.1 Square Feet
Optional Layouts	Circle All that Apply	GFA1	GROUND FLOOR Optional Alternative Layout
		SFA2	SECOND FLOOR Shower in Lieu of Tub B4
Optional Layouts	Circle All that Apply	SFA3	SECOND FLOOR Optional Laundry Layout

Model 41.6 The Verdi			
Elevation	Circle One	A	3862.5 Square Feet
		B	3866.4 Square Feet
Optional Layouts	Circle All that Apply	GFA1	GROUND FLOOR Optional Alternative Layout
		SFA3	SECOND FLOOR Optional Laundry Layout
Optional Layouts	Circle All that Apply		

June 22, 16


OK

encore
BRAMPTON

Telephone — (T)
Cable — (C)
Electrical — (E)

The Handel 38' SERIES

Elevation A • 2,603 sq.ft. | Elevation B • 2,603 sq.ft.

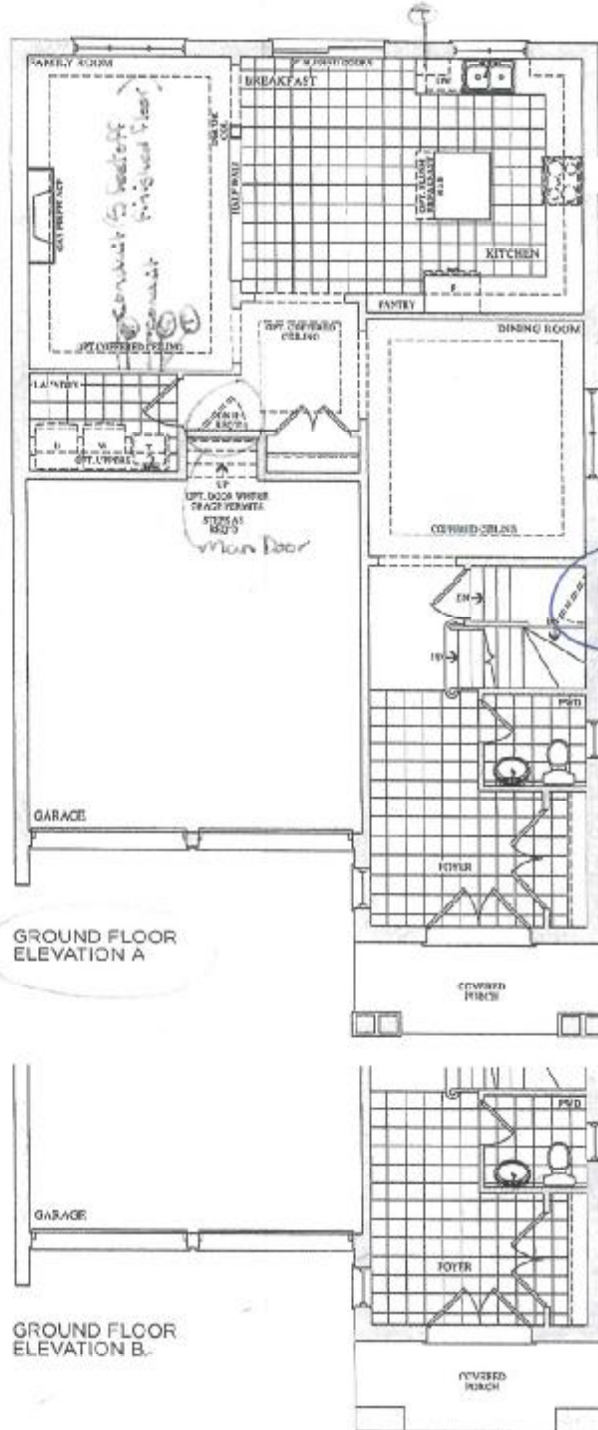

SIDE DOOR *NEW!

Lot 15
June 22, 16
[Signature]

Prices, figures, illustrations, story features and floor plans are subject to change without notice. E&O.E. Areas and dimensions are approximate and actual usable floor space may vary from the stated area. Layout may be reversed of the unit purchased. E. & O.E.

GOLD PARK HOMES

Replaces
June 22, 2016
Neyf

Lot 15
August 11, 2016
○○