

CONSTRUCTION SUMMARY

17 - 1 - 38-6 Elev.B SCARLATTI OPT- GFA1

CENTRAL VAC AND WIRING

Inv.534	1 - GROUND FLOOR: INSTALL ROUGH-IN FOR EXTRA SECURITY KEY PAD BY MAN DOOR.
Line6452	Note:
2Jun16 / 23Sep16	
Inv.534	1 - TELEPHONE AND CABLE ROUGH-IN LOCATIONS
Line6451	Note:
2Jun16 / 23Sep16	
Inv.534	1 - GROUND FLOOR/ REC ROOM: INSTALL RG 6 ROUGH-IN IN REC ROOM. SEE SKETCH
Line6457	Note:
2Jun16 / 23Sep16	

DRYWALL

Inv.534	1 - GROUND FLOOR BATHROOM- INSTALL SHOWER IN LIEU OF TUB- FRAMED SHOWER ENCLOSURE WITH POTLIGHT
Line11863	Note:
2Jun16 / 23Sep16	

ELECTRICAL

Inv.534	4 - EXTERIOR: INSTALL FOUR (X4) POT LIGHTS: 4 INCH LINE VOLTAGE POT LIGHT - (EXTERIOR) -EACH, AS PER PLAN, SEE SKETCH
Line6464	Note:
2Jun16 / 23Sep16	
Inv.534	1 - LIVING ROOM: INSTALL ADDITIONAL STANDARD FIXTURE WITH SWITCH - IN LIVING ROOM. IN ADDITION TO BUILDER'S STANDARD SWITCH CONTROLLED RECEPTICAL
Line6453	Note:
2Jun16 / 23Sep16	
Inv.534	1 - GROUND FLOOR BATHROOM- INSTALL SHOWER IN LIEU OF TUB- FRAMED SHOWER ENCLOSURE WITH POTLIGHT
Line11864	Note:
2Jun16 / 23Sep16	

EXTERIOR COLOURS

Inv.534	1 - EXTERIOR COLOUR PACKAGE 8
Line11860	Note:
2Jun16 / 23Sep16	

FORMING

Inv.534	1 - EXTERIOR: INSTALL SIDE DOOR- HOME TO EXTERIOR- AS PER PLAN AND GRADE PERMITTING
Line6455	Note: GRADING DOES NOT PERMIT THE SIDE DOOR - MUST CREDIT PURCHASER - AS PER SITING DATED AUGUST 2, 2016
2Jun16 / 23Sep16	

FRAMING

Inv.534	1 - GARAGE: INSTALL MANDOOR - GARAGE TO HOUSE- AS PER PLAN AND GRADE PERMITTING
Line6454	Note: GIVEN IN AGREEMENT OF PURCHASE AND SALE
2Jun16 / 23Sep16	

CONSTRUCTION SUMMARY

17 - 1 - 38-6 Elev.B SCARLATTI OPT- GFA1

Inv.534	1 - MAIN FLOOR: INSTALL FOUR (X4) STANDARD DOOR EXTENDED HEIGHT 96" (PRICE PER DOOR) MAIN FLOOR 3 STOREY MODELS - TO GO IN POWDER ROOM, CLOSETS AND LAUNDRY ROOM
Line11865	Note:
2Jun16 / 23Sep16	
Inv.534	1 - GROUND FLOOR BATHROOM- INSTALL SHOWER IN LIEU OF TUB- FRAMED SHOWER ENCLOSURE WITH POTLIGHT
Line11862	Note:
2Jun16 / 23Sep16	

GARAGE DOORS

Inv.534	2 - GARAGE: INSTALL INSULATION KIT - STANDARD GARAGE DOORS - EACH HOUSE REQUIRES 2 INSULATION KITS- PER DOOR PRICE
Line6458	Note:
2Jun16 / 23Sep16	

GLASS AND MIRROR

Inv.534	1 - GROUND FLOOR BATHROOM- INSTALL SHOWER IN LIEU OF TUB FRAMED SHOWER ENCLOSURE WITH POTLIGHT
Line6456	Note:
2Jun16 / 23Sep16	

HVAC

Inv.534	1 - KITCHEN: INSTALL GAS LINE ROUGH - MAIN FLOOR - (3 STOREY MODELS), FOR STOVE
Line6459	Note:
2Jun16 / 23Sep16	

INTERIOR TRIM AND DOORS

Inv.534	4 - MAIN FLOOR: INSTALL FOUR (X4) STANDARD DOOR EXTENDED HEIGHT 96" (PRICE PER DOOR) MAIN FLOOR 3 STOREY MODELS - TO GO IN POWDER ROOM, CLOSETS AND LAUNDRY ROOM
Line6461	Note:
2Jun16 / 23Sep16	

MISC.

Inv.534	1 - Purchaser has attended a Structural appointment at the Decor Centre & has DECLINED any additional upgrades and accepts and acknowledges that there will be no further structural changes/additions/deletions to be made upon signing on June 2, 2016
Line6466	Note:
2Jun16 / 23Sep16	
Inv.534	1 - BONUS PACKAGE: \$10,000.00 (INCLUDING TAXES) WORTH OF UPGRADES FROM GOLD PARK HOMES DÉCOR CENTRE IS BEING APPLIED TOWARD THE STRUCTURAL APPOINTMENT.
Line6465	Note:
2Jun16 / 23Sep16	
Inv.534	1 - Purchasers are aware & accepts that ANY changes made to upgrades after signing this Purchasers Extra Form are subject to a minimum administration fee of \$500. PLUS a 10% holdback fee
Line6467	Note:
2Jun16 / 23Sep16	

CONSTRUCTION SUMMARY

17 - 1 - 38-6 Elev.B SCARLATTI OPT- GFA1

Inv.534	1 - HOUSE IS MODEL 38-6 ELEVATION B AND PURCHASER BOUGHT THE OPTIONAL GROUND FLOOR
Line11861	Note:
2Jun16 / 23Sep16	

PLUMBING

Inv.534	1 - KITCHEN: INSTALL ROUGH-IN - WATERLINE FOR FRIDGE
Line6462	Note:
2Jun16 / 23Sep16	

Inv.534	1 - BASEMENT: INSTALL ROUGH-IN - 3PC BASEMENT ROUGH-IN, AS PER PLAN
Line6463	Note:
2Jun16 / 23Sep16	

WINDOWS - BASEMENT


Inv.534	4 - BASEMENT: INSTALL FOUR (X4) BASEMENT WINDOWS - UPGRADE EXISTING BASEMENT WINDOW TO 30 INCH X 24 INCH - MAY REQUIRE INSTALLATION OF WINDOW WELL
Line6460	Note:
2Jun16 / 23Sep16	

WINDOWS AND DOORS

Inv.534	1 - GARAGE: INSTALL MANDOOR - GARAGE TO HOUSE- AS PER PLAN AND GRADE PERMITING
Line10229	Note:
2Jun16 / 23Sep16	

**The
Scarlatti**
38' SERIES

Elevation A • 3,591 sq.ft. | Elevation B • 3,578 sq.ft.

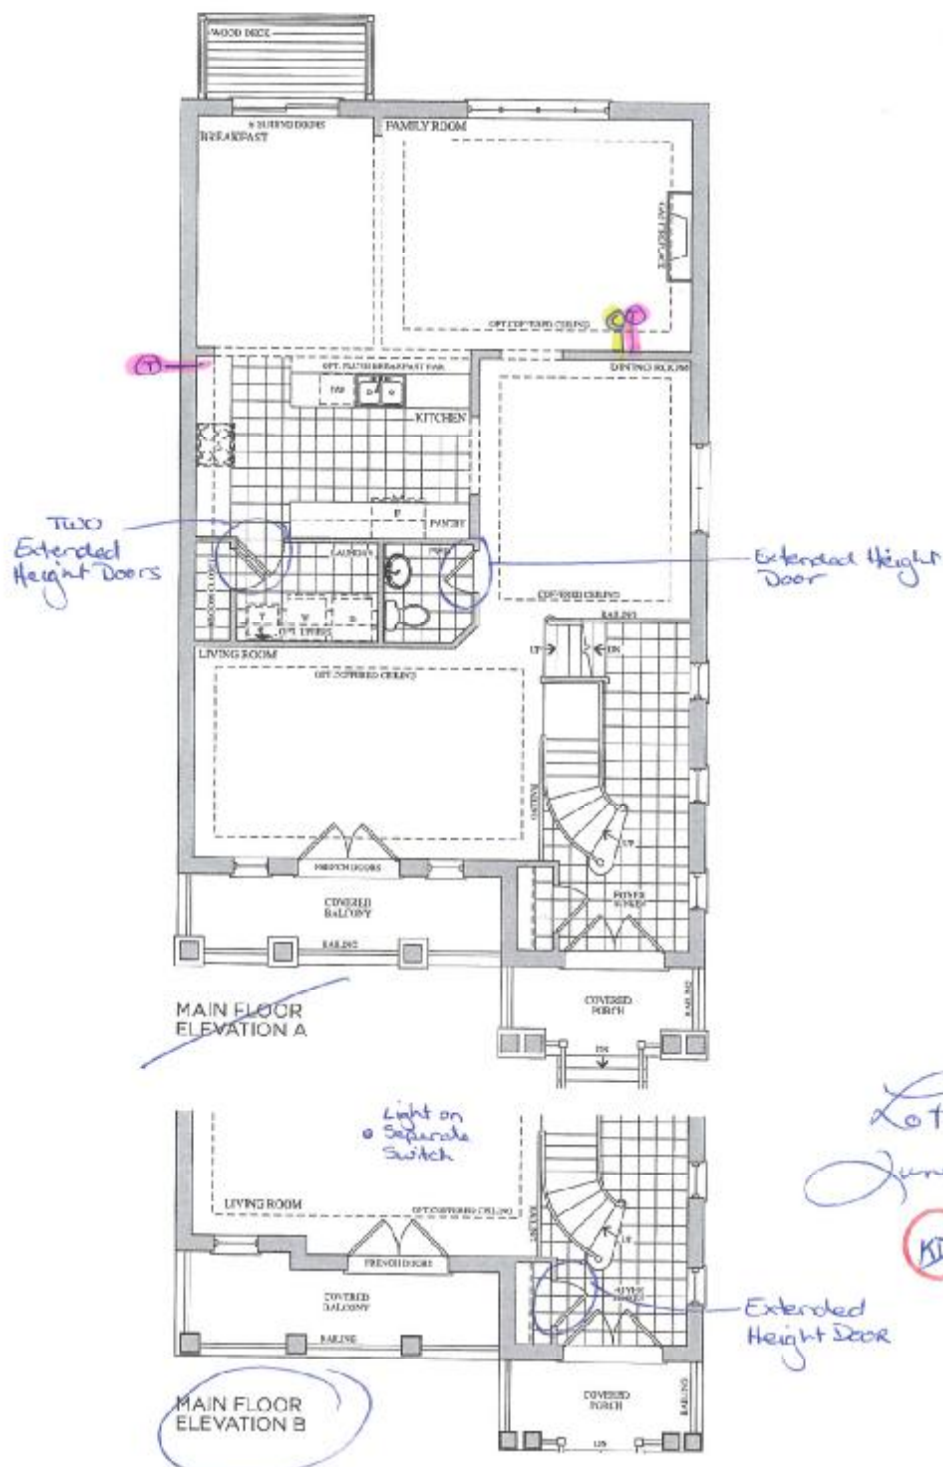



Prices, figures, illustrations, sizes, features and finishes are subject to change without notice. E&OE. Areas and dimensions are approximate and actual usable floor space may vary from the stated area. Layout may be reverse of the unit purchased. E & OE.

GOLDPARK
HOMES

Lot 17
June 2, 186

The
Scarlatti
38' SERIES

Elevation A • 3,591 sq.ft. | Elevation B • 3,578 sq.ft.

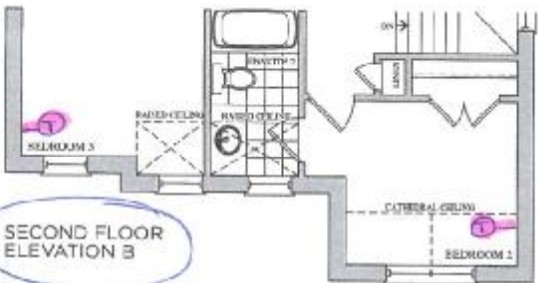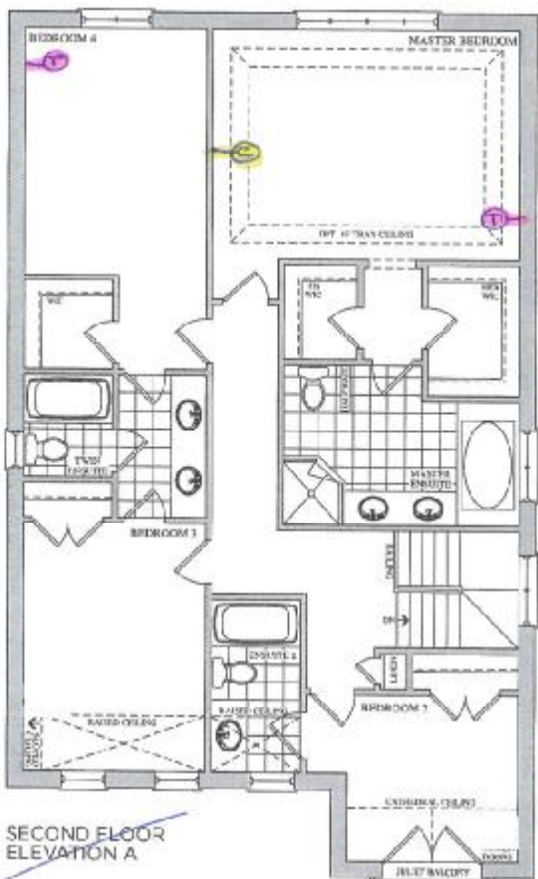

Lot 17
June 2, 16

KS AL


encore
BRAMPTON

Telephone — (T)

Cable — (C)

The Scarlatti 38' SERIES

Elevation A • 3,591 sq.ft. | Elevation B • 3,578 sq.ft.

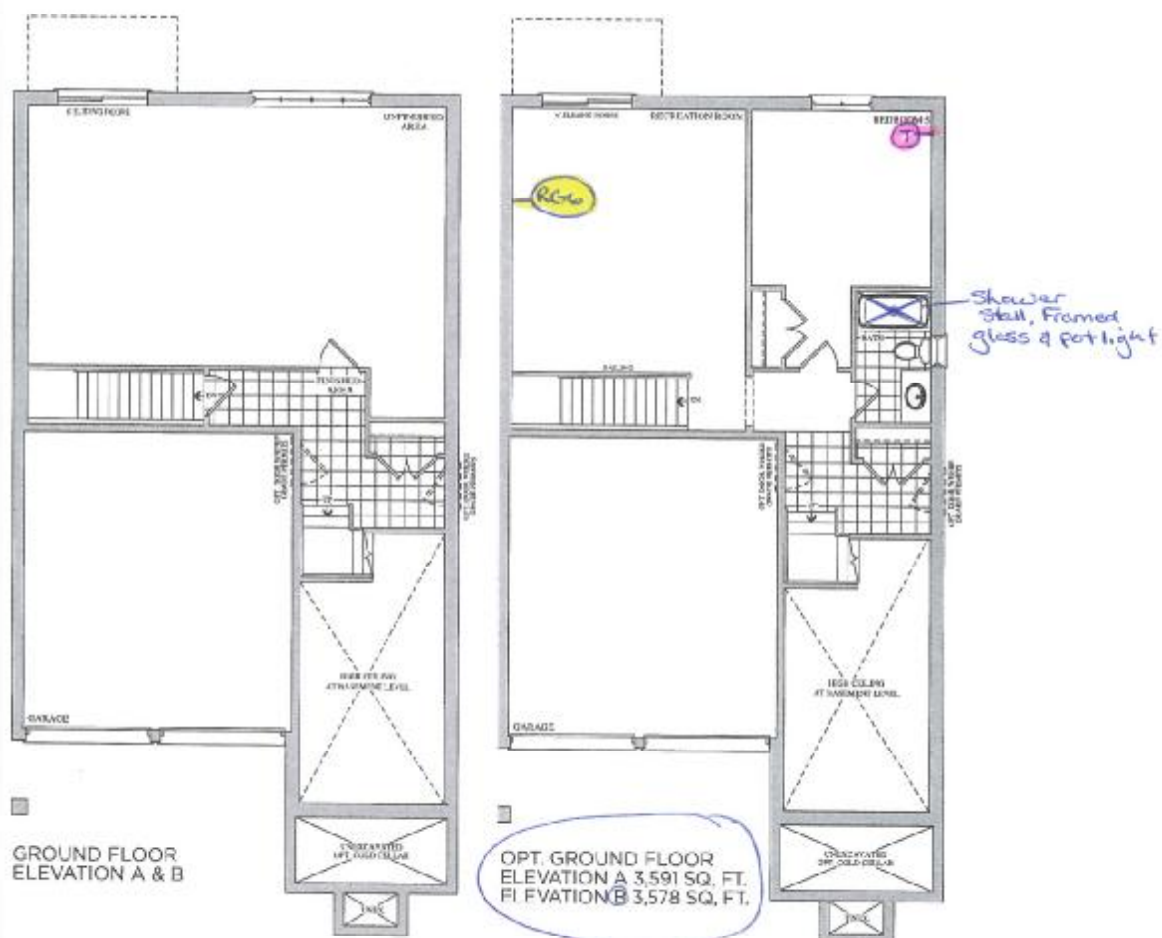

Lot 17
June 2, 16



Prices, figures, illustration sizes, features and finishes are subject to change without notice. L&D. Areas and dimensions are approximate and actual. Available floor space may vary from the stated area. Layout may be reverse of the unit purchased. E & O.E.


GOLDPARK
HOMES

encore
BRAMPTON


The
Scarlatti
38' SERIES

Elevation A • 3,591 sq.ft. | Elevation B • 3,578 sq.ft.

BSMNT WINDOWS
4 x 30" x 24"

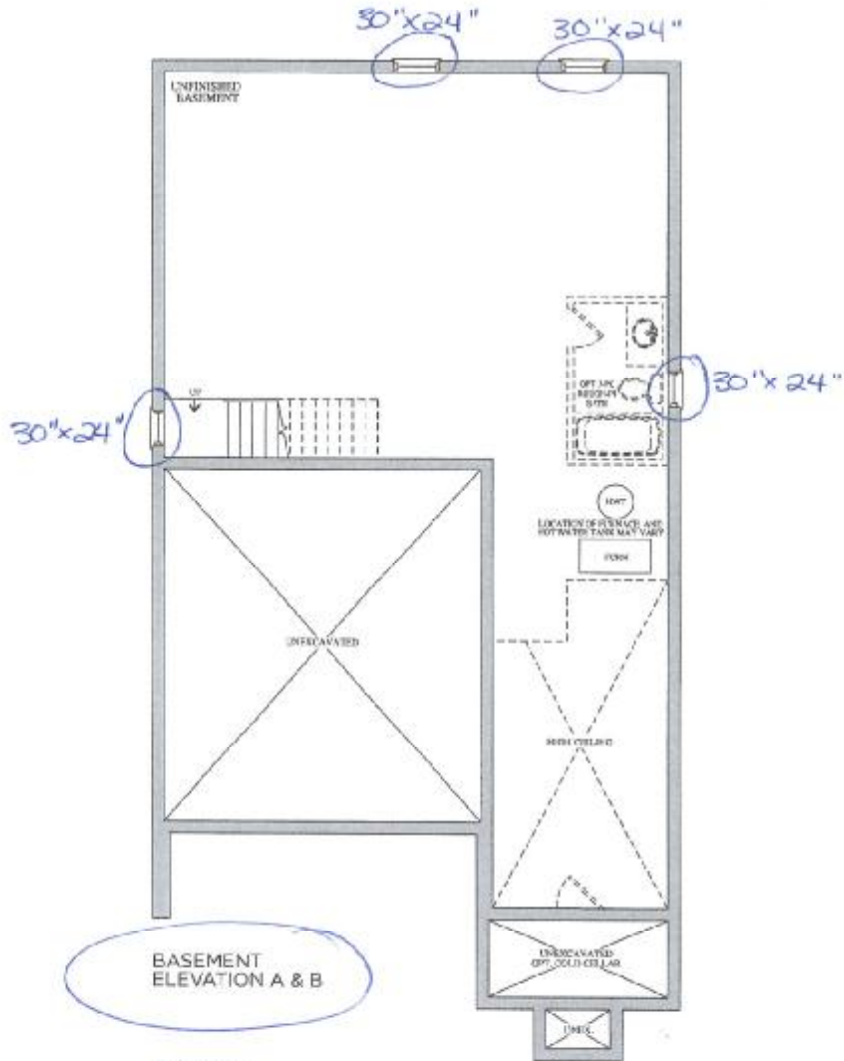

BASEMENT
ELEVATION A & B

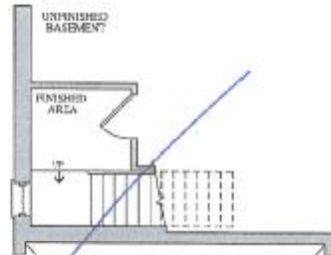

OPT. BASEMENT
ELEVATION A & B

Lot 17
June 2, 16

KP

Wk

Prices, figures, illustrations, sizes, features and finishes are subject to change without notice. L.B.O.B. Areas and dimensions are approximate and actual usable floor space may vary from the stated area. Layout may be reverse of the one illustrated. E & O.E.

GOLDPARK
HOMES

Lot 17



Elevation A • 2,943 sq.ft.



Elevation B • 2,930 sq.ft.



Four (x4)
Exterior
Potlights

Lot 17,
June 2, 16



GOLDPARK
HOMES

Prices, figures, illustrations, sizes, features and finishes are subject to change without notice. E.&O.E. Areas and dimensions are approximate and actual usable floor space may vary from the stated area. Layout may be reverse of the unit purchased. E. & O.E.



Stacey Carlete
Project Coordinator



Claude Azzopardi
Contracts Manager



Nancy McCorporate

17
Lot #



Model	38.1 The Bizet		
Elevation	Circle One	A	2189.6 Square Feet
		B	2185.7 Square Feet
Optional Layouts	Circle All that Apply		

Model	38.2 The Ravel		
Elevation	Circle One	A	2771.5 Square Feet
		B	2273.7 Square Feet
Optional Layouts	Circle All that Apply		

Model	38.3 The Haydn		
Elevation	Circle One	A	2394.5 Square Feet
		B	2388.3 Square Feet
Optional Layouts	Circle All that Apply		

Model	38.4 The Vivaldi		
Elevation	Circle One	A	2459.1 Square Feet
		B	2459.1 Square Feet
Optional Layouts	Circle All that Apply		

Model	38.5 The Handel		
Elevation	Circle One	A	2549.2 Square Feet
		B	2554.7 Square Feet
Optional Layouts	Circle All that Apply		

Model	38.9 The Puccini		
Elevation	Circle One	A	3528.0 Square Feet
		B	3534.7 Square Feet
Optional Layouts	Circle All that Apply	GFA1	GROUND FLOOR Optional Alternative Layout

Model	38.6 The Scarlatti		
Elevation	Circle One	A	3521.1 Square Feet
		B	3508.1 Square Feet
Optional Layouts	Circle All that Apply	GFA1	GROUND FLOOR Optional Alternative Layout

Model	38.7 The Schubert		
Elevation	Circle One	A	3593.8 Square Feet
		B	3610.5 Square Feet
Optional Layouts	Circle All that Apply	GFA1	GROUND FLOOR Optional Alternative Layout
		SFA4	SECOND FLOOR Additional Bedroom

Model	38.8 The Corelli		
Elevation	Circle One	A	3801.5 Square Feet
		B	3801.5 Square Feet
Optional Layouts	Circle All that Apply	GFA1	GROUND FLOOR Optional Alternative Layout
		SFA4	SECOND FLOOR Additional Bedroom w/ Ensuite

Model	41.1 The Strauss		
Elevation	Circle One	A	2554.2 Square Feet
		B	2571.2 Square Feet
Optional Layouts	Circle All that Apply	SFA1	SECOND FLOOR Shower in Lieu of Tub B2

Model	41.2 The Mozart		
Elevation	Circle One	A	2725.9 Square Feet
		B	2711.1 Square Feet
Optional Layouts	Circle All that Apply	SFA1	SECOND FLOOR Shower in Lieu of Tub B2

Model	41.3 The Chopin		
Elevation	Circle One	A	2800.0 Square Feet
		B	2810.5 Square Feet
Optional Layouts	Circle All that Apply		

Model	41.4 The Bach		
Elevation	Circle One	A	2894.4 Square Feet
		B	2894.5 Square Feet
Optional Layouts	Circle All that Apply		

Model	41.5 The Brahms		
Elevation	Circle One	A	3948.1 Square Feet
		B	3949.1 Square Feet
Optional Layouts	Circle All that Apply	GFA1	GROUND FLOOR Optional Alternative Layout
		SFA2	SECOND FLOOR Shower in Lieu of Tub B4
		SFA3	SECOND FLOOR Optional Laundry Layout

Model	41.6 The Verdi		
Elevation	Circle One	A	3862.5 Square Feet
		B	3866.4 Square Feet
Optional Layouts	Circle All that Apply	GFA1	GROUND FLOOR Optional Alternative Layout
		SFA3	SECOND FLOOR Optional Laundry Layout

Lot 17
June 2, 16

