

CONSTRUCTION SUMMARY

33 - 1 - 38-3 Elev.A HAYDN

CENTRAL VAC AND WIRING

Inv.552	1 - TELEPHONE AND CABLE ROUGH-IN LOCATIONS.
Line9502	Note:
8Jun16 / 20Sep16	

ELECTRICAL

Inv.552	1 - KITCHEN: INSTALL 110V WALL RECEPTACLE ON DEDICATED CIRCUIT - FOR MICROWAVE - MICROWAVE NOT INCLUDED. TO GO ABOVE STOVE
Line9509	Note:
8Jun16 / 20Sep16	

Inv.552	1 - FAMILY ROOM: INSTALL ONE ADDITIONAL STANDARD FIXTURE WITH SWITCH - IN FAMILY ROOM, IN ADDITION TO BUILDER'S STANDARD LIGHT. SEE SKETCH
Line9503	Note:
8Jun16 / 20Sep16	

Inv.552	1 - FAMILY ROOM: RELOCATE STANDARD FIXTURE - SEE SKETCH
Line9504	Note:
8Jun16 / 20Sep16	

EXTERIOR COLOURS

Inv.833	1 - EXTERIOR COLOUR PACKAGE 9
Line11598	Note:
20Sep16 / 20Sep16	

FORMING

Inv.552	1 - EXTERIOR: INSTALL SIDE DOOR- HOME TO EXTERIOR- AS PER PLAN AND GRADE PERMITTING
Line9506	Note:
8Jun16 / 20Sep16	

FRAMING

Inv.552	1 - GARAGE: INSTALL MANDOOR - GARAGE TO HOUSE- AS PER PLAN AND GRADE PERMITTING
Line9505	Note: GIVEN IN AGREEMENT OF PURCHASE AND SALE
8Jun16 / 20Sep16	

MISC.

Inv.552	1 - BONUS PACKAGE: \$5260.15 (INCLUDING TAXES) WORTH OF UPGRADES FROM GOLD PARK HOMES DÉCOR CENTRE IS BEING APPLIED TOWARD THE STRUCTURAL APPOINTMENT. PURCHASER HAS A REMAINING AMOUNT OF \$4739.85 (INCLUDING TAXES) TO BE USED TOWARD THE COLOUR APPOINTMENT
Line9510	Note:
8Jun16 / 20Sep16	

Inv.552	1 - Purchaser has attended a Structural appointment at the Decor Centre & has DECLINED any additional upgrades and accepts and acknowledges that there will be no further structural changes/additions/deletions to be made upon signing on July 28, 2016
Line9511	Note:
8Jun16 / 20Sep16	

Inv.552	1 - Purchasers are aware & accepts that ANY changes made to upgrades after signing this Purchasers Extra Form are subject to a minimum administration fee of \$500. PLUS a 10% holdback fee
Line9512	Note:
8Jun16 / 20Sep16	



CONSTRUCTION SUMMARY

33 - 1 - 38-3 Elev.A HAYDN

PLUMBING

Inv.552	1 - BASEMENT: INSTALL ROUGH-IN - 3PC BASEMENT ROUGH-IN
Line9508	Note:
8Jun16 / 20Sep16	

WINDOWS - BASEMENT


Inv.552	2 - BASEMENT: INSTALL TWO (X2) BASEMENT WINDOWS - UPGRADE EXISTING BASEMENT WINDOW TO 30 INCH X 24 INCH - MAY REQUIRE INSTALLATION OF WINDOW WELL. SEE SKETCH
Line9507	Note:
8Jun16 / 20Sep16	

encore
BRAMPTON

Telephone — (T)
Cable — (C)
Electrical — (E)

The Haydn 38' SERIES

Elevation A • 2,454 sq.ft. | Elevation B • 2,448 sq.ft.

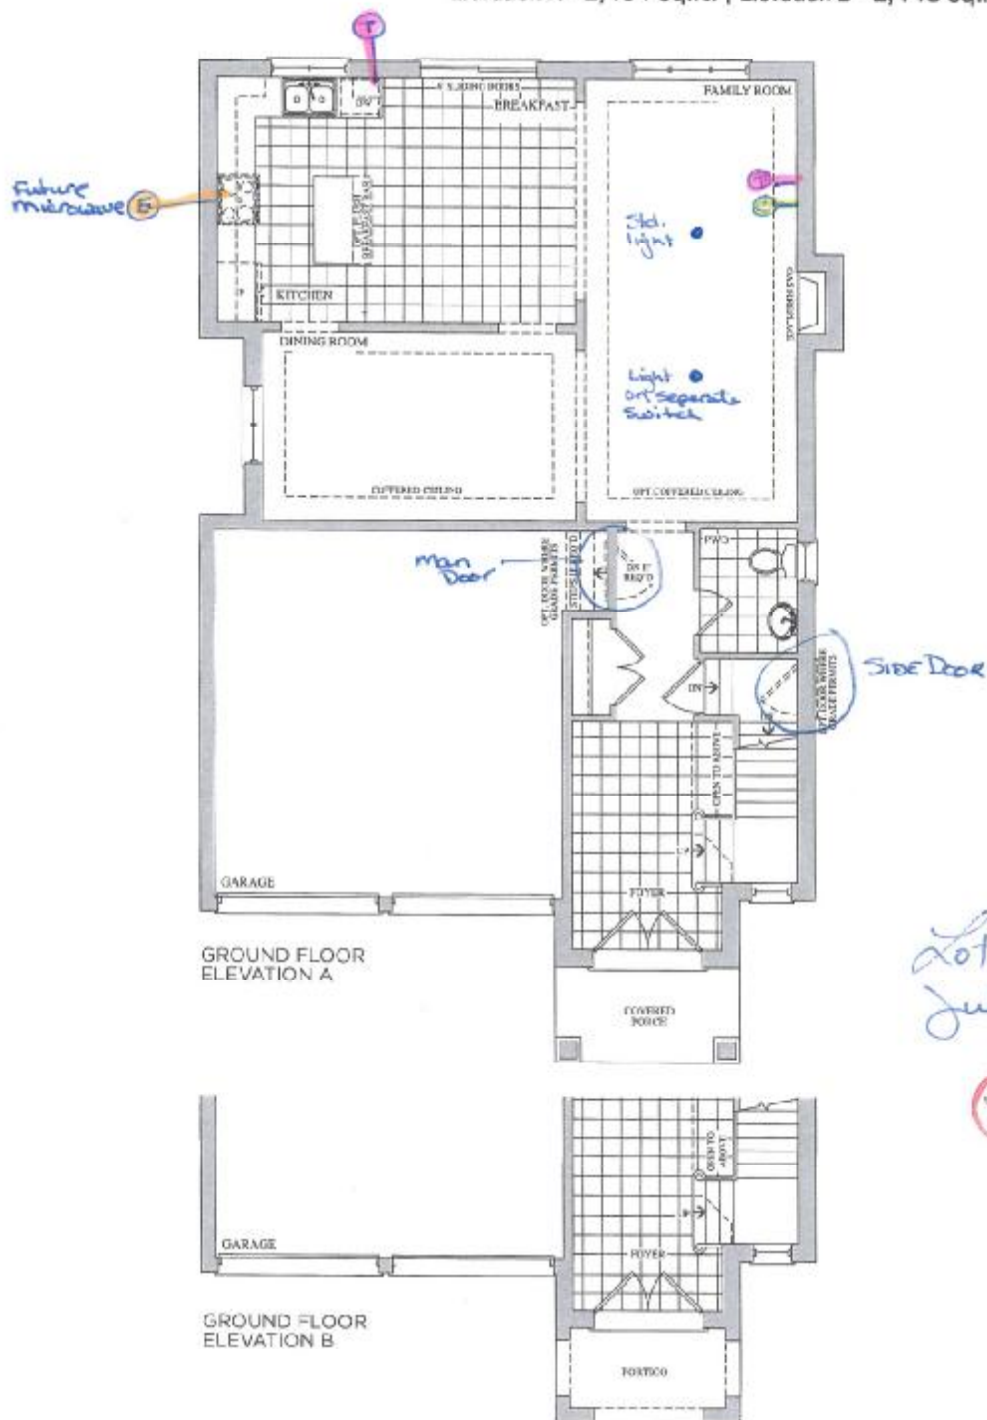

Printed figures, elevations, views, features and finishes are subject to change without notice. E.R.O.E. Areas and dimensions are approximate and actual inside floor space may vary from the stated area. Layout may be reverse of this unit purchased. E. & O.B.


GOLDPARK
HOMES

encore
BRAMPTON

Telephone — (T)
cable — (C)

The Haydn 38' SERIES

Elevation A • 2,454 sq.ft. | Elevation B • 2,448 sq.ft.

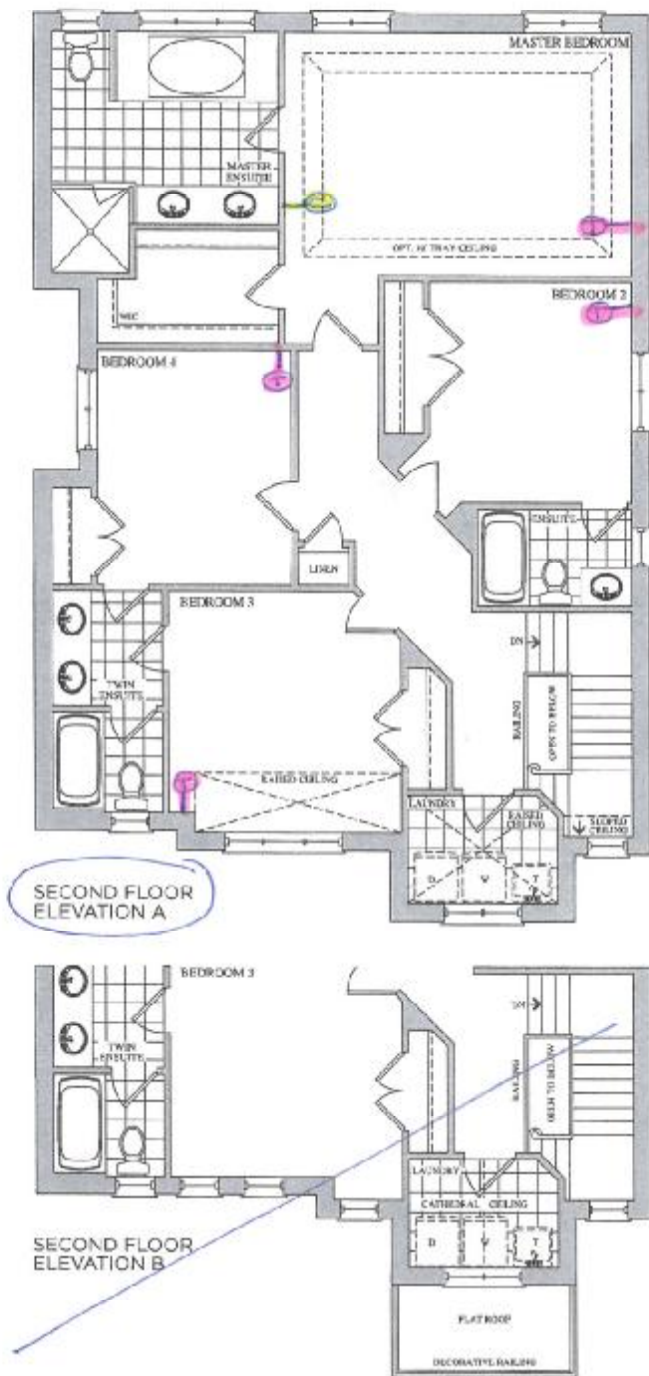

Prices, hours, illustration's sizes, features and finishes are subject to change without notice. E.A.D.C. Areas and dimensions are approximate and actual. Available floor space may vary from the stated area. Layout may be reverse of the unit portrayed. E. & O.E.


GOLDPARK
HOMES

encore
BRAMPTON

Basement Windows
2x 30"x24"

The
Haydn
38' SERIES

Elevation A • 2,454 sq.ft. | Elevation B • 2,448 sq.ft.

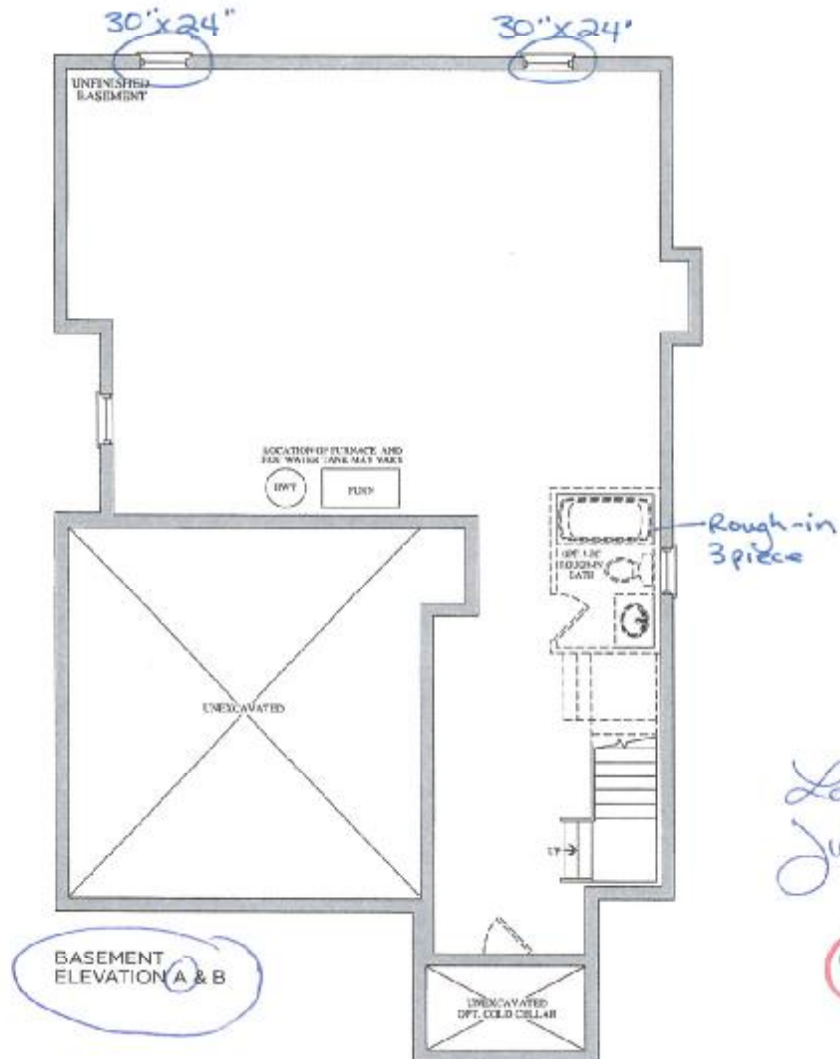

Prices, figures, illustrations, sizes, features and finishes are subject to change without notice. All dimensions and approximate area to actual usable floor space may vary from the stated area. Layout may be reverse of the one purchased. E. & G.E.

GOLDPARK
H O M E S