



CONSTRUCTION SUMMARY

35 - 1 - 38-8 Elev.A CORELLI OPT - GFA1

CENTRAL VAC AND WIRING

Inv.565	1 - TELEPHONE AND CABLE ROUGH-IN LOCATIONS
Line6870	Note:
14Jun16 / 20Sep16	
Inv.565	1 - BEDROOM #2: INSTALL RG 6 ROUGH-IN, TO GO IN BED #2, SEE SKETCH
Line6871	Note:
14Jun16 / 20Sep16	
Inv.565	1 - BEDROOM #3: INSTALL RG 6 ROUGH-IN, TO GO IN BED #3, SEE SKETCH
Line6872	Note:
14Jun16 / 20Sep16	
Inv.565	1 - BEDROOM #4: INSTALL RG 6 ROUGH-IN, TO GO IN BED #4, SEE SKETCH
Line6873	Note:
14Jun16 / 20Sep16	
Inv.565	1 - GROUND FLOOR/ REC ROOM: INSTALL RG 6 ROUGH-IN, TO GO GROUND FLOOR/ REC ROOM. SEE SKETCH
Line6874	Note:
14Jun16 / 20Sep16	

ELECTRICAL

Inv.565	1 - MASTER ENSUITE: INSTALL BATHROOM FAN DELAY- ONE UNIT- TO GO IN MASTER ENSUITE.
Line6877	Note:
14Jun16 / 20Sep16	
Inv.565	1 - DINING/LIVING ROOM: RELOCATE STANDARD FIXTURE - CENTRE TTHE CEILING LIGHT IN THE LIVING/DINING ROOM. SEE SKETCH
Line6880	Note:
14Jun16 / 20Sep16	
Inv.565	1 - KITCHEN CABINET STRIP VALANCE LIGHTS (UNDER CABINETS) - ROUGH - IN - DOES NOT INCLUDE (AND REQUIRES) KITCHEN UPGRADE PRICING
Line6881	Note:
14Jun16 / 20Sep16	
Inv.565	1 - BASEMENT: INSTALL ROUGH-IN LAUNDRY IN BASEMENT, TUB NOT INCLUDED. SEE SKETCH
Line11543	Note:
14Jun16 / 20Sep16	

EXTERIOR COLOURS

Inv.565	1 - EXTERIOR COLOUR PACKAGE 6
Line11545	Note:
14Jun16 / 20Sep16	

FORMING

Inv.565	1 - EXTERIOR: INSTALL SIDE DOOR- HOME TO EXTERIOR- AS PER PLAN AND GRADE PERMITTING
Line6883	Note: * Grade does not permit * * Do not install *
14Jun16 / 20Sep16	

FRAMING



CONSTRUCTION SUMMARY

35 - 1 - 38-8 Elev.A CORELLI OPT - GFA1

Inv.565	1 - GARAGE: INSTALL MANDOOR - GARAGE TO HOUSE- AS PER PLAN AND GRADE PERMITTING
Line6882	Note: GIVEN IN THE AGREEMENT OF PURCHASE AND SALE
14Jun16 / 20Sep16	* Grade does <u>NOT</u> Permit *
Inv.565	1 - FAMILY ROOM: INSTALL OPTIONAL COFFERED CEILING - FAMILY ROOM (PER ROOM AS PER PLAN)
Line6884	Note:
14Jun16 / 20Sep16	
Inv.565	1 - MAIN FLOOR: INSTALL THREE (X3) STANDARD DOORS EXTENDED HEIGHT 96" (PRICE PER DOOR) MAIN FLOOR 3 STOREY MODELS - TO GO IN POWDER ROOM, LAUNDRY ROOM AND CLOSET. SEE SKETCH
Line11542	Note:
14Jun16 / 20Sep16	

GARAGE DOORS

Inv.565	2 - GARAGE: INSTALL TWO (X2) INSULATION KIT - STANDARD GARAGE DOORS - EACH HOUSE REQUIRES 2 INSULATION KITS- PER DOOR PRICE
Line6885	Note:
14Jun16 / 20Sep16	
Inv.565	2 - GARAGE: INSTALL TWO (X2) GARAGE DOOR OPENERS - WITH 1 REMOTE EACH- PRICE IS PER DOOR
Line6886	Note:
14Jun16 / 20Sep16	
Inv.565	1 - GARAGE: INSTALL DIGITAL ENTRY KEYPAD
Line6887	Note:
14Jun16 / 20Sep16	

HVAC

Inv.565	1 - KITCHEN: INSTALL GAS LINE ROUGH - MAIN FLOOR - (3 STOREY MODELS), FOR STOVE
Line6889	Note:
14Jun16 / 20Sep16	
Inv.565	1 - BASEMENT: INSTALL ROUGH-IN LAUNDRY IN BASEMENT, TUB NOT INCLUDED. SEE SKETCH
Line11544	Note:
14Jun16 / 20Sep16	

INTERIOR TRIM AND DOORS

Inv.565	3 - MAIN FLOOR: INSTALL THREE (X3) STANDARD DOORS EXTENDED HEIGHT 96" (PRICE PER DOOR) MAIN FLOOR 3 STOREY MODELS - TO GO IN POWDER ROOM, LAUNDRY ROOM AND CLOSET. SEE SKETCH
Line6890	Note:
14Jun16 / 20Sep16	

MISC.

Inv.565	1 - BONUS PACKAGE: \$15,000.00 (INCLUDING TAXES) WORTH OF UPGRADES FROM GOLD PARK HOMES DÉCOR CENTRE IS BEING APPLIED TOWARD THE STRUCTURAL APPOINTMENT. PURCHASER HAS A REMAINING AMOUNT OF \$00 (INCLUDING TAXES) TO BE USED TOWARD THE COLOUR APPOINTMENT
Line6894	Note:
14Jun16 / 20Sep16	



CONSTRUCTION SUMMARY

35 - 1 - 38-8 Elev.A CORELLI OPT - GFA1

Inv.565	1 - Purchaser has attended a Structural appointment at the Decor Centre & has DECLINED any additional upgrades and accepts and acknowledges that there will be no further structural changes/additions/deletions to be made upon signing on June 14, 2016
Line6895	Note:
14Jun16 / 20Sep16	
Inv.565	1 - Purchasers are aware & accepts that ANY changes made to upgrades after signing this Purchasers Extra Form are subject to a minimum administration fee of \$500. PLUS a 10% holdback fee
Line6896	Note:
14Jun16 / 20Sep16	

PLUMBING

Inv.565	1 - KITCHEN: INSTALL ROUGH-IN - WATERLINE FOR FRIDGE
Line6891	Note:
14Jun16 / 20Sep16	
Inv.565	1 - BASEMENT: INSTALL ROUGH-IN - 3PC BASEMENT ROUGH-IN, AS PER PLAN
Line6892	Note:
14Jun16 / 20Sep16	
Inv.565	1 - BASEMENT: INSTALL ROUGH-IN LAUNDRY IN BASEMENT, TUB NOT INCLUDED. SEE SKETCH
Line6893	Note:
14Jun16 / 20Sep16	

WINDOWS - BASEMENT

Inv.565	3 - BASEMENT: INSTALL THREE (X3) BASEMENT WINDOWS - UPGRADE EXISTING BASEMENT WINDOW TO 30 INCH X 24 INCH - MAY REQUIRE INSTALLATION OF WINDOW WELL
Line6888	Note:
14Jun16 / 20Sep16	



GOLDPARK
HOMES

encore
BRAMPTON

Telephone — (T)
Cable — (C)

The
Corelli
38' SERIES

Elevation A • 3,878 sq.ft. | Elevation B • 3,878 sq.ft.

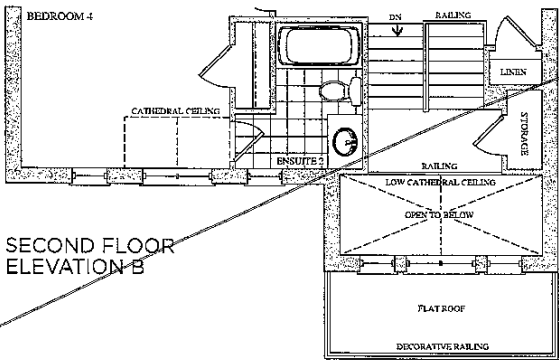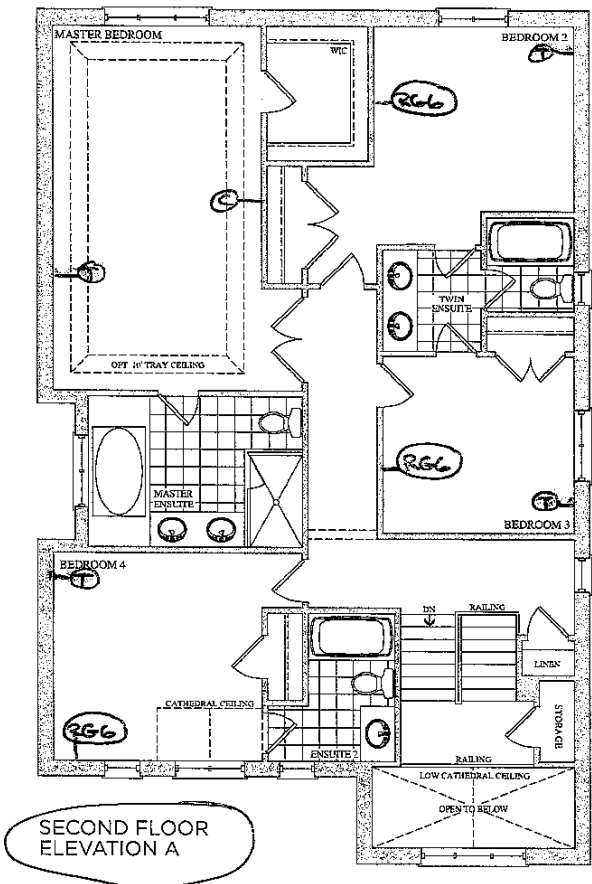


Lot 35
June 14, 16




Prices, figures, illustrations, sizes, features and finishes are subject to change without notice. E&O.E. Areas and dimensions are approximate and actual usable floor space may vary from the stated area. Layout may be reverse of the unit purchased. E. & O.E.

GOLDPARK
HOMES

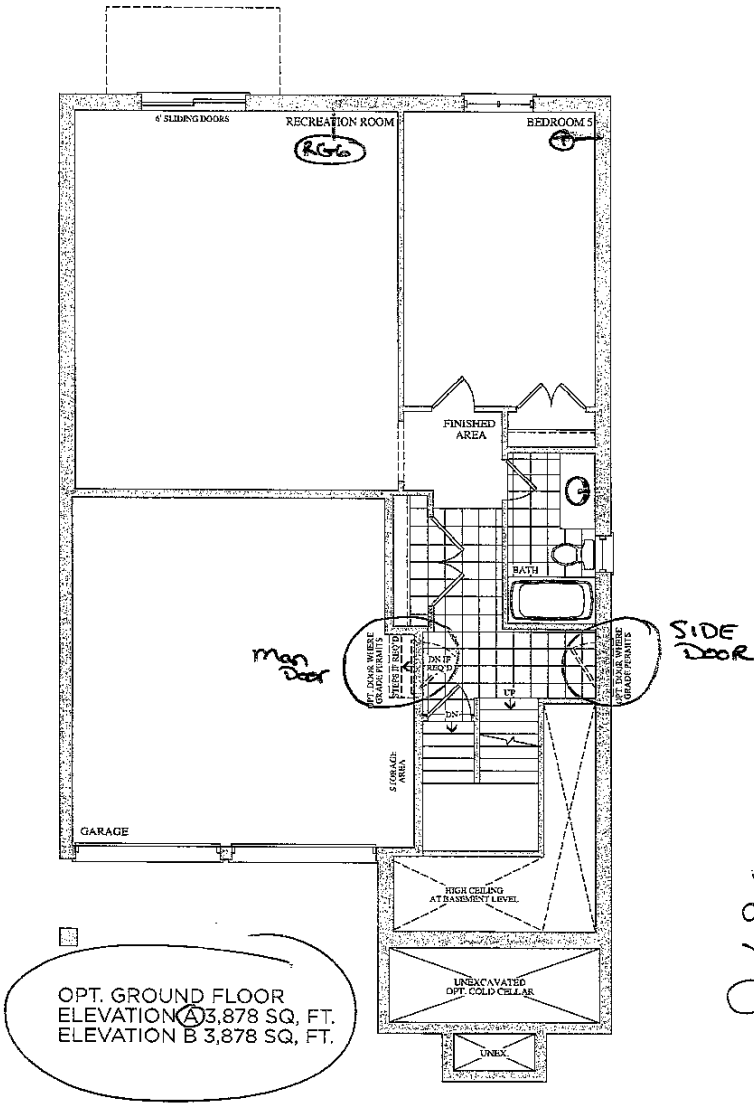

Lot 35
June 14, 16
(3)

BSMNT WINDOWS
3x 30"x24"

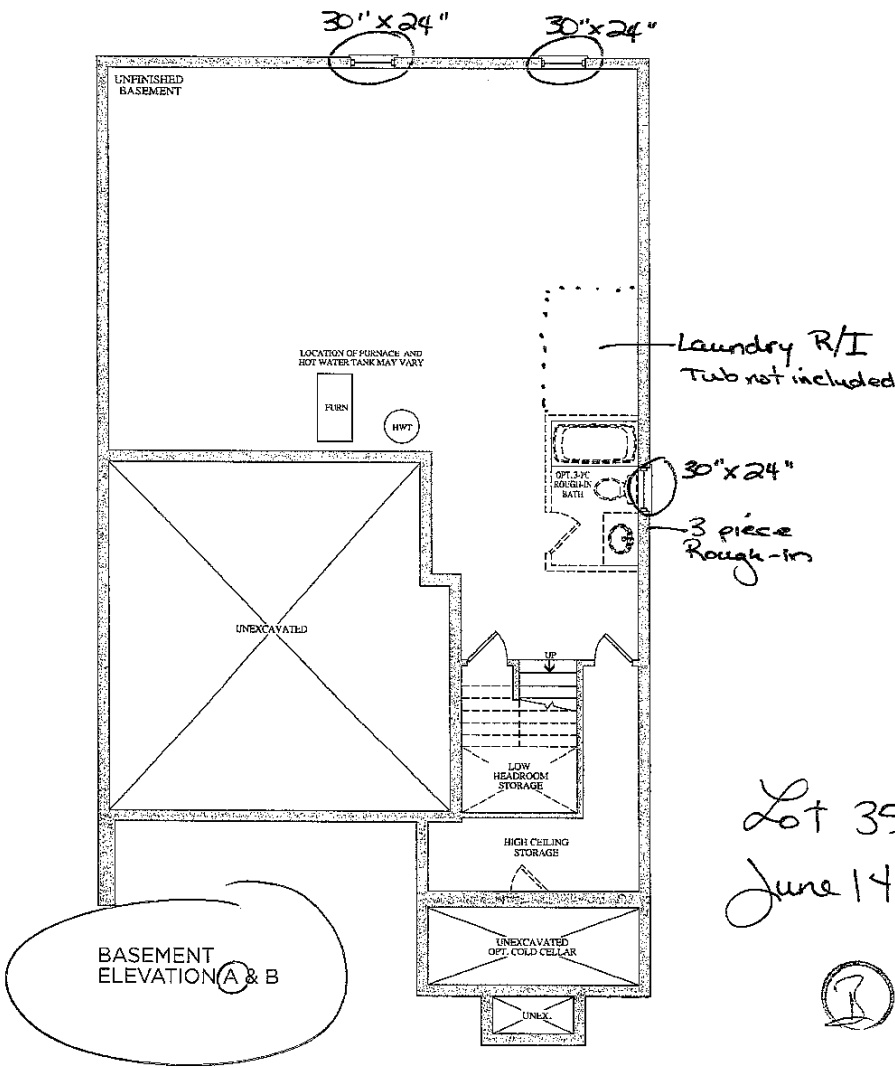



Stacey Carlete
Project Coordinator



Claude Azzopardi
Contracts Manager



Nancy Mc
Corporate C

35
Lot #



38.1 The Bizet			
Elevation	Circle One	A	2189.6 Square Feet
		B	2186.7 Square Feet
Optional Layouts	Circle All that Apply		

38.2 The Ravel			
Elevation	Circle One	A	2271.5 Square Feet
		B	2273.7 Square Feet
Optional Layouts	Circle All that Apply		

38.3 The Haydn			
Elevation	Circle One	A	2394.5 Square Feet
		B	2388.3 Square Feet
Optional Layouts	Circle All that Apply		

38.4 The Vivaldi			
Elevation	Circle One	A	2459.1 Square Feet
		B	2459.1 Square Feet
Optional Layouts	Circle All that Apply		

38.5 The Handel			
Elevation	Circle One	A	2549.2 Square Feet
		B	2554.7 Square Feet
Optional Layouts	Circle All that Apply		

38.9 The Puccini			
Elevation	Circle One	A	3628.0 Square Feet
		B	3634.7 Square Feet
Optional Layouts	Circle All that Apply	GFA1	GROUND FLOOR Optional Alternative Layout

38.6 The Scarlatti			
Elevation	Circle One	A	3521.1 Square Feet
		B	3508.1 Square Feet
Optional Layouts	Circle All that Apply	GFA1	GROUND FLOOR Optional Alternative Layout

38.7 The Schubert			
Elevation	Circle One	A	3593.8 Square Feet
		B	3610.5 Square Feet
Optional Layouts	Circle All that Apply	GFA1	GROUND FLOOR Optional Alternative Layout
		SFA4	SECOND FLOOR Additional Bedroom

38.8 The Corelli			
Elevation	Circle One	A	3801.5 Square Feet
		B	3801.5 Square Feet
Optional Layouts	Circle All that Apply	GFA1	GROUND FLOOR Optional Alternative Layout
		SFA4	SECOND FLOOR Additional Bedroom w/ Ensuite

41.1 The Strauss			
Elevation	Circle One	A	2554.2 Square Feet
		B	2571.2 Square Feet
Optional Layouts	Circle All that Apply	SFA1	SECOND FLOOR Shower in Lieu of Tub B2

41.2 The Mozart			
Elevation	Circle One	A	2725.9 Square Feet
		B	2711.1 Square Feet
Optional Layouts	Circle All that Apply	SFA1	SECOND FLOOR Shower in Lieu of Tub B2

41.3 The Chopin			
Elevation	Circle One	A	2800.0 Square Feet
		B	2810.5 Square Feet
Optional Layouts	Circle All that Apply		

41.4 The Bach			
Elevation	Circle One	A	2894.4 Square Feet
		B	2894.5 Square Feet
Optional Layouts	Circle All that Apply		

41.5 The Brahms			
Elevation	Circle One	A	3948.1 Square Feet
		B	3949.1 Square Feet
Optional Layouts	Circle All that Apply	GFA1	GROUND FLOOR Optional Alternative Layout
		SFA2	SECOND FLOOR Shower in Lieu of Tub B4
Optional Layouts	Circle All that Apply	SFA3	SECOND FLOOR Optional Laundry Layout

41.6 The Verdi			
Elevation	Circle One	A	3862.5 Square Feet
		B	3866.4 Square Feet
Optional Layouts	Circle All that Apply	GFA1	GROUND FLOOR Optional Alternative Layout
		SFA3	SECOND FLOOR Optional Laundry Layout
Optional Layouts	Circle All that Apply		

Lot 35
June 14, 16

