

Brampton Encore - 37 - 1 - 38-6 Elev.B SCARLATTI

CENTRAL VAC AND WIRING

Inv.607	1 - FAMILY ROOM: INSTALL CONDUIT PIPE- FOR TELEVISION- MUST SPECIFY LOCATION AND TERMINATION POINT, ABOVE FIREPLACE. SEE SKETCH
Line7468	Note:
27Jun16 / 20Sep16	
Inv.607	1 - ATTIC: INSTALL CONDUIT PIPE- FROM ATTIC TO ELECTRICAL PANEL- MUST SPECIFY LOCATION AND TERMINATION POINT, NEAR FRONT OF HOUSE
Line7470	Note:
27Jun16 / 20Sep16	

ELECTRICAL

Inv.607	1 - TELEPHONE AND CABLE ROUGH-IN LOCATIONS
Line7467	Note:
27Jun16 / 20Sep16	
Inv.607	1 - FAMILY ROOM: INSTALL 110V WALL RECEPTACLE ON DEDICATED CIRCUIT - ABOVE FIREPLACE. SEE SKETCH
Line7469	Note:
27Jun16 / 20Sep16	
Inv.607	1 - LIVING ROOM: INSTALL ADDITIONAL STANDARD FIXTURE WITH SWITCH - SEE SKETCH
Line7474	Note:
27Jun16 / 20Sep16	
Inv.607	4 - EXTERIOR: INSTALL FOUR (X4) POT LIGHT: 4 INCH LINE VOLTAGE POT LIGHT - (EXTERIOR) -EACH. SEE SKETCH
Line7475	Note:
27Jun16 / 20Sep16	

EXTERIOR COLOURS

Inv.607	1 - EXTERIOR COLOUR PACKAGE 8
Line11538	Note:
27Jun16 / 20Sep16	

FORMING

Inv.607	1 - EXTERIOR: INSTALL SIDE DOOR- HOME TO EXTERIOR- AS PER PLAN AND GRADE PERMITTING
Line7477	Note:
27Jun16 / 20Sep16	

FRAMING

Inv.607	1 - GARAGE: INSTALL MANDOOR - GARAGE TO HOUSE- AS PER PLAN AND GRADE PERMITTING
Line7476	Note: GIVEN IN AGREEMENT OF PURCHASE AND SALE
27Jun16 / 20Sep16	

HVAC

Inv.607	1 - KITCHEN: INSTALL GAS LINE ROUGH - MAIN FLOOR - (3 STOREY MODELS), FOR STOVE
Line7481	Note:
27Jun16 / 20Sep16	

MISC.

Brampton Encore - 37 - 1 - 38-6 Elev.B SCARLATTI

Inv.607	1 - BONUS PACKAGE: \$10,000.00 (INCLUDING TAXES) WORTH OF UPGRADES FROM GOLD PARK HOMES DÉCOR CENTRE IS BEING APPLIED TOWARD THE STRUCTURAL APPOINTMENT. PURCHASER HAS A REMAINING AMOUNT OF \$00 (INCLUDING TAXES) TO BE USED TOWARD THE COLOUR APPOINTMENT
Line7498	Note:
27Jun16 / 20Sep16	
Inv.607	1 - Purchaser has attended a Structural appointment at the Decor Centre & has DECLINED any additional upgrades and accepts and acknowledges that there will be no further structural changes/additions/deletions to be made upon signing on June 27, 2016
Line7499	Note:
27Jun16 / 20Sep16	
Inv.607	1 - Purchasers are aware & accepts that ANY changes made to upgrades after signing this Purchasers Extra Form are subject to a minimum administration fee of \$500. PLUS a 10% holdback fee
Line7500	Note:
27Jun16 / 20Sep16	

PLUMBING



Inv.607	1 - KITCHEN: INSTALL ROUGH-IN - WATERLINE FOR FRIDGE
Line7486	Note:
27Jun16 / 20Sep16	
Inv.607	1 - BASEMENT: INSTALL ROUGH-IN - 3PC BASEMENT ROUGH-IN, AS PER PLAN
Line7487	Note:
27Jun16 / 20Sep16	
Inv.607	1 - GARAGE: INSTALL HOSE BIB - STANDARD TO UPGRADED WITH HOT AND COLD WATER VALVE. FOR THE HOSE BIB IN GARAGE.
Line7488	Note: REAR HOSE BIB TO REMAIN STANDARD
27Jun16 / 20Sep16	

WINDOWS - BASEMENT

Inv.607	1 - BASEMENT: INSTALL ONE (X1) BASEMENT WINDOWS - UPGRADE EXISTING BASEMENT WINDOW TO 53 INCH X 16 INCH - MAY REQUIRE INSTALLATION OF WINDOW WELL. SEE SKETCH
Line7479	Note:
27Jun16 / 20Sep16	
Inv.607	2 - BASEMENT: INSTALL TWO (X2) BASEMENT WINDOWS - UPGRADE EXISTING BASEMENT WINDOW TO 30 INCH X 24 INCH - MAY REQUIRE INSTALLATION OF WINDOW WELL. SEE SEKTCH
Line7480	Note:
27Jun16 / 20Sep16	


The Scarlatti 38' SERIES

Elevation A • 3,591 sq.ft. | Elevation B • 3,578 sq.ft.

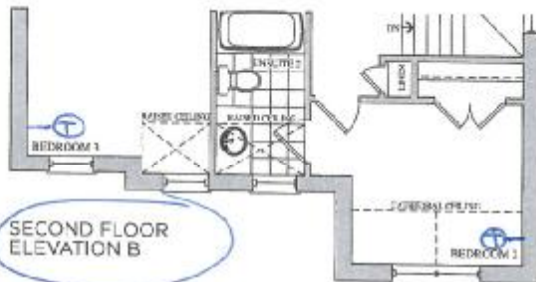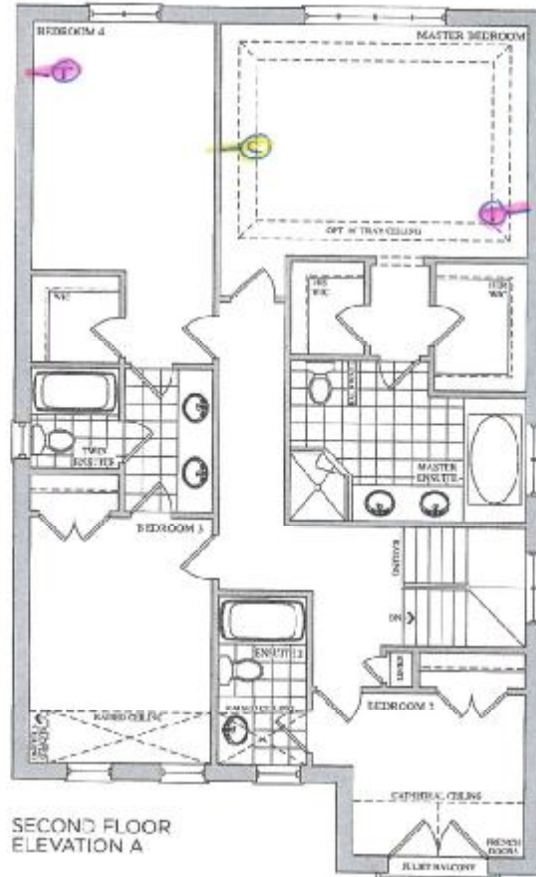


Lot 37
June 27, 16

RS

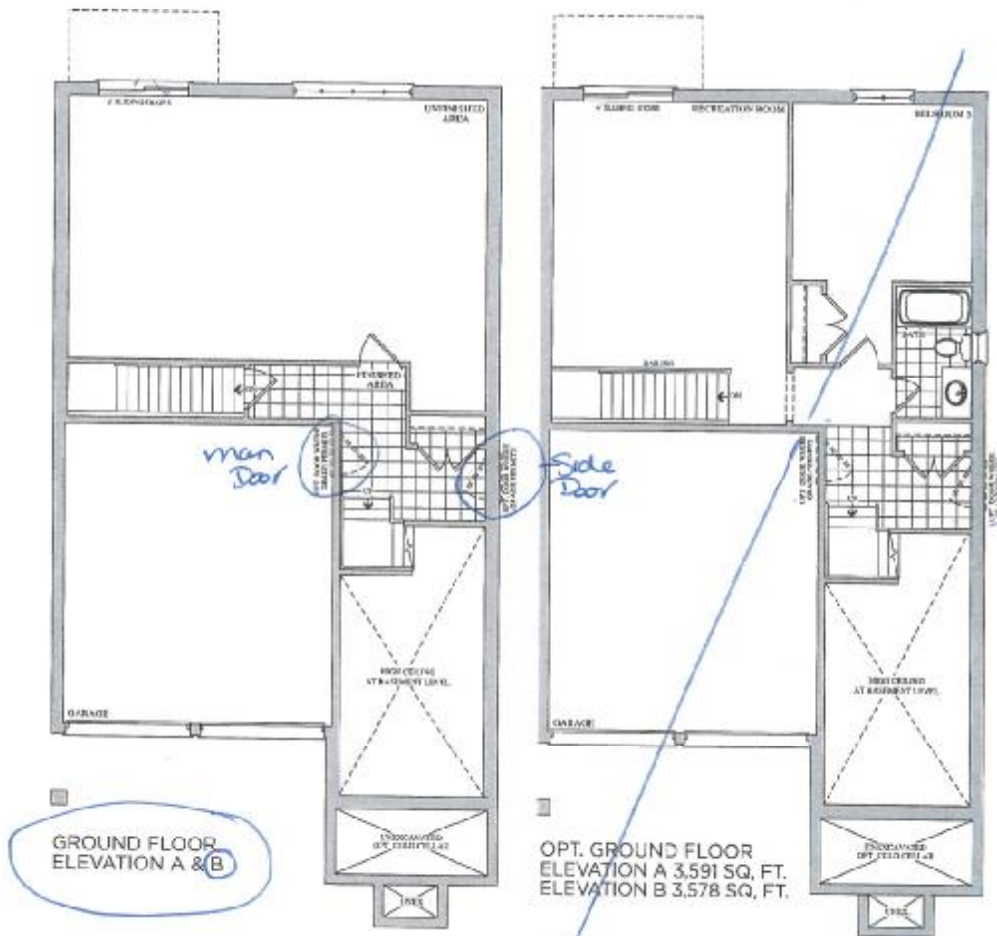

Lot 37
June 27, 16
B

BSMNT WINDOWS
1 x 53"x16"
2 x 30"x24"

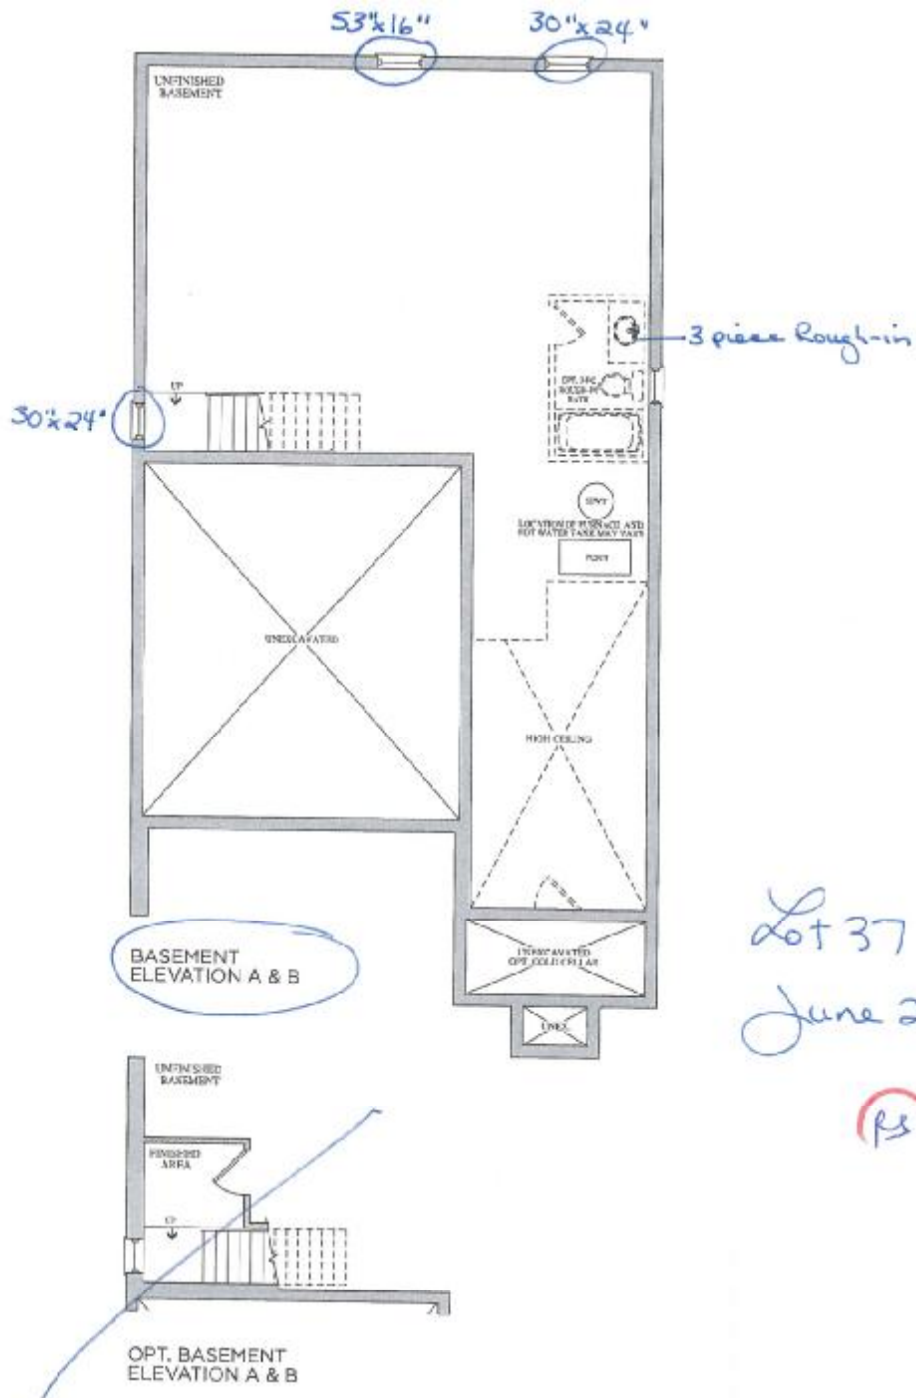

Lot 37
June 27, 16

Lot 37
June 27, 16

4



Elevation A • 2,943 sq.ft.



Elevation B • 2,930 sq.ft.

4 exterior
pot lights



GOLDPARK
HOMES

Prices, figures, illustrations, sizes, features and finishes are subject to change without notice. E & O.E. Areas and dimensions are approximate and actual usable floor space may vary from the stated area. It will be the reverse of the unit purchased. E. & O.E.