

CONSTRUCTION SUMMARY

115 - 1 - 38-3 Elev.A HAYDN

CENTRAL VAC AND WIRING

Inv.628	1 - TELEPHONE AND CABLE ROUGH-IN LOCATIONS
Line7933	Note:
6Jul16 / 26Sep16	
Inv.628	1 - FAMILY ROOM: INSTALL CONDUIT PIPE- FOR TELEVISION- ABOVE FIREPLACE, SEE SKETCH
Line7934	Note:
6Jul16 / 26Sep16	

ELECTRICAL

Inv.628	1 - FAMILY ROOM: INSTALL 110V WALL RECEPTACLE ON DEDICATED CIRCUIT - ABOVE FIREPLACE FAN KIT -SEE SKETCH
Line7935	Note:
6Jul16 / 26Sep16	
Inv.628	5 - EXTERIOR: INSTALL FIVE (X5) POT LIGHT: 4 INCH LINE VOLTAGE POT LIGHT - (EXTERIOR) -EACH. SEE SKETCH
Line7936	Note:
6Jul16 / 26Sep16	
Inv.628	1 - KITCHEN: INSTALL KITCHEN CABINET STRIP VALANCE LIGHTS (UNDER CABINETS) - ROUGH - IN - DOES NOT INCLUDE (AND REQUIRES) KITCHEN UPGRADE PRICING
Line7940	Note:
6Jul16 / 26Sep16	

EXTERIOR COLOURS

Inv.628	1 - EXTERIOR COLOUR PACKAGE 2
Line11995	Note:
6Jul16 / 26Sep16	

FORMING

Inv.628	1 - EXTERIOR: INSTALL SIDE DOOR- HOME TO EXTERIOR- AS PER PLAN AND GRADE PERMITTING
Line7938	Note: YES GRADING DOES PERMIT BASED ON SITING DATED AUGUST 2, 2016
6Jul16 / 26Sep16	

FRAMING

Inv.628	1 - GARAGE: INSTALL MANDOOR - GARAGE TO HOUSE- AS PER PLAN AND GRADE PERMITTING
Line7937	Note: GIVEN IN AGREEMENT OF PURCHASE AND SALE
6Jul16 / 26Sep16 YES GRADING DOES PERMIT BASED ON SITING DATED AUGUST 2, 2016	

MISC.

Inv.628	1 - BONUS PACKAGE: \$6570.95 (INCLUDING TAXES) WORTH OF UPGRADES FROM GOLD PARK HOMES DÉCOR CENTRE IS BEING APPLIED TOWARD THE STRUCTURAL APPOINTMENT. PURCHASER HAS A REMAINING AMOUNT OF \$3429.05 (INCLUDING TAXES) TO BE USED TOWARD THE COLOUR APPOINTMENT.
Line7941	Note:
6Jul16 / 26Sep16	

CONSTRUCTION SUMMARY

115 - 1 - 38-3 Elev.A HAYDN

Inv.628	1 - Purchaser has attended a Structural appointment at the Decor Centre & has DECLINED any additional upgrades and accpets and acknowledges that there will be no further structural changes/additions/deletions to be made upon signing on July 6, 2016
Line7942	Note:
6Jul16 / 26Sep16	
Inv.628	1 - Purchasers are aware & accepts that ANY changes made to upgrades after signing this Purchasers Extra Form are subject to a minimum administration fee of \$500. PLUS a 10% holdback fee
Line7943	Note:
6Jul16 / 26Sep16	

PLUMBING


Inv.628	1 - BASEMENT: INSTALL ROUGH-IN - 3PC BASEMENT ROUGH-IN, AS PER PLAN
Line7939	Note:
6Jul16 / 26Sep16	

encore
BRAMPTON

Telephone — (T)
Cable — (C)
Electrical — (E)

The Haydn 38' SERIES

Elevation A • 2,454 sq.ft. | Elevation B • 2,448 sq.ft.

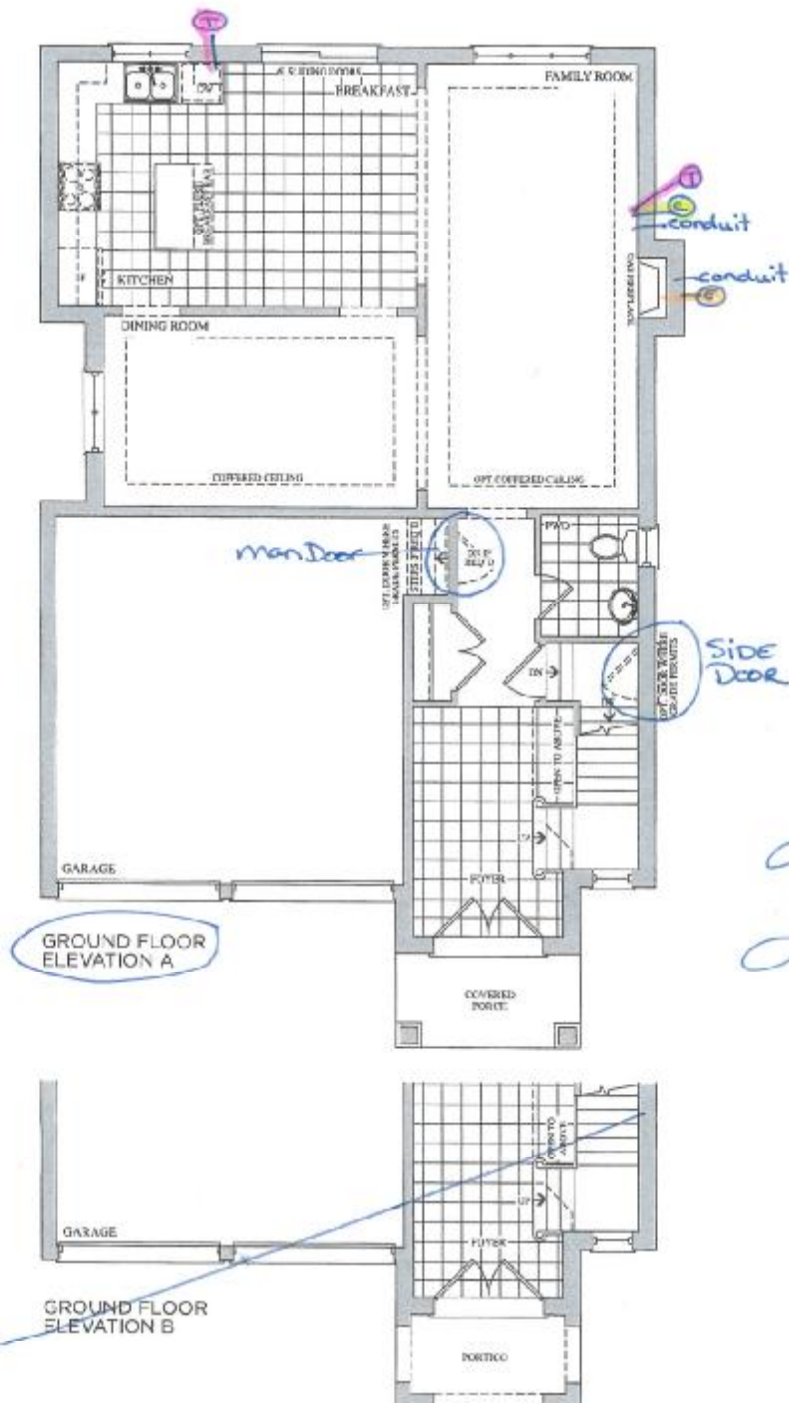

Prices, figures, illustrations, sizes, features and finishes are subject to change without notice. L.S.O.E. Areas and dimensions are approximate and actual usable floor space may vary from the stated area. Layout may be reverse of the one illustrated. R. & O.E.



GOLDPARK
HOMES

encore
BRAMPTON

Telephone — (P)
Cable — (C)

The Haydn 38' SERIES

Elevation A • 2,454 sq.ft. | Elevation B • 2,448 sq.ft.

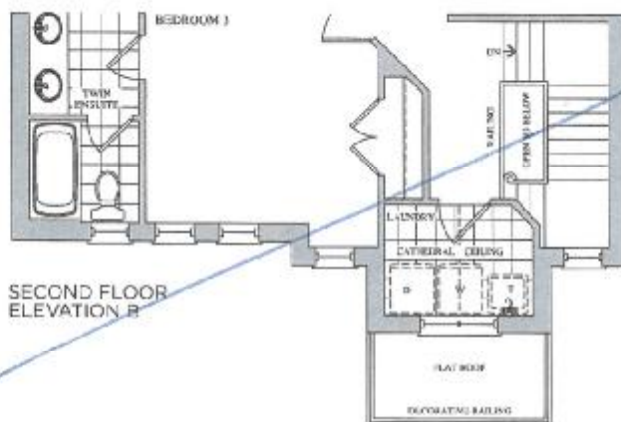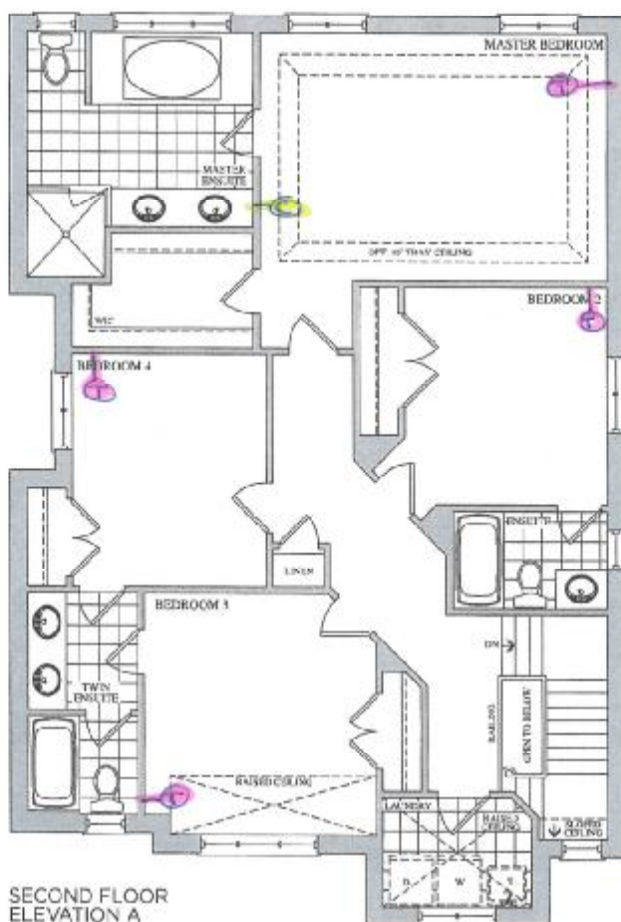

Lot 115
July 8, 16

[Handwritten signature]

Prices, figures, illustrations, sizes, features and floor plans are subject to change without notice. E.S.O.C. Areas and dimensions are approximate and actual usable floor space may vary from the stated area. Layout may be different if the unit is customized. E.S.O.C.

GOLDPARK
HOMES

GOLDpark
HOMES

Lot 115


5 exterior pot lights,
as per plan

July 6, 16



The Haydn

Elevation A • 2,454 sq.ft.

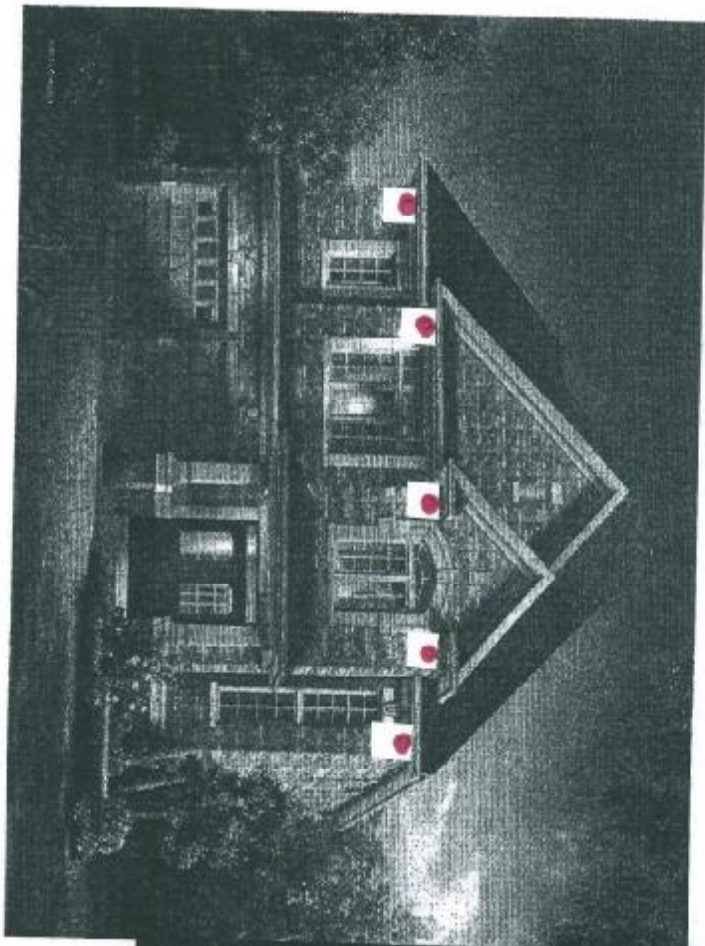

 **GOLDPARK**
H O M E S

1st
Apr 1



Stacey Corlete
Project Coordinator



Claude Azzopardi
Contracts Manager



Nancy Mc
Corporate C

115
Lot #



38.1 The Bizet			
Elevation	Circle One	A	2189.6 Square Feet
		B	2186.7 Square Feet
Optional Layouts	Circle All that Apply		

38.2 The Ravel			
Elevation	Circle One	A	2271.5 Square Feet
		B	2275.7 Square Feet
Optional Layouts	Circle All that Apply		

38.3 The Haydn			
Elevation	Circle One	A	2394.5 Square Feet
		B	2388.3 Square Feet
Optional Layouts	Circle All that Apply		

38.4 The Vivaldi			
Elevation	Circle One	A	2459.1 Square Feet
		B	2459.1 Square Feet
Optional Layouts	Circle All that Apply		

38.5 The Handel			
Elevation	Circle One	A	2549.2 Square Feet
		B	2554.7 Square Feet
Optional Layouts	Circle All that Apply		

38.9 The Puccini			
Elevation	Circle One	A	3628.0 Square Feet
		B	3634.7 Square Feet
Optional Layouts	Circle All that Apply	GFA1	GROUND FLOOR Optional Alternative Layout

38.6 The Scarlatti			
Elevation	Circle One	A	3521.1 Square Feet
		B	3508.1 Square Feet
Optional Layouts	Circle All that Apply	GFA1	GROUND FLOOR Optional Alternative Layout

38.7 The Schubert			
Elevation	Circle One	A	3593.8 Square Feet
		B	3610.5 Square Feet
Optional Layouts	Circle All that Apply	GFA1	GROUND FLOOR Optional Alternative Layout
		SFA4	SECOND FLOOR Additional Bedroom
Optional Layouts	Circle All that Apply		

38.8 The Corelli			
Elevation	Circle One	A	3801.5 Square Feet
		B	3801.5 Square Feet
Optional Layouts	Circle All that Apply	GFA1	GROUND FLOOR Optional Alternative Layout
		SFA4	SECOND FLOOR Additional Bedroom w/ Ensuite
Optional Layouts	Circle All that Apply		

41.1 The Strauss			
Elevation	Circle One	A	2554.2 Square Feet
		B	2571.2 Square Feet
Optional Layouts	Circle All that Apply	SFA1	SECOND FLOOR Shower in Lieu of Tub B2

41.2 The Mozart			
Elevation	Circle One	A	2725.9 Square Feet
		B	2711.1 Square Feet
Optional Layouts	Circle All that Apply	SFA1	SECOND FLOOR Shower in Lieu of Tub B2

41.3 The Chopin			
Elevation	Circle One	A	2800.0 Square Feet
		B	2810.5 Square Feet
Optional Layouts	Circle All that Apply		

41.4 The Bach			
Elevation	Circle One	A	2894.4 Square Feet
		B	2894.5 Square Feet
Optional Layouts	Circle All that Apply		

41.5 The Brahms			
Elevation	Circle One	A	3548.1 Square Feet
		B	3549.1 Square Feet
Optional Layouts	Circle All that Apply	GFA1	GROUND FLOOR Optional Alternative Layout
		SFA2	SECOND FLOOR Shower in Lieu of Tub B4
Optional Layouts	Circle All that Apply	SFA3	SECOND FLOOR Optional Laundry Layout

41.6 The Verdi			
Elevation	Circle One	A	3862.5 Square Feet
		B	3866.4 Square Feet
Optional Layouts	Circle All that Apply	GFA1	GROUND FLOOR Optional Alternative Layout
		SFA3	SECOND FLOOR Optional Laundry Layout
Optional Layouts	Circle All that Apply		

July 6, 18