

* Structural *
CONSTRUCTION SUMMARY

118 - 1 - 38-1 Elev.B BIZET

ELECTRICAL

Inv.487	1 - TELEPHONE AND CABLE ROUGH-IN LOCATION SKETCH
Line5846	Note:
9May16 / 20May16	
Inv.487	1 - EXTERIOR: INSTALL ADDITIONAL FESTIVE SOFFIT PLUG ON SAME SWITCH AS BUILDER'S STANDARD SOFFIT PLUG FOR EXTERIOR HOLIDAY LIGHTS - SEE SKETCH FOR LOCATION:
Line5849	Note:
9May16 / 20May16	
Inv.487	1 - EXTERIOR: INSTALL GFI DUPLEX OUTLET WITH COVER - TO GO ON THE EXTERIOR WALL OUTSIDE OF BED #3 WINDOW, WHERE THERE IS THE DECORATIVE RAILING. SEE SKETCH FOR LOCATION.
Line5850	Note:
9May16 / 20May16	

EXTERIOR COLOURS

Inv.509	1 - EXTERIOR COLOUR PACKAGE 1
Line6144	Note:
20May16 / 20May16	

FORMING

Inv.487	1 - EXTERIOR: INSTALL SIDE DOOR- HOME TO EXTERIOR- AS PER PLAN AND GRADE PERMITTING
Line5847	Note:
9May16 / 20May16	

FRAMING

Inv.487	1 - FAMILY ROOM: INSTALL OPTIONAL COFFERED CEILING - FAMILY ROOM (PER ROOM AS PER PLAN)
Line5848	Note:
9May16 / 20May16	

MISC.

Inv.487	1 - Purchasers are aware & accepts that ANY changes made to upgrades after signing this Purchasers Extra Form are subject to a minimum administration fee of \$500. PLUS a 10% holdback fee
Line5853	Note:
9May16 / 20May16	
Inv.487	1 - BONUS PACKAGE: \$5130.20 (INCLUDING TAXES) WORTH OF UPGRADES FROM GOLD PARK HOMES DÉCOR CENTRE IS BEING APPLIED TOWARD THE STRUCTURAL APPOINTMENT. PURCHASER HAS A REMAINING AMOUNT OF \$4869.80 (INCLUDING TAXES) TO BE USED TOWARD THE COLOUR APPOINTMENT
Line5851	Note:
9May16 / 20May16	
Inv.487	1 - Purchaser has attended a Structural appointment at the Decor Centre & has DECLINED any additional upgrades and accepts and acknowledges that there will be no further structural changes/additions/deletions to be made upon signing on May 9, 2016
Line5852	Note:
9May16 / 20May16	

WINDOWS AND DOORS



CONSTRUCTION SUMMARY


118 - 1 - 38-1 Elev.B BIZET

Inv.487	1 - MAN DOOR GARAGE TO HOUSE - OPTIONAL - IF GRADE PERMITS
Line6138	Note: As per APS
9May16 / 20May16	

encore
BRAMPTON

The Bizet 38' SERIES

Elevation A • 2,234 sq.ft. | Elevation B • 2,222 sq.ft.

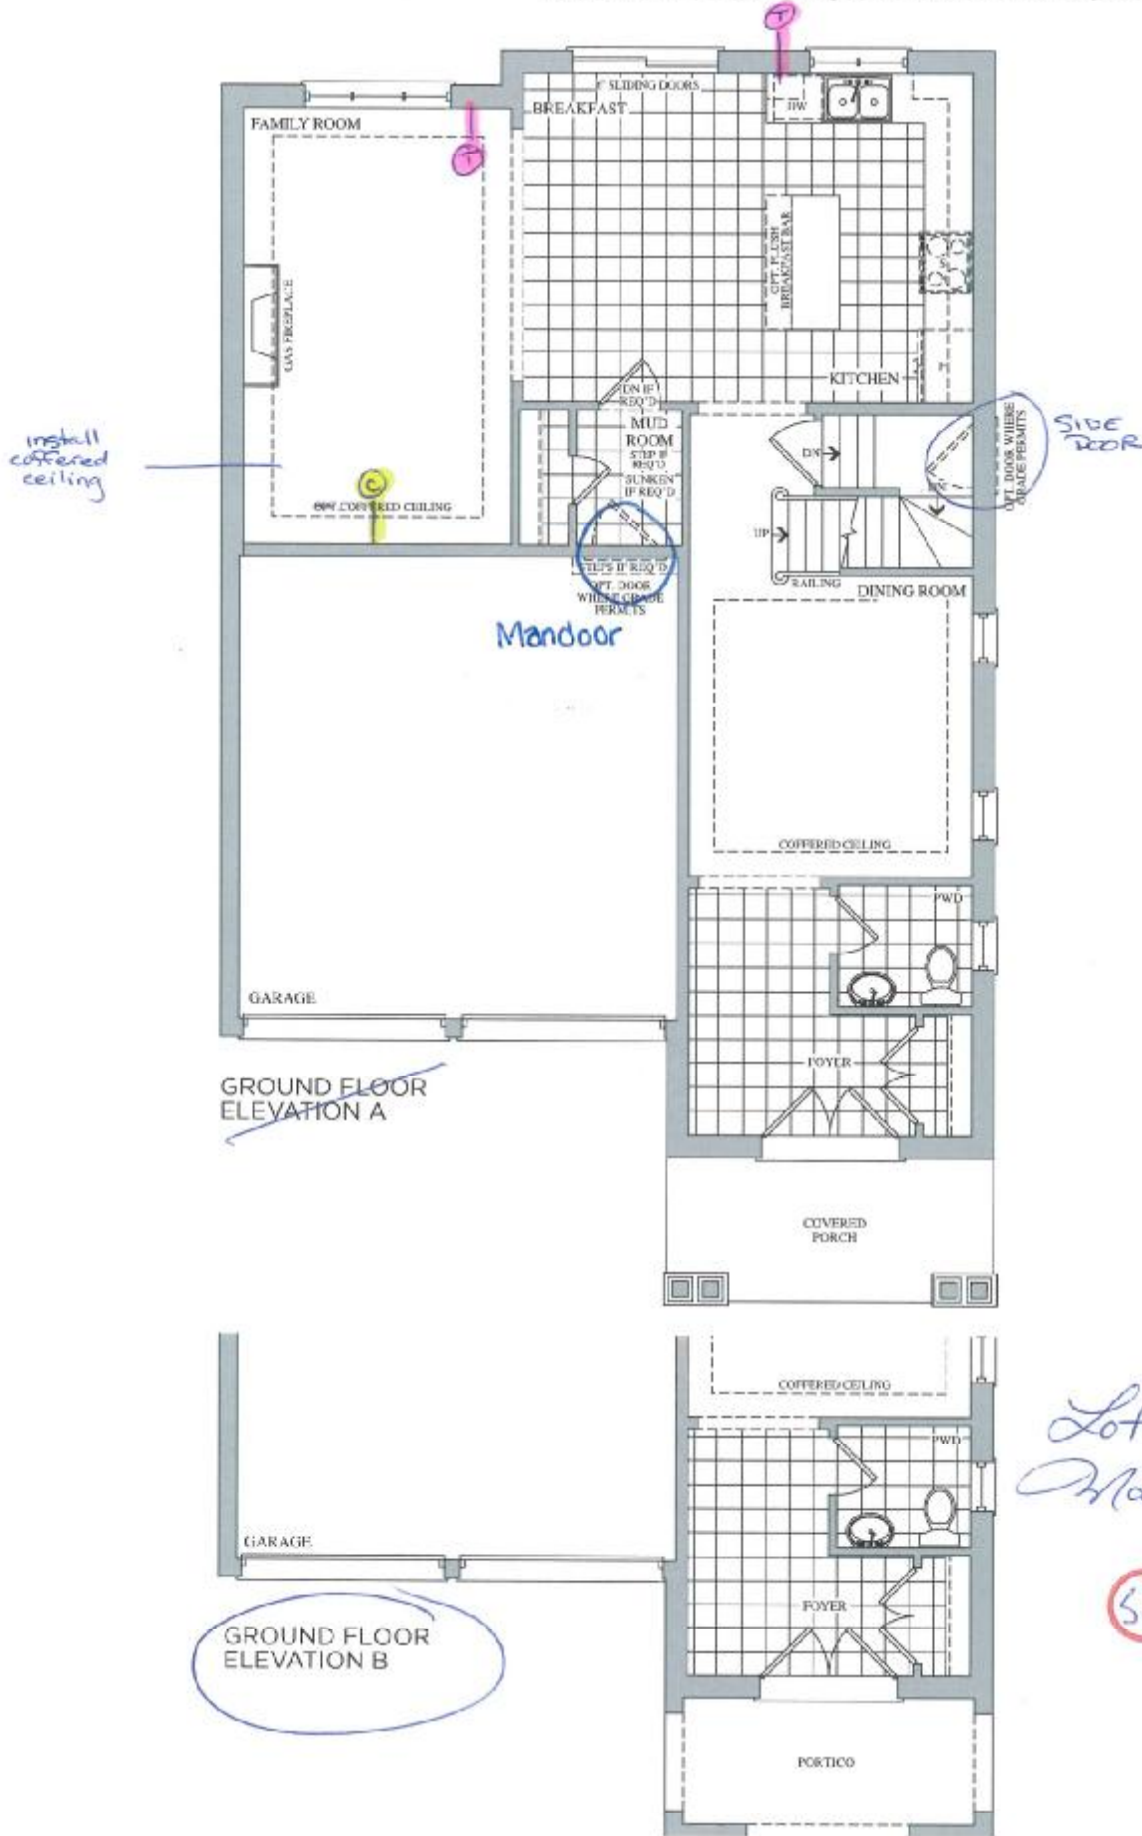



Prices, figures, illustrations, sizes, features and finishes are subject to change without notice. E. & O.E. Areas and dimensions are approximate and actual usable floor space may vary from the stated area. Layout may be reverse of the unit purchased. E. & O.E.

GOLDPARK
HOMES

Telephone — (T)
Cable — (C)
Electrical — GFI

The Bizet 38' SERIES

Elevation A • 2,234 sq.ft. | Elevation B • 2,222 sq.ft.

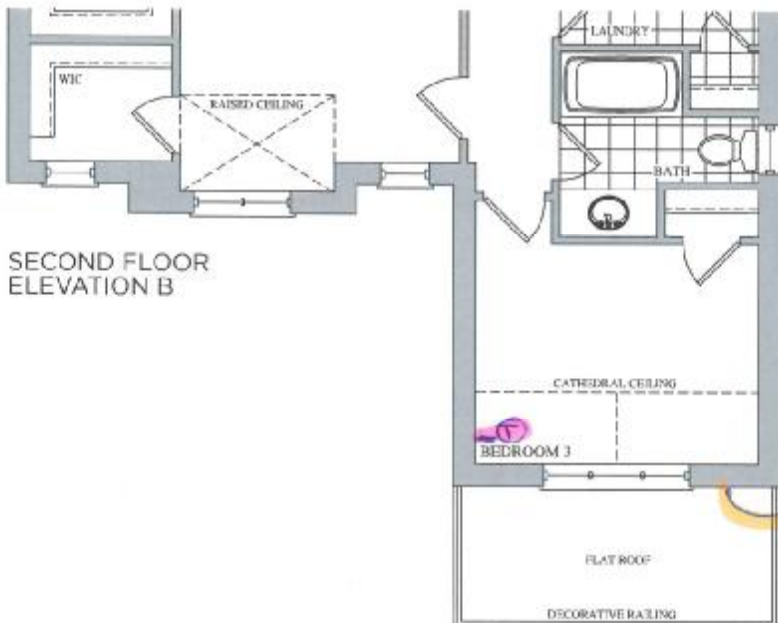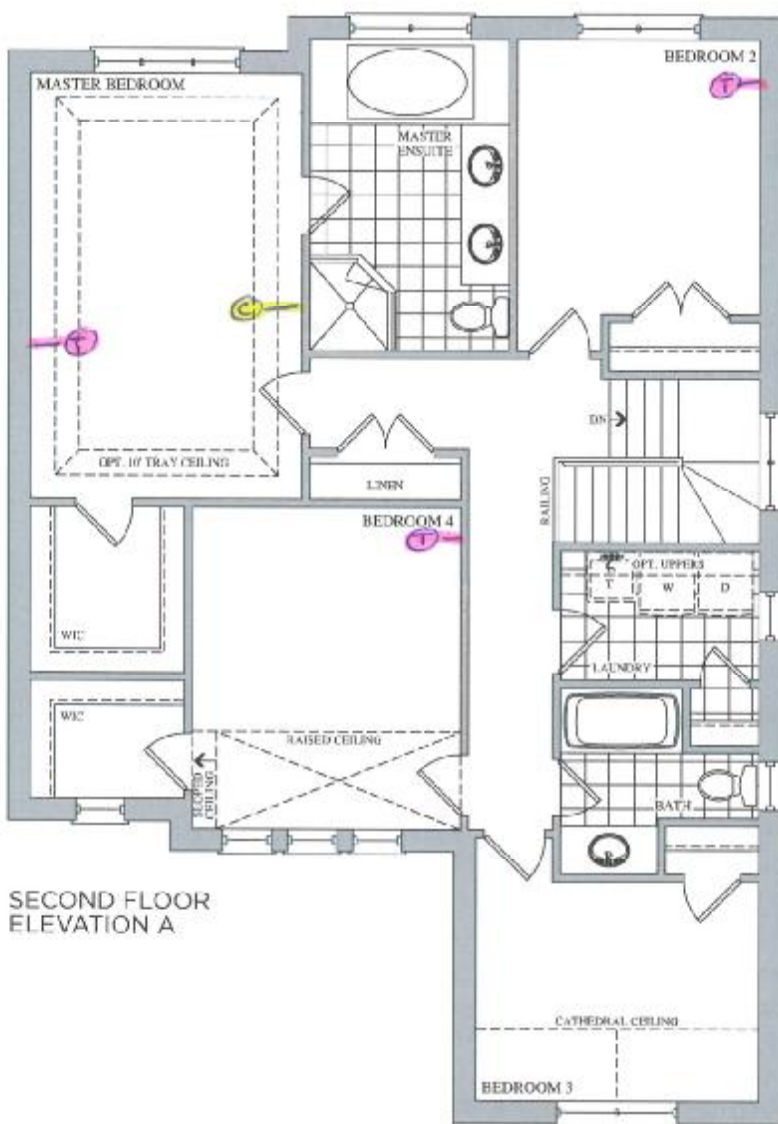

Lot 118
May 9, 2016


S.S

Exterior
GFI

Prices, figures, illustrations, sizes, features and finishes are subject to change without notice. E.&O.E. Areas and dimensions are approximate and actual usable floor space may vary from the stated area. Layout may be reverse of the unit purchased. E. & O.E.

The
Bizet
38' SERIES

Elevation A • 2,234 sq.ft. | Elevation B • 2,222 sq.ft.

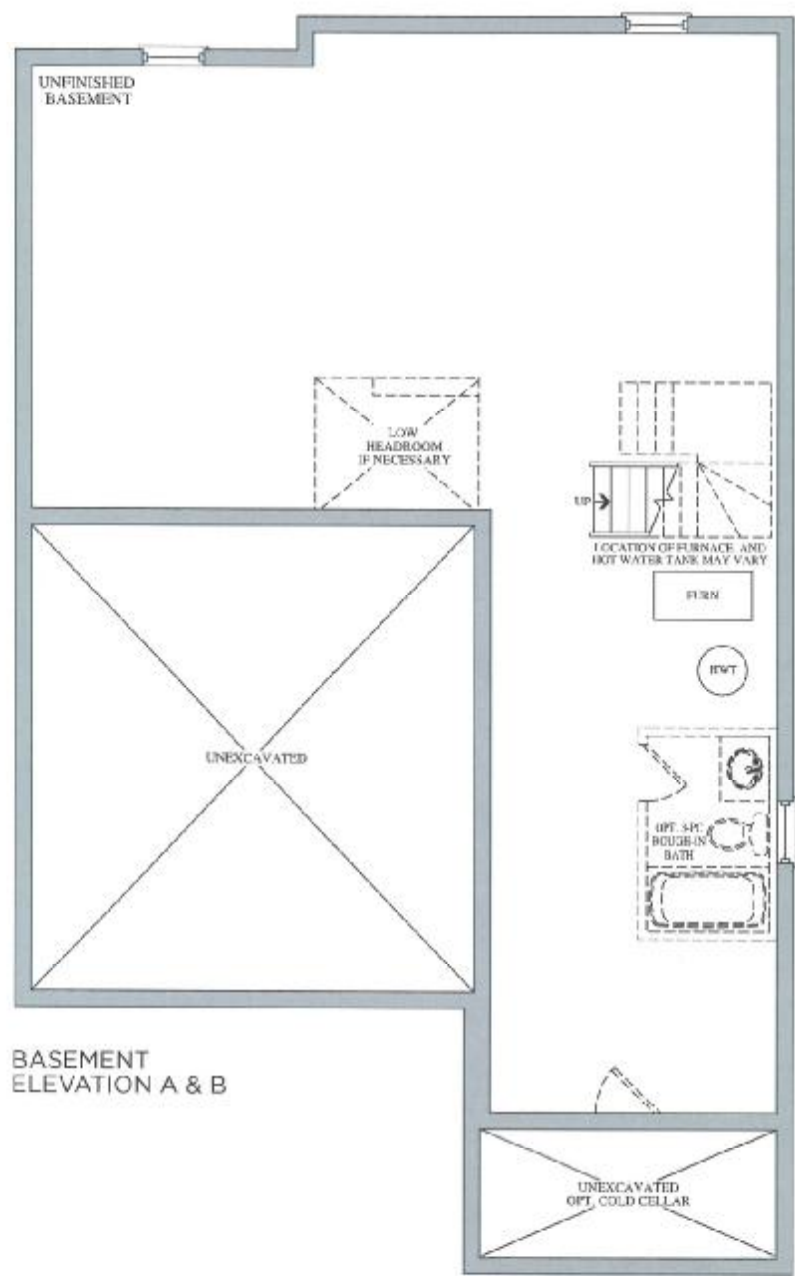

Lot 118
May 9, 2016


55

Electrical - 0

encore
SHAMPTON

The Bizet

Elevation A • 2,234 sq.ft.

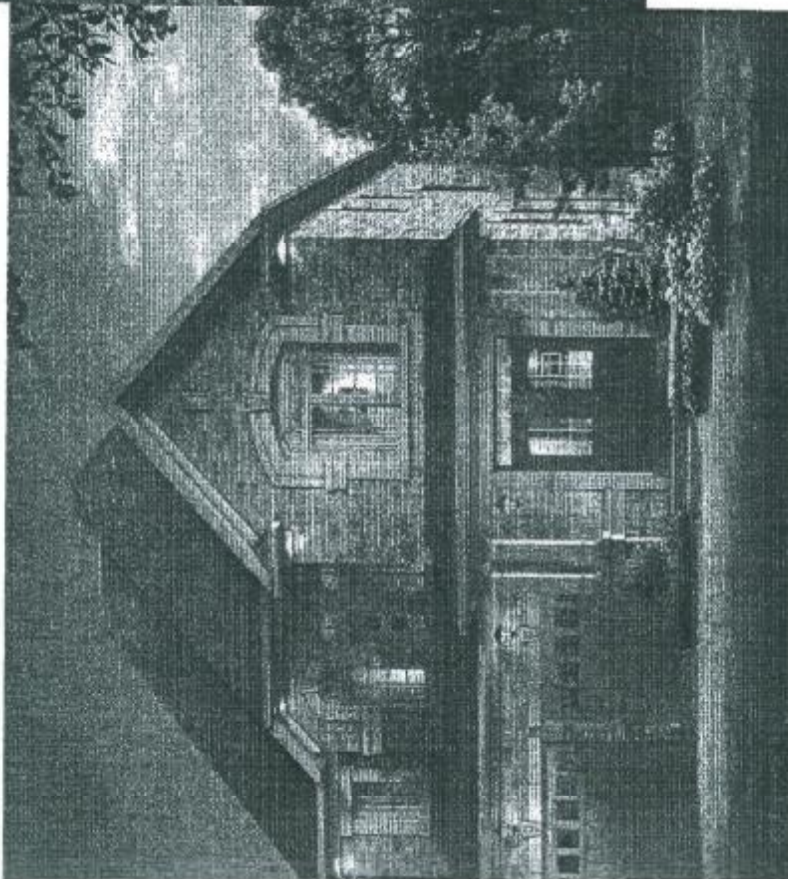

SCHEDULE 'E'

38'
SERIES

Elevation B • 2,222 sq.ft.

lot 118
Apr 3/16

May 9, 2016

SS

DARK
HOMES

VENDOR

PURCHASER

PURCHASER

SS



Stacey Corlete
Project Coordinator



Claude Azzopardi
Contracts Manager



Nancy McCorporate

118
Lot #



38.1 The Bizet			
Elevation	Circle One	A	2189.6 Square Feet
		B	2186.7 Square Feet
Optional Layouts	Circle All that Apply		

38.2 The Ravel			
Elevation	Circle One	A	2273.5 Square Feet
		B	2273.7 Square Feet
Optional Layouts	Circle All that Apply		

38.3 The Haydn			
Elevation	Circle One	A	2354.5 Square Feet
		B	2388.3 Square Feet
Optional Layouts	Circle All that Apply		

38.4 The Vivaldi			
Elevation	Circle One	A	2459.1 Square Feet
		B	2459.1 Square Feet
Optional Layouts	Circle All that Apply		

38.5 The Handel			
Elevation	Circle One	A	2548.2 Square Feet
		B	2554.7 Square Feet
Optional Layouts	Circle All that Apply		

38.9 The Puccini			
Elevation	Circle One	A	3628.0 Square Feet
		B	3634.7 Square Feet
Optional Layouts	Circle All that Apply	GFA1	GROUND FLOOR Optional Alternative Layout

38.6 The Scarlatti			
Elevation	Circle One	A	3521.1 Square Feet
		B	3508.1 Square Feet
Optional Layouts	Circle All that Apply	GFA1	GROUND FLOOR Optional Alternative Layout

38.7 The Schubert			
Elevation	Circle One	A	3593.8 Square Feet
		B	3610.5 Square Feet
Optional Layouts	Circle All that Apply	GFA1	GROUND FLOOR Optional Alternative Layout
		SFA4	SECOND FLOOR Additional Bedroom

38.8 The Corelli			
Elevation	Circle One	A	3601.5 Square Feet
		B	3601.5 Square Feet
Optional Layouts	Circle All that Apply	GFA1	GROUND FLOOR Optional Alternative Layout
		SFA4	SECOND FLOOR Additional Bedroom w/ Ensuite

41.1 The Strauss			
Elevation	Circle One	A	2554.2 Square Feet
		B	2571.2 Square Feet
Optional Layouts	Circle All that Apply	SFA1	SECOND FLOOR Shower in Lieu of Tub B2

41.2 The Mozart			
Elevation	Circle One	A	2725.9 Square Feet
		B	2711.1 Square Feet
Optional Layouts	Circle All that Apply	SFA1	SECOND FLOOR Shower in Lieu of Tub B2

41.3 The Chopin			
Elevation	Circle One	A	2600.0 Square Feet
		B	2610.5 Square Feet
Optional Layouts	Circle All that Apply		

41.4 The Bach			
Elevation	Circle One	A	2894.4 Square Feet
		B	2894.5 Square Feet
Optional Layouts	Circle All that Apply		

41.5 The Brahms			
Elevation	Circle One	A	3948.1 Square Feet
		B	3949.1 Square Feet
Optional Layouts	Circle All that Apply	GFA1	GROUND FLOOR Optional Alternative Layout
		SFA2	SECOND FLOOR Showers in Lieu of Tub B4
		SFA3	SECOND FLOOR Optional Laundry Layout

41.6 The Verdi			
Elevation	Circle One	A	3662.5 Square Feet
		B	3666.4 Square Feet
Optional Layouts	Circle All that Apply	GFA1	GROUND FLOOR Optional Alternative Layout
		SFA3	SECOND FLOOR Optional Laundry Layout

May 9, 16

55