

CONSTRUCTION SUMMARY

119 - 1 - 38-3 Elev.A HAYDN

CENTRAL VAC AND WIRING

Inv.555	1 - TELEPHONE AND CABLE ROUGH-IN LOCATIONS
Line7309	Note:
9Jun16 / 26Sep16	
Inv.555	1 - MASTER BEDROOM: INSTALL CAT 6 WIRING - UPGRADE AN OUTLET TO CAT 6- IN MASTER BEDROOM, SEE SKETCH
Line7310	Note:
9Jun16 / 26Sep16	
Inv.555	1 - KITCHEN: INSTALL VAC PAN UNDER KITCHEN SINK
Line7319	Note:
9Jun16 / 26Sep16	

EXTERIOR COLOURS

Inv.555	1 - EXTERIOR COLOUR PACKAGE 8
Line12000	Note:
9Jun16 / 26Sep16	

FORMING

Inv.555	1 - EXTERIOR: INSTALL SIDE DOOR- HOME TO EXTERIOR- AS PER PLAN AND GRADE PERMITTING
Line7312	Note: GRADE PERMITS PER SITING DATED AUGUST 2, 2016
9Jun16 / 26Sep16	

FRAMING

Inv.555	1 - GARAGE: ISNTALL MANDOOR - GARAGE TO HOUSE- AS PER PLAN AND GRADE PERMITTING
Line7311	Note: GIVEN IN AGREEMENT OF PURCHASE AND SALE
9Jun16 / 26Sep16 GRADE PERMITS PER SITING DATED AUGUST 2, 2016	
Inv.555	1 - FAMILY ROOM: INSTALL OPTIONAL COFFERED CEILING - FAMILY ROOM (PER ROOM AS PER PLAN)
Line7313	Note:
9Jun16 / 26Sep16	

HVAC

Inv.555	1 - KITCHEN: INSTALL GAS LINE ROUGH - MAIN FLOOR FOR STOVE
Line7315	Note:
9Jun16 / 26Sep16	

KITCHEN AND BATH CABINETRY

Inv.555	1 - KITCHEN: INSTALL VAC PAN UNDER KITCHEN SINK
Line11999	Note:
9Jun16 / 26Sep16	

MISC.

Inv.555	1 - BONUS PACKAGE: \$10305.60 (INCLUDING TAXES) WORTH OF UPGRADES FROM GOLD PARK HOMES DÉCOR CENTRE IS BEING APPLIED TOWARD THE STRUCTURAL APPOINTMENT. PURCHASER HAS A REMAINING AMOUNT OF \$4694.40 (INCLUDING TAXES) TO BE USED TOWARD THE COLOUR APPOINTMENT
Line7320	Note:
9Jun16 / 26Sep16	

CONSTRUCTION SUMMARY

119 - 1 - 38-3 Elev.A HAYDN

Inv.555	1 - Purchaser has attended a Structural appointment at the Decor Centre & has DECLINED any additional upgrades and accepts and acknowledges that there will be no further structural changes/additions/deletions to be made upon signing on June 21, 2016
Line7321	Note:
9Jun16 / 26Sep16	
Inv.555	1 - Purchasers are aware & accepts that ANY changes made to upgrades after signing this Purchasers Extra Form are subject to a minimum administration fee of \$500. PLUS a 10% holdback fee
Line7322	Note:
9Jun16 / 26Sep16	

PLUMBING

Inv.555	1 - KITCHEN: INSTALL: INSTALL ROUGH-IN - WATERLINE FOR FRIDGE
Line7316	Note:
9Jun16 / 26Sep16	
Inv.555	1 - BASEMENT: INSTALL ROUGH-IN - 3PC BASEMENT ROUGH-IN, AS PER PLAN
Line7317	Note:
9Jun16 / 26Sep16	
Inv.555	1 - BACK YARD: INSTALL HOSE BIB - STANDARD TO UPGRADED WITH HOT AND COLD WATER VALVE
Line7318	Note: GARAGE HOSE BIB TO REMAIN STANDARD
9Jun16 / 26Sep16	

WINDOWS - BASEMENT

Inv.555	1 - BASEMENT: INSTALL ONE (X1) BASEMENT WINDOWS - UPGRADE EXISTING BASEMENT WINDOW TO 30 INCH X 24 INCH - MAY REQUIRE INSTALLATION OF WINDOW WELL. SEE SKETCH
Line7314	Note:
9Jun16 / 26Sep16	


GOLDPARK
HOMES

encore
BRAMPTON


Telephone — (T)
Cable — (C)

The Haydn 38' SERIES

Elevation A • 2,454 sq.ft. | Elevation B • 2,448 sq.ft.

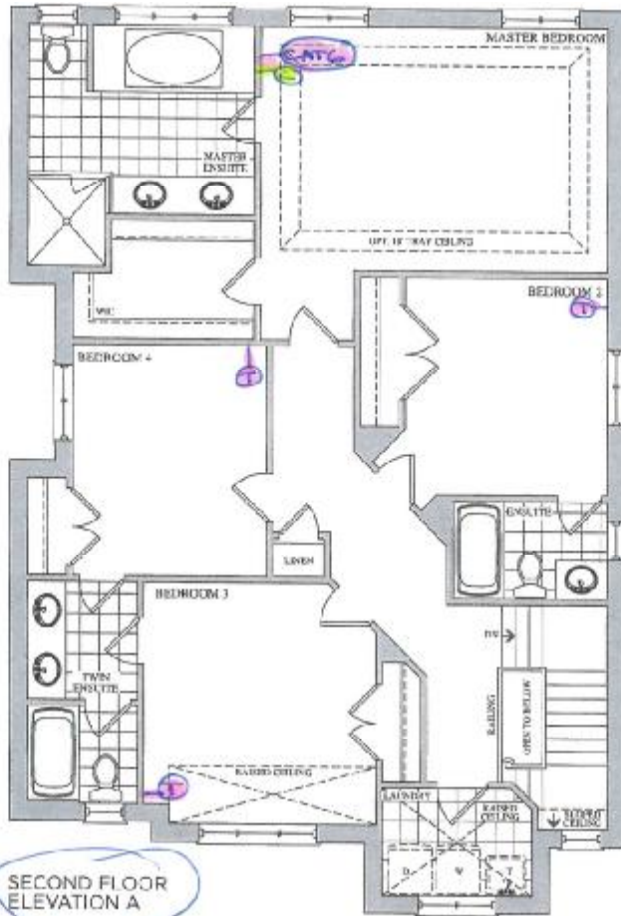

Lot 119
June 21, 16

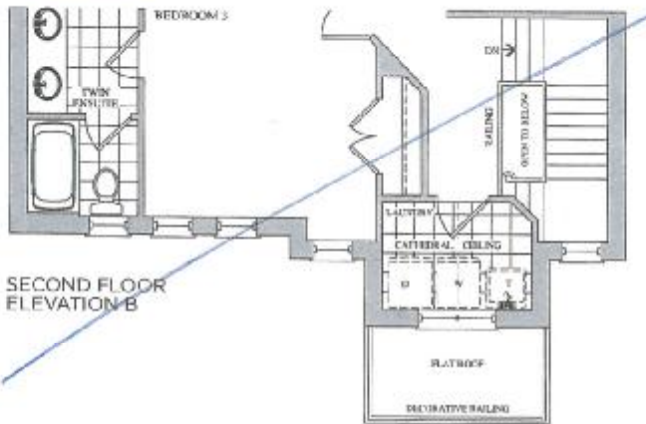



Prices, figures, illustrations, sizes, features and finishes are subject to change without notice. F.R.O.E. Areas and dimensions are approximate and actual. Sales floor space may vary from the stated area. Layout may be reverse of the unit purchased. S. & O.E.

GOLDPARK
HOMES

Elevation A • 2,454 sq.ft. | Elevation B • 2,448 sq.ft.

BSMNT WINDOWS
1 x 30" x 24"

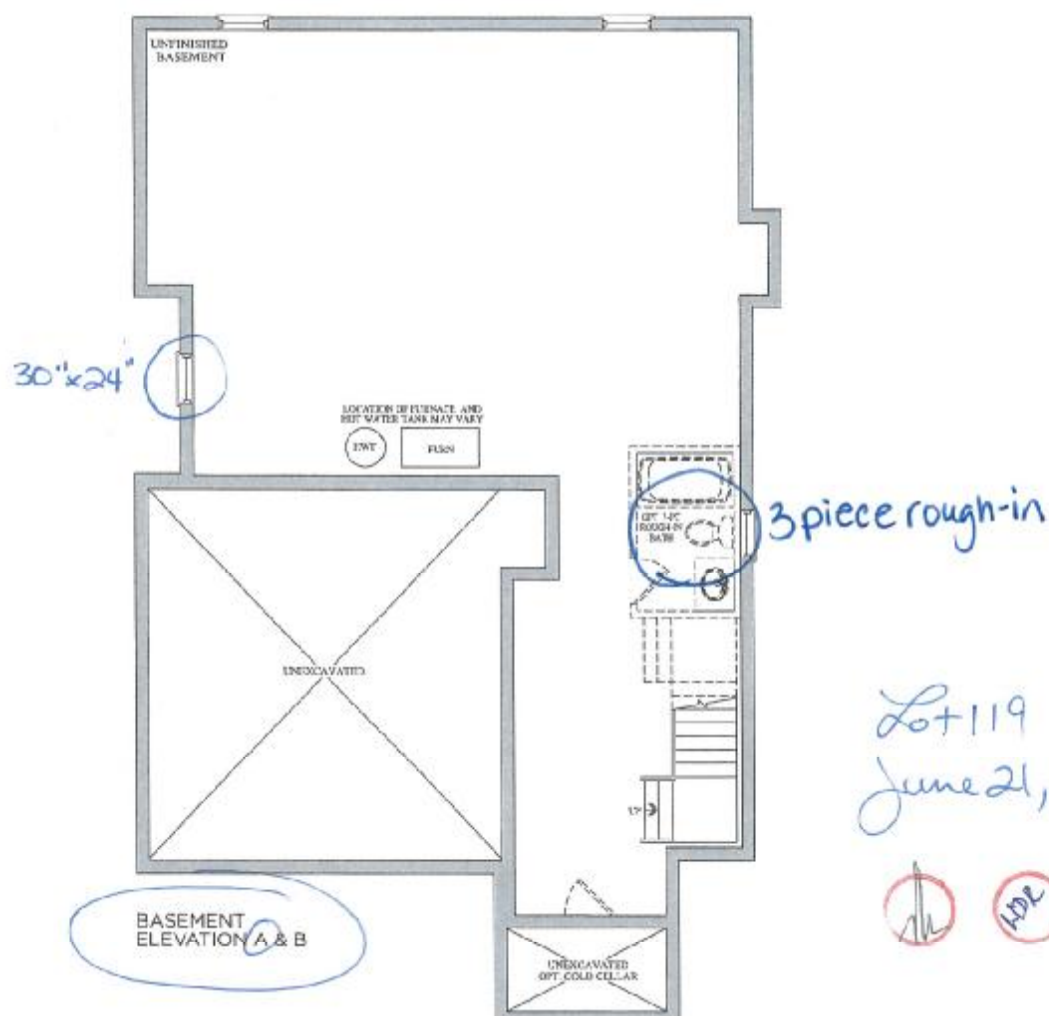

Lot 119
June 21, 16



402

Prices, figures, illustrations, sizes, features and finishes are subject to change without notice. E.R.O. E. Areas and dimensions are approximate and actual. Usable floor space may vary from the stated area. Layout may be reverse of the one illustrated. E. R. O.

GOLDPARK
HOMES



Stacey Carlete
Project Coordinator



Claude Azzopardi
Contracts Manager



Nancy Mc
Corporate C

119
Lot #



38.1 The Bizet			
Elevation	Circle One	A	2189.6 Square Feet
		B	2186.7 Square Feet
Optional Layouts	Circle All that Apply		

38.2 The Ravel			
Elevation	Circle One	A	2271.5 Square Feet
		B	2273.7 Square Feet
Optional Layouts	Circle All that Apply		

38.3 The Haydn			
Elevation	Circle One	A	2394.5 Square Feet
		B	2388.3 Square Feet
Optional Layouts	Circle All that Apply		

38.4 The Vivaldi			
Elevation	Circle One	A	2459.1 Square Feet
		B	2459.1 Square Feet
Optional Layouts	Circle All that Apply		

38.5 The Handel			
Elevation	Circle One	A	2549.2 Square Feet
		B	2554.7 Square Feet
Optional Layouts	Circle All that Apply		

38.9 The Puccini			
Elevation	Circle One	A	3628.0 Square Feet
		B	3634.7 Square Feet
Optional Layouts	Circle All that Apply	GFA1	GROUND FLOOR Optional Alternative Layout

38.6 The Scarlatti			
Elevation	Circle One	A	3521.1 Square Feet
		B	3508.1 Square Feet
Optional Layouts	Circle All that Apply	GFA1	GROUND FLOOR Optional Alternative Layout

38.7 The Schubert			
Elevation	Circle One	A	3593.8 Square Feet
		B	3610.5 Square Feet
Optional Layouts	Circle All that Apply	GFA1	GROUND FLOOR Optional Alternative Layout
		SFA4	SECOND FLOOR Additional Bedroom
Optional Layouts	Circle All that Apply		

38.8 The Corelli			
Elevation	Circle One	A	3801.5 Square Feet
		B	3801.5 Square Feet
Optional Layouts	Circle All that Apply	GFA1	GROUND FLOOR Optional Alternative Layout
		SFA4	SECOND FLOOR Additional Bedroom w/ Ensuite
Optional Layouts	Circle All that Apply		

41.1 The Strauss			
Elevation	Circle One	A	2554.2 Square Feet
		B	2571.2 Square Feet
Optional Layouts	Circle All that Apply	SFA1	SECOND FLOOR Shower in Lieu of Tub #2

41.2 The Mozart			
Elevation	Circle One	A	2725.9 Square Feet
		B	2711.1 Square Feet
Optional Layouts	Circle All that Apply	SFA1	SECOND FLOOR Shower in Lieu of Tub #2

41.3 The Chopin			
Elevation	Circle One	A	2800.0 Square Feet
		B	2810.5 Square Feet
Optional Layouts	Circle All that Apply		

41.4 The Bach			
Elevation	Circle One	A	2894.4 Square Feet
		B	2894.5 Square Feet
Optional Layouts	Circle All that Apply		

41.5 The Brahms			
Elevation	Circle One	A	3948.1 Square Feet
		B	3949.1 Square Feet
Optional Layouts	Circle All that Apply	GFA1	GROUND FLOOR Optional Alternative Layout
		SFA2	SECOND FLOOR Shower in Lieu of Tub #4
Optional Layouts	Circle All that Apply	SFA3	SECOND FLOOR Optional Laundry Layout

41.6 The Verdi			
Elevation	Circle One	A	3852.5 Square Feet
		B	3856.4 Square Feet
Optional Layouts	Circle All that Apply	GFA1	GROUND FLOOR Optional Alternative Layout
		SFA3	SECOND FLOOR Optional Laundry Layout
Optional Layouts	Circle All that Apply		

June 21, 16

HL