


LENGTH OF TRENCH = 30.0m TOP OF TRENCH ELEV = 214.40 216.49 216.71 216,2 2.6% × 35.27 *2L 2R 216.6 A 3R 216.91 В 웊 RIVER STONE A 25-01 REV. FFE 217.36 TFW 217.06 TBS 214.77 USF 214.54 0 0 17.09 ¥ 21. ∇. 216.51 216.55 5.84 0.51 0.51 5.8 1.24 USFG= 215.14 21 21

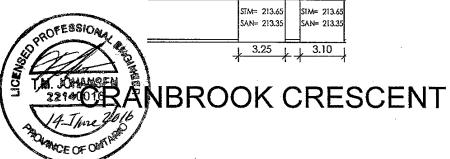

1.50m CONC

STM= 213,65

STM= 213.65

SITE PLAN REVIEW

LOT NO ...2L

... REGISTERED PLAN 65 M - 4500

THE PROPOSED LOT GRADING AND DRAINAGE IS APPROVED AS BEING IN CONFORMITY WITH THE OVERALL APPROVED GRADING PLANS FOR THE SUBDIVISION.

THIS REVIEW DOES NOT WARRANT THAT OTHER INFORMATION SHOWN ON THIS DRAWING IS ACCURATE OR COMPLETE, SOLE RESPONSIBILITY FOR THE DESIGN AND DETAILS SHALL REMAIN WITH THE DESIGNER.

NO COMMENT

REVIEWED BY .

COMMENTS AS NOTED

DATE MAY 12-16



It is the builder's complete responsibility to ensure that all plans submitted for approval fully comply with the Architectural Guidelines and all applicable regulations and requirements including zoning provisions and any provisions in the subdivision agreement. The Control Architect is not responsible in any way for examining or approving site (lotting) plans or working drawings with respect to any zoning or building code or permit matter or that any house can be properly built or located on its lot.

This is to certify that these plans comply with the applicable Architectural Design Guidelines approved by the City of VAUGHAN.

architectural review à approxai MAY 1/ 7-2016

John G. Williams Librica, Accessor

NOTE: BUILDER TO VERIEY LOCATION OF ALL HYDRANTS, STREET LIGHTS, TRANSFORMERS AND OTHER SERVICES. IF MIN. DIMENSIONS ARE NOT MAINTAINED BUILDER IS TO RELOCATE AT HIS OWN EXPENSE

BUILDING STATISTIC	S
REG. PLAN No.	
ZONE	RS1
LOT NUMBER	2L
LOT AREA(m) ²	267.58
BLDG AREA(m) ²	NA
LOT COVERAGE(%)	NA NA
No. OF STOREYS	2
MEAN HEIGHT(m)	7.98
PEAK HEIGHT(m)	NA
DECK LINE(m)	NA

LEGEND						
FFE	FINISHED FLOOR ELEVATION	\boxtimes	BELL PEDESTAL			
TFW	TOP OF FOUNDATION WALL		CABLE PEDESTAL			
14.44			CATCH BASIN			
TBS	TOP OF BASEMENT SLAB		DBL, CATCH BASIN			
USF	UNDER SIDE FOOTING	*	ENGINEERED FILL			
USFR	UNDER SIDE FOOTING @	*	HYDRO CONNECTION			
USEG	UNDER SIDE FOOTING ®	Ŷ	FIRE HYDRANT			
	TOP OF ENGINEERED	Si.	STREET LIGHT			
TEF	FILL	\boxtimes	MAIL BOX			
R	NUMBER OF RISERS TO GRADE	1	TRANSFORMER			
WOD	WALKOUT DECK	∇	SEWER CONNECTIONS 2 LOTS			
LOB	LOOKOUT BASEMENT	7	SEWER CONNECTIONS 1			
WOB	WALK OUT BASEMENT	÷	WATER CONNECTION			
REV	REVERSE PLAN	ė	WATER VALVE			
ZID	STANDARD PLAN	_	CHAMBER HYDRANT AND			
Δ	DOOR	유	VALVE			
0	WINDOW	Ħ	HYDRO METER			
<u>~</u>	AIR CONDITIONING	•	GAS METER			
⊕+	DOWN SPOUT TO SPLASH PAD	∇	MANHOLE - STORM			
	SWALE DIRECTION	•	MANHOLE - SANITARY			
SP	SUMP PUMP	•	PROPOSED SUMP PUMP			
	CHAINLINK FENCE					
	XX					
	XXX—— SOUND BARRIER					
	— F	001ING 0 1,22 (A	TO BE EXTENDED AIN) BELOW GRADE			

	ISSUED OR REVISION CO	DMMENT:	S	
NO.	DESCRIPTION	DATE	DWN	CHK
1	ISSUED FOR REVIEW	APR-21-16	RK	JP
2	REVISED PER ENG COMM - FINAL	MAY. 09/16	RK	JP
		<u></u>		
				<u>L</u>
			<u> </u>	

I, JULIO PINZON DECLARE THAT I HAVE REVIEWED AND TAKEN DESIGN RESPONSBILITY FOR THE DESIGN WORK ON BEHALF OF RN DESIGN LTD, UNDER DIVISION C, FART-3 SUBSECTION-3.2.4 OF THE BULDING CODE. I AM QUALIFIED AND THE FIRM IS REGISTERED IN THE APPROPRIATE CLASSES / CATEGORIES.

QUALIFIED DESIGNER BCIN: FIRM BCIN: DATE: MAY 09/16

RN DESIGN LTD.



8395 JANE STREET, SUITE 203 VAUGHAN, ONTARIO. L4K 5Y2 T:905-738-3177 J F: 905-738-5449

GOLD PARK HOMES

PROJECT/LOCATION

KLEINBURG GLEN VAUGHAN, ON

DRAWING

SITE PLAN

DRAWN BY	SCALE			
RK	1:250			
PROJECT No. 14043	LOT NUMBER			
	2L			