## Schedule 1: Designer Information

Building number, street name			Tours and the second			
			Unit no. 38-01 'A'	Lot/con.		
dunicipality /AUGHAN	Postal code Plan number/ c 65M-4500		other description			
3. Individual who reviews ar	d takes responsil	bility for design activit	ies			
lame		Firm				
Iulio Pinzon		RN Design Limit				
Street address			Unit no.	Lot/con.		
8395 Jane Street	Postal code	Province	203			
funicipality Vaughan		Ontario	E-mail juliop@rnde	sian com		
elephone number			Cell number	signi.com		
(905) 738-3177	(905) 73		Oon named			
. Design activities undertaker	The second secon		ling Code Division C. Par	rt 3 Table 3 5 2 1		
Complex Buildings escription of designer's work eview of the site plan design esponsibility excludes any st BC.	and working draw		HAMPTON 38-01 'A			
. Declaration of Designer						
Julio Pinzo	n	declare	that (choose one as ap	onmoriate):		
(print name	1					
Married Towns				quiquina,		
☑ I review and take responsubsection 3.2.4, of the I classes/categories:  Individual BCIN:	sibility for the design	work on behalf of a firm requalified, and the firm is req		C, Part 3,		
subsection 3.2.4, of the I classes/categories;	sibility for the design Building Code. I am o			C, Part 3,		
subsection 3.2.4. of the B classes/categories: Individual BCIN: Firm BCIN: I review and take respondesigner* under Division Individual BCIN: Basis for exemption The design work is exer	sibility for the design Building Code. I am of 38688 26996 sibility for the design C, Part 3, subsection on from registration:	ualified, and the firm is required work and am qualified in to 3.2.5 of the Building Cod	istered, in the appropria he appropriate category a.	C, Part 3, ate		
subsection 3.2.4, of the B classes/categories: Individual BCIN: Firm BCIN:  I review and take respondesigner* under Division Individual BCIN:  Basis for exemption	sibility for the design Building Code. I am of 38688 26996 sibility for the design C, Part 3, subsection on from registration:	ualified, and the firm is required work and am qualified in to 3.2.5 of the Building Cod	istered, in the appropria he appropriate category a.	C, Part 3, ate		
subsection 3.2.4. of the B classes/categories: Individual BCIN: Firm BCIN:  I review and take respondesigner under Division Individual BCIN: Basis for exemption The design work is exer	sibility for the design Building Code. I am of 38688 26995 sibility for the design C, Part 3, subsection on from registration: npt from the registrat m registration and qu in this schedule is to	work and am qualified in to a 3.2.5 of the Building Code	pistered, in the appropriate he appropriate category a.	C, Part 3, ate		

"For the purposes of this form, "individual" means the "person" referred to in Division C, Part 3, Clause 3.2.4.7. (1)(d), Division C, Part 3, Article 3.2.5.1. and all other persons who are exempt from qualification under Division C, Part 3, Subsections 3.2.4. and 3.2.5.

### NOTE

- 1. Firm and Individual BCIN numbers are not required for building permit applications submitted prior to January 1, 2006
- Schedule 1 does not need to be completed by architects, or holders of a Certificate of Practice or a Temporary License under the Architects
  Act

It is the builder's complete responsibility to ensure that all plans submitted for approval fully comply with the Architectural Guidelines and all applicable regulations are requirements including zoning provisions and any provisions in the subdivision agreement. The Control Architect is not responsible in any way for examining or approving site (lotting) plans or working drawings with respect to any zoning or building code or permit matter or that any house can be properly built or located on its lot.


This is to certify that these plans comply with the applicable Architectural Design Guidelines approved by the City of VAUGHAN.



#### NOTE-

NOTE:
UNDER-SLAB WEEPER DRAIN NETWORKS TO BE INSTALLED TO CAPTURE GROUND WATER SEPACE ASSOCIATED WIT I SEASONAL AND PERIODIC HIGH WATER TABLE WITH THE SHALLOW SAND UNIT BENEATH THE SITE. UNDER-SLAB DRAINAGE NETWORK TO CONSIST OF 100mm DIAMETER PREFICHATED THES WRAPPED IN GEOTEXTILE AND EMBEDDED IN CSA FINE CONCRETE AGGREGATE AT MAXIMUM 5000 O/C, PENEATH BASEMENT SLAB. PERMINETER AND UNDER-SLAB DRAINS TO BE DRAINED BY GRAVITY INFO THE MUNICIPAL STORM, SEWER SERVICES.
PROVIDE ROUGH IN FOR SUMP PIT.



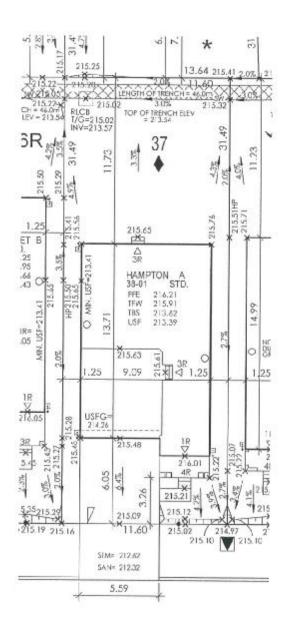

# ZENITH AVENUE

## SITE PLAN REVIEW

LOTNO 37 REGISTERED PLAN 65M-4500

THE PROPOSED LOT GRADING AND DRAINAGE IS APPROVED AS BRING IN CONFORMITY WITH THE OVERALL APPROVED GRADING PLANS FOR THE SUBDIVISION.

THIS REVIEW DOES NOT WARRANT THAT OTHER INFORMATION SHOWN ON THIS DRAWING IS ACCURATE OR COMPLEIE. SOLE RESPONSIBILITY FOR THE DESIGN AND DETAILS SHALL REMAIN WITH THE DESIGNER.

NO COMMENT

☐ REVIEWED BY ....

COMMENTS AS NOTED

DATE AUG.18 2016





NOTE BUILDER TO VERFY LOCATION OF ALL INFORMATS STREET INSHIFT, TRANSPORAGES AND OTHER SERVICES. FINEL DAMENDORS, ARE NOT MAINTAINED DULLDER STO RELOCATE AT HIS OWN SPIPELS.

### BUILDING STATISTICS REG. PLAN No. 65M-4500 RO4 OT NUMBER LOT 37 OT AREA(m) 365.20 SLDG AREA!m)2 134.5 LOT COVERAGE (%) 36.8% MEAN HEIGHT [m] 9.04 PEAK HEIGHT(m) DECKLINEIM!

	LEGI	END	
FFE	CLEVATION	(3)	BELL PEDESTAL
TEW	TOP OF FOURIDATION		CABLE PEDESTAL
133	MATE	U	CATCH BASIN
TBS	TOP OF BASEMENT SLAB		DBL CATCH BASIN
USF	UNDER SIDE FORFING	*	ENGHEERED DU.
USFR	UNDER DIDE POORING G	++-	HYDEC CONNECTION
USPG	UNDER SIDE FOOTING IS	9	RPE HYDRALT
1	OARAGE TOP OF \$10HEEPED	*	STREET LIGHT
TEF	PGL.	74	MALBOX
R	GRACE OF RISERS TO	M	TRANSFORMUR.
MOD	WALKOUT DECK	V	SEWER CONNECTIONS 2.
LOB	LOCKOUT EASEMENT	7	SEWER CONNECTIONS I
MOB	WALK OUT BASSMEHT	1	WATER CONNECTION
REV	REVENSE PLAN	-	WATERVALVE
STO	STANDARD PLAN	0	CHAMBER
Δ	1000	Q-	HYDRA VI AND VALVE
0	WHOOW	E	H*ERO METER
W.	AR CONSTIONING	0	GAS METER
<b>B</b> +	DOWN SYOU" TO	0	MANHOLE - STORM
$\rightarrow$	SMALE DRECTION	0	MARHOLE SAMILARY
9	SLEVE PLOVE	+	POPENTAL HIGH WATER TABLE ISEE NOTE ON THIS DRAWNING!
		0.000	KIFENCE
		DUVD B	
			TO BE EXTENDED
	13	1,22 (	AND BELOW GRADE

	ISSUED OR REVISION CO	DMMENT	S	
40.	DESCRIPTION	DATE	DWN	СНХ
1	ISSUED FOR REVIEW	20-7/7/-16	SOU	JO.
2	REVISED PER ENG COMM - FINAL	04-101-76	SOU	1/2
-				
			-	_

L JUJO PNZON DECLARE THATI HAVE REVIEWED AND IALEN DESIGN WORK ON BEHALF DESIGN WORK ON BEHALF OF AN DESIGN BUTTON TO PARTIS SIBSECTION 3.7.4 OF THE BUILDING COOL. TAM QUALIFED AND THE FRM. 6 RECISIERED IN THE APPROPRIATE CLASSES / CATEGORES.

QUALFED DESIGNER SCIN: FIRM BCIN:

38588 26995

JUL04/16

SIGNATURE:



### RN DESIGN LTD.

8395 JANE STREET, SUITE 203 VAUGHAN, ONTARIO L4K 5Y2 T:905 738 3177 | F: 905-738-5440

CLER

GOLD PARK HOMES

PROJECTACICATION

KLEINBURG GLEN VAUGHAN, ON

DRAWING

SITE PLAN

DRAWN BY	SCALE
SDU	1:250
WOJECT No.	LOT NUMBER
14043	LOT 37