

CONSTRUCTION SUMMARY

6 - 1 - 38-7 Elev.A SCHUBERT

CENTRAL VAC AND WIRING

Inv.411	1 - MASTER BEDROOM: INSTALL ROUGH-IN FOR EXTRA SECURITY KEY PAD IN MASTER ENSUITE, BESIDE LIGHT SWITCHES
Line5157	Note:
7Apr16 / 26Apr16	
Inv.411	1 - LAUNDRY ROOM: INSTALL RG 6 WIRING - IN MAIN FLOOR LAUNDRY ROOM. SEE SKETCH
Line5158	Note:
7Apr16 / 26Apr16	
Inv.411	1 - GROUND FLOOR: INSTALL RG 6 WIRING - SEE SKETCH
Line5159	Note:
7Apr16 / 26Apr16	
Inv.411	1 - GROUND FLOOR: INSTALL CAT 5 WIRING - ADD EXTRA OUTLET, ROUGH-IN ONLY. SEE SKETCH
Line5160	Note:
7Apr16 / 26Apr16	
Inv.411	1 - FAMILY ROOM: INSTALL CONDUIT PIPE- FOR TELEVISION- MUST SPECIFY LOCATION AND TERMINATION POINT. SEE SKETCH
Line5161	Note:
7Apr16 / 26Apr16	

ELECTRICAL

Inv.411	1 - TELEPHONE AND CABLE ROUGH-IN LOCATIONS
Line5156	Note:
7Apr16 / 26Apr16	
Inv.411	1 - FAMILY ROOM: INSTALL 110V WALL RECEPTACLE ON DEDICATED CIRCUIT - ABOVE FIREPLACE SEE SKETCH
Line5162	Note:
7Apr16 / 26Apr16	
Inv.411	1 - LIVING ROOM: INSTALL ADDITIONAL STANDARD FIXTURE WITH SWITCH - MUST SPECIFY LOCATION IN LIVING ROOM. SEE SKETCH
Line5163	Note:
7Apr16 / 26Apr16	

EXTERIOR COLOURS

Inv.411	1 - EXTERIOR COLOUR PACKAGE 6 ✓
Line5301	Note:
7Apr16 / 26Apr16	

FORMING

Inv.411	1 - EXTERIOR: INSTALL SIDE DOOR- HOME TO EXTERIOR- AS PER PLAN AND GRADE PERMITTING
Line5164	Note:
7Apr16 / 26Apr16	
Inv.484	1 - DELETE:
EXTERIOR: SIDE DOOR- HOME TO EXTERIOR- AS PER PLAN AND GRADE PERMITTING	
Line5835	Note: GRADE DOES NOT PERMIT TO HAVE SIDE DOOR.
5May16 / 19May16	

CONSTRUCTION SUMMARY

6 - 1 - 38-7 Elev.A SCHUBERT

FRAMING

Inv.411	1 - GROUND FLOOR: INSTALL COMPLETE 3PC IN WASHROOM ON GROUND FLOOR. SEE SKETCH FOR LOCATIONS.
Line5439	Note:
7Apr16 / 26Apr16	
Inv.411	1 - GARAGE: INSTALL MAN DOOR GARAGE TO HOUSE - OPTIONAL - IF GRADE PERMITS. ***AS PER AGREEMENT OF PURCHASE AND SALE***
Line5441	Note:
7Apr16 / 26Apr16	

HVAC

Inv.411	1 - KITCHEN: INSTALL GAS LINE ROUGH - IN MAIN FLOOR - (3 STOREY MODELS) FOR STOVE
Line5165	Note:
7Apr16 / 26Apr16	

MISC.

Inv.411	1 - BONUS PACKAGE: \$10,000.00 (INCLUDING TAXES) WORTH OF UPGRADES FROM GOLD PARK HOMES DÉCOR CENTRE IS BEING APPLIED TOWARD THE STRUCTURAL APPOINTMENT.
Line5181	Note:
7Apr16 / 26Apr16	
Inv.411	1 - Purchaser has attended a STRUCTURAL appointment at the Decor Centre & has DECLINED any additional upgrades and accepts and acknowledges that there will be no further structural changes/additions/deletions to be made upon signing on April 18,2016
Line5183	Note:
7Apr16 / 26Apr16	
Inv.411	1 - Purchasers are aware & accepts that ANY changes made to upgrades after signing this Purchasers Extra Form are subject to a minimum administration fee of \$500. PLUS a 10% holdback fee
Line5184	Note:
7Apr16 / 26Apr16	
Inv.484	1 - Purchasers are aware & accepts that ANY changes made to upgrades after signing this Purchasers Extra Form are subject to a minimum administration fee of \$500. PLUS a 10% holdback fee.
Line5836	Note:
5May16 / 19May16	

PLUMBING

Inv.411	1 - GROUND FLOOR: INSTALL COMPLETE 3PC IN WASHROOM ON GROUND FLOOR. SEE SKETCH FOR LOCATIONS.
Line5166	Note:
7Apr16 / 26Apr16	
Inv.411	1 - KITCHEN: INSTALL ROUGH-IN - WATERLINE FOR FRIDGE
Line5167	Note:
7Apr16 / 26Apr16	
Inv.411	1 - BACK YARD: INSTALL HOSE BIB - STANDARD TO UPGRADED WITH HOT AND COLD WATER VALVE. AT THE REAR OF THE HOUSE.
Line5168	Note: GARAGE HOSE BIB TO REMAIN STANDARD.
7Apr16 / 26Apr16	
Inv.411	1 - BASEMENT: INSTALL 3PC BASEMENT ROUGH-IN, AS PER PLAN
Line5187	Note:
7Apr16 / 26Apr16	



CONSTRUCTION SUMMARY

6 - 1 - 38-7 Elev.A SCHUBERT

WINDOWS AND DOORS

Inv.411	1 - GARAGE: INSTALL MAN DOOR GARAGE TO HOUSE - OPTIONAL - IF GRADE PERMITS. ***AS PER AGREEMENT OF PURCHASE AND SALE***
Line5189	Note:
7Apr16 / 26Apr16	
Inv.411	1 - EXTERIOR: INSTALL SIDE DOOR- HOME TO EXTERIOR- AS PER PLAN AND GRADE PERMITTING
Line5440	Note:
7Apr16 / 26Apr16	

Telephone - (T)

Cable - (C)



Elevation A • 3,005 sq.ft.




Elevation B • 3,022 sq.ft.




GOLDPARK

Model, Square Footage, and other information are subject to change without notice. Please contact the salesperson for more information. This document is not a contract. It is a guide only. See the actual plan for details.

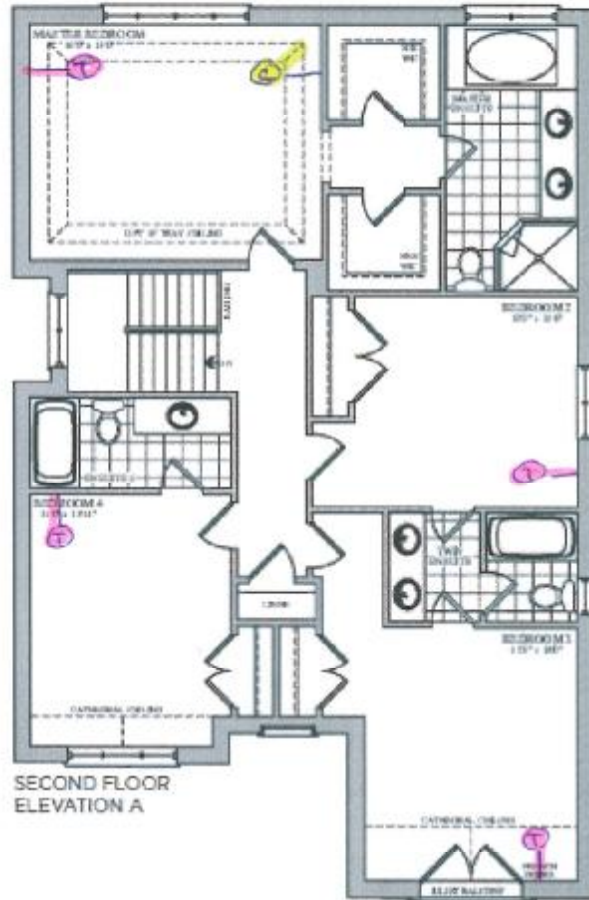

SECOND FLOOR
ELEVATION A

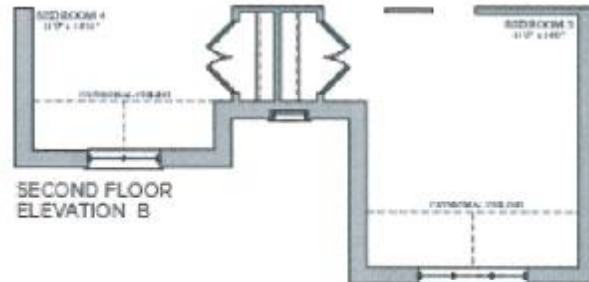

SECOND FLOOR
ELEVATION B

Lot 6
April 7, 2016

RS

Telephone - ①


Cable ———— (c)



Elevation A = 3,005 sq.ft.



© 2012 Wiley Periodicals, Inc. All rights reserved. No part of this publication may be reproduced, stored in a retrieval system, or transmitted, in any form or by any means, electronic, mechanical, photocopying, recording, scanning, or otherwise, except as may be permitted in writing by Wiley Periodicals, Inc. This article is intended solely for the personal use of the individual user and is not to be disseminated broadly. Reproduction by any other means without express permission of Wiley Periodicals, Inc. is prohibited. This article is published with the understanding that Wiley Periodicals, Inc. is not liable for damages resulting from its use.

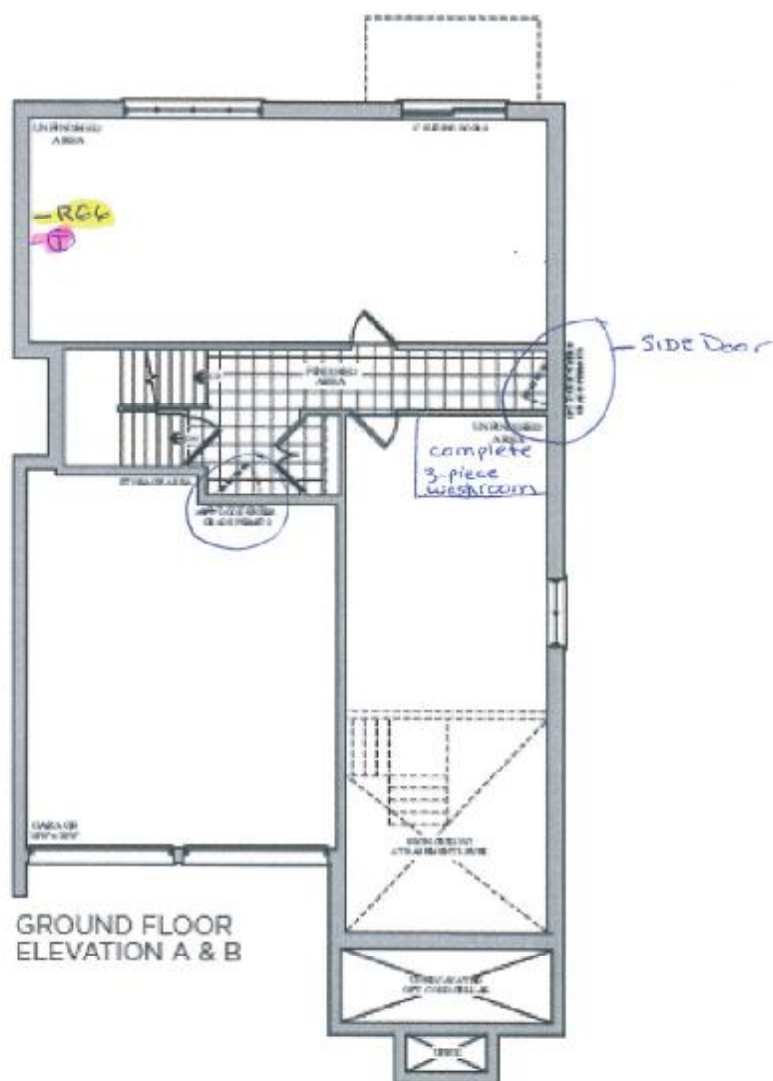

Lot 6
April 6, 2016
PS

April 6, 2016

P.S




Stacey Carlete
Project Coordinator



Claude Azzopardi
Contracts Manager



Nancy Mc
Corporate C

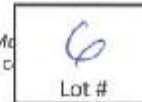

Model	38.1 The Bizet		
Elevation	Circle One	A	2189.6 Square Feet
		B	2186.7 Square Feet
Optional Layouts	Circle All that Apply		

Model	38.2 The Ravel		
Elevation	Circle One	A	2271.5 Square Feet
		B	2273.7 Square Feet
Optional Layouts	Circle All that Apply		

Model	38.3 The Haydn		
Elevation	Circle One	A	2394.5 Square Feet
		B	2386.3 Square Feet
Optional Layouts	Circle All that Apply		

Model	38.4 The Vivaldi		
Elevation	Circle One	A	2459.1 Square Feet
		B	2459.1 Square Feet
Optional Layouts	Circle All that Apply		

Model	38.5 The Handel		
Elevation	Circle One	A	2549.2 Square Feet
		B	2554.7 Square Feet
Optional Layouts	Circle All that Apply		

Model	38.9 The Puccini		
Elevation	Circle One	A	3628.0 Square Feet
		B	3634.7 Square Feet
Optional Layouts	Circle All that Apply	GFA1	GROUND FLOOR Optional Alternative Layout

Model	38.6 The Scarlatti		
Elevation	Circle One	A	3521.1 Square Feet
		B	3508.1 Square Feet
Optional Layouts	Circle All that Apply	GFA1	GROUND FLOOR Optional Alternative Layout

Model	38.7 The Schubert		
Elevation	Circle One	A	3593.8 Square Feet
		B	3610.5 Square Feet
Optional Layouts	Circle All that Apply	GFA1	GROUND FLOOR Optional Alternative Layout
		SFA4	SECOND FLOOR Additional Bedroom
Optional Layouts	Circle All that Apply		

Model	38.8 The Corelli		
Elevation	Circle One	A	3801.5 Square Feet
		B	3801.5 Square Feet
Optional Layouts	Circle All that Apply	GFA1	GROUND FLOOR Optional Alternative Layout
		SFA4	SECOND FLOOR Additional Bedroom w/ Ensuite
Optional Layouts	Circle All that Apply		

Model	41.1 The Strauss		
Elevation	Circle One	A	2554.2 Square Feet
		B	2571.2 Square Feet
Optional Layouts	Circle All that Apply	SFA1	SECOND FLOOR Shower in Lieu of Tub B2

Model	41.2 The Mozart		
Elevation	Circle One	A	2725.9 Square Feet
		B	2711.1 Square Feet
Optional Layouts	Circle All that Apply	SFA1	SECOND FLOOR Shower in Lieu of Tub B2

Model	41.3 The Chopin		
Elevation	Circle One	A	2800.0 Square Feet
		B	2810.5 Square Feet
Optional Layouts	Circle All that Apply		

Model	41.4 The Bach		
Elevation	Circle One	A	2894.4 Square Feet
		B	2894.5 Square Feet
Optional Layouts	Circle All that Apply		

Model	41.5 The Brahms		
Elevation	Circle One	A	3948.1 Square Feet
		B	3949.1 Square Feet
Optional Layouts	Circle All that Apply	GFA1	GROUND FLOOR Optional Alternative Layout
		SFA2	SECOND FLOOR Shower in Lieu of Tub B4
Optional Layouts	Circle All that Apply	SFA3	SECOND FLOOR Optional Laundry Layout

Model	41.6 The Verdi		
Elevation	Circle One	A	3862.5 Square Feet
		B	3866.4 Square Feet
Optional Layouts	Circle All that Apply	GFA1	GROUND FLOOR Optional Alternative Layout
		SFA3	SECOND FLOOR Optional Laundry Layout
Optional Layouts	Circle All that Apply		

Lot 6
April 18, 2014