

Structural
CONSTRUCTION SUMMARY
41 - 1 - 38-5 Elev.A HANDEL

ELECTRICAL

Inv.412	1 - Telephone and cable rough-in location sketch. See floor plan
Line4908	Note: Purchaser chose not to put one of the builder's standard telephone locations in the kitchen. No credit.
8Apr16 / 20Apr16	
Inv.412	1 - BEDROOM #2: Install RG6 (cable/internet) rough-in in bedroom #2. See sketch for location
Line4909	Note:
8Apr16 / 20Apr16	
Inv.412	1 - BEDROOM #4: Install RG6 (cable/internet) rough-in in bedroom #4. See sketch for location
Line4910	Note:
8Apr16 / 20Apr16	

EXTERIOR COLOURS

Inv.412	1 - EXTERIOR COLOUR PACKAGE 3
Line5186	Note:
8Apr16 / 20Apr16	

MISC.

Inv.412	1 - Purchasers are aware & accepts that ANY changes made to upgrades after signing this Purchasers Extra Form are subject to a minimum administration fee of \$500. PLUS a 10% holdback fee
Line4914	Note:
8Apr16 / 20Apr16	
Inv.412	1 - Purchaser has attended a Structural appointment at the Decor Centre & has DECLINED any additional upgrades and accepts and acknowledges that there will be no further structural changes/additions/deletions to be made upon signing on April 7,2016
Line4915	Note:
8Apr16 / 20Apr16	

PLUMBING

Inv.412	1 - KITCHEN: ROUGH-IN - WATERLINE FOR FIRDGE
Line4912	Note:
8Apr16 / 20Apr16	
Inv.412	1 - BASEMENT: INSTALL ROUGH-IN ONLY - 2PC BASEMENT ROUGH-IN
Line4913	Note:
8Apr16 / 20Apr16	

WINDOWS AND DOORS

Inv.412	1 - EXTERIOR: Install Side Door, where grade permits. See Floor plan
Line4911	Note:
8Apr16 / 20Apr16	

Telephone — (T)

Cable — (C)



Elevation A • 2,603 sq.ft.




Elevation B • 2,603 sq.ft.



GOLD PARK

Handel Homes is a registered trademark of The Home Depot. All other trademarks are the property of their respective owners. © 2011 The Home Depot. All rights reserved.

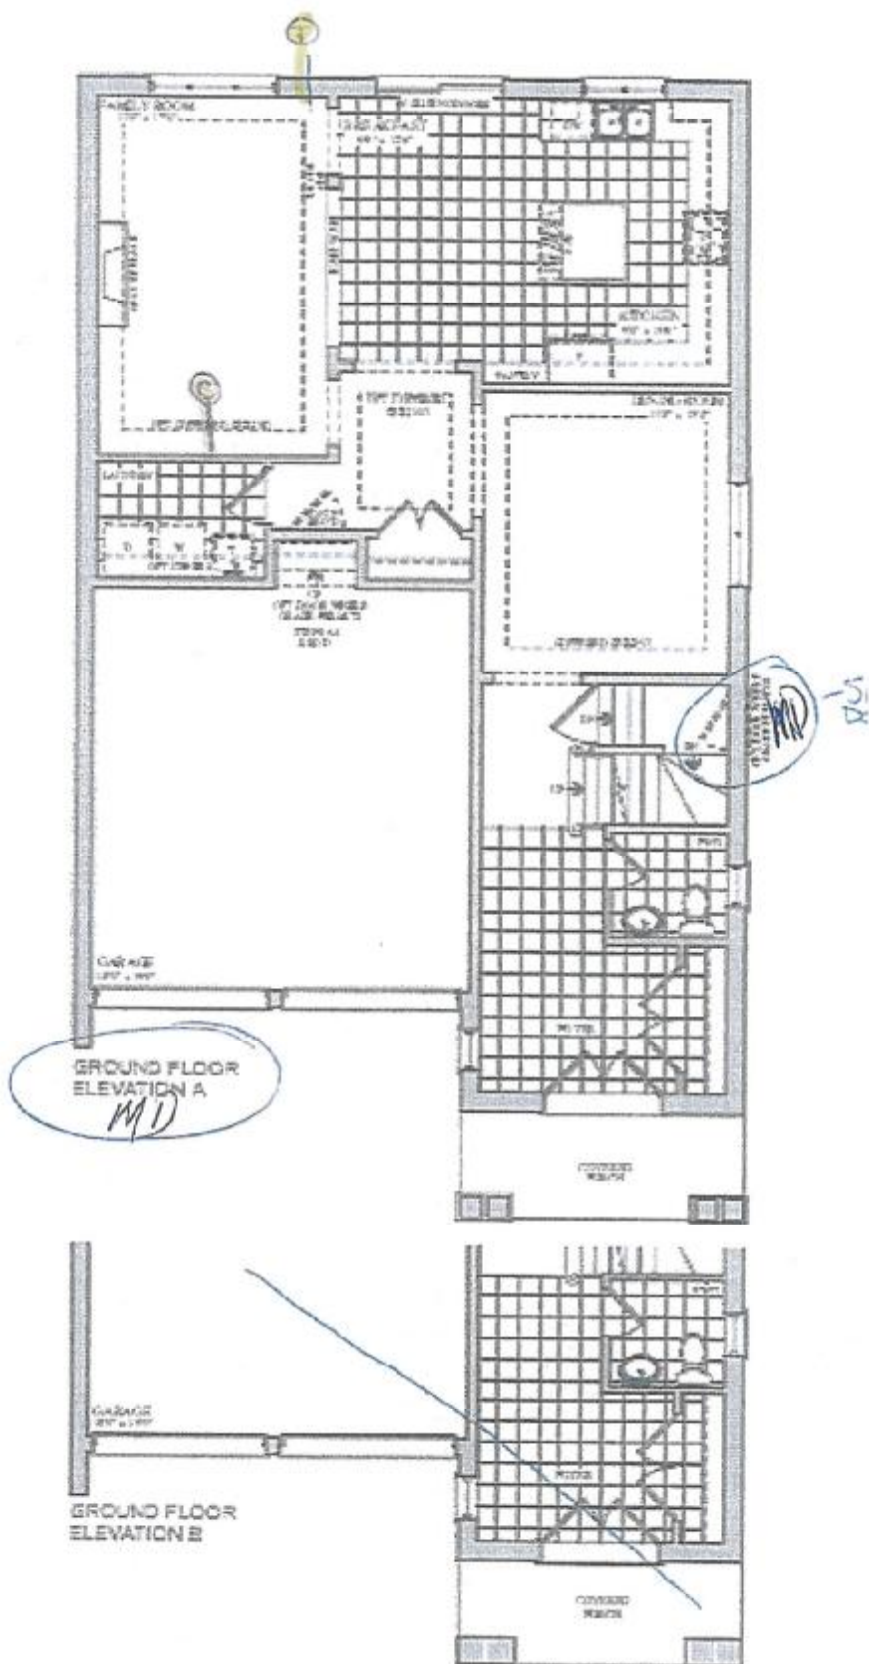

The Handel 38' SERIES

Elevation A • 2,603 sq.ft.




Elevation B • 2,603 sq.ft.



GOLDPARK
RESIDENTIAL

Plans, Specifications, Details, Materials and Conditions are subject to change without notice. All dimensions are approximate and actual measurements may vary. Any other conditions may apply. This is not a contract. See the contract for the full terms and conditions.

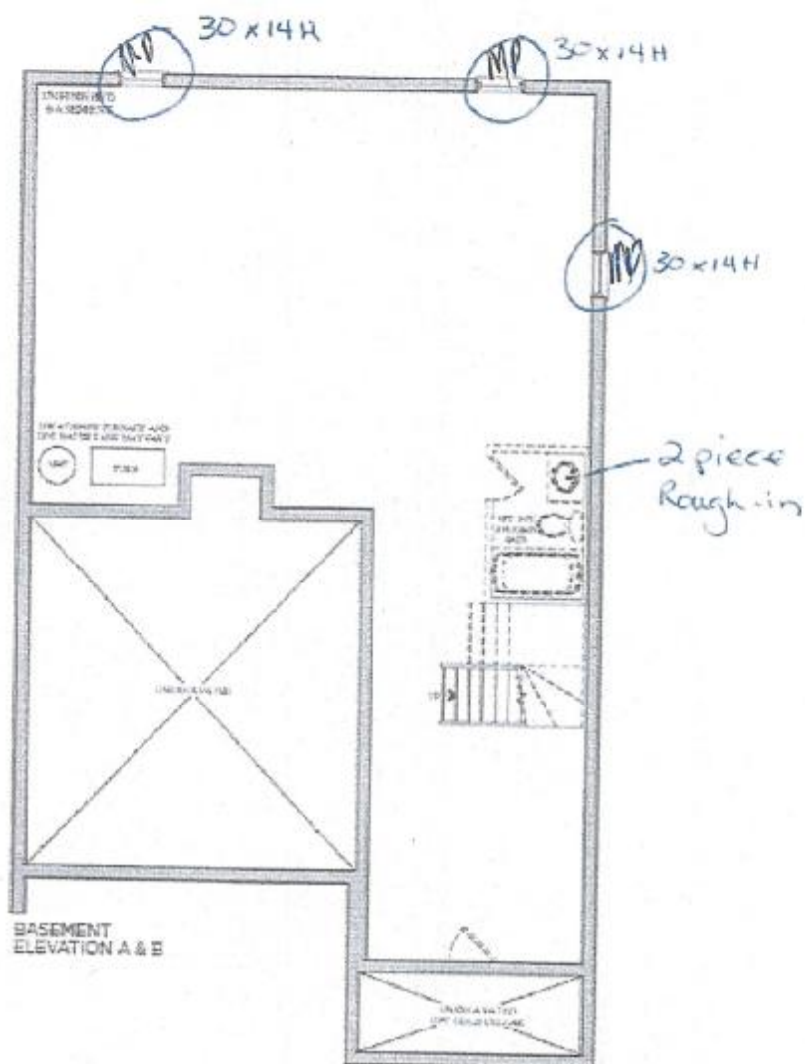

Lot 41

Telephone — (T)
 Cable — (C)



Elevation A • 2,603 sq.ft.




Elevation B • 2,603 sq.ft.



GOLDPARK

These floor plans are for informational purposes only. They are not to be used for construction. All dimensions are approximate. All dimensions are subject to change without notice. All dimensions are subject to change without notice. All dimensions are subject to change without notice.

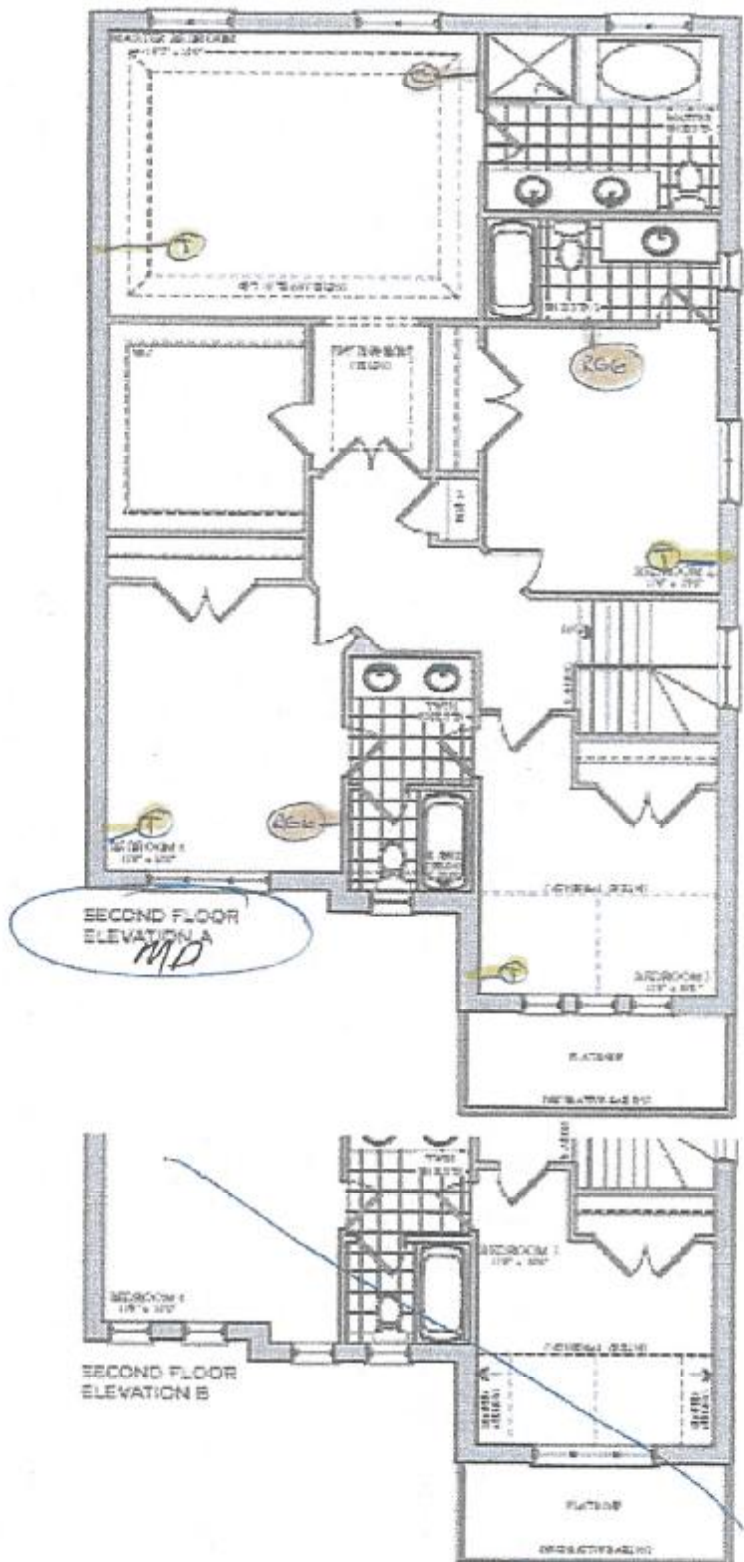

Set 41



Stacey Carlete
Project Coordinator



Claude Azzopardi
Contracts Manager



Nancy McCorporate



Model	38.1 The Bizet		
Elevation	Circle One	A	2189.6 Square Feet
		B	2186.7 Square Feet
Optional Layouts	Circle All that Apply		

Model	38.2 The Ravel		
Elevation	Circle One	A	2271.5 Square Feet
		B	2273.7 Square Feet
Optional Layouts	Circle All that Apply		

Model	38.3 The Haydn		
Elevation	Circle One	A	2391.5 Square Feet
		B	2383.3 Square Feet
Optional Layouts	Circle All that Apply		

Model	38.4 The Vivaldi		
Elevation	Circle One	A	2459.1 Square Feet
		B	2459.1 Square Feet
Optional Layouts	Circle All that Apply		

Model	38.5 The Handel		
Elevation	Circle One	A	2549.2 Square Feet
		B	2554.7 Square Feet
Optional Layouts	Circle All that Apply		

Model	38.9 The Puccini		
Elevation	Circle One	A	3528.0 Square Feet
		B	3534.7 Square Feet
Optional Layouts	Circle All that Apply	GFA1	GROUND FLOOR Optional Alternative Layout

Model	38.6 The Scarlatti		
Elevation	Circle One	A	3521.1 Square Feet
		B	3508.1 Square Feet
Optional Layouts	Circle All that Apply	GFA1	GROUND FLOOR Optional Alternative Layout

Model	38.7 The Schubert		
Elevation	Circle One	A	3593.8 Square Feet
		B	3610.5 Square Feet
Optional Layouts	Circle All that Apply	GFA1	GROUND FLOOR Optional Alternative Layout
		SFA4	SECOND FLOOR Additional Bedroom
Optional Layouts	Circle All that Apply		

Model	38.8 The Corelli		
Elevation	Circle One	A	3801.5 Square Feet
		B	3801.5 Square Feet
Optional Layouts	Circle All that Apply	GFA1	GROUND FLOOR Optional Alternative Layout
		SFA4	SECOND FLOOR Additional Bedroom w/ Ensuite
Optional Layouts	Circle All that Apply		

Model	41.1 The Strauss		
Elevation	Circle One	A	2554.2 Square Feet
		B	2571.2 Square Feet
Optional Layouts	Circle All that Apply	SFA1	SECOND FLOOR Shower in Lieu of Tub B2

Model	41.2 The Mozart		
Elevation	Circle One	A	2725.9 Square Feet
		B	2711.1 Square Feet
Optional Layouts	Circle All that Apply	SFA1	SECOND FLOOR Shower in Lieu of Tub B2

Model	41.3 The Chopin		
Elevation	Circle One	A	2800.1 Square Feet
		B	2810.5 Square Feet
Optional Layouts	Circle All that Apply		

Model	41.4 The Bach		
Elevation	Circle One	A	2894.4 Square Feet
		B	2894.5 Square Feet
Optional Layouts	Circle All that Apply		

Model	41.5 The Brahms		
Elevation	Circle One	A	3948.1 Square Feet
		B	3949.1 Square Feet
Optional Layouts	Circle All that Apply	GFA1	GROUND FLOOR Optional Alternative Layout
		SFA2	SECOND FLOOR Shower in Lieu of Tub B4
Optional Layouts	Circle All that Apply	SFA3	SECOND FLOOR Optional Laundry Layout

Model	41.6 The Verdi		
Elevation	Circle One	A	3862.5 Square Feet
		B	3866.4 Square Feet
Optional Layouts	Circle All that Apply	GFA1	GROUND FLOOR Optional Alternative Layout
		SFA3	SECOND FLOOR Optional Laundry Layout
Optional Layouts	Circle All that Apply		

April 7, 2016

