



Structural
CONSTRUCTION SUMMARY

44 - 1 - 38-1 Elev.A BIZET

CENTRAL VAC AND WIRING

Inv.443	1 - BREAKFAST AREA: INSTALL ROUGH-IN FOR EXTRA SECURITY KEY PAD BY SLIDING DOORS IN BREAKFAST AREA
Line6438	Note:
20Apr16 / 2Jun16	

ELECTRICAL

Inv.443	1 - BASEMENT: INSTALL 200 AMP ELECTRICAL SERVICE
Line6440	Note:
20Apr16 / 2Jun16	

Inv.443	1 - TELEPHONE AND CABLE ROUGH-IN LOCATIONS
Line6437	Note:
20Apr16 / 2Jun16	

Inv.443	1 - KITCHEN: INSTALL 110V WALL RECEPTACLE ON DEDICATED CIRCUIT - FOR MICROWAVE - MICROWAVE NOT INCLUDED, ABOVE STOVE
Line6439	Note:
20Apr16 / 2Jun16	

EXTERIOR COLOURS

Inv.423	1 - EXTERIOR COLOUR PACKAGE 1
Line5196	Note:
13Apr16 / 20Apr16	

FRAMING

Inv.443	1 - GARAGE: INSTALL MANDOOR - GARAGE TO HOUSE- AS PER PLAN AND GRADE PERMITING
Line6441	Note:
20Apr16 / 2Jun16	

GARAGE DOORS

Inv.443	1 - GARAGE: INSTALL DIGITAL ENTRY KEYPAD
Line6450	Note:
20Apr16 / 2Jun16	

Inv.443	2 - GARAGE DOOR OPENER - WITH 1 REMOTE- PRICE IS PER DOOR
Line6449	Note:
20Apr16 / 2Jun16	

MISC.

Inv.423	1 - Purchaser acknowledges that purchases are final and subject to head office approval. Approval will be based on construction status of the home.
Line5178	Note:
13Apr16 / 20Apr16	

Inv.423	1 - BONUS DECOR DOLLARS- \$10 000.00 DECOR INVOICE TOTAL - (-\$3 463.45) REMAINING DECOR DOLLARS- \$ 6 536.55
Line5179	Note:
13Apr16 / 20Apr16	



CONSTRUCTION SUMMARY

44 - 1 - 38-1 Elev.A BIZET

Inv.443	1 - Purchaser has attended a Structural appointment at the Decor Centre & has DECLINED any additional upgrades and accepts and acknowledges that there will be no further structural changes/additions/deletions to be made upon signing on June 2, 2016
Line6446	Note:
20Apr16 / 2Jun16	
Inv.443	1 - BONUS PACKAGE: \$5085.00 (INCLUDING TAXES) WORTH OF UPGRADES FROM GOLD PARK HOMES DÉCOR CENTRE IS BEING APPLIED TOWARD THE STRUCTURAL APPOINTMENT. PURCHASER HAS A REMAINING AMOUNT OF \$1451.55 (INCLUDING TAXES) TO BE USED TOWARD THE COLOUR APPOINTMENT
Line6445	Note:
20Apr16 / 2Jun16	
Inv.443	1 - Purchasers are aware & accepts that ANY changes made to upgrades after signing this Purchasers Extra Form are subject to a minimum administration fee of \$500. PLUS a 10% holdback fee
Line6447	Note:
20Apr16 / 2Jun16	

PLUMBING

Inv.423	1 - ROUGH-IN - 3PC BASEMENT ROUGH-IN
Line5177	Note:
13Apr16 / 20Apr16	
Inv.443	1 - KITCHEN: INSTALL ROUGH-IN - WATERLINE FOR FRIDGE
Line6448	Note:
20Apr16 / 2Jun16	

WINDOWS - BASEMENT


Inv.423	2 - BASEMENT WINDOWS - UPGRADE EXISTING BASEMENT WINDOW TO 30 INCH X 24 INCH - MAY REQUIRE INSTALLATION OF WINDOW WELL
Line5175	Note:
13Apr16 / 20Apr16	
Inv.423	1 - BASEMENT WINDOWS - UPGRADE EXISTING BASEMENT WINDOW TO 53 INCH X 16 INCH EGRESS
Line5176	Note:
13Apr16 / 20Apr16	

encore
BRAMPTON

Telephone (T)
Cable (C)

The
Bizet
38' SERIES

Elevation A • 2,234 sq.ft. | Elevation B • 2,222 sq.ft.

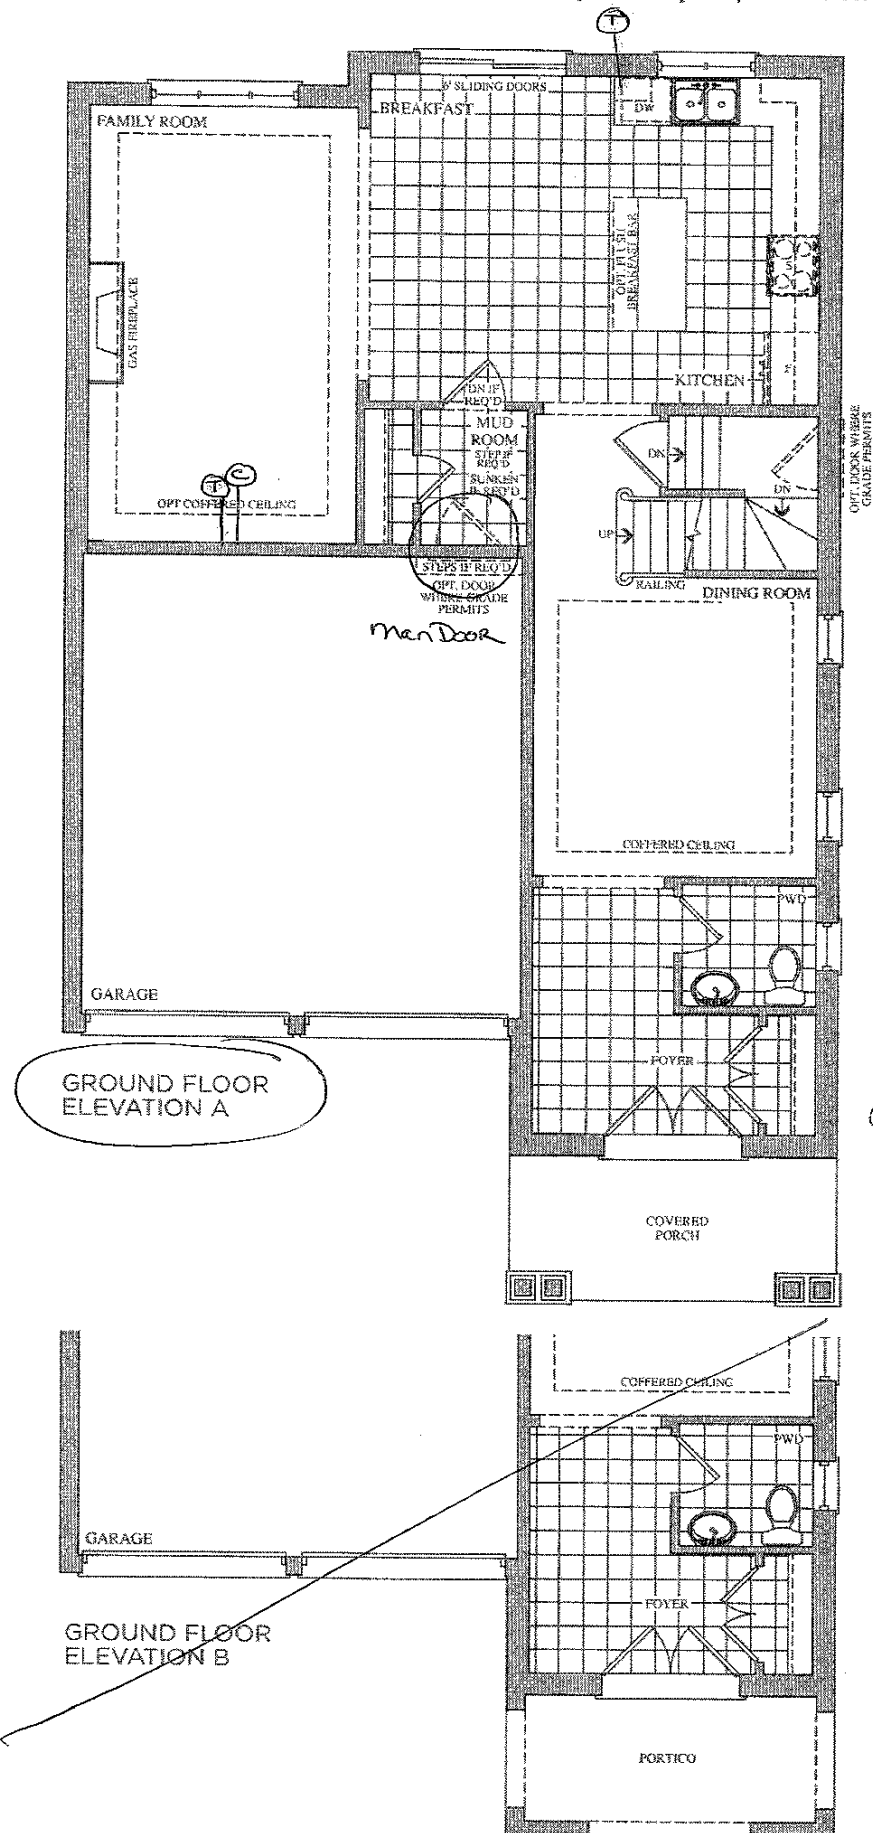

Prices, figures, illustrations, sizes, features and finishes are subject to change without notice. E.&O.E. Areas and dimensions are approximate and actual usable floor space may vary from the stated area. Layout may be reverse of the unit purchased. E. & O.E.



GOLDPARK
HOMES

encore
BRAMPTON

Telephone (T)
Cable (C)

The
Bizet
38' SERIES

Elevation A • 2,234 sq.ft. | Elevation B • 2,222 sq.ft.

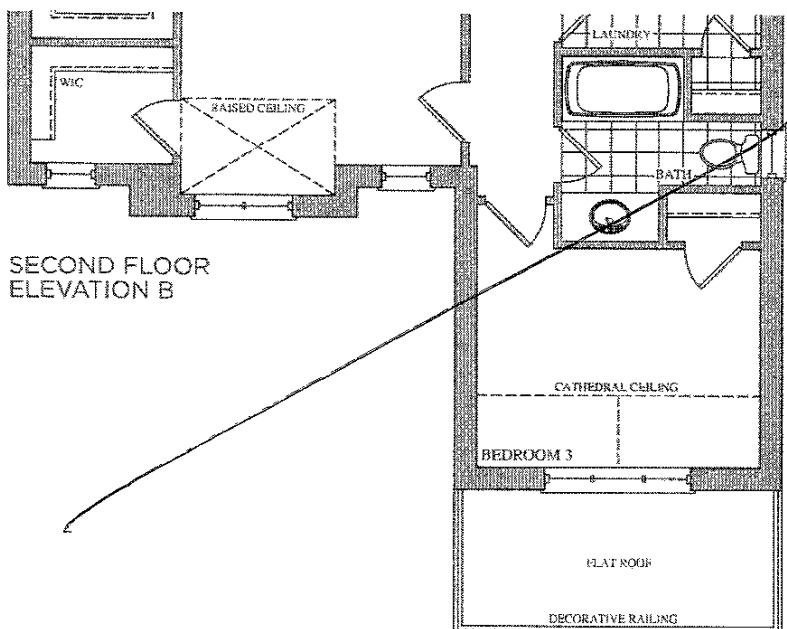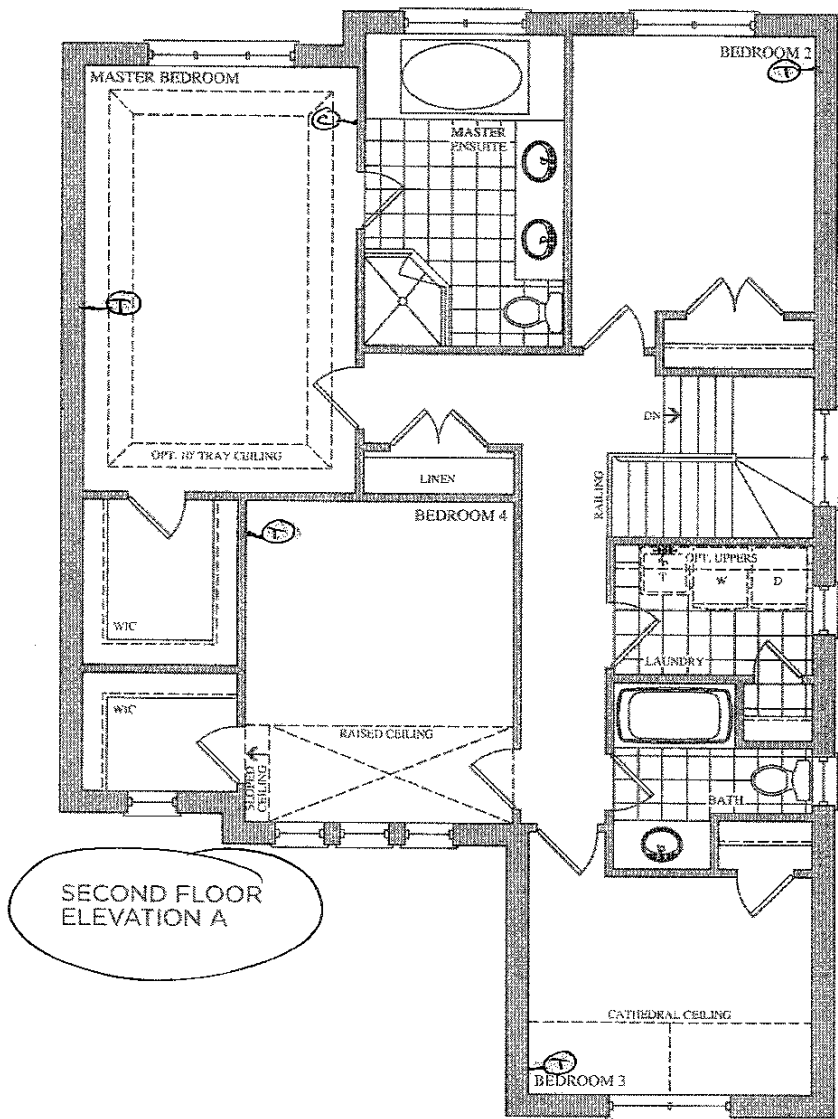

Prices, figures, illustrations, sizes, features and finishes are subject to change without notice. E.&O.E. Areas and dimensions are approximate and actual usable floor space may vary from the stated area. Layout may be reverse of the unit purchased. E. & O.E.


GOLDPARK
HOMES

BSMNT WINDOWS

2 x 30" x 24"

1 x 53" x 16"

Elevation A • 2,234 sq.ft. | Elevation B • 2,222 sq.ft.

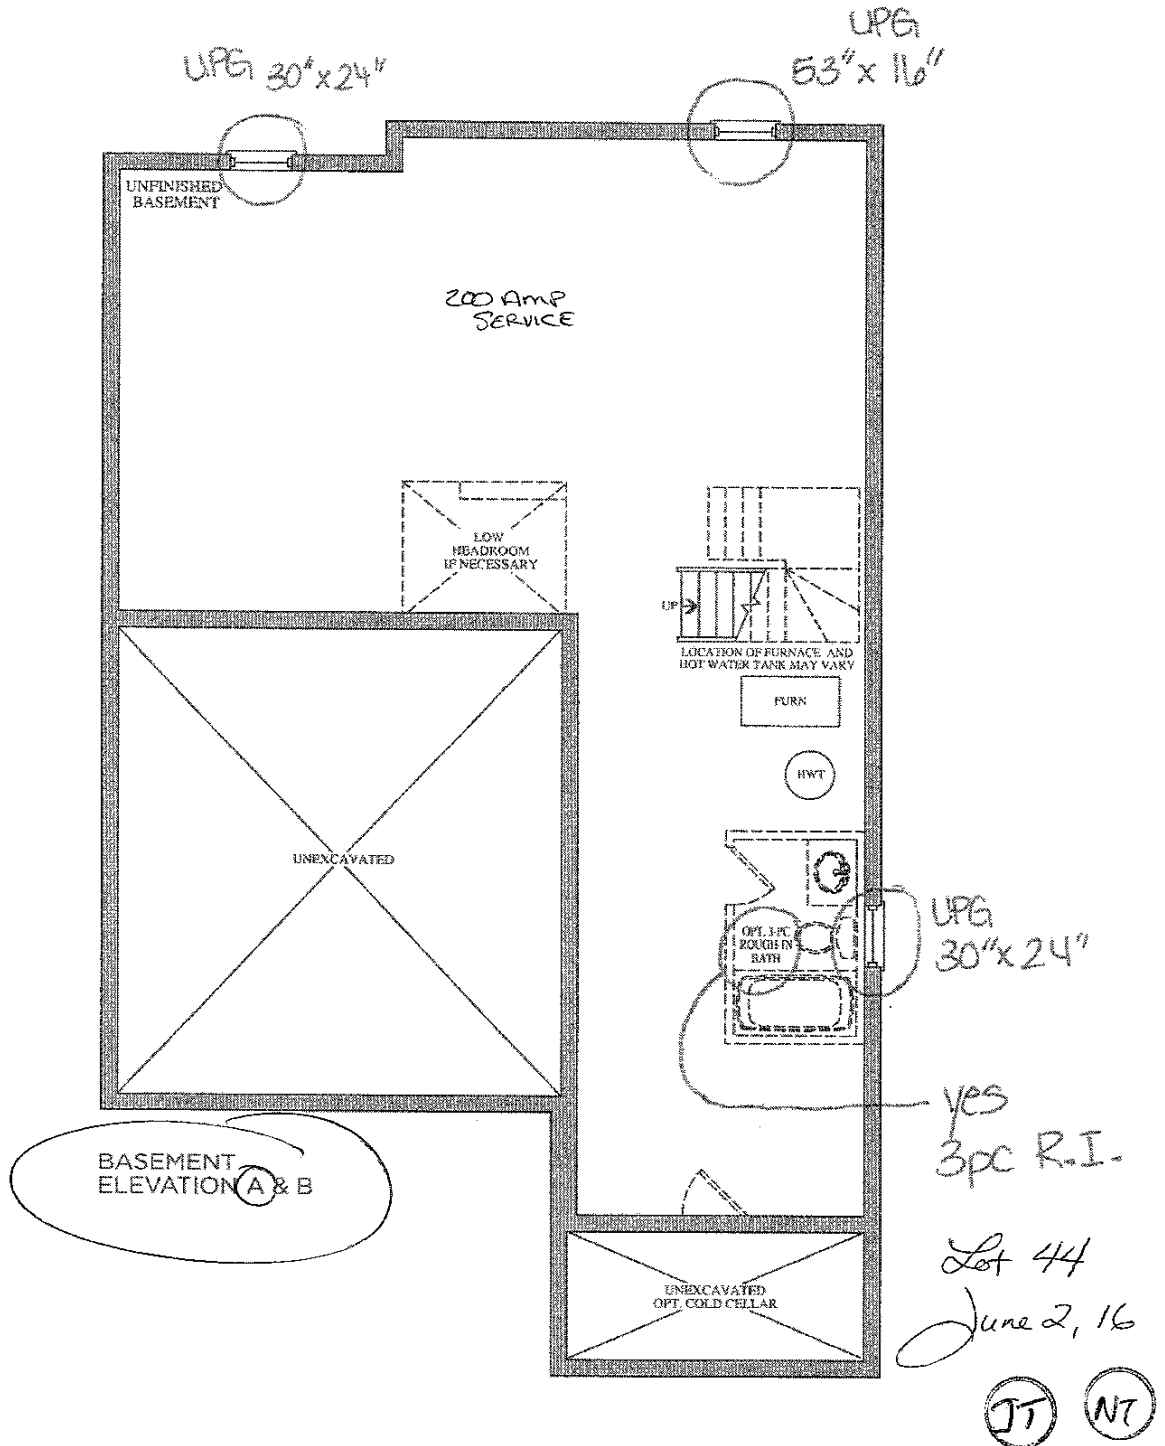



Stacey Carlete
Project Coordinator



Claude Azzopardi
Contracts Manager



Nancy Mc
Corporate

44
Lot #



38.1 The Bizet			
Elevation	Circle One	A	2189.6 Square Feet
		B	2186.7 Square Feet
Optional Layouts	Circle All that Apply		

38.2 The Ravel			
Elevation	Circle One	A	2271.5 Square Feet
		B	2273.7 Square Feet
Optional Layouts	Circle All that Apply		

38.3 The Haydn			
Elevation	Circle One	A	2394.5 Square Feet
		B	2388.3 Square Feet
Optional Layouts	Circle All that Apply		

38.4 The Vivaldi			
Elevation	Circle One	A	2459.1 Square Feet
		B	2459.1 Square Feet
Optional Layouts	Circle All that Apply		

38.5 The Handel			
Elevation	Circle One	A	2549.2 Square Feet
		B	2554.7 Square Feet
Optional Layouts	Circle All that Apply		

38.9 The Puccini			
Elevation	Circle One	A	3628.0 Square Feet
		B	3634.7 Square Feet
Optional Layouts	Circle All that Apply	GFA1	GROUND FLOOR Optional Alternative Layout

38.6 The Scarlatti			
Elevation	Circle One	A	3521.1 Square Feet
		B	3508.1 Square Feet
Optional Layouts	Circle All that Apply	GFA1	GROUND FLOOR Optional Alternative Layout

38.7 The Schubert			
Elevation	Circle One	A	3593.8 Square Feet
		B	3610.5 Square Feet
Optional Layouts	Circle All that Apply	GFA1	GROUND FLOOR Optional Alternative Layout
		SFA4	SECOND FLOOR Additional Bedroom

38.8 The Corelli			
Elevation	Circle One	A	3801.5 Square Feet
		B	3801.5 Square Feet
Optional Layouts	Circle All that Apply	GFA1	GROUND FLOOR Optional Alternative Layout
		SFA4	SECOND FLOOR Additional Bedroom w/ Ensuite

41.1 The Strauss			
Elevation	Circle One	A	2554.2 Square Feet
		B	2571.2 Square Feet
Optional Layouts	Circle All that Apply	SFA1	SECOND FLOOR Shower in Lieu of Tub B2

41.2 The Mozart			
Elevation	Circle One	A	2725.9 Square Feet
		B	2711.1 Square Feet
Optional Layouts	Circle All that Apply	SFA1	SECOND FLOOR Shower in Lieu of Tub B2

41.3 The Chopin			
Elevation	Circle One	A	2800.0 Square Feet
		B	2810.5 Square Feet
Optional Layouts	Circle All that Apply		

41.4 The Bach			
Elevation	Circle One	A	2894.4 Square Feet
		B	2894.5 Square Feet
Optional Layouts	Circle All that Apply		

41.5 The Brahms			
Elevation	Circle One	A	3948.1 Square Feet
		B	3949.1 Square Feet
Optional Layouts	Circle All that Apply	GFA1	GROUND FLOOR Optional Alternative Layout
		SFA2	SECOND FLOOR Shower in Lieu of Tub B4
		SFA3	SECOND FLOOR Optional Laundry Layout

41.6 The Verdi			
Elevation	Circle One	A	3862.5 Square Feet
		B	3866.4 Square Feet
Optional Layouts	Circle All that Apply	GFA1	GROUND FLOOR Optional Alternative Layout
		SFA3	SECOND FLOOR Optional Laundry Layout

June 2, 16

TT

NT