

Brampton Encore - 75 - 1 - 41-5 Elev.B BRAHMS OPT - GFA1
CENTRAL VAC AND WIRING

Inv.595	1 - TELEPHONE AND CABLE ROUGH-IN LOCATIONS
Line7275	NOTE: STANDARD CAT-5 IS BEING MOVED FROM BED #2, INTO THE DEN
21Jun16 / 16Nov16	Note:
Inv.595	1 - FAMILY ROOM: INSTALL CONDUIT PIPE- FOR TELEVISION- MUST SPECIFY LOCATION AND TERMINATION POINT, ABOVE FIREPLACE. SEE SKETCH
Line7276	Note:
21Jun16 / 16Nov16	
Inv.595	1 - GROUND FLOOR: INSTALL ROUGH-IN FOR EXTRA SECURITY KEY PAD IN FINISHED AREA OF GROUND FLOOR. SEE SKETCH FOR LOCATION
Line7278	Note:
21Jun16 / 16Nov16	
Inv.595	1 - KITCHEN: INSTALL VAC PAN UNDER KITCHEN SINK
Line7279	Note:
21Jun16 / 16Nov16	
Inv.595	1 - ATTIC: INSTALL CONDUIT PIPE- FROM ATTIC TO ELECTRICAL PANEL- MUST SPECIFY LOCATION AND TERMINATION POINT- PLACE CLOSE TO THE ATTIC DOOR, APPROX. 3 FEET FROM THE DOOR
Line7280	Note:
21Jun16 / 16Nov16	
Inv.595	1 - FAMILY ROOM: INSTALL ROUGH-IN FIBER OPTIC CABLE- HOME RUN TO ELECTRICAL PANEL- MUST SPECIFY LOCATION IN ROOM. SEE SKETCH
Line7281	Note:
21Jun16 / 16Nov16	
Inv.595	1 - DEN: INSTALL CAT 6 WIRING - UPGRADE AN OUTLET TO CAT 6- MUST SPECIFY LOCATION
Line7282	Note: STD. CABLE WAS MOVED HERE INSTEAD OF BED #2
21Jun16 / 16Nov16	

ELECTRICAL

Inv.595	1 - FAMILY ROOM: INSTALL 110V WALL RECEPTACLE ON DEDICATED CIRCUIT - ABOVE FIREPLACE, SEE SKETCH
Line7277	Note:
21Jun16 / 16Nov16	
Inv.595	1 - BASEMENT: INSTALL 200 AMP ELECTRICAL SERVICE
Line7283	Note:
21Jun16 / 16Nov16	
Inv.595	1 - LIVING ROOM: INSTALL ADDITIONAL STANDARD FIXTURE ON SAME SWITCH AS THE BUILDER'S STANDARD SWITCH CONTROLLED RECEPTICAL. LIVING ROOM LIGHT AND DINING ROOM LIGHT TO BE ON SEPERATE SWITCHES
Line7284	Note:
21Jun16 / 16Nov16	
Inv.595	2 - EXTERIOR: INSTALL TWO (X2) POT LIGHTS: 4 INCH LINE VOLTAGE POT LIGHT - (EXTERIOR) -EACH. SEE SKETCH
Line7305	Note:
21Jun16 / 16Nov16	

EXTERIOR COLOURS

Brampton Encore - 75 - 1 - 41-5 Elev.B BRAHMS OPT - GFA1

Inv.595	1 - EXTERIOR COLOUR PACKAGE 1
Line14143	Note:
21Jun16 / 16Nov16	

FORMING

Inv.595	1 - EXTERIOR: INSTALL SIDE DOOR- HOME TO EXTERIOR- AS PER PLAN AND GRADE PERMITTING
Line7286	Note:
21Jun16 / 16Nov16	

FRAMING

Inv.595	1 - MAIN FLOOR: INSTALL FIVE (X5) STANDARD DOOR EXTENDED HEIGHT 96" (PRICE PER DOOR) MAIN FLOOR 3 STOREY MODELS - TO GO ON CLOSETS, POWDER ROOM, AND PANTRY
Line14145	Note:
21Jun16 / 16Nov16	

Inv.595	1 - DEN: INSTALL STANDARD FRENCH DOORS EXTENDED HEIGHT 96" (PRICE PER DOOR) MAIN FLOOR 3 STOREY MODELS -
Line14146	Note:
21Jun16 / 16Nov16	

HVAC

Inv.595	1 - KITCHEN: INSTALL GAS LINE ROUGH - MAIN FLOOR - (3 STOREY MODELS), FOR STOVE
Line7299	Note:
21Jun16 / 16Nov16	

INTERIOR TRIM AND DOORS

Inv.595	5 - MAIN FLOOR: INSTALL FIVE (X5) STANDARD DOOR EXTENDED HEIGHT 96" (PRICE PER DOOR) MAIN FLOOR 3 STOREY MODELS - TO GO ON CLOSETS, POWDER ROOM, AND PANTRY
Line7300	Note:
21Jun16 / 16Nov16	

Inv.595	2 - DEN: INSTALL STANDARD FRENCH DOORS EXTENDED HEIGHT 96" (PRICE PER DOOR) MAIN FLOOR 3 STOREY MODELS -
Line7301	Note:
21Jun16 / 16Nov16	

MISC.

Inv.595	1 - GARAGE: DO NOT INSTALL MANDOOR - GARAGE TO HOUSE- GRADE DOES NOT PERMIT
Line7285	Note: GIVEN IN AGREEMENT OF PURCHASE AND SALE
21Jun16 / 16Nov16	

Inv.595	1 - BONUS PACKAGE: \$10,000.00 (INCLUDING TAXES) WORTH OF UPGRADES FROM GOLD PARK HOMES DÉCOR CENTRE IS BEING APPLIED TOWARD THE STRUCTURAL APPOINTMENT. PURCHASER HAS A REMAINING AMOUNT OF \$00 (INCLUDING TAXES) TO BE USED TOWARD THE COLOUR APPOINTMENT
Line7306	Note:
21Jun16 / 16Nov16	

Inv.595	1 - Purchasers are aware & accepts that ANY changes made to upgrades after signing this Purchasers Extra Form are subject to a minimum administration fee of \$500. PLUS a 10% holdback fee.
Line7308	Note:
21Jun16 / 16Nov16	

Brampton Encore - 75 - 1 - 41-5 Elev.B BRAHMS OPT - GFA1

Inv.595	1 - Purchaser has attended a Structural appointment at the Decor Centre & has DECLINED any additional upgrades and accepts and acknowledges that there will be no further structural changes/additions/deletions to be made upon signing on June 21, 2016
Line7307	Note:
21Jun16 / 16Nov16	

PLUMBING

Inv.595	1 - KITCHEN: INSTALL ROUGH-IN - WATERLINE FOR FRIDGE
Line7302	Note:
21Jun16 / 16Nov16	

WINDOWS - BASEMENT

Inv.595	3 - BASEMENT: INSTALL THREE (X3) BASEMENT WINDOWS - UPGRADE EXISTING BASEMENT WINDOW TO 46 INCH X 32 INCH - MAY REQUIRE INSTALLATION OF WINDOW WELL. TO BE APPROVED BY CONSTRUCTION
Line7294	Note:
21Jun16 / 16Nov16	


WINDOWS AND DOORS

Inv.595	1 - EXTERIOR: INSTALL SIDE DOOR- HOME TO EXTERIOR- AS PER PLAN AND GRADE PERMITTING
Line14144	Note:
21Jun16 / 16Nov16	

Telephone — (T)
Cable — (C)
Electrical — (E)

**The
Brahms**
41' SERIES

Elevation A • 4,038 sq.ft. | Elevation B • 4,038 sq.ft.

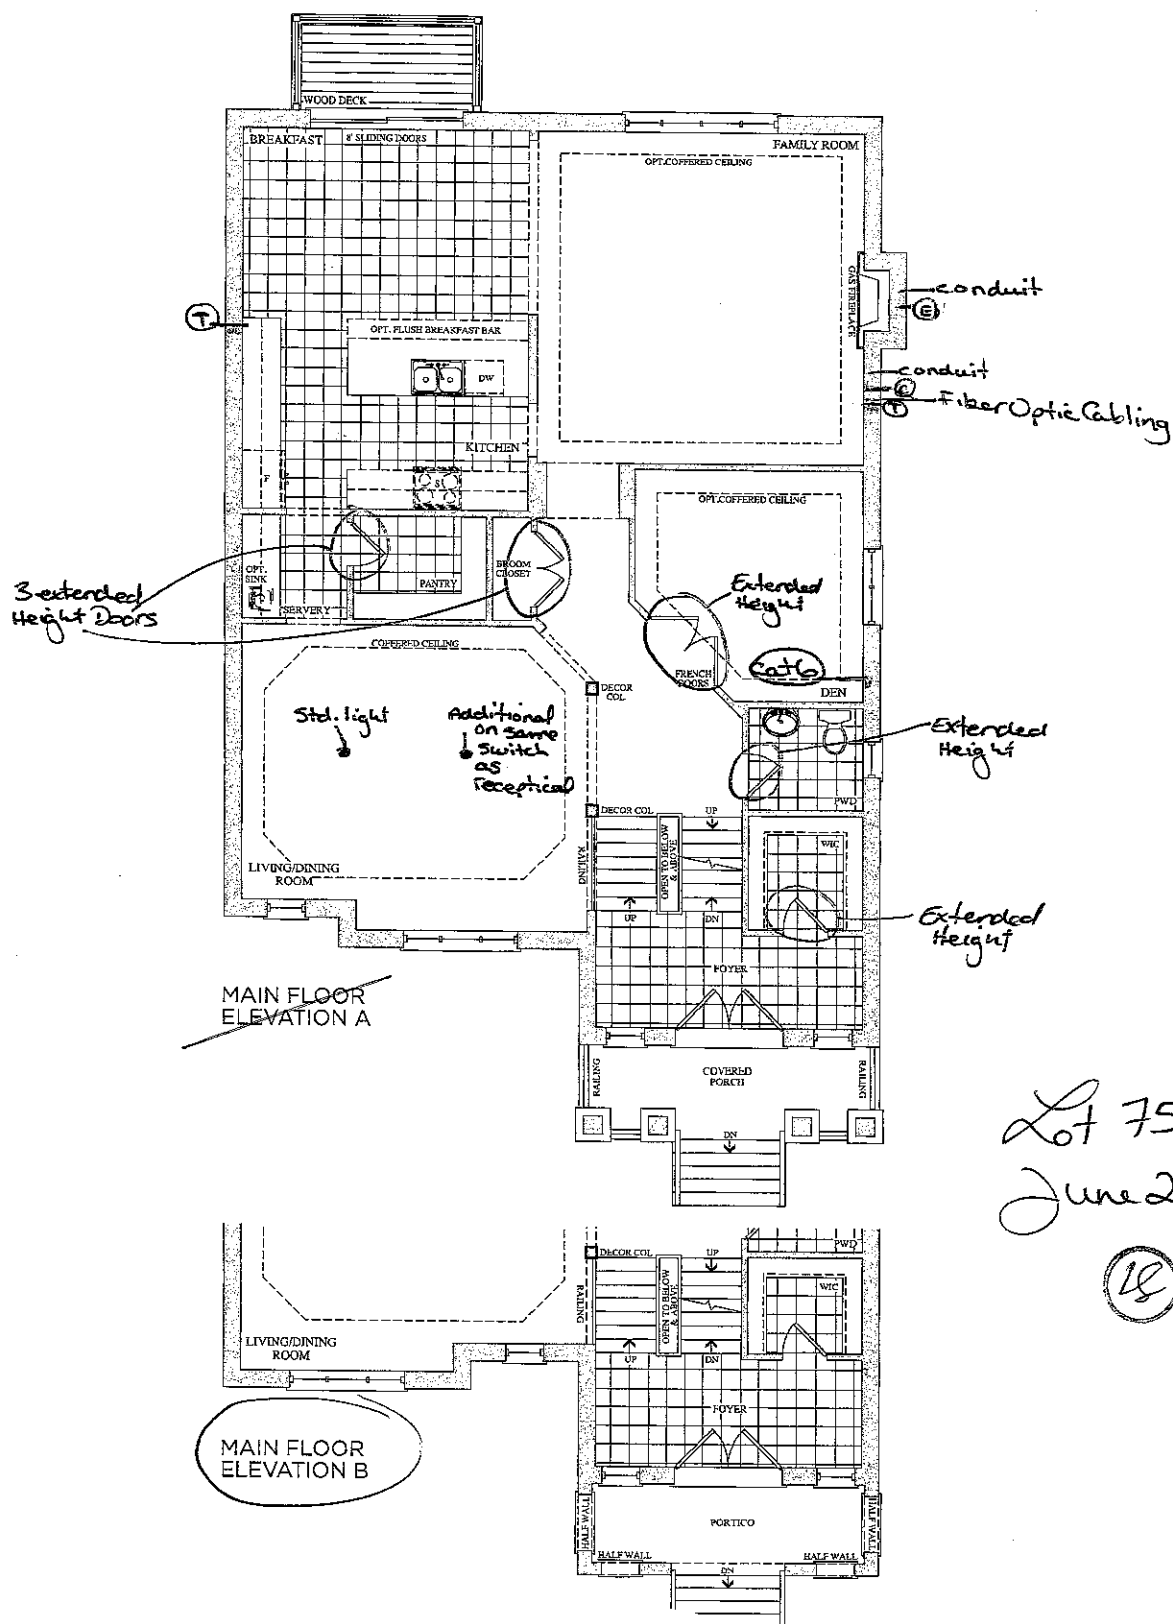

Lot 75
June 21, 16




Prices, figures, illustrations, sizes, features and finishes are subject to change without notice. E.&O.E. Areas and dimensions are approximate and actual usable floor space may vary from the stated area. Layout may be reverse of the unit purchased. E. & O.E.


GOLDPARK
HOMES

The
Brahms
41' SERIES


Elevation A • 4,038 sq.ft. | Elevation B • 4,038 sq.ft.

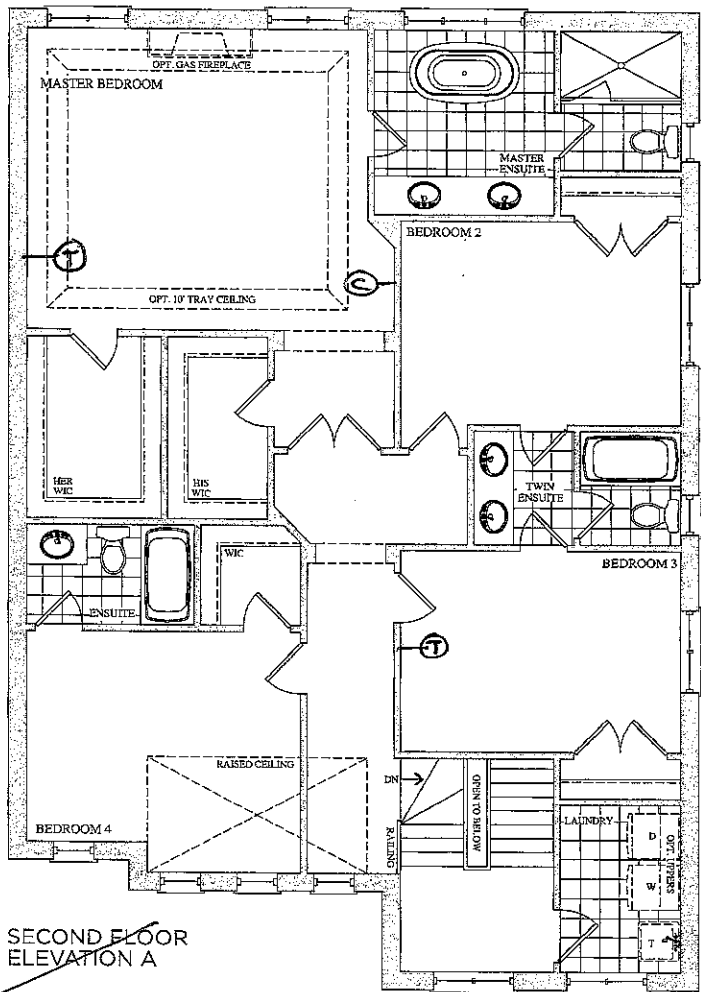

SECOND FLOOR
ELEVATION A

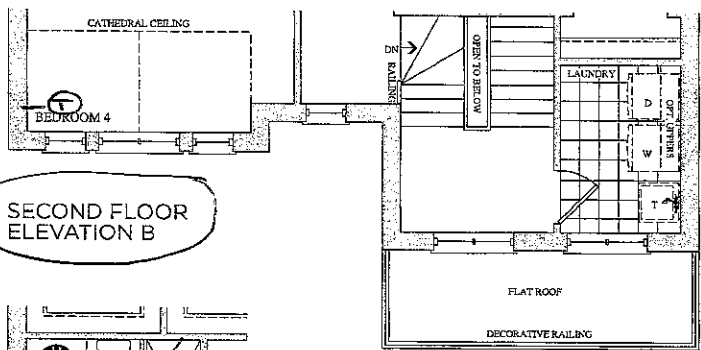

SECOND FLOOR
ELEVATION B

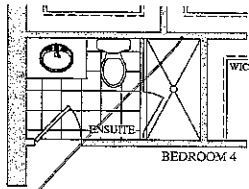

SECOND FLOOR
ELEVATION A & B
OPT. ENSUITE

Lot 75
June 21, 16


(18)

Prices, figures, illustrations, sizes, features and finishes are subject to change without notice. E&O.E. Areas and dimensions are approximate and actual usable floor space may vary from the stated area. Layout may be reverse of the unit purchased. E. & O.E.

48

**The
Brahms**
41' SERIES

Elevation A • 4,038 sq.ft. | Elevation B • 4,038 sq.ft.

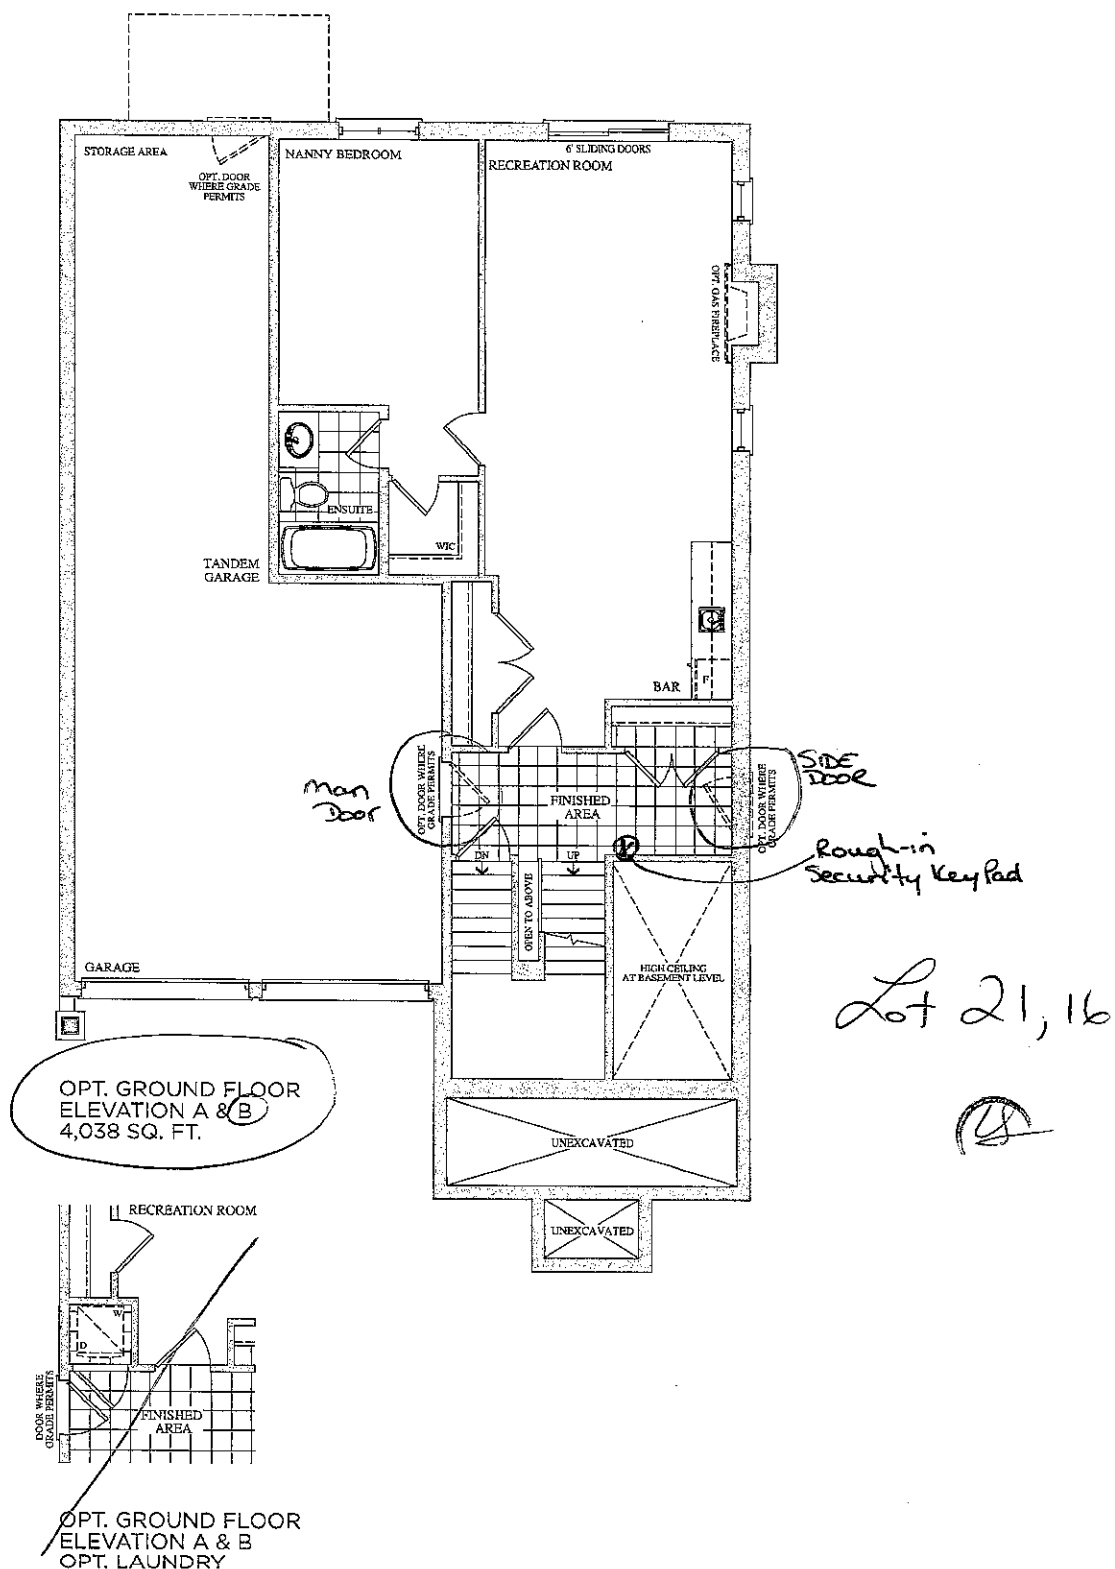


Prices, figures, illustrations, sizes, features and finishes are subject to change without notice. E.&O.E. Areas and dimensions are approximate and actual usable floor space may vary from the stated area. Layout may be reverse of the unit purchased. E. & O.E.

GOLD PARK
HOMES

4


Elevation A • 4,038 sq.ft. | Elevation B • 4,038 sq.ft.

BSMNT WINDOWS
3 x 46" x 32"

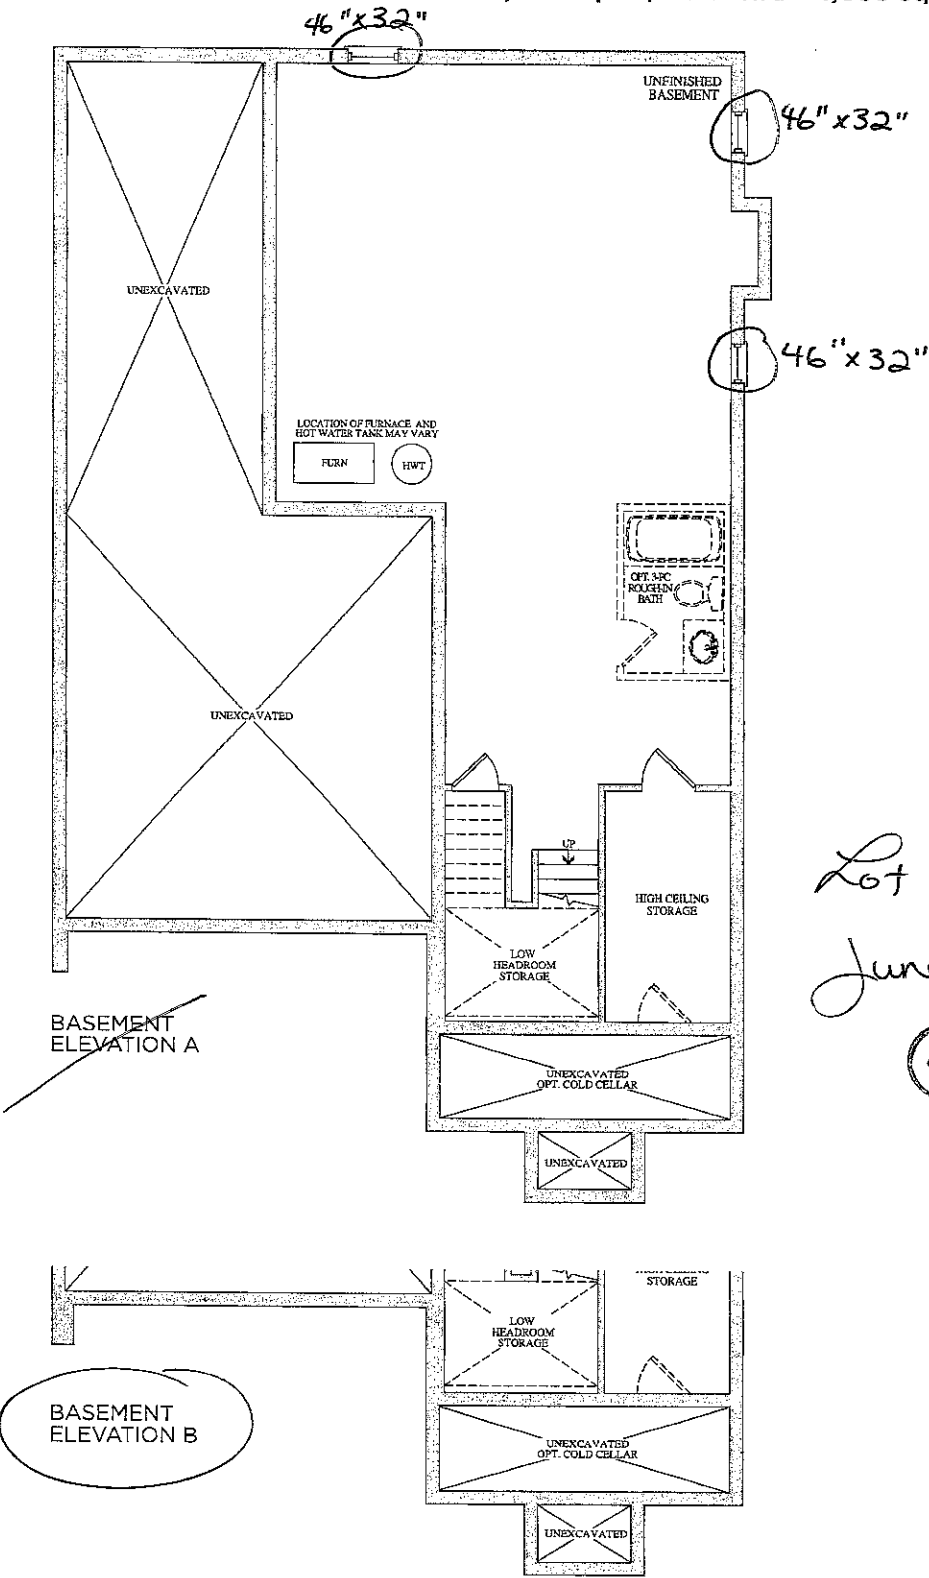

Prices, figures, illustrations, sizes, features and finishes are subject to change without notice. E.&O.E. Areas and dimensions are approximate and actual usable floor space may vary from the stated area. Layout may be reverse of the unit purchased. E. & O.E.

48

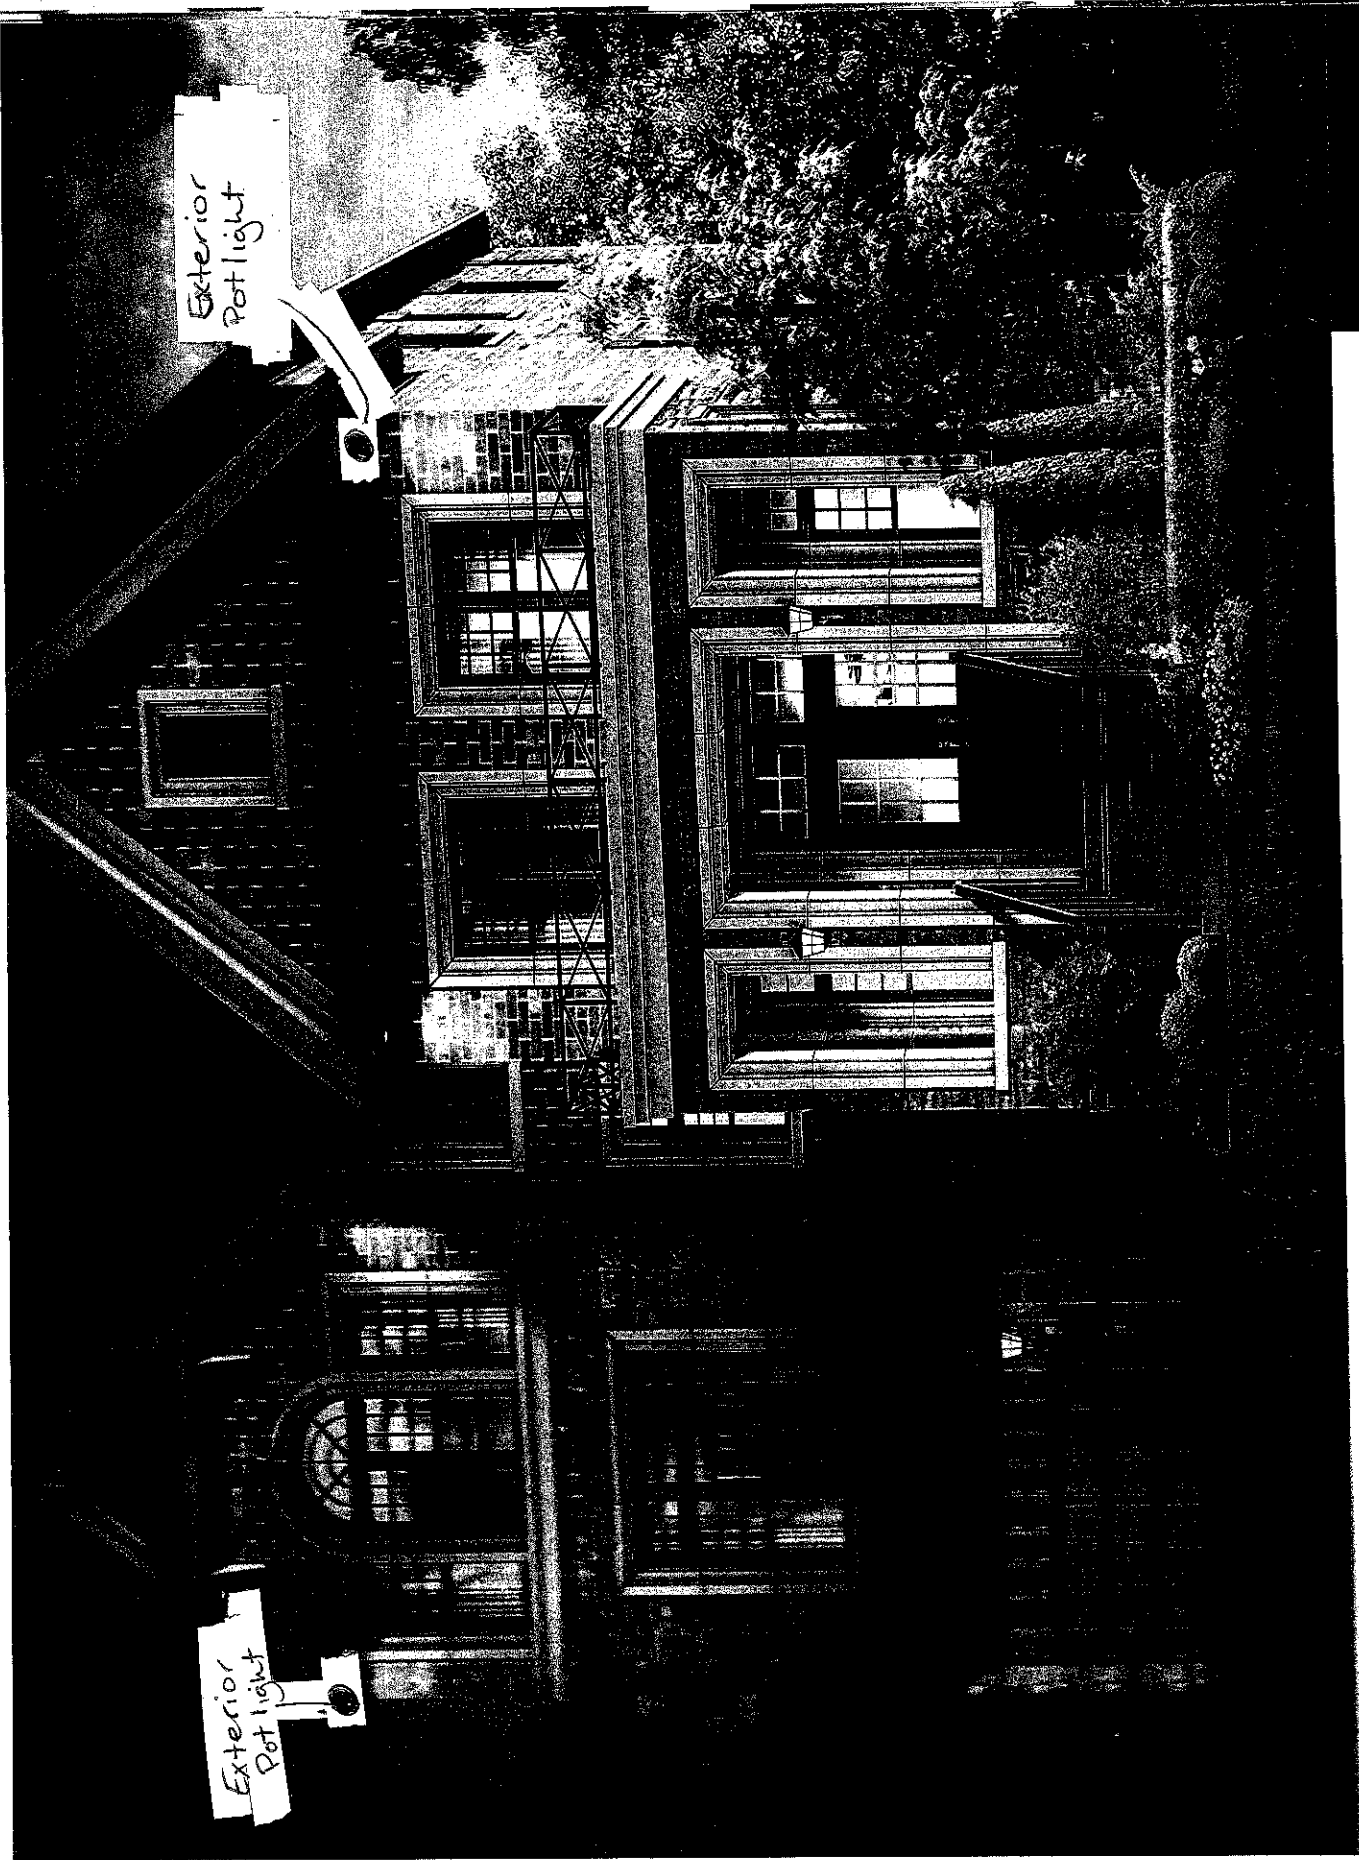

Exterior
Pot light

Exterior
Pot light

Lot 75
June 21, 16
18

Elevation B • 3,352 sq.ft.

41'
SERIES



Stacey Carlete
Project Coordinator



Claude Azzopardi
Contracts Manager



Nancy Mc
Corporate C

75
Lot #



38.1 The Bizet			
Elevation	Circle One	A	2189.6 Square Feet
		B	2186.7 Square Feet
Optional Layouts	Circle All that Apply		

38.2 The Ravel			
Elevation	Circle One	A	2271.5 Square Feet
		B	2273.7 Square Feet
Optional Layouts	Circle All that Apply		

38.3 The Haydn			
Elevation	Circle One	A	2394.5 Square Feet
		B	2388.3 Square Feet
Optional Layouts	Circle All that Apply		

38.4 The Vivaldi			
Elevation	Circle One	A	2459.1 Square Feet
		B	2459.1 Square Feet
Optional Layouts	Circle All that Apply		

38.5 The Handel			
Elevation	Circle One	A	2549.2 Square Feet
		B	2554.7 Square Feet
Optional Layouts	Circle All that Apply		

38.9 The Puccini			
Elevation	Circle One	A	3628.0 Square Feet
		B	3634.7 Square Feet
Optional Layouts	Circle All that Apply	GFA1	GROUND FLOOR Optional Alternative Layout

38.6 The Scarlatti			
Elevation	Circle One	A	3521.1 Square Feet
		B	3508.1 Square Feet
Optional Layouts	Circle All that Apply	GFA1	GROUND FLOOR Optional Alternative Layout

38.7 The Schubert			
Elevation	Circle One	A	3593.8 Square Feet
		B	3610.5 Square Feet
Optional Layouts	Circle All that Apply	GFA1	GROUND FLOOR Optional Alternative Layout
		SFA4	SECOND FLOOR Additional Bedroom

38.8 The Corelli			
Elevation	Circle One	A	3801.5 Square Feet
		B	3801.5 Square Feet
Optional Layouts	Circle All that Apply	GFA1	GROUND FLOOR Optional Alternative Layout
		SFA4	SECOND FLOOR Additional Bedroom w/ Ensuite

41.1 The Strauss			
Elevation	Circle One	A	2554.2 Square Feet
		B	2571.2 Square Feet
Optional Layouts	Circle All that Apply	SFA1	SECOND FLOOR Shower in Lieu of Tub B2

41.2 The Mozart			
Elevation	Circle One	A	2725.9 Square Feet
		B	2711.1 Square Feet
Optional Layouts	Circle All that Apply	SFA1	SECOND FLOOR Shower in Lieu of Tub B2

41.3 The Chopin			
Elevation	Circle One	A	2800.0 Square Feet
		B	2810.5 Square Feet
Optional Layouts	Circle All that Apply		

41.4 The Bach			
Elevation	Circle One	A	2894.4 Square Feet
		B	2894.5 Square Feet
Optional Layouts	Circle All that Apply		

41.5 The Brahms			
Elevation	Circle One	A	3948.1 Square Feet
		B	3949.1 Square Feet
Optional Layouts	Circle All that Apply	GFA1	GROUND FLOOR Optional Alternative Layout
		SFA2	SECOND FLOOR Shower in Lieu of Tub B4
		SFA3	SECOND FLOOR Optional Laundry Layout

41.6 The Verdi			
Elevation	Circle One	A	3862.5 Square Feet
		B	3866.4 Square Feet
Optional Layouts	Circle All that Apply	GFA1	GROUND FLOOR Optional Alternative Layout
		SFA3	SECOND FLOOR Optional Laundry Layout

June 21, 16

