

Brampton Encore - 26 - 1 - 38-7 Elev.A SCHUBERT
CENTRAL VAC AND WIRING

Inv.579	1 - TELEPHONE AND CABLE ROUGH-IN LOCATIONS
Line7041	Note:
15Jun16 / 31Oct16	
Inv.579	1 - BEDROOM #2: INSTALL RG 6 ROUGH-IN IN BEDROOM #2
Line7042	Note:
15Jun16 / 31Oct16	
Inv.579	1 - BEDROOM #3: INSTALL RG 6 ROUGH-IN IN BEDROOM #3
Line7043	Note:
15Jun16 / 31Oct16	
Inv.579	1 - BEDROOM #4: INSTALL RG 6 ROUGH-IN IN BEDROOM #4
Line7044	Note:
15Jun16 / 31Oct16	

ELECTRICAL

Inv.579	1 - KITCHEN: INSTALL 110V WALL RECEPTACLE ON DEDICATED CIRCUIT - FOR MICROWAVE - MICROWAVE NOT INCLUDED. PURCHASER IS AWARE THAT THEY MUST BUY THE APPROPRIATE CABINETRY TO ACCOMODATE THE MICROWAVE. SEE SKETCH
Line7045	Note:
15Jun16 / 31Oct16	
Inv.579	1 - KITCHEN: INSTALL KITCHEN CABINET STRIP VALANCE LIGHTS (UNDER CABINETS) - ROUGH - IN - DOES NOT INCLUDE (AND REQUIRES) KITCHEN UPGRADE PRICING
Line7046	Note:
15Jun16 / 31Oct16	
Inv.579	1 - LIVING ROOM: INSTALL INSTALL ADDITIONAL STANDARD FIXTURE WITH SWITCH IN LIVING ROOM. IN ADDITION TO BUILDER'S STANDARD SWITCH CONTROLLED RECEPTICAL
Line7138	Note:
15Jun16 / 31Oct16	
Inv.579	1 - KITCHEN: INSTALL GAS LINE ROUGH - MAIN FLOOR - (3 STOREY MODELS), FOR STOVE
Line13209	Note:
15Jun16 / 31Oct16	

EXTERIOR COLOURS

Inv.579	1 - EXTERIOR COLOUR PACKAGE 7
Line13210	Note:
15Jun16 / 31Oct16	

FRAMING

Inv.579	1 - FAMILY ROOM: INSTALL OPTIONAL COFFERED CEILING - FAMILY ROOM (PER ROOM AS PER PLAN)
Line7048	Note:
15Jun16 / 31Oct16	
Inv.579	1 - GARAGE: INSTALL MANDOOR - GARAGE TO HOUSE- AS PER PLAN AND GRADE PERMITING
Line7054	Note: DO NOT INSTALL **GRADE DOES NOT PERMIT
15Jun16 / 31Oct16	

HVAC

Brampton Encore - 26 - 1 - 38-7 Elev.A SCHUBERT


Inv.579	1 - KITCHEN: INSTALL GAS LINE ROUGH - MAIN FLOOR - (3 STOREY MODELS), FOR STOVE
Line7049	Note:
15Jun16 / 31Oct16	

MISC.

Inv.579	1 - BONUS PACKAGE: \$8028.65 (INCLUDING TAXES) WORTH OF UPGRADES FROM GOLD PARK HOMES DÉCOR CENTRE IS BEING APPLIED TOWARD THE STRUCTURAL APPOINTMENT. PURCHASER HAS A REMAINING AMOUNT OF \$1971.35 (INCLUDING TAXES) TO BE USED TOWARD THE COLOUR APPOINTMENT
Line7141	Note:
15Jun16 / 31Oct16	
Inv.579	1 - Purchaser has attended a Structural appointment at the Decor Centre & has DECLINED any additional upgrades and accepts and acknowledges that there will be no further structural changes/additions/deletions to be made upon signing on June 20, 2016
Line7142	Note:
15Jun16 / 31Oct16	
Inv.579	1 - Purchasers are aware & accepts that ANY changes made to upgrades after signing this Purchasers Extra Form are subject to a minimum administration fee of \$500. PLUS a 10% holdback fee
Line7144	Note:
15Jun16 / 31Oct16	

PLUMBING

Inv.579	1 - BASEMENT: INSTALL ROUGH-IN - 3PC BASEMENT ROUGH-IN, AS PER PLAN
Line7050	Note:
15Jun16 / 31Oct16	
Inv.579	1 - KITCHEN: INSTALL ROUGH-IN - WATERLINE FOR FRIDGE
Line7056	Note:
15Jun16 / 31Oct16	

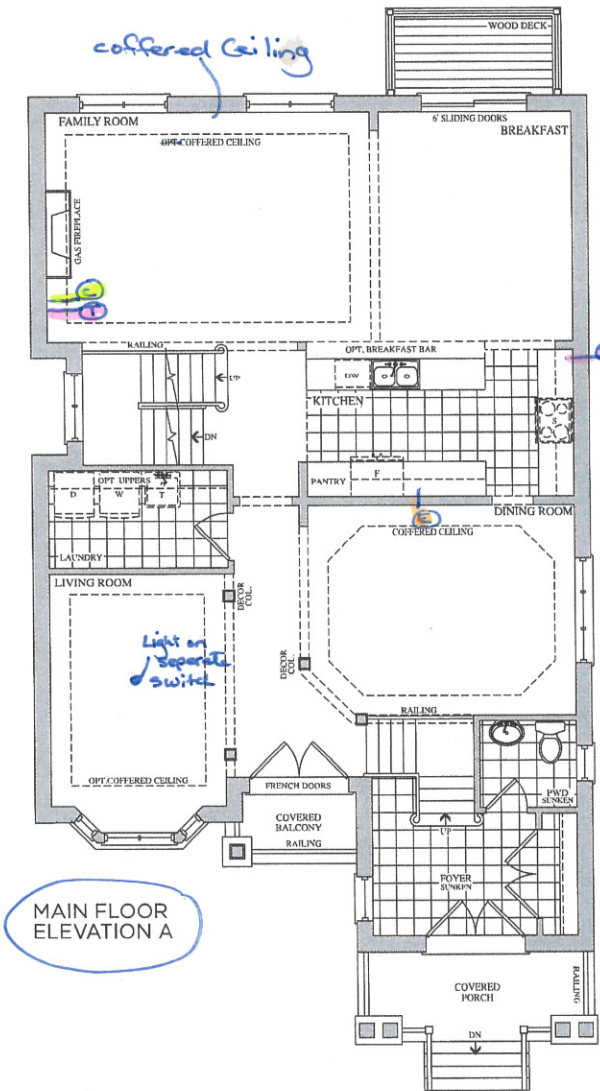


TELEPHONE — (T)

CABLE — (C)

ELECTRICAL — (E)

Lot 26
June 15, 16



B/B

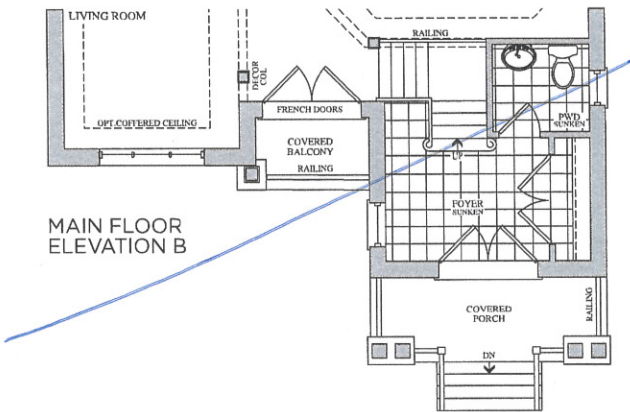

Prices, figures, illustrations, sizes, features and finishes are subject to change without notice. E.&O.E. Areas and dimensions are approximate and actual usable floor space may vary from the stated area. Layout may be reverse of the unit purchased. E. & O.E.

The
Schubert
38' SERIES


Elevation A • 3,665 sq.ft. | Elevation B • 3,683 sq.ft.

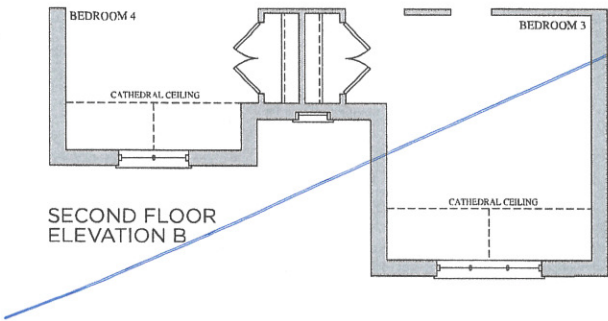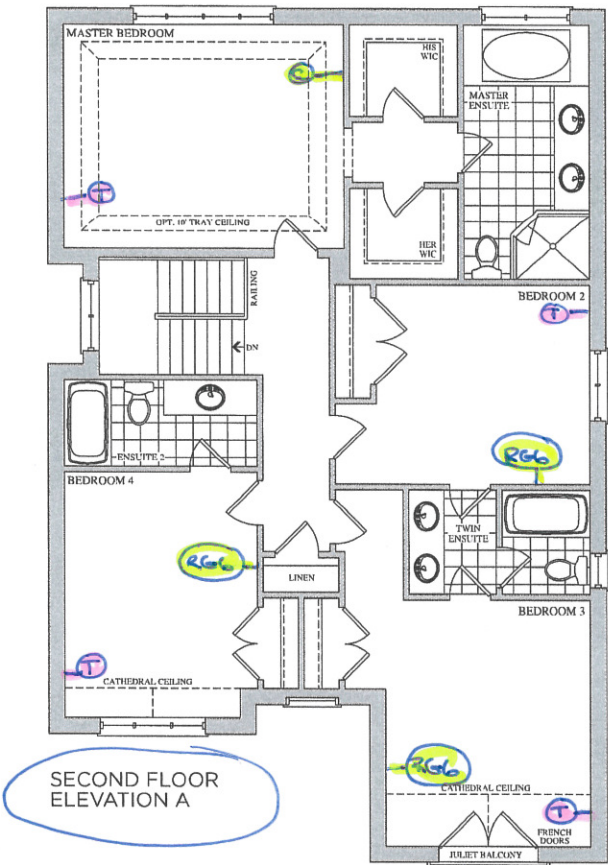

Prices, figures, illustration's sizes, features and finishes are subject to change without notice. E.&O.E. Areas and dimensions are approximate and actual usable floor space may vary from the stated area. Layout may be reverse of the unit purchased. E. & O.E.

The
Schubert
38' SERIES

Elevation A • 3,665 sq.ft. | Elevation B • 3,683 sq.ft.

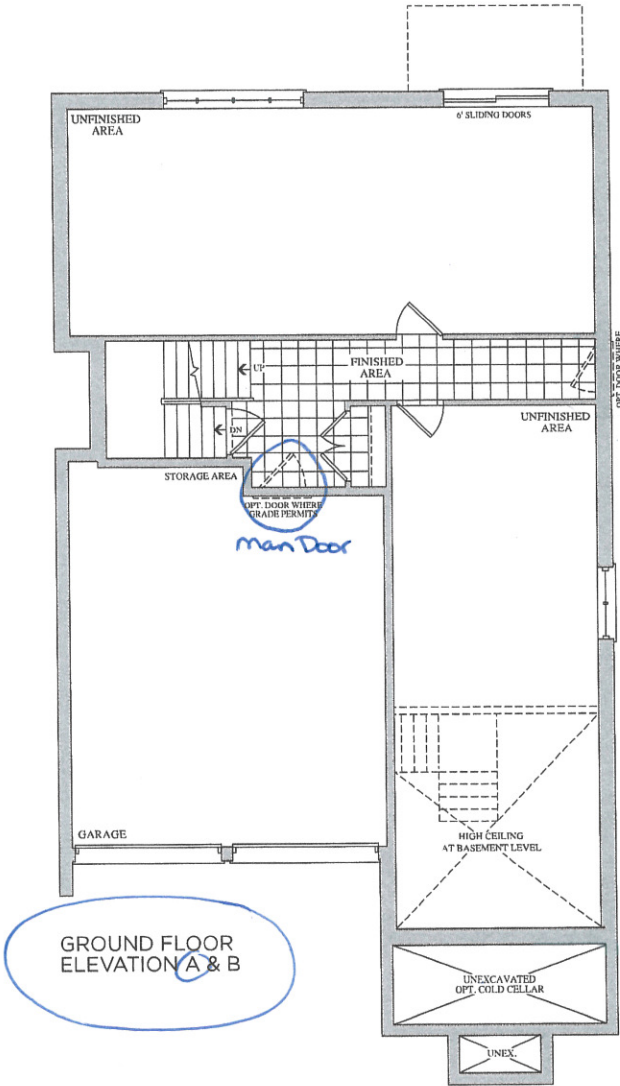

GROUND FLOOR
ELEVATION A & B


Lot 26
June 15, 16

B-6

Prices, figures, illustration's sizes, features and finishes are subject to change without notice. E.&O.E. Areas and dimensions are approximate and actual usable floor space may vary from the stated area. Layout may be reverse of the unit purchased. E. & O.E.

The
Schubert
38' SERIES

Elevation A • 3,665 sq.ft. | Elevation B • 3,683 sq.ft.

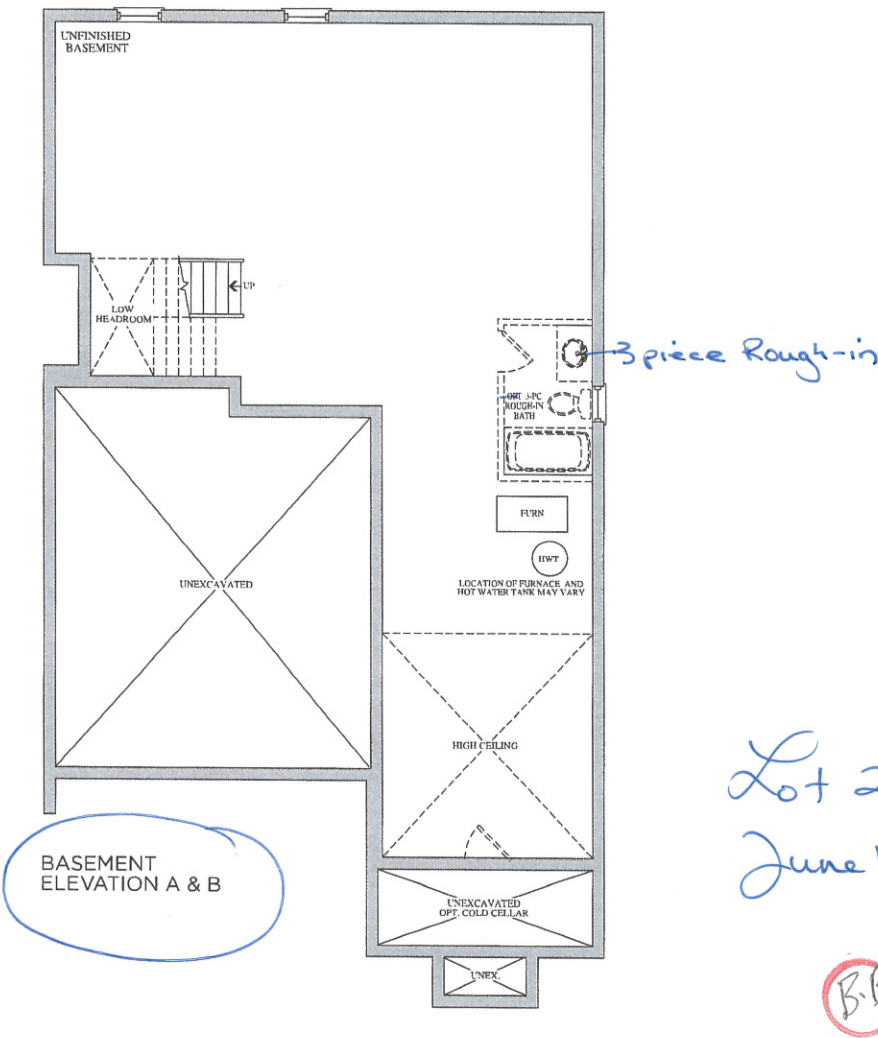

Prices, figures, illustrations, sizes, features and finishes are subject to change without notice. E.&O.E. Areas and dimensions are approximate and actual usable floor space may vary from the stated area. Layout may be reverse of the unit purchased. E. & O.E.



Stacey Carlete
Project Coordinator



Claude Azzopardi
Contracts Manager



Nancy Moore
Corporate Counsel

26
Lot #



38.1 The Bizet			
Elevation	Circle One	A	2189.6 Square Feet
		B	2186.7 Square Feet
Optional Layouts	Circle All that Apply		

38.2 The Ravel			
Elevation	Circle One	A	2271.5 Square Feet
		B	2273.7 Square Feet
Optional Layouts	Circle All that Apply		

38.3 The Haydn			
Elevation	Circle One	A	2394.5 Square Feet
		B	2388.3 Square Feet
Optional Layouts	Circle All that Apply		

38.4 The Vivaldi			
Elevation	Circle One	A	2459.1 Square Feet
		B	2459.1 Square Feet
Optional Layouts	Circle All that Apply		

38.5 The Handel			
Elevation	Circle One	A	2549.2 Square Feet
		B	2554.7 Square Feet
Optional Layouts	Circle All that Apply		

38.9 The Puccini			
Elevation	Circle One	A	3628.0 Square Feet
		B	3634.7 Square Feet
Optional Layouts	Circle All that Apply	GFA1	GROUND FLOOR Optional Alternative Layout

38.6 The Scarlatti			
Elevation	Circle One	A	3521.1 Square Feet
		B	3508.1 Square Feet
Optional Layouts	Circle All that Apply	GFA1	GROUND FLOOR Optional Alternative Layout

38.7 The Schubert			
Elevation	Circle One	A	3593.8 Square Feet
		B	3610.5 Square Feet
Optional Layouts	Circle All that Apply	GFA1	GROUND FLOOR Optional Alternative Layout
		SFA4	SECOND FLOOR Additional Bedroom
Optional Layouts	Circle All that Apply		

38.8 The Corelli			
Elevation	Circle One	A	3801.5 Square Feet
		B	3801.5 Square Feet
Optional Layouts	Circle All that Apply	GFA1	GROUND FLOOR Optional Alternative Layout
		SFA4	SECOND FLOOR Additional Bedroom w/ Ensuite
Optional Layouts	Circle All that Apply		

41.1 The Strauss			
Elevation	Circle One	A	2554.2 Square Feet
		B	2571.2 Square Feet
Optional Layouts	Circle All that Apply	SFA1	SECOND FLOOR Shower In Lieu of Tub B2

41.2 The Mozart			
Elevation	Circle One	A	2725.9 Square Feet
		B	2711.1 Square Feet
Optional Layouts	Circle All that Apply	SFA1	SECOND FLOOR Shower In Lieu of Tub B2

41.3 The Chopin			
Elevation	Circle One	A	2800.0 Square Feet
		B	2810.5 Square Feet
Optional Layouts	Circle All that Apply		

41.4 The Bach			
Elevation	Circle One	A	2894.4 Square Feet
		B	2894.5 Square Feet
Optional Layouts	Circle All that Apply		

41.5 The Brahms			
Elevation	Circle One	A	3948.1 Square Feet
		B	3949.1 Square Feet
Optional Layouts	Circle All that Apply	GFA1	GROUND FLOOR Optional Alternative Layout
		SFA2	SECOND FLOOR Shower In Lieu of Tub B4
Optional Layouts	Circle All that Apply	SFA3	SECOND FLOOR Optional Laundry Layout

41.6 The Verdi			
Elevation	Circle One	A	3862.5 Square Feet
		B	3866.4 Square Feet
Optional Layouts	Circle All that Apply	GFA1	GROUND FLOOR Optional Alternative Layout
		SFA3	SECOND FLOOR Optional Laundry Layout
Optional Layouts	Circle All that Apply		

June 15, 16
BB