

Brampton Encore - 74 - 1 - 41-1 Elev.A STRAUSS OPT - SFA1

CENTRAL VAC AND WIRING

Inv.560	1 - TELEPHONE AND CABLE ROUGH-IN LOCATIONS
Line6828	Note:
13Jun16 / 16Nov16	
Inv.560	1 - FAMILY ROOM: INSTALL CONDUIT PIPE- FOR TELEVISION- MUST SPECIFY LOCATION AND TERMINATION POINT, TO GO ABOVE FIREPLACE. SEE SKETCH
Line6829	Note:
13Jun16 / 16Nov16	

CERAMIC

Inv.560	1 - OPTIONAL ENSUITE BEDROOM 2- SHOWER IN LIEU OF TUB
Line14140	Note:
13Jun16 / 16Nov16	

ELECTRICAL

Inv.560	1 - FAMILY ROOM: INSTALL 110V WALL RECEPTACLE ON DEDICATED CIRCUIT - ABOVE FIREPLACE. SEE SKETCH
Line6830	Note:
13Jun16 / 16Nov16	
Inv.560	1 - OPTIONAL ENSUITE BEDROOM 2- SHOWER IN LIEU OF TUB
Line14142	Note:
13Jun16 / 16Nov16	

EXTERIOR COLOURS

Inv.560	1 - EXTERIOR COLOUR PACKAGE 7
Line14138	Note:
13Jun16 / 16Nov16	

FORMING

Inv.560	1 - EXTERIOR: INSTALL SIDE DOOR- HOME TO EXTERIOR- AS PER PLAN AND GRADE PERMITTING
Line6832	Note:
13Jun16 / 16Nov16	

FRAMING

Inv.560	1 - GARAGE: INSTALL MANDOOR - GARAGE TO HOUSE- AS PER PLAN AND GRADE PERMITING
Line6831	Note: GIVEN IN AGREEMENT OF PURCHASE AND SALE
13Jun16 / 16Nov16	
Inv.560	1 - OPTIONAL ENSUITE BEDROOM 2- SHOWER IN LIEU OF TUB
Line14139	Note:
13Jun16 / 16Nov16	

MISC.

Inv.560	1 - BONUS PACKAGE: \$2785.45 (INCLUDING TAXES) WORTH OF UPGRADES FROM GOLD PARK HOMES DÉCOR CENTRE IS BEING APPLIED TOWARD THE STRUCTURAL APPOINTMENT. PURCHASER HAS A REMAINING AMOUNT OF \$7214.55 (INCLUDING TAXES) TO BE USED TOWARD THE COLOUR APPOINTMENT
Line6833	Note:
13Jun16 / 16Nov16	

Brampton Encore - 74 - 1 - 41-1 Elev.A STRAUSS OPT - SFA1

Inv.560	1 - Purchaser has attended a Structural appointment at the Decor Centre & has DECLINED any additional upgrades and accepts and acknowledges that there will be no further structural changes/additions/deletions to be made upon signing on June 13, 2016
Line6834	Note:
13Jun16 / 16Nov16	
Inv.560	1 - Purchasers are aware & accepts that ANY changes made to upgrades after signing this Purchasers Extra Form are subject to a minimum administration fee of \$500. PLUS a 10% holdback fee
Line6835	Note:
13Jun16 / 16Nov16	

PLUMBING


Inv.560	1 - OPTIONAL ENSUITE BEDROOM 2- SHOWER IN LIEU OF TUB
Line14141	Note:
13Jun16 / 16Nov16	

WINDOWS AND DOORS

Inv.560	1 - GARAGE: INSTALL MANDOOR - GARAGE TO HOUSE- AS PER PLAN AND GRADE PERMITTING
Line14136	Note:
13Jun16 / 16Nov16	
Inv.560	1 - EXTERIOR: INSTALL SIDE DOOR- HOME TO EXTERIOR- AS PER PLAN AND GRADE PERMITTING
Line14137	Note:
13Jun16 / 16Nov16	

The
Strauss
41' SERIES




Elevation A • 2,607 sq.ft. | Elevation B • 2,625 sq.ft.

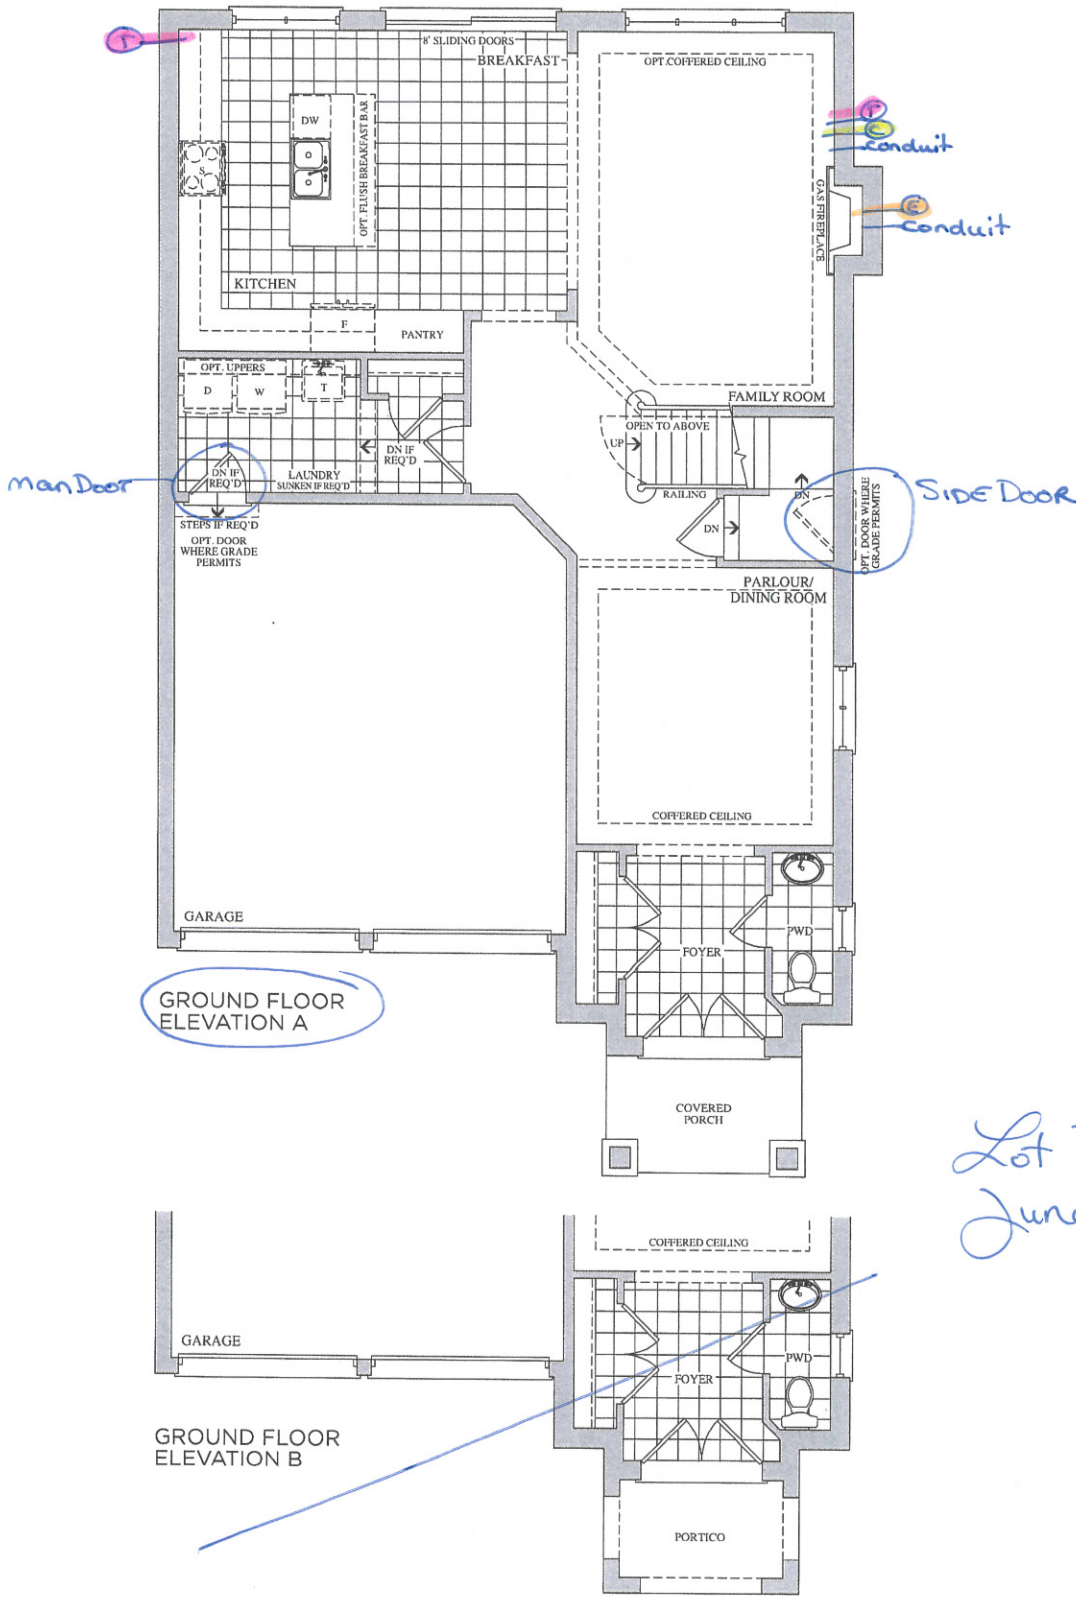

Prices, figures, illustrations, sizes, features and finishes are subject to change without notice. E.&O.E. Areas and dimensions are approximate and actual usable floor space may vary from the stated area. Layout may be reverse of the unit purchased. E. & O.E.

The Strauss 41' SERIES

Elevation A • 2,607 sq.ft. | Elevation B • 2,625 sq.ft.

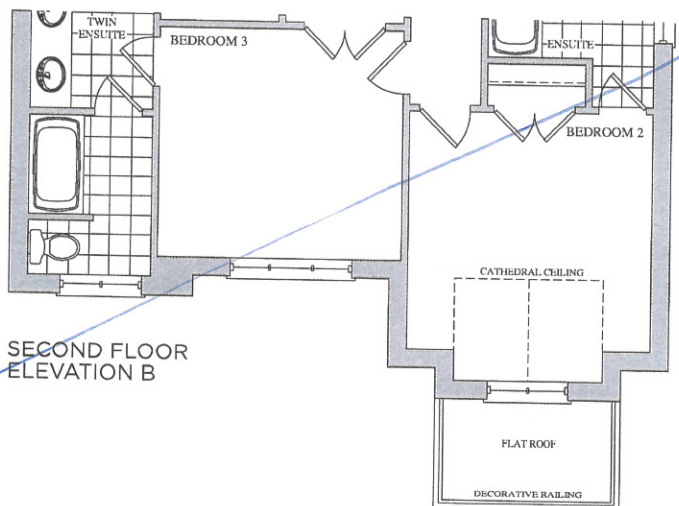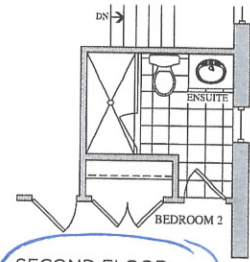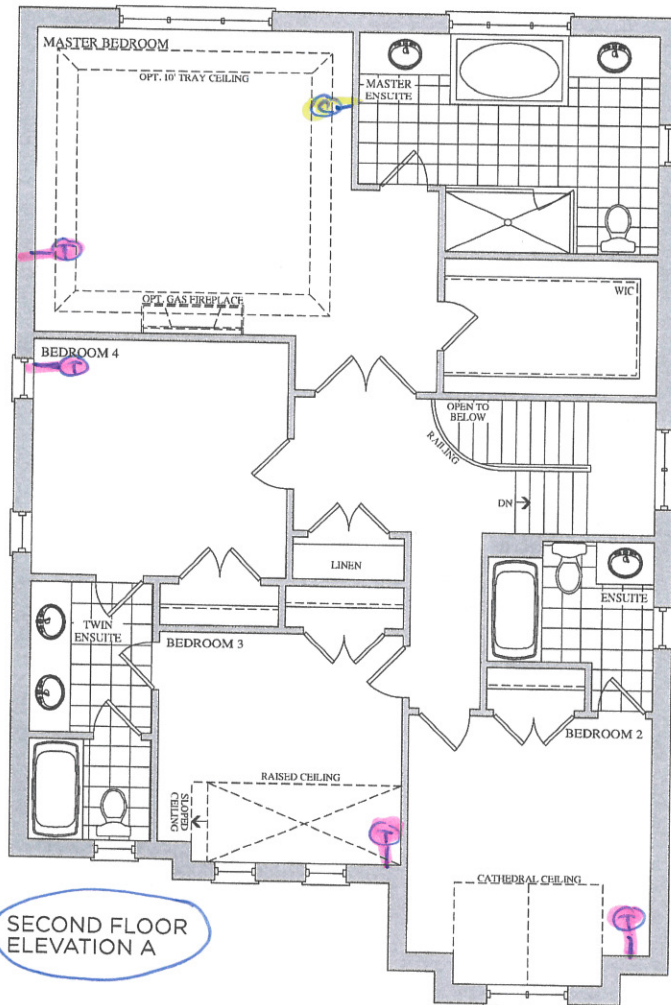


Lot 74
June 13, 16

A.M.

The
Strauss
41' SERIES

Elevation A • 2,607 sq.ft. | Elevation B • 2,625 sq.ft.

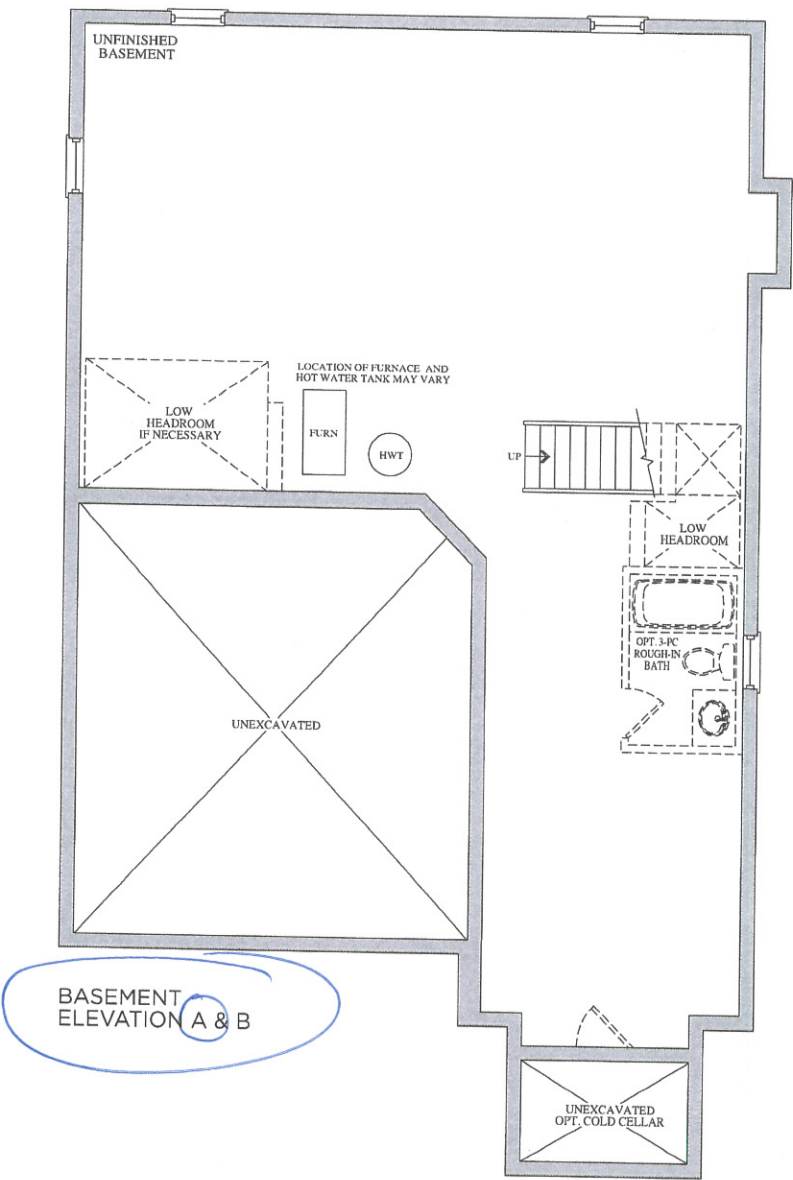

Lot 74
June 13, 16

P.M.

Prices, figures, illustrations, sizes, features and finishes are subject to change without notice. E.&O.E. Areas and dimensions are approximate and actual usable floor space may vary from the stated area. Layout may be reverse of the unit purchased. E & O.E.

GOLDPARK
HOMES



Stacey Carlete
Project Coordinator



Claude Azzopardi
Contracts Manager



Nancy Mc
Corporate C

74
Lot #



38.1 The Bizet			
Elevation	Circle One	A	2189.6 Square Feet
		B	2186.7 Square Feet
Optional Layouts	Circle All that Apply		

38.2 The Ravel			
Elevation	Circle One	A	2271.5 Square Feet
		B	2273.7 Square Feet
Optional Layouts	Circle All that Apply		

38.3 The Haydn			
Elevation	Circle One	A	2394.5 Square Feet
		B	2388.3 Square Feet
Optional Layouts	Circle All that Apply		

38.4 The Vivaldi			
Elevation	Circle One	A	2459.1 Square Feet
		B	2459.1 Square Feet
Optional Layouts	Circle All that Apply		

38.5 The Handel			
Elevation	Circle One	A	2549.2 Square Feet
		B	2554.7 Square Feet
Optional Layouts	Circle All that Apply		

38.9 The Puccini			
Elevation	Circle One	A	3628.0 Square Feet
		B	3634.7 Square Feet
Optional Layouts	Circle All that Apply	GFA1	GROUND FLOOR Optional Alternative Layout

38.6 The Scarlatti			
Elevation	Circle One	A	3521.1 Square Feet
		B	3508.1 Square Feet
Optional Layouts	Circle All that Apply	GFA1	GROUND FLOOR Optional Alternative Layout

38.7 The Schubert			
Elevation	Circle One	A	3593.8 Square Feet
		B	3610.5 Square Feet
Optional Layouts	Circle All that Apply	GFA1	GROUND FLOOR Optional Alternative Layout
		SFA4	SECOND FLOOR Additional Bedroom

38.8 The Corelli			
Elevation	Circle One	A	3801.5 Square Feet
		B	3801.5 Square Feet
Optional Layouts	Circle All that Apply	GFA1	GROUND FLOOR Optional Alternative Layout
		SFA4	SECOND FLOOR Additional Bedroom w/ Ensuite

41.1 The Strauss			
Elevation	Circle One	A	2554.2 Square Feet
		B	2571.2 Square Feet
Optional Layouts	Circle All that Apply	SFA1	SECOND FLOOR Shower in Lieu of Tub B2

41.2 The Mozart			
Elevation	Circle One	A	2725.9 Square Feet
		B	2711.1 Square Feet
Optional Layouts	Circle All that Apply	SFA1	SECOND FLOOR Shower in Lieu of Tub B2

41.3 The Chopin			
Elevation	Circle One	A	2800.0 Square Feet
		B	2810.5 Square Feet
Optional Layouts	Circle All that Apply		

41.4 The Bach			
Elevation	Circle One	A	2894.4 Square Feet
		B	2894.5 Square Feet
Optional Layouts	Circle All that Apply		

41.5 The Brahms			
Elevation	Circle One	A	3948.1 Square Feet
		B	3949.1 Square Feet
Optional Layouts	Circle All that Apply	GFA1	GROUND FLOOR Optional Alternative Layout
		SFA2	SECOND FLOOR Shower in Lieu of Tub B4
		SFA3	SECOND FLOOR Optional Laundry Layout

41.6 The Verdi			
Elevation	Circle One	A	3862.5 Square Feet
		B	3866.4 Square Feet
Optional Layouts	Circle All that Apply	GFA1	GROUND FLOOR Optional Alternative Layout
		SFA3	SECOND FLOOR Optional Laundry Layout

June 13, 16

R.M.