

Brampton Encore - 123 - 1 - 41-1 Elev.A STRAUSS
CENTRAL VAC AND WIRING

Inv.665	1 - TELEPHONE AND CABLE ROUGH-IN LOCATIONS
Line8622	Note:
14Jul16 / 16Nov16	

Inv.665	1 - FAMILY ROOM: INSTALL CONDUIT PIPE- FOR TELEVISION- ABOVE FIREPLACE. SEE SKETCH
Line8623	Note:
14Jul16 / 16Nov16	

ELECTRICAL

Inv.665	1 - BASEMENT: INSTALL 200 AMP ELECTRICAL SERVICE
Line8628	Note:
14Jul16 / 16Nov16	

Inv.665	1 - KITCHEN: ISNTALL KITCHEN CABINET STRIP VALANCE LIGHTS (UNDER CABINETS) - ROUGH - IN - DOES NOT INCLUDE (AND REQUIRES) KITCHEN UPGRADE PRICING
Line8632	Note:
14Jul16 / 16Nov16	

Inv.665	1 - FAMILY ROOM: INSTALL 110V WALL RECEPTACLE ON DEDICATED CIRCUIT - ABOVE FIREPLACE SEE SKETCH
Line8624	Note:
14Jul16 / 16Nov16	

Inv.665	1 - KITCHEN: INSTALL 110V WALL RECEPTACLE ON DEDICATED CIRCUIT - FOR MICROWAVE - MICROWAVE NOT INCLUDED. FOR FUTURE MICRO/WALL OVEN UNIT. PURCHASER IS AWARE THAT THEY MUST BUY THE APPROPRIATE CABINETRY AT THE TIME OF COLOURS. SEE SKETCH
Line8625	Note: ***NOTE: MICROWAVE GOES UNDER STOVE***
14Jul16 / 16Nov16	

Inv.665	1 - 220V WALL RECEPTICAL ON DEDICATED CIRCUIT- FOR 4 WIRE BUILT-IN WALL OVEN - INCLUDED. FOR FUTURE MICRO/WALL OVEN UNIT. PURCHASER IS AWARE THAT THEY MUST BUY THE APPROPRIATE CABINETRY AT THE TIME OF COLOURS. SEE SKETCH
Line8626	Note: ***NOTE: MICROWAVE GOES UNDER STOVE***
14Jul16 / 16Nov16	

EXTERIOR COLOURS

Inv.665	1 - EXTERIOR COLOUR PACKAGE 8
Line14125	Note:
14Jul16 / 16Nov16	

FORMING

Inv.665	1 - BASEMENT: INSTALL COLD CELLAR
Line8638	Note:
14Jul16 / 16Nov16	

FRAMING

Inv.665	1 - MASTER ENSUITE- SHOWER: INSTALL SHAMPOO SHELF IN MASTER ENSUITE SHOWER STALL
Line8642	Note:
14Jul16 / 16Nov16	

Inv.665	1 - GARAGE; INSTALL MANDOOR ROUGH-IN- OPTION ONLY AVAILABLE IF GRADE DOES NOT PERMIT - APPLIED BY HEAD OFFICE
Line8639	Note: GIVEN IN AGREEMENT OF PURCHASE AND SALE
14Jul16 / 16Nov16	

Brampton Encore - 123 - 1 - 41-1 Elev.A STRAUSS

Inv.665	1 - MASTER ENSUITE- SHOWER: INSTALL SHOWER STALL SEAT
Line8641	Note:
14Jul16 / 16Nov16	
Inv.665	1 - MASTER ENSUITE: UPGRADE TO FREE STANDING TUB - UPG1 ONLY- NOT AVAILABLE ON 41-5 AND 41-6
Line14127	Note:
14Jul16 / 16Nov16	
Inv.665	1 - MAIN FLOOR: INSTALL SIX (X6) STANDARD DOOR EXTENDED HEIGHT 96" (PRICE PER DOOR)- GROUND FLOOR 2 STOREY MODELS. FOR CLOSETS, POWDER ROOM BASEMENT AND LAUNDRY ROOM
Line14128	Note:
14Jul16 / 16Nov16	

INTERIOR TRIM AND DOORS

Inv.665	6 - MAIN FLOOR: INSTALL SIX (X6) STANDARD DOOR EXTENDED HEIGHT 96" (PRICE PER DOOR)- GROUND FLOOR 2 STOREY MODELS. FOR CLOSETS, POWDER ROOM BASEMENT AND LAUNDRY ROOM
Line8645	Note:
14Jul16 / 16Nov16	

MISC.

Inv.665	1 - BONUS PACKAGE: \$10,000.00 (INCLUDING TAXES) WORTH OF UPGRADES FROM GOLD PARK HOMES DÉCOR CENTRE IS BEING APPLIED TOWARD THE STRUCTURAL APPOINTMENT. PURCHASER HAS A REMAINING AMOUNT OF \$00 (INCLUDING TAXES) TO BE USED TOWARD THE COLOUR APPOINTMENT
Line8650	Note:
14Jul16 / 16Nov16	
Inv.665	1 - Purchaser has attended a Structural appointment at the Decor Centre & has DECLINED any additional upgrades and accepts and acknowledges that there will be no further structural changes/additions/deletions to be made upon signing on July 14, 2016
Line8651	Note:
14Jul16 / 16Nov16	
Inv.665	1 - Purchasers are aware & accepts that ANY changes made to upgrades after signing this Purchasers Extra Form are subject to a minimum administration fee of \$500. PLUS a 10% holdback fee
Line8652	Note:
14Jul16 / 16Nov16	
Inv.665	1 - ELECTRICAL FOR APPLIANCES: *PLEASE NOTE: PRICE ABOVE MAY CHANGE. PURCHASER(S) TO PROVIDE PROPER APPLIANCE SPECIFICATIONS TO PRICE APPLICABLE ELECTRICAL ACCORDINGLY
Line8655	Note:
14Jul16 / 16Nov16	

PLUMBING

Inv.665	1 - BASEMENT: INSTALL ROUGH-IN - 3PC BASEMENT ROUGH-IN
Line8649	Note:
14Jul16 / 16Nov16	
Inv.665	1 - MASTER ENSUITE: UPGRADE TO FREE STANDING TUB - UPG1 ONLY- NOT AVAILABLE ON 41-5 AND 41-6 PURCHASER TO SELECT TUB AT THE COLOUR APPOINTMENT
Line8654	Note:
14Jul16 / 16Nov16	

WINDOWS AND DOORS

Brampton Encore - 123 - 1 - 41-1 Elev.A STRAUSS

Inv.665	1 - GARAGE; INSTALL MANDOOR ROUGH-IN- OPTION ONLY AVAILABLE IF GRADE DOES NOT PERMIT - APPLIED BY HEAD OFFICE
Line14126	Note:
14Jul16 / 16Nov16	

Telephone (T)

Cable (C)



Electrical (E)

The Strauss 41' SERIES

Elevation A • 2,607 sq.ft. | Elevation B • 2,625 sq.ft.

* Plug for microwave is below wall oven

Wall oven & microwave

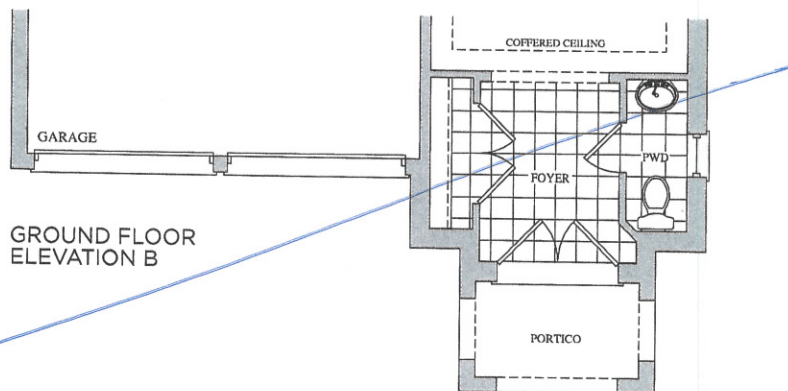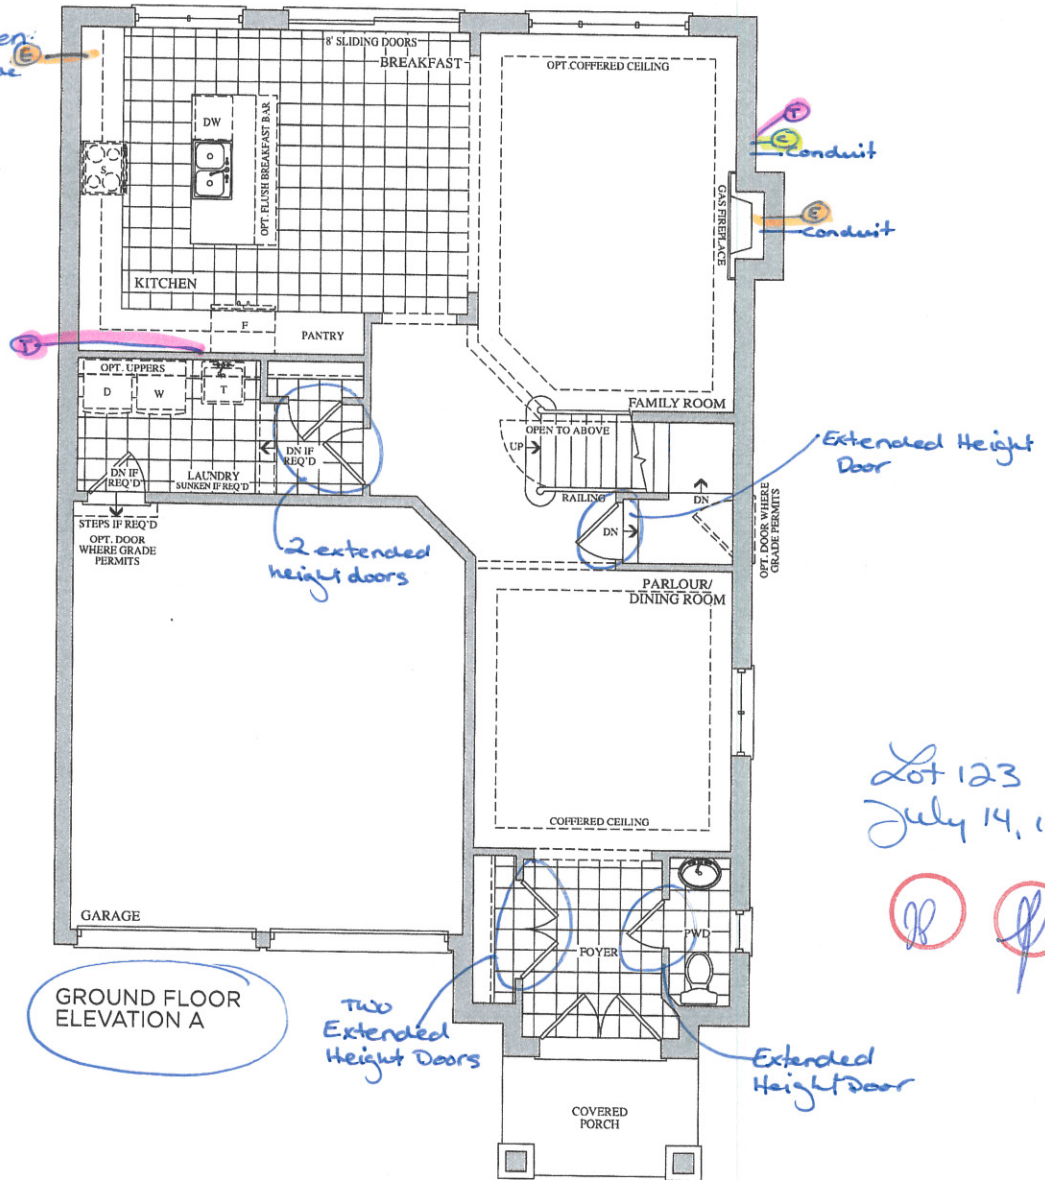

Lot 123
July 14, 16

RB

PK



Prices, figures, illustrations, sizes, features and finishes are subject to change without notice. E.&O.E. Areas and dimensions are approximate and actual usable floor space may vary from the stated area. Layout may be reverse of the unit purchased. E. & O.E.

GOLDPARK
HOMES


Telephone — (T)
Cable — (C)

The
Strauss
41' SERIES

Elevation A • 2,607 sq.ft. | Elevation B • 2,625 sq.ft.

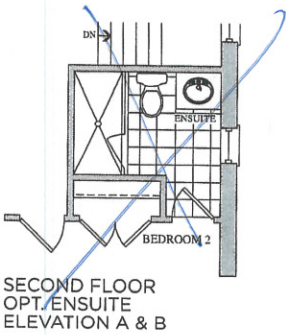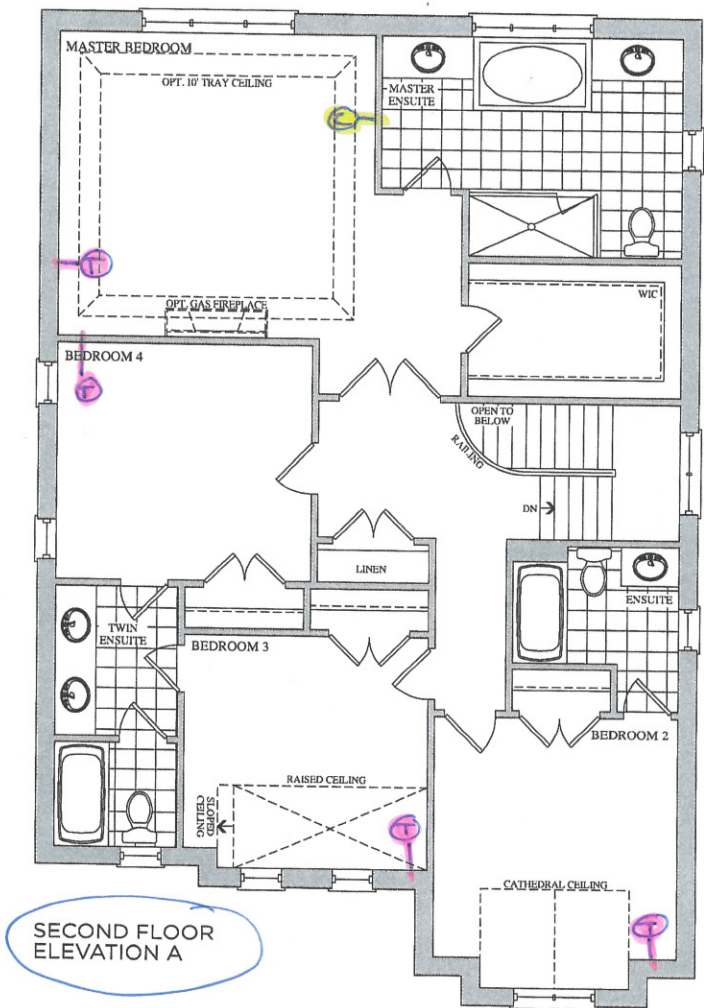


Lot 123
July 14, 16

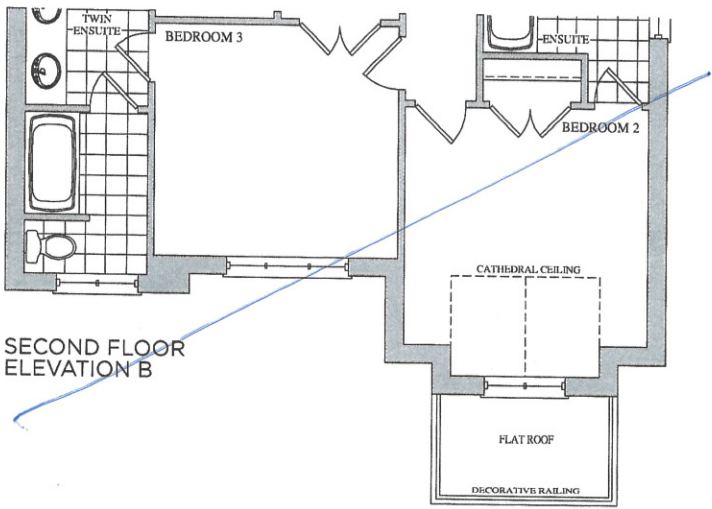

Prices, figures, illustrations, sizes, features and finishes are subject to change without notice. E&O.E. Areas and dimensions are approximate and actual usable floor space may vary from the stated area. Layout may be reverse of the unit purchased. E. & O.E.

The
Strauss
41' SERIES

Elevation A • 2,607 sq.ft. | Elevation B • 2,625 sq.ft.

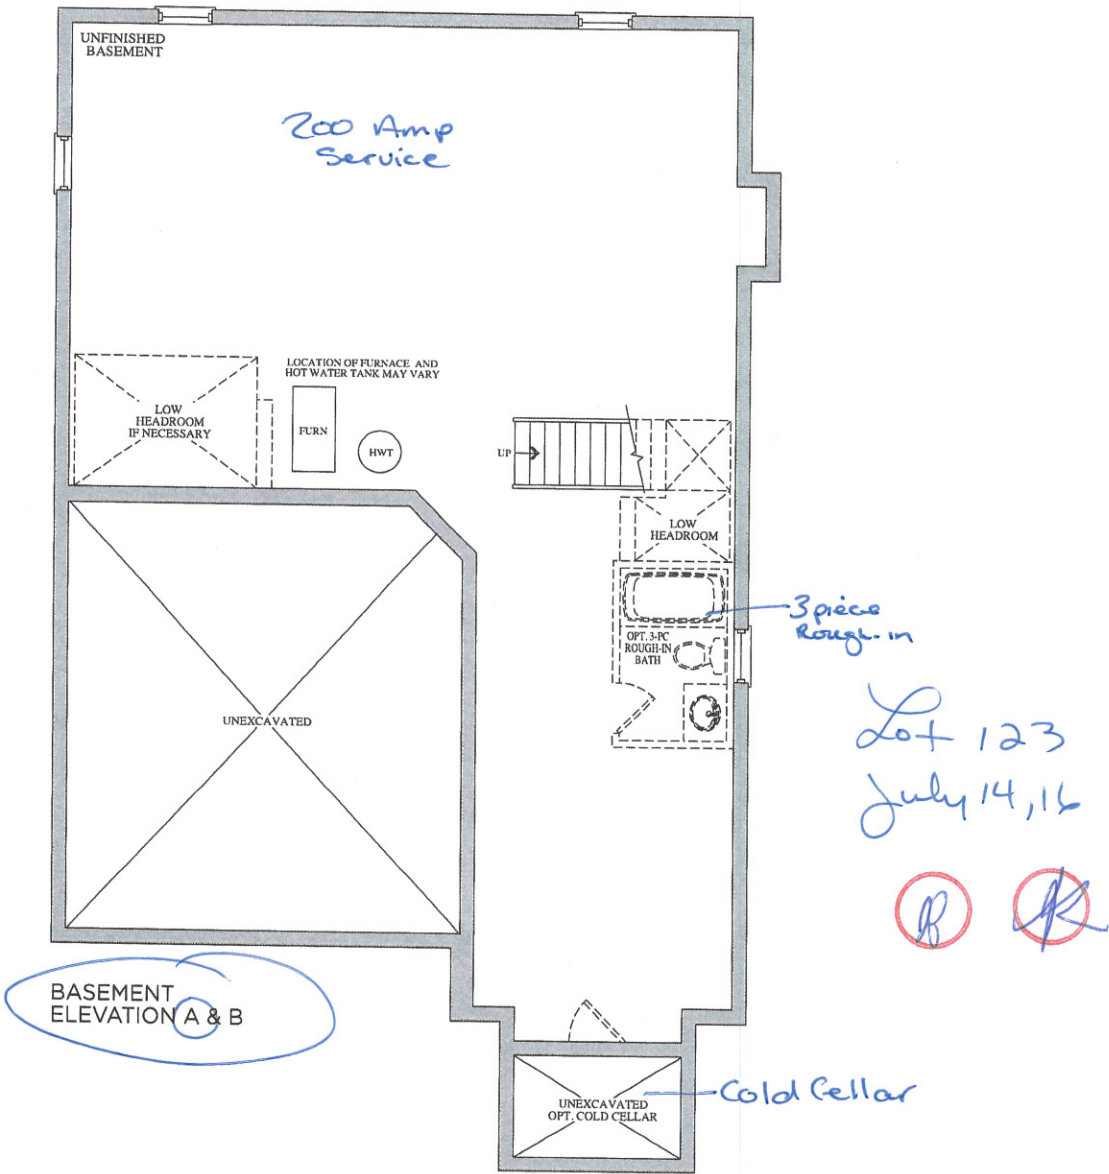

Prices, figures, illustrations, sizes, features and finishes are subject to change without notice. E.&O.E. Areas and dimensions are approximate and actual usable floor space may vary from the stated area. Layout may be reverse of the unit purchased. E. & O.E.



Stacey Carlete
Project Coordinator



Claude Azzopardi
Contracts Manager



Nancy Mc
Corporate C

123
Lot #



38.1 The Bizet			
Elevation	Circle One	A	2189.6 Square Feet
		B	2186.7 Square Feet
Optional Layouts	Circle All that Apply		

38.2 The Ravel			
Elevation	Circle One	A	2271.5 Square Feet
		B	2273.7 Square Feet
Optional Layouts	Circle All that Apply		

38.3 The Haydn			
Elevation	Circle One	A	2394.5 Square Feet
		B	2388.3 Square Feet
Optional Layouts	Circle All that Apply		

38.4 The Vivaldi			
Elevation	Circle One	A	2459.1 Square Feet
		B	2459.1 Square Feet
Optional Layouts	Circle All that Apply		

38.5 The Handel			
Elevation	Circle One	A	2549.2 Square Feet
		B	2554.7 Square Feet
Optional Layouts	Circle All that Apply		

38.9 The Puccini			
Elevation	Circle One	A	3628.0 Square Feet
		B	3634.7 Square Feet
Optional Layouts	Circle All that Apply	GFA1	GROUND FLOOR Optional Alternative Layout

38.6 The Scarlatti			
Elevation	Circle One	A	3521.1 Square Feet
		B	3508.1 Square Feet
Optional Layouts	Circle All that Apply	GFA1	GROUND FLOOR Optional Alternative Layout

38.7 The Schubert			
Elevation	Circle One	A	3593.8 Square Feet
		B	3610.5 Square Feet
Optional Layouts	Circle All that Apply	GFA1	GROUND FLOOR Optional Alternative Layout
		SFA4	SECOND FLOOR Additional Bedroom

38.8 The Corelli			
Elevation	Circle One	A	3801.5 Square Feet
		B	3801.5 Square Feet
Optional Layouts	Circle All that Apply	GFA1	GROUND FLOOR Optional Alternative Layout
		SFA4	SECOND FLOOR Additional Bedroom w/ Ensuite

41.1 The Strauss			
Elevation	Circle One	A	2554.2 Square Feet
		B	2571.2 Square Feet
Optional Layouts	Circle All that Apply	SFA1	SECOND FLOOR Shower In Lieu of Tub B2

41.2 The Mozart			
Elevation	Circle One	A	2725.9 Square Feet
		B	2711.1 Square Feet
Optional Layouts	Circle All that Apply	SFA1	SECOND FLOOR Shower In Lieu of Tub B2

41.3 The Chopin			
Elevation	Circle One	A	2800.0 Square Feet
		B	2810.5 Square Feet
Optional Layouts	Circle All that Apply		

41.4 The Bach			
Elevation	Circle One	A	2894.4 Square Feet
		B	2894.5 Square Feet
Optional Layouts	Circle All that Apply		

41.5 The Brahms			
Elevation	Circle One	A	3948.1 Square Feet
		B	3949.1 Square Feet
Optional Layouts	Circle All that Apply	GFA1	GROUND FLOOR Optional Alternative Layout
		SFA2	SECOND FLOOR Shower In Lieu of Tub B4
		SFA3	SECOND FLOOR Optional Laundry Layout

41.6 The Verdi			
Elevation	Circle One	A	3862.5 Square Feet
		B	3866.4 Square Feet
Optional Layouts	Circle All that Apply	GFA1	GROUND FLOOR Optional Alternative Layout
		SFA3	SECOND FLOOR Optional Laundry Layout

July 14, 16

PR