

Brampton Encore - 126 - 1 - 41-6 Elev.A VERDI OPT - GAF1 AND SFA3
CENTRAL VAC AND WIRING

Inv.637	1 - TELEPHONE AND CABLE ROUGH-IN LOCATIONS
Line8080	Note: NOTE: STANDARD CAT 5 HAS BEEN MOVED FROM BED #4, INTO THE DEN. SEE SKETCH
7Jul16 / 15Nov16	
Inv.637	1 - DEN: INSTALL RG 6 ROUGH-IN DEN. SEE SKETCH
Line8094	Note:
7Jul16 / 15Nov16	
Inv.637	1 - GROUND FLOOR-REC ROOM: INSTALL RG 6 ROUGH-IN REC ROOM. SEE SKETCH
Line8095	Note:
7Jul16 / 15Nov16	
Inv.637	1 - FAMILY ROOM: INSTALL CONDUIT PIPE- FOR TELEVISION- IN FAMILY ROOM, SEE SKETCH
Line8096	Note:
7Jul16 / 15Nov16	
Inv.637	1 - KITCHEN: INSTALL VAC PAN UNDER KITCHEN SINK
Line8098	Note:
7Jul16 / 15Nov16	
Inv.637	1 - GROUND FLOOR-MAN DOOR: INSTALL ROUGH-IN FOR EXTRA SECURITY KEY PAD BY MAN DOOR.
Line8099	Note:
7Jul16 / 15Nov16	
Inv.637	1 - FAMILY ROOM: INSTALL ROUGH-IN FIBER OPTIC CABLE- HOME RUN TO ELECTRICAL PANEL- IN FAMILY ROOM
Line8100	Note:
7Jul16 / 15Nov16	
Inv.637	1 - ATTIC: INSTALL CONDUIT PIPE- FROM ATTIC TO ELECTRICAL PANEL- MUST SPECIFY LOCATION AND TERMINATION POINT. CLOSE TO THE FRONT OF THE HOUSE
Line8101	Note:
7Jul16 / 15Nov16	
Inv.637	1 - MASTER BEDROOM: INSTALL ROUGH-IN FOR EXTRA SECURITY KEY PAD, IN MASTER BEDROOM
Line8140	Note:
7Jul16 / 15Nov16	

ELECTRICAL

Inv.637	1 - FAMILY ROOM: INSTALL 110V WALL RECEPTACLE ON DEDICATED CIRCUIT - ABOVE FIREPLACE SEE SKETCH
Line8097	Note:
7Jul16 / 15Nov16	
Inv.637	1 - KITCHEN: INSTALL 110V WALL RECEPTACLE ON DEDICATED CIRCUIT - FOR MICROWAVE - MICROWAVE NOT INCLUDED. SEE SKETCH. PURCHASER MUST BUY APPROPRIATE CABINETRY AT THE TIME OF COLOURS.
Line8102	Note:
7Jul16 / 15Nov16	
Inv.637	1 - BASEMENT: INSTALL 200 AMP ELECTRICAL SERVICE
Line8103	Note:
7Jul16 / 15Nov16	

Brampton Encore - 126 - 1 - 41-6 Elev.A VERDI OPT - GAF1 AND SFA3

Inv.637	1 - LIVING ROOM: INSTALL ADDITIONAL STANDARD FIXTURE WITH SWITCH - IN LIVING ROOM. SEE SKETCH. IN ADDITION TO BUILDER'S STANDARD SWITCH CONTROLLED RECEPTICAL
Line8104	Note:
7Jul16 / 15Nov16	
Inv.637	1 - LIVING ROOM: INSTALL ROUGH - IN FOR WALL OUTLET (SCONCE) & SWITCH (WITH COVER PLATE) - DOES NOT INCLUDE FIXTURE - IN LIVING ROOM, SEVEN (7) ABOVE FINISHED FLOOR. SEE SKETCH.
Line8105	Note:
7Jul16 / 15Nov16	
Inv.637	1 - GROUND FLOOR-REC ROOM: INSTALL 220V WALL RECEPTICAL ON DEDICATED CIRCUIT-FOR FUTURE OVEN -
	MOVE LOCATION OF ELECTRICAL FOR FRIDGE . SEE SKETCH
Line8114	Note: TO BE APPROVED BY CONSTRUCTION
7Jul16 / 15Nov16	

EXTERIOR COLOURS

Inv.637	1 - EXTERIOR COLOUR PACKAGE 9
Line14075	Note:
7Jul16 / 15Nov16	

FORMING

Inv.637	1 - BASEMENT: INSTALL COLD CELLAR
Line8106	Note:
7Jul16 / 15Nov16	
Inv.637	1 - EXTERIOR: INSTALL SIDE DOOR- HOME TO EXTERIOR- AS PER PLAN AND GRADE PERMITTING
Line8108	Note:
7Jul16 / 15Nov16	
Inv.637	1 - EXTERIOR/BACK YARD: INSTALL BACK DOOR- GARAGE TO EXTERIOR- AS PER PLAN AND GRADE PERMITTING
Line8109	Note:
7Jul16 / 15Nov16	

FRAMING

Inv.637	1 - GARAGE: INSTALL MANDOOR - GARAGE TO HOUSE- AS PER PLAN AND GRADE PERMITTING
Line8107	Note: GIVEN IN AGREEMENT OF PURCHASE AND SALE
7Jul16 / 15Nov16	
Inv.637	1 - OPTIONAL LAUNDRY
Line14066	Note:
7Jul16 / 15Nov16	
Inv.637	1 - OPTIONAL GROUND FLOOR
Line14067	Note:
7Jul16 / 15Nov16	
Inv.637	1 - MAIN FLOOR: INSTALL FOUR (X4) STANDARD DOOR EXTENDED HEIGHT 96" (PRICE PER DOOR) MAIN FLOOR 3 STOREY MODELS - TO GO IN CLOSETS, POWDER ROOM, AND LAUNDRY
Line14073	Note:
7Jul16 / 15Nov16	

Brampton Encore - 126 - 1 - 41-6 Elev.A VERDI OPT - GAF1 AND SFA3

Inv.637	1 - MAIN FLOOR-DEN: INSTALL ONE (X1) STANDARD FRENCH DOOR EXTENDED HEIGHT 96" (PRICE PER DOOR) MAIN FLOOR 3 STOREY MODELS - TO GO IN DEN
Line14074	Note:
7Jul16 / 15Nov16	

GLASS AND MIRROR

Inv.637	1 - MASTER BEDROOM: CONVERT FRAMED SHOWER TO 10MM FRAMLESS SHOWER ENCLOSURE WITH DOOR AND 10MM SIDE PANEL IN MASTER ENSUITE
Line8110	Note:
7Jul16 / 15Nov16	

Inv.637	1 - TWIN ENSUITE: CONVERT FRAMED SHOWER TO 10MM FRAMLESS SHOWER ENCLOSURE WITH DOOR AND 10MM SIDE PANEL, IN TWIN ENSUITE (BED 3/4)
Line8137	Note:
7Jul16 / 15Nov16	

HVAC

Inv.637	1 - KITCHEN: INSTALL GAS LINE ROUGH - MAIN FLOOR - (3 STOREY MODELS), FOR STOVE
Line8113	Note:
7Jul16 / 15Nov16	

INTERIOR TRIM AND DOORS

Inv.637	4 - MAIN FLOOR: INSTALL FOUR (X4) STANDARD DOOR EXTENDED HEIGHT 96" (PRICE PER DOOR) MAIN FLOOR 3 STOREY MODELS - TO GO IN CLOSETS, POWDER ROOM, AND LAUNDRY
Line8120	Note:
7Jul16 / 15Nov16	

Inv.637	1 - MAIN FLOOR-DEN: INSTALL ONE (X1) STANDARD FRENCH DOOR EXTENDED HEIGHT 96" (PRICE PER DOOR) MAIN FLOOR 3 STOREY MODELS - TO GO IN DEN
Line8123	Note:
7Jul16 / 15Nov16	

MISC.

Inv.637	1 - DO NOT INSTALL GROUND FLOOR-VENTING FOR FUTURE STOVE
	NOT APPROVED BY CONSTRUCTION
Line8115	Note: REFUND ISSUED ON PE:986
7Jul16 / 15Nov16	

Inv.637	1 - BONUS PACKAGE: \$10,000.00 (INCLUDING TAXES) WORTH OF UPGRADES FROM GOLD PARK HOMES DÉCOR CENTRE IS BEING APPLIED TOWARD THE STRUCTURAL APPOINTMENT. PURCHASER HAS A REMAINING AMOUNT OF \$00 (INCLUDING TAXES) TO BE USED TOWARD THE COLOUR APPOINTMENT
Line8131	Note:
7Jul16 / 15Nov16	

Inv.637	1 - Purchaser has attended a Structural appointment at the Decor Centre & has DECLINED any additional upgrades and accepts and acknowledges that there will be no further structural changes/additions/deletions to be made upon signing on July 7, 2016
Line8132	Note:
7Jul16 / 15Nov16	

Inv.637	1 - Purchasers are aware & accepts that ANY changes made to upgrades after signing this Purchasers Extra Form are subject to a minimum administration fee of \$500. PLUS a 10% holdback fee
Line8133	Note:
7Jul16 / 15Nov16	

PLUMBING

Brampton Encore - 126 - 1 - 41-6 Elev.A VERDI OPT - GAF1 AND SFA3


Inv.637	1 - KITCHEN: INSTALL ROUGH-IN - WATERLINE FOR FRIDGE
Line8125	Note:
7Jul16 / 15Nov16	
Inv.637	1 - EXTERIOR/KITCHEN: INSTALL HOSE BIB - EXTRA EXTERIOR HOSE BIB- COLD ONLY, ON DECK OUTSIDE OF KITCHEN, IF POSSIBLE. TO BE APPROVED BY CONSTRUCTION
Line8126	Note:
7Jul16 / 15Nov16	

WINDOWS - BASEMENT


Inv.637	1 - BASEMENT: INSTALL ONE (X1) BASEMENT WINDOWS - UPGRADE EXISTING BASEMENT WINDOW TO 46 INCH X 32 INCH - MAY REQUIRE INSTALLATION OF WINDOW WELL. SEE SKETCH
Line8111	Note:
7Jul16 / 15Nov16	
Inv.637	2 - BASEMENT: INSTALL TWO (X2) BASEMENT WINDOWS - UPGRADE EXISTING BASEMENT WINDOW TO 30 INCH X 24 INCH - MAY REQUIRE INSTALLATION OF WINDOW WELL. SEE SKETCH
Line8112	Note:
7Jul16 / 15Nov16	

WINDOWS AND DOORS


Inv.637	1 - GARAGE: INSTALL MANDOOR - GARAGE TO HOUSE- AS PER PLAN AND GRADE PERMITTING
Line14065	Note:
7Jul16 / 15Nov16	
Inv.637	1 - EXTERIOR: INSTALL SIDE DOOR- HOME TO EXTERIOR- AS PER PLAN AND GRADE PERMITTING
Line14068	Note:
7Jul16 / 15Nov16	
Inv.637	1 - EXTERIOR/BACK YARD: INSTALL BACK DOOR- GARAGE TO EXTERIOR- AS PER PLAN AND GRADE PERMITTING
Line14069	Note:
7Jul16 / 15Nov16	

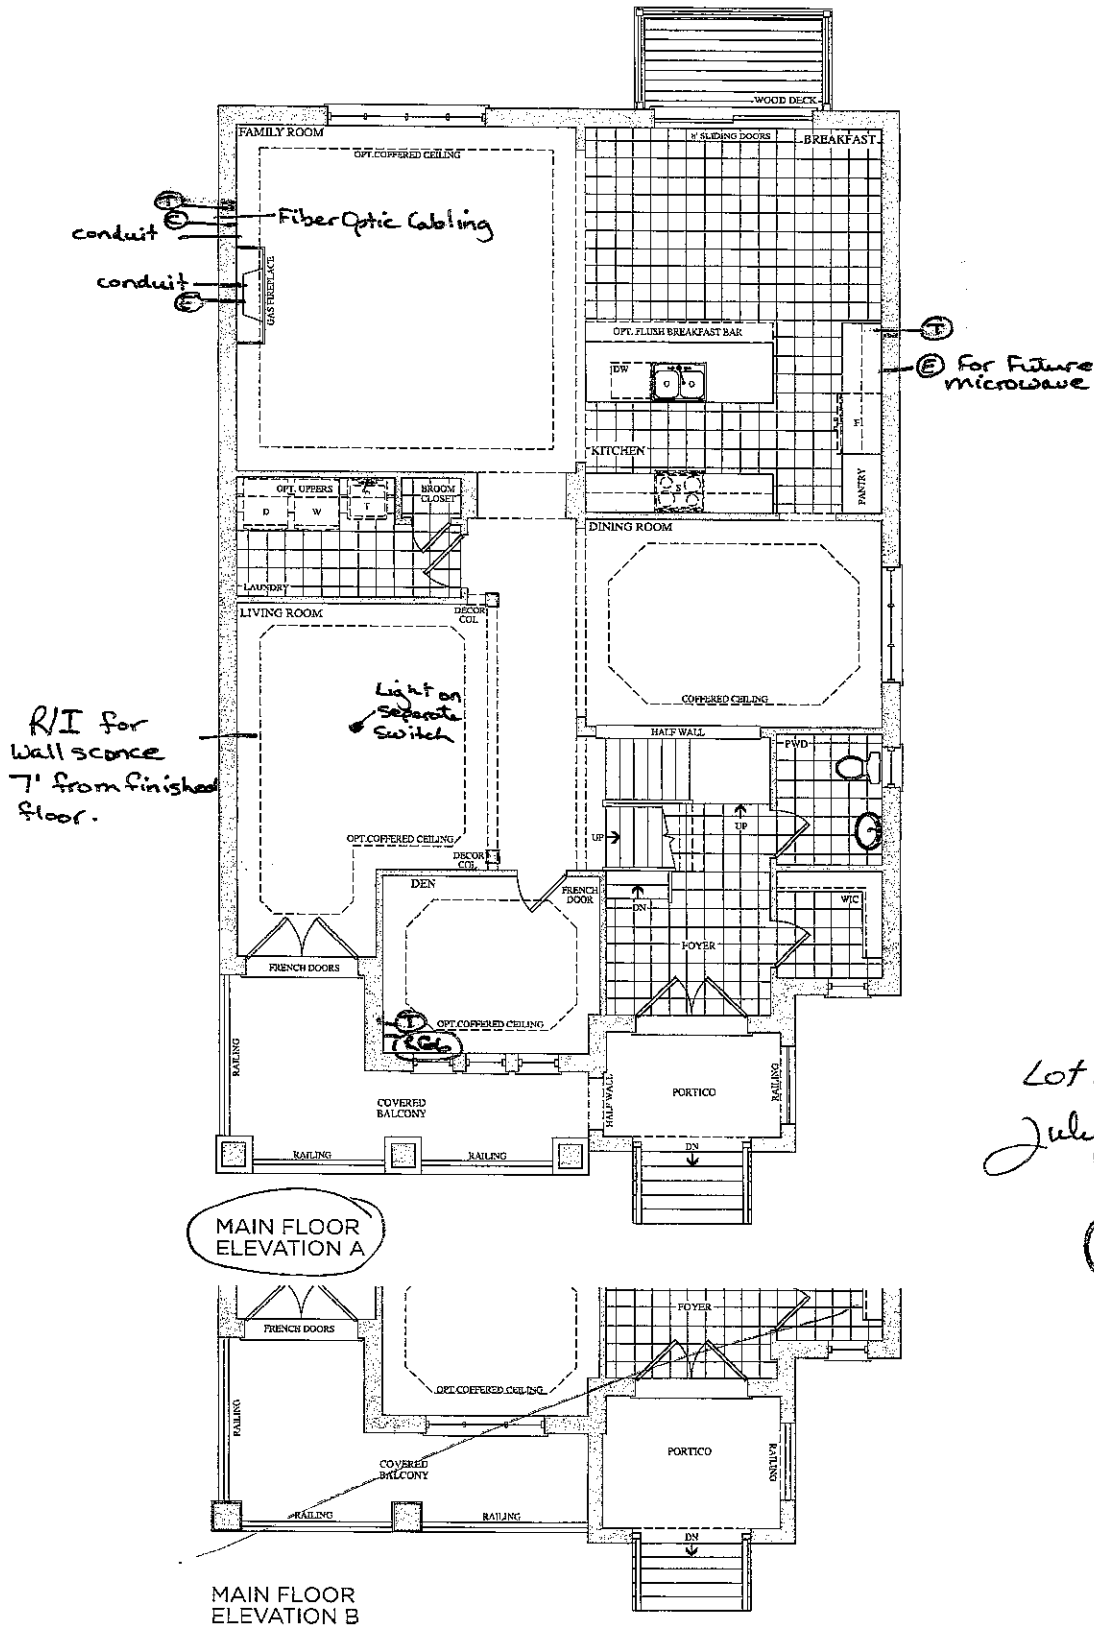

Prices, figures, illustrations, sizes, features and finishes are subject to change without notice. E.&O.E. Areas and dimensions are approximate and actual usable floor space may vary from the stated area. Layout may be reverse of the unit purchased. E. & O.E.

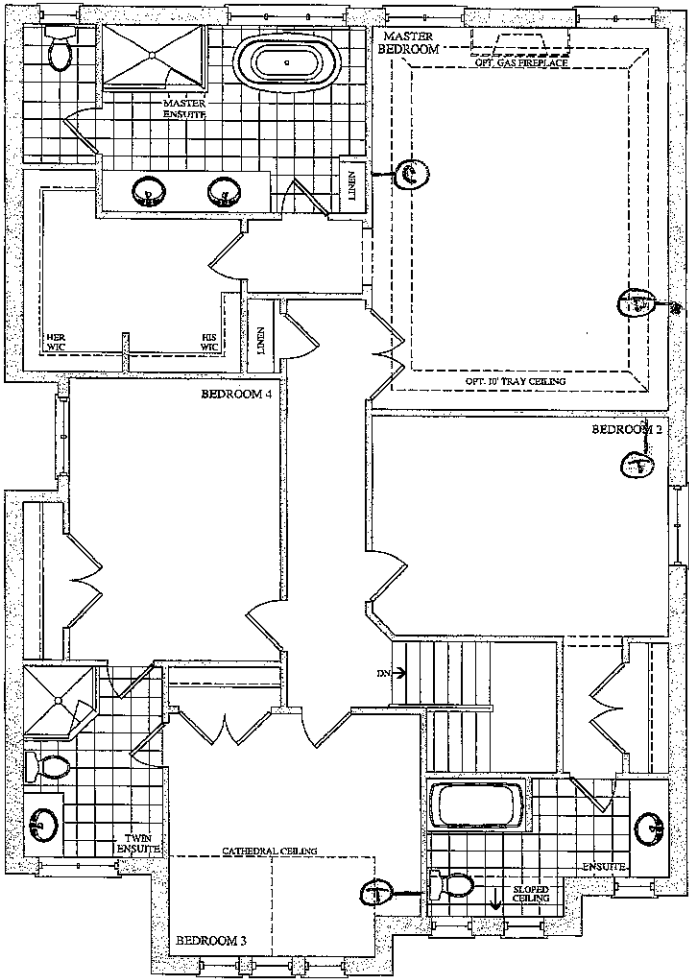

SECOND FLOOR
ELEVATION A

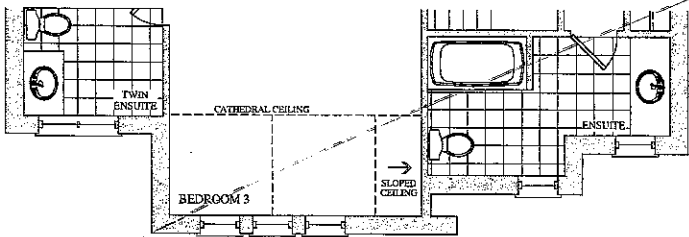


SECOND FLOOR
ELEVATION B

Lot 126
July 7, 16




Elevation A • 3,940 sq.ft. | Elevation B • 3,940 sq.ft.

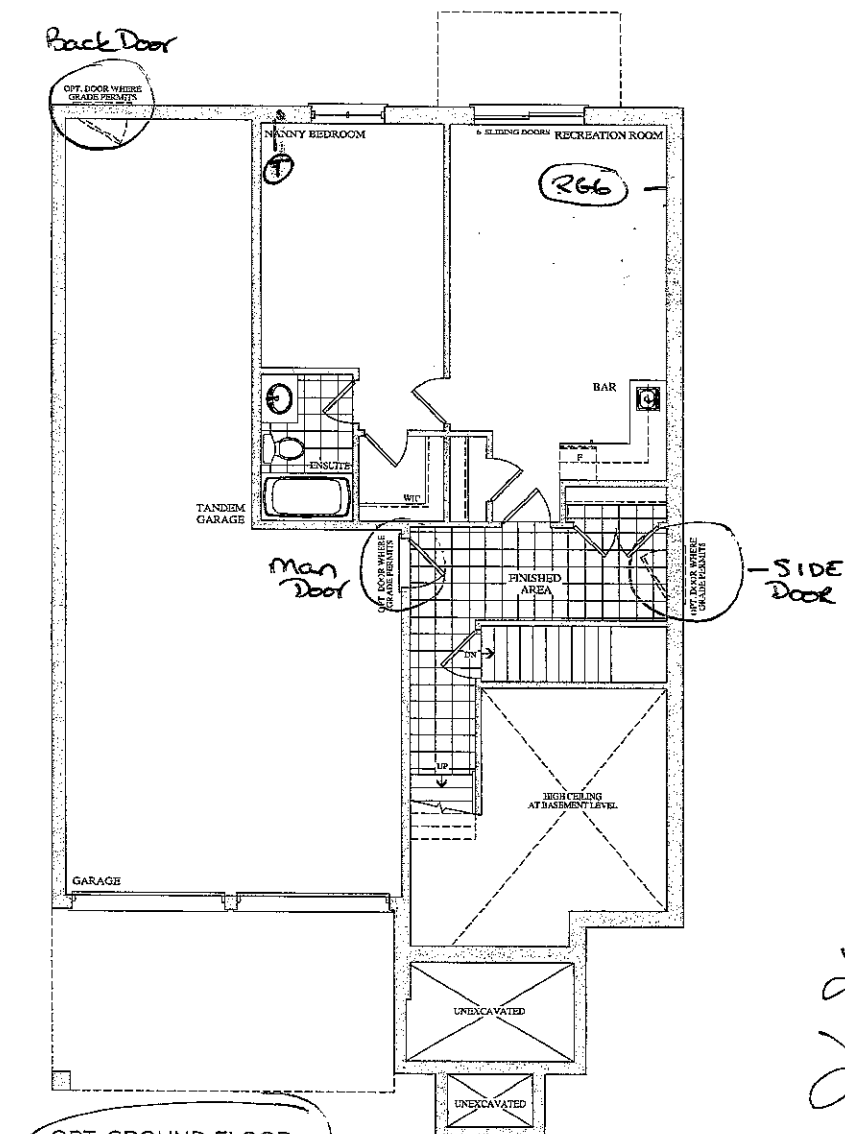

OPT. GROUND FLOOR
ELEVATION A & B
3,940 SQ. FT.

Lot 126
July 7, 16

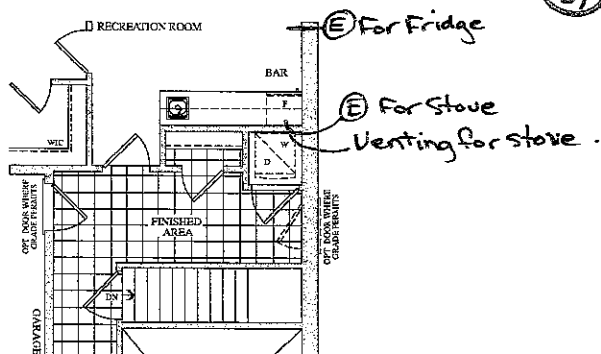

OPT. GROUND FLOOR
ELEVATION A & B
OPT. LAUNDRY

Prices, figures, illustrations, sizes, features and finishes are subject to change without notice. E.&O.E. Areas and dimensions are approximate and actual usable floor space may vary from the stated area. Layout may be reverse of the unit purchased. E. & O.E.


GOLD PARK
HOMES

BSMT WINDOWS

1 x 46" x 32"

2 x 30" x 24"

Elevation A • 3,940 sq.ft. | Elevation B • 3,940 sq.ft.

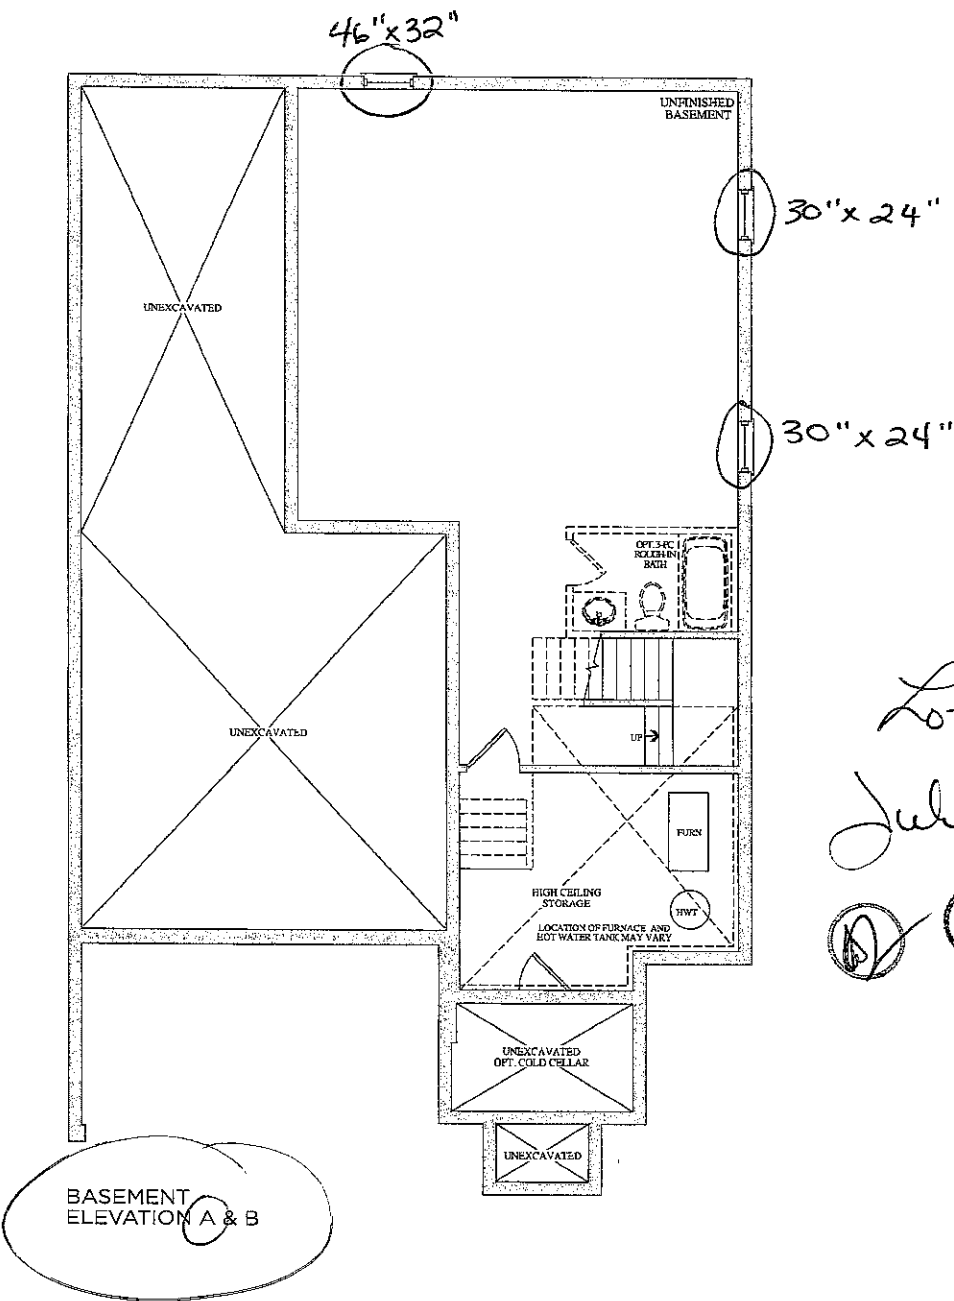

Lot 126
July 7, 16
Ⓟ Ⓡ

Prices, figures, illustrations, sizes, features and finishes are subject to change without notice. E.&O.E. Areas and dimensions are approximate and actual usable floor space may vary from the stated area. Layout may be reverse of the unit purchased. E. & O.E.



Stacey Carlete
Project Coordinator



Claude Azzopardi
Contracts Manager



Nancy Mc
Corporate

126
Lot #



38.1 The Bizet			
Elevation	Circle One	A	2189.6 Square Feet
		B	2186.7 Square Feet
Optional Layouts	Circle All that Apply		

38.2 The Ravel			
Elevation	Circle One	A	2271.5 Square Feet
		B	2273.7 Square Feet
Optional Layouts	Circle All that Apply		

38.3 The Haydn			
Elevation	Circle One	A	2394.5 Square Feet
		B	2388.3 Square Feet
Optional Layouts	Circle All that Apply		

38.4 The Vivaldi			
Elevation	Circle One	A	2459.1 Square Feet
		B	2459.1 Square Feet
Optional Layouts	Circle All that Apply		

38.5 The Handel			
Elevation	Circle One	A	2549.2 Square Feet
		B	2554.7 Square Feet
Optional Layouts	Circle All that Apply		

38.9 The Puccini			
Elevation	Circle One	A	3628.0 Square Feet
		B	3634.7 Square Feet
Optional Layouts	Circle All that Apply	GFA1	GROUND FLOOR Optional Alternative Layout

38.6 The Scarlatti			
Elevation	Circle One	A	3521.1 Square Feet
		B	3508.1 Square Feet
Optional Layouts	Circle All that Apply	GFA1	GROUND FLOOR Optional Alternative Layout

38.7 The Schubert			
Elevation	Circle One	A	3593.8 Square Feet
		B	3610.5 Square Feet
Optional Layouts	Circle All that Apply	GFA1	GROUND FLOOR Optional Alternative Layout
		SFA4	SECOND FLOOR Additional Bedroom

38.8 The Corelli			
Elevation	Circle One	A	3801.5 Square Feet
		B	3801.5 Square Feet
Optional Layouts	Circle All that Apply	GFA1	GROUND FLOOR Optional Alternative Layout
		SFA4	SECOND FLOOR Additional Bedroom w/ Ensuite

41.1 The Strauss			
Elevation	Circle One	A	2554.2 Square Feet
		B	2571.2 Square Feet
Optional Layouts	Circle All that Apply	SFA1	SECOND FLOOR Shower In Lieu of Tub B2

41.2 The Mozart			
Elevation	Circle One	A	2725.9 Square Feet
		B	2711.1 Square Feet
Optional Layouts	Circle All that Apply	SFA1	SECOND FLOOR Shower In Lieu of Tub B2

41.3 The Chopin			
Elevation	Circle One	A	2800.0 Square Feet
		B	2810.5 Square Feet
Optional Layouts	Circle All that Apply		

41.4 The Bach			
Elevation	Circle One	A	2894.4 Square Feet
		B	2894.5 Square Feet
Optional Layouts	Circle All that Apply		

41.5 The Brahms			
Elevation	Circle One	A	3948.1 Square Feet
		B	3949.1 Square Feet
Optional Layouts	Circle All that Apply	GFA1	GROUND FLOOR Optional Alternative Layout
		SFA2	SECOND FLOOR Shower In Lieu of Tub B4
		SFA3	SECOND FLOOR Optional Laundry Layout

41.6 The Verdi			
Elevation	Circle One	A	3862.5 Square Feet
		B	3866.4 Square Feet
Optional Layouts	Circle All that Apply	GFA1	GROUND FLOOR Optional Alternative Layout
		SFA3	SECOND FLOOR Optional Laundry Layout

July 7, 16



3862.5 Square Feet
3866.4 Square Feet