

Brampton Encore - 128 - 1 - 41-6 Elev.B VERDI OPT - GFA1 AND SFA3
CENTRAL VAC AND WIRING

Inv.626	1 - TELEPHONE AND CABLE ROUGH-IN LOCATIONS
Line7909	Note:
6Jul16 / 15Nov16	
Inv.626	1 - FAMILY ROOM: INSTALL CONDUIT PIPE- FOR TELEVISION- ABOVE FIREPLACE, SEE SKETCH
Line7910	Note:
6Jul16 / 15Nov16	
Inv.626	1 - FAMILY ROOM: INSTALL ROUGH-IN WIRING FOR ONE PAIR OF SPEAKERS - IN FAMILY ROOM, SEE SKETCH
Line7912	Note:
6Jul16 / 15Nov16	

ELECTRICAL

Inv.626	1 - FAMILY ROOM: INSTALL 110V WALL RECEPTACLE ON DEDICATED CIRCUIT - ABOVE FIREPLACE SEE SKETCH
Line7911	Note:
6Jul16 / 15Nov16	
Inv.626	1 - KITCHEN: RELOCATE FRIDGE AND STOVE IN KITCHEN. SEE ATTACHED FLOOR PLAN
Line11977	Note:
6Jul16 / 15Nov16	
Inv.626	1 - KITCHEN: INSTALL 220V WALL RECEPTICAL ON DEDICATED CIRCUIT- FOR 4 WIRE BUILT-IN WALL OVEN - SEE SKETCH
Line11976	Note:
6Jul16 / 15Nov16	

EXTERIOR COLOURS

Inv.626	1 - EXTERIOR COLOUR PACKAGE 3
Line14039	Note:
6Jul16 / 15Nov16	

FRAMING

Inv.626	1 - KITCHEN: RELOCATE FRIDGE AND STOVE IN KITCHEN. SEE ATTACHED FLOOR PLAN
Line14034	Note:
6Jul16 / 15Nov16	
Inv.626	1 - KITCHEN: RELOCATE SINK AND DISHWASHER IN KITCHEN. SEE ATTACHED FLOOR PLAN
Line14037	Note:
6Jul16 / 15Nov16	
Inv.626	1 - MAN DOOR GARAGE TO HOUSE - OPTIONAL - IF GRADE PERMITS
Line14041	Note:
6Jul16 / 15Nov16	
Inv.984	1 - OPTIONAL GROUND FLOOR
Line14043	Note:
15Nov16 / 15Nov16	
Inv.984	1 - OPTIONAL LAUNDRY
Line14044	Note:
15Nov16 / 15Nov16	

KITCHEN AND BATH CABINETRY

Brampton Encore - 128 - 1 - 41-6 Elev.B VERDI OPT - GFA1 AND SFA3

Inv.626	1 - KITCHEN: CHANGE KITCHEN LAYOUT, ADDING CABINETRY WHERE NEEDED. SEE ATTACHED FLOOR PLAN
Line11979	Note: *DOES NOT INCLUDE CHARGE FOR BUILT-IN WALL OVEN UNIT OR ADDITIONAL GRANITE, IF NEEDED
6Jul16 / 15Nov16	
Inv.626	1 - KITCHEN: RELOCATE FRIDGE AND STOVE IN KITCHEN. SEE ATTACHED FLOOR PLAN
Line14035	Note:
6Jul16 / 15Nov16	
Inv.626	1 - KITCHEN: RELOCATE SINK AND DISHWASHER IN KITCHEN. SEE ATTACHED FLOOR PLAN
Line14036	Note:
6Jul16 / 15Nov16	

MISC.

Inv.626	1 - Purchasers are aware & accepts that ANY changes made to upgrades after signing this Purchasers Extra Form are subject to a minimum administration fee of \$500. PLUS a 10% holdback fee
Line11981	Note:
6Jul16 / 15Nov16	
Inv.626	1 - Purchaser has attended a Structural appointment at the Decor Centre & has DECLINED any additional upgrades and accepts and acknowledges that there will be no further structural changes/additions/deletions to be made upon signing on September 26, 2016
Line11980	Note:
6Jul16 / 15Nov16	
Inv.626	1 - BONUS PACKAGE: \$7345.00 (INCLUDING TAXES) WORTH OF UPGRADES FROM GOLD PARK HOMES DÉCOR CENTRE IS BEING APPLIED TOWARD THE STRUCTURAL APPOINTMENT. PURCHASER HAS A REMAINING AMOUNT OF \$2655.00 (INCLUDING TAXES) TO BE USED TOWARD THE COLOUR APPOINTMENT
Line11982	Note:
6Jul16 / 15Nov16	

PLUMBING

Inv.626	1 - BASEMENT: INSTALL ROUGH-IN - 3PC BASEMENT ROUGH-IN, AS PER SKETCH
Line7914	Note:
6Jul16 / 15Nov16	
Inv.626	1 - KITCHEN: RELOCATE SINK AND DISHWASHER IN KITCHEN. SEE ATTACHED FLOOR PLAN
Line11978	Note:
6Jul16 / 15Nov16	

WINDOWS - BASEMENT

Inv.626	3 - BASEMENT: INSTALL THREE (X3) BASEMENT WINDOWS - UPGRADE EXISTING BASEMENT WINDOW TO 30 INCH X 24 INCH - MAY REQUIRE INSTALLATION OF WINDOW WELL
Line7913	Note:
6Jul16 / 15Nov16	


WINDOWS AND DOORS

Inv.626	1 - MAN DOOR GARAGE TO HOUSE - OPTIONAL - IF GRADE PERMITS
Line13113	Note: AS PER APS
6Jul16 / 15Nov16	

Telephone - (T)
Cable - (C)
Electrical - (E)

The
Verdi
41' SERIES


Elevation A • 3,940 sq.ft. | Elevation B • 3,940 sq.ft.

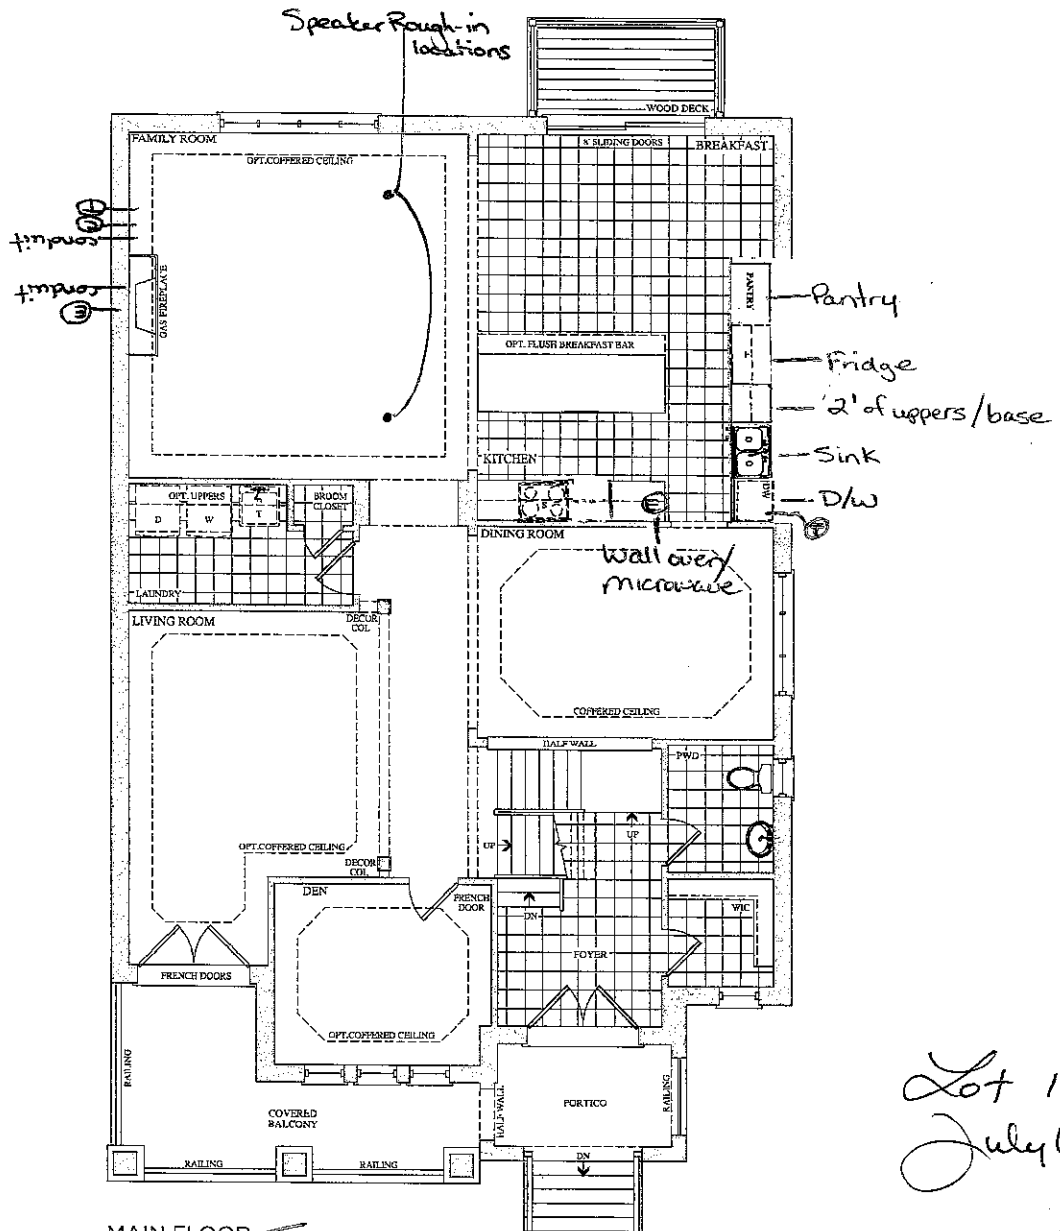

Lot 128
July 6, 16



MAIN FLOOR
ELEVATION A

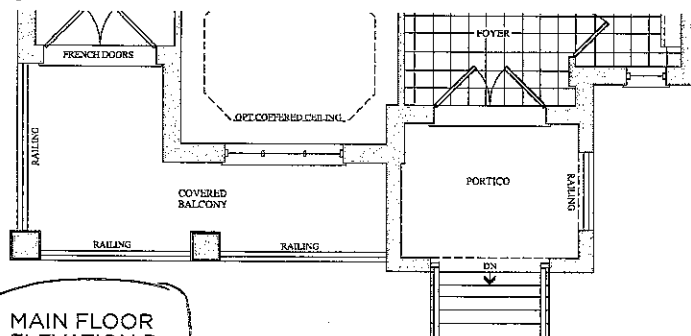

MAIN FLOOR
ELEVATION B


Prices, figures, illustrations, sizes, features and finishes are subject to change without notice. E.&O.E. Areas and dimensions are approximate and actual usable floor space may vary from the stated area. Layout may be reverse of the unit purchased. E. & O.E.

GOLDPARK
HOMES


Telephone —(T)—
Cable —(C)—

The
Verdi
41' SERIES

Elevation A • 3,940 sq.ft. | Elevation B • 3,940 sq.ft.

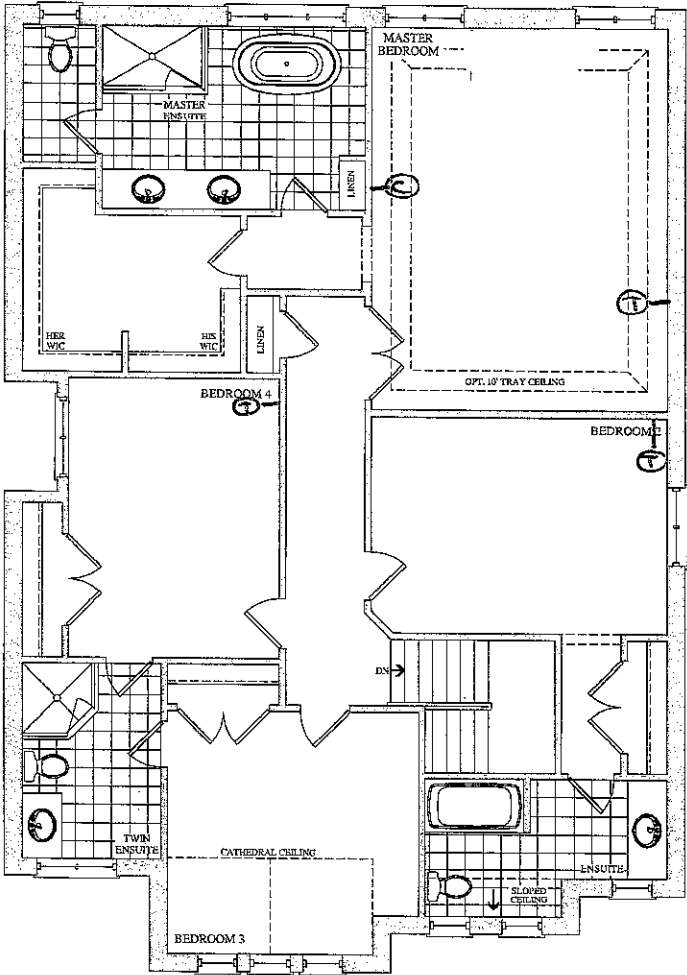

SECOND FLOOR
ELEVATION A

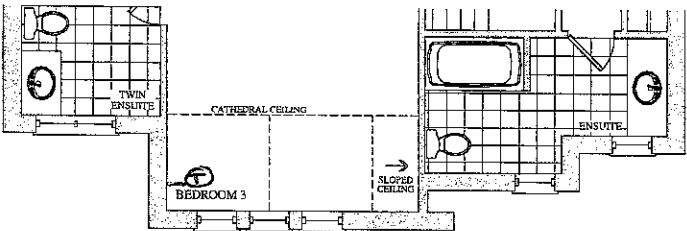

SECOND FLOOR
ELEVATION B

Lot 128
July 6, 16




Prices, figures, illustrations, sizes, features and finishes are subject to change without notice. E.&O.E. Areas and dimensions are approximate and actual usable floor space may vary from the stated area. Layout may be reverse of the unit purchased. E. & O.E.

GOLDPARK
HOMES


Telephone — (T)
Cable — (C)

The
Verdi
41' SERIES

Elevation A • 3,940 sq.ft. | Elevation B • 3,940 sq.ft.

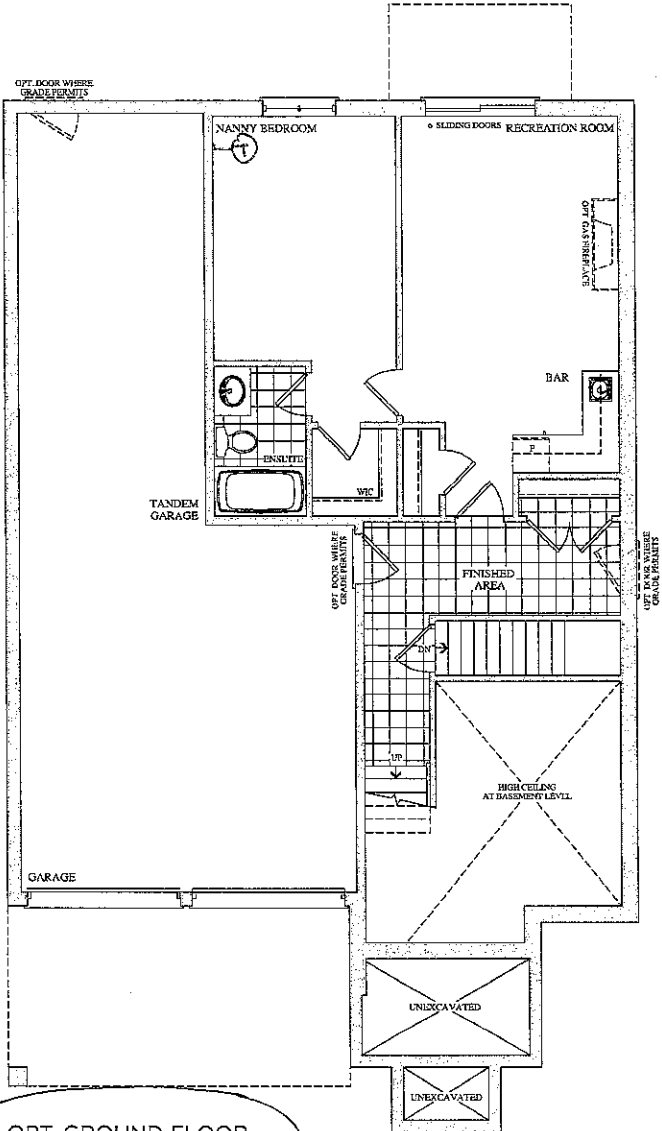

OPT. GROUND FLOOR
ELEVATION A & B
3,940 SQ. FT.

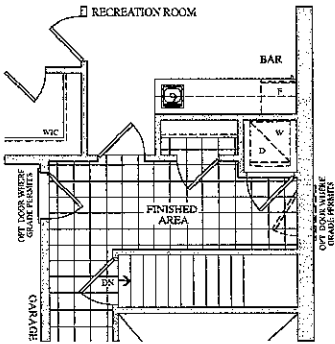


OPT. GROUND FLOOR
ELEVATION A & B
OPT. LAUNDRY

Lot 128
July 8, 16
(2)

Prices, figures, illustrations, sizes, features and finishes are subject to change without notice. E.&O.E. Areas and dimensions are approximate and actual usable floor space may vary from the stated area. Layout may be reverse of the unit purchased. E. & O.E.

bsmt windows
3 x 30" x 24"

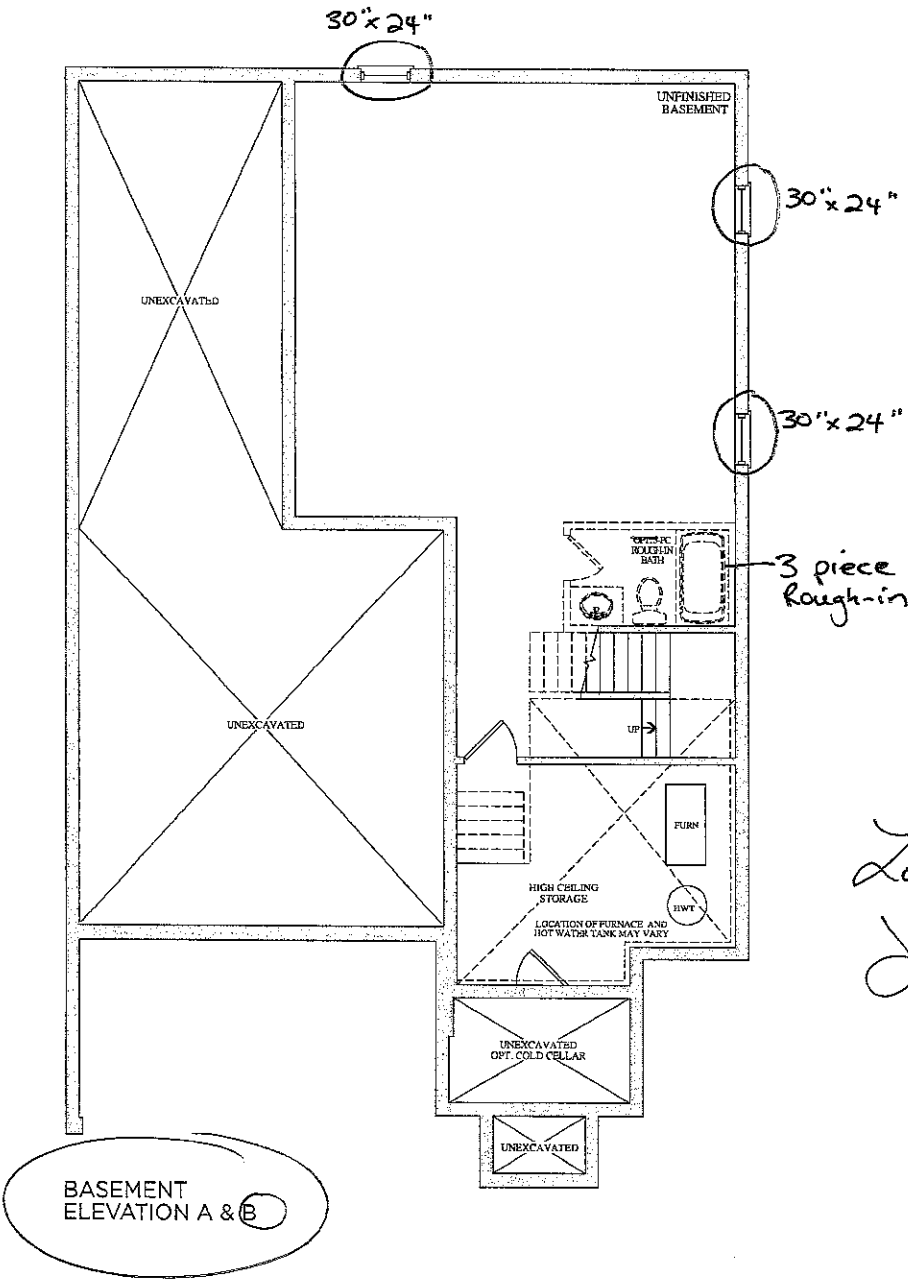

Lot 128
July 6, 16
B/S



Stacey Carlete
Project Coordinator



Claude Azzopardi
Contracts Manager



Nancy Macdonald
Corporate Counsel

128
Lot #



38.1 The Bizet			
Elevation	Circle One	A	2189.6 Square Feet
		B	2186.7 Square Feet
Optional Layouts	Circle All that Apply		

38.2 The Ravel			
Elevation	Circle One	A	2271.5 Square Feet
		B	2273.7 Square Feet
Optional Layouts	Circle All that Apply		

38.3 The Haydn			
Elevation	Circle One	A	2394.5 Square Feet
		B	2388.3 Square Feet
Optional Layouts	Circle All that Apply		

38.4 The Vivaldi			
Elevation	Circle One	A	2459.1 Square Feet
		B	2459.1 Square Feet
Optional Layouts	Circle All that Apply		

38.5 The Handel			
Elevation	Circle One	A	2549.2 Square Feet
		B	2554.7 Square Feet
Optional Layouts	Circle All that Apply		

38.9 The Puccini			
Elevation	Circle One	A	3628.0 Square Feet
		B	3634.7 Square Feet
Optional Layouts	Circle All that Apply	GFA1	GROUND FLOOR Optional Alternative Layout

38.6 The Scarlatti			
Elevation	Circle One	A	3521.1 Square Feet
		B	3508.1 Square Feet
Optional Layouts	Circle All that Apply	GFA1	GROUND FLOOR Optional Alternative Layout

38.7 The Schubert			
Elevation	Circle One	A	3599.8 Square Feet
		B	3610.5 Square Feet
Optional Layouts	Circle All that Apply	GFA1	GROUND FLOOR Optional Alternative Layout
		SFA4	SECOND FLOOR Additional Bedroom
Optional Layouts	Circle All that Apply		

38.8 The Corelli			
Elevation	Circle One	A	3801.5 Square Feet
		B	3801.5 Square Feet
Optional Layouts	Circle All that Apply	GFA1	GROUND FLOOR Optional Alternative Layout
		SFA4	SECOND FLOOR Additional Bedroom w/ Ensuite
Optional Layouts	Circle All that Apply		

41.1 The Strauss			
Elevation	Circle One	A	2554.2 Square Feet
		B	2571.2 Square Feet
Optional Layouts	Circle All that Apply	SFA1	SECOND FLOOR Shower in Lieu of Tub B2

41.2 The Mozart			
Elevation	Circle One	A	2725.9 Square Feet
		B	2711.1 Square Feet
Optional Layouts	Circle All that Apply	SFA1	SECOND FLOOR Shower in Lieu of Tub B2

41.3 The Chopin			
Elevation	Circle One	A	2800.0 Square Feet
		B	2810.5 Square Feet
Optional Layouts	Circle All that Apply		

41.4 The Bach			
Elevation	Circle One	A	2894.4 Square Feet
		B	2894.5 Square Feet
Optional Layouts	Circle All that Apply		

41.5 The Brahms			
Elevation	Circle One	A	3948.1 Square Feet
		B	3949.1 Square Feet
Optional Layouts	Circle All that Apply	GFA1	GROUND FLOOR Optional Alternative Layout
		SFA2	SECOND FLOOR Shower in Lieu of Tub B4
Optional Layouts	Circle All that Apply	SFA3	SECOND FLOOR Optional Laundry Layout

41.6 The Verdi			
Elevation	Circle One	A	3862.5 Square Feet
		B	3866.4 Square Feet
Optional Layouts	Circle All that Apply	GFA1	GROUND FLOOR Optional Alternative Layout
		SFA3	SECOND FLOOR Optional Laundry Layout
Optional Layouts	Circle All that Apply		


July 6, 16



Date: July 30/16

Trade Name: Gold Park Homes	Site location: Brampton	Model: 41-6 VERDI
Address:	Project: Encore LOT 128	Phase:

This layout has been explained to the purchaser by Cortina Kitchens Inc. and is understood by the purchaser.

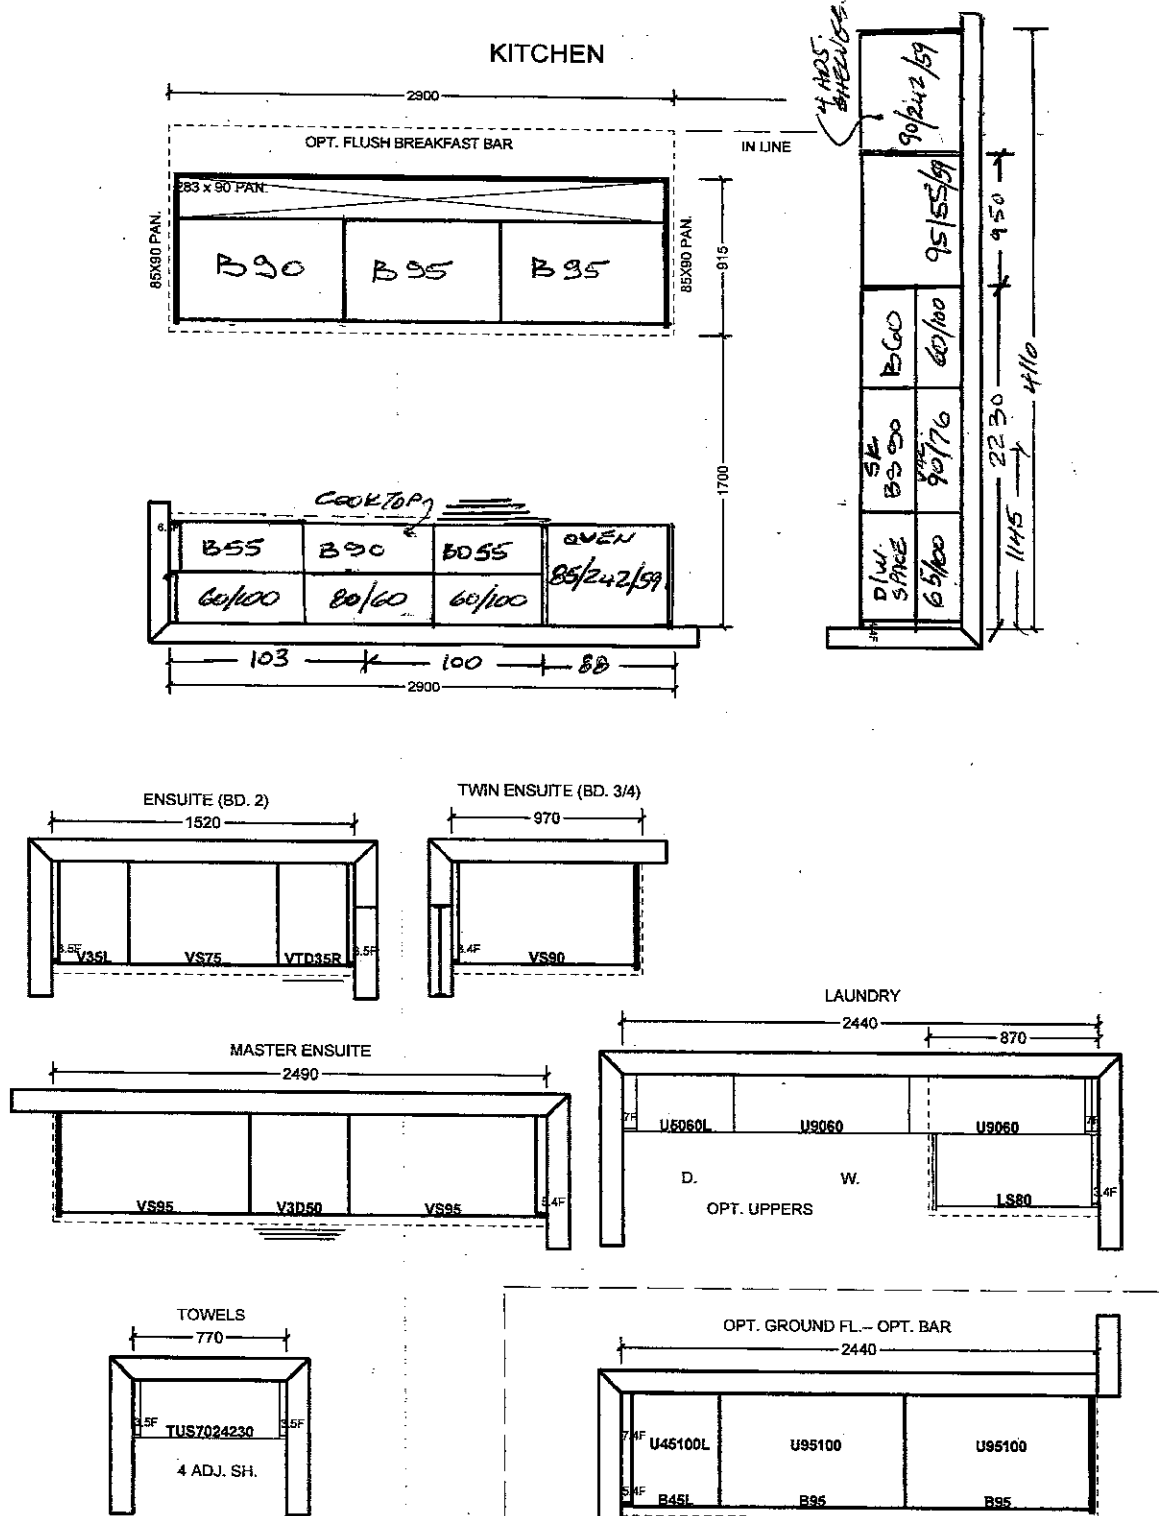

All prices subject to confirmation from head office.
This quotation is subject to the terms & conditions set out

ACCEPTED DATE: _____

All agreements are contingent upon strikes, accidents, and delays beyond our control.
Please provide our installer with template for sinkholes or \$150.00 will be charged for callback.

Item A. Wood grain and colour are characteristics of the product. We cannot guarantee that such grain and colour will always match.
Item B. Cortina Kitchens Inc. reserves the right to alter dimensions and make technical changes without notice.

Lot 128
Sept. 26, 16

