

CONSTRUCTION SUMMARY

18 - 1 - 38-6 Elev.A SCARLATTI

CENTRAL VAC AND WIRING

Inv.639	1 - TELEPHONE AND CABLE ROUGH-IN LOCATIONS
	DELETE CABLE FROM MASTER BEDROOM
Line8151	Note: NOTE: STANDARD CABLE HAS BEEN MOVED FROM THE MASTER BEDROOM TO THE GROUND FLOOR. SEE SKETCH
11Jul16 / 27Sep16	

ELECTRICAL

Inv.639	1 - LIVING ROOM: INSTALL ADDITIONAL STANDARD FIXTURE WITH SWITCH - IN LIVING ROOM, IN ADDITION TO THE SWITCH CONTROLLED RECEPTICAL. SEE SKETCH
Line8152	Note:
11Jul16 / 27Sep16	

EXTERIOR COLOURS

Inv.639	1 - EXTERIOR COLOUR PACKAGE 4
Line12018	Note:
11Jul16 / 27Sep16	

FORMING

Inv.639	1 - MAIN FLOOR: INSTALL FOUR (X4) STANDARD DOOR EXTENDED HEIGHT 96" (PRICE PER DOOR) MAIN FLOOR 3 STOREY MODELS - FOR CLOSETS, POWDER ROOM AND LAUNDRY ROOM
Line12017	Note:
11Jul16 / 27Sep16	

FRAMING

Inv.639	1 - GARAGE: INSTALL MANDOOR - GARAGE TO HOUSE- AS PER PLAN AND GRADE PERMITING
Line8153	Note: GIVEN IN AGREEMENT OF PURCHANSE AND SALE
11Jul16 / 27Sep16 GRADING DOES PERMIT PER SITING DATED SEPT 8, 2016	

HVAC

Inv.639	1 - KITCHEN: INSTALL GAS LINE ROUGH - MAIN FLOOR - (3 STOREY MODELS), FOR STOVE
Line8155	Note:
11Jul16 / 27Sep16	

INTERIOR TRIM AND DOORS

Inv.639	4 - MAIN FLOOR: INSTALL FOUR (X4) STANDARD DOOR EXTENDED HEIGHT 96" (PRICE PER DOOR) MAIN FLOOR 3 STOREY MODELS - FOR CLOSETS, POWDER ROOM AND LAUNDRY ROOM
Line8156	Note:
11Jul16 / 27Sep16	

MISC.

Inv.639	1 - BONUS PACKAGE: \$3271.35 (INCLUDING TAXES) WORTH OF UPGRADES FROM GOLD PARK HOMES DÉCOR CENTRE IS BEING APPLIED TOWARD THE STRUCTURAL APPOINTMENT. PURCHASER HAS A REMAINING AMOUNT OF \$6728.65 (INCLUDING TAXES) TO BE USED TOWARD THE COLOUR APPOINTMENT
Line8158	Note:
11Jul16 / 27Sep16	

CONSTRUCTION SUMMARY

18 - 1 - 38-6 Elev.A SCARLATTI

Inv.639	1 - Purchaser has attended a Structural appointment at the Decor Centre & has DECLINED any additional upgrades and accepts and acknowledges that there will be no further structural changes/additions/deletions to be made upon signing on July 11, 2016
Line8159	Note:
11Jul16 / 27Sep16	

Inv.639	1 - Purchasers are aware & accepts that ANY changes made to upgrades after signing this Purchasers Extra Form are subject to a minimum administration fee of \$500. PLUS a 10% holdback fee
Line8160	Note:
11Jul16 / 27Sep16	

PLUMBING

Inv.639	1 - KITCHEN: INSTALL ROUGH-IN - WATERLINE FOR FRIDGE
Line8157	Note:
11Jul16 / 27Sep16	


WINDOWS - BASEMENT

Inv.639	2 - BASEMENT: INSTALL TWO (X2) BASEMENT WINDOWS - UPGRADE EXISTING BASEMENT WINDOW TO 30 INCH X 16 INCH. SEE SKETCH
Line8154	Note:
11Jul16 / 27Sep16	


The Scarlatti

38' SERIES

Elevation A • 3,591 sq.ft. | Elevation B • 3,578 sq.ft.

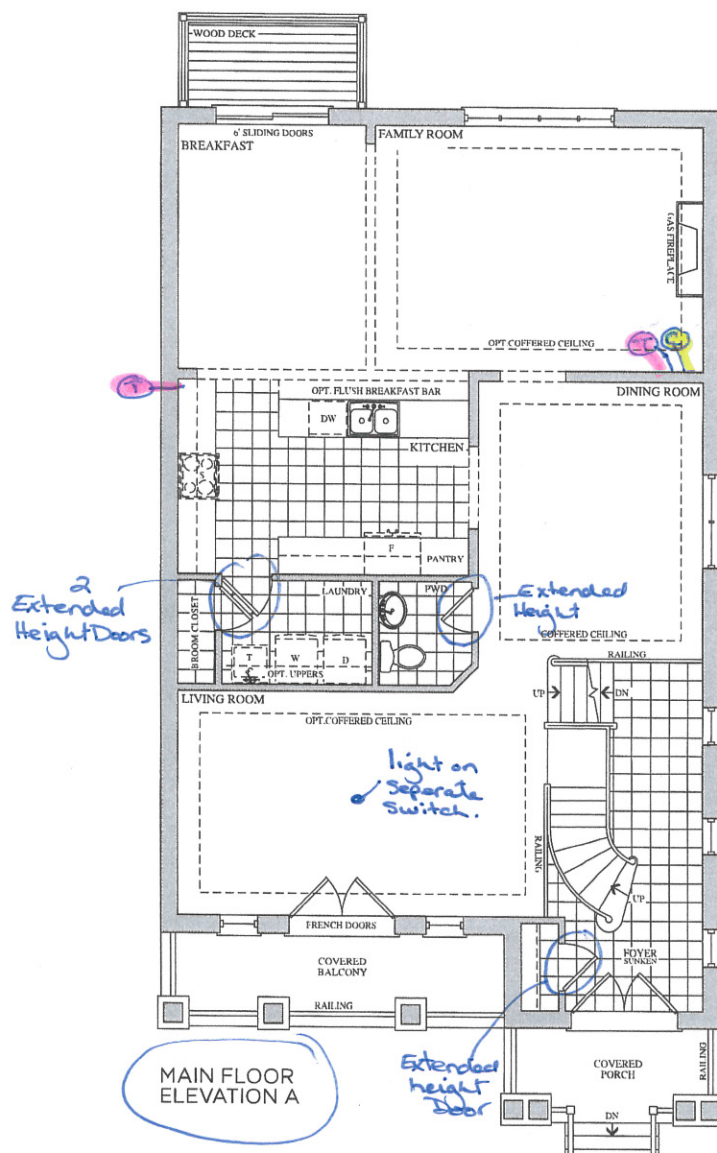

Lot 18
July 11, 16

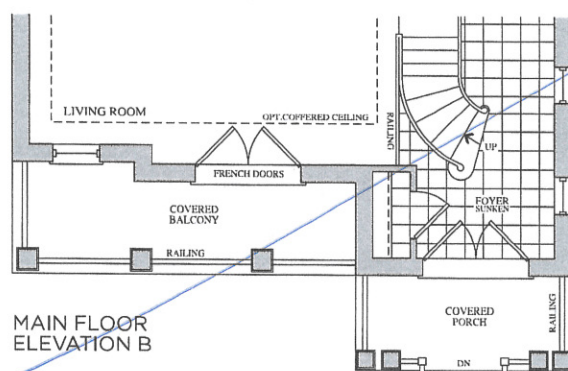


Prices, figures, illustrations, sizes, features and finishes are subject to change without notice. L.&O.E. Areas and dimensions are approximate and actual usable floor space may vary from the stated area. Layout may be reverse of the unit purchased. E. & O.E.

GOLDPARK
HOMES

The
Scarlatti
38' SERIES


Elevation A • 3,591 sq.ft. | Elevation B • 3,578 sq.ft.

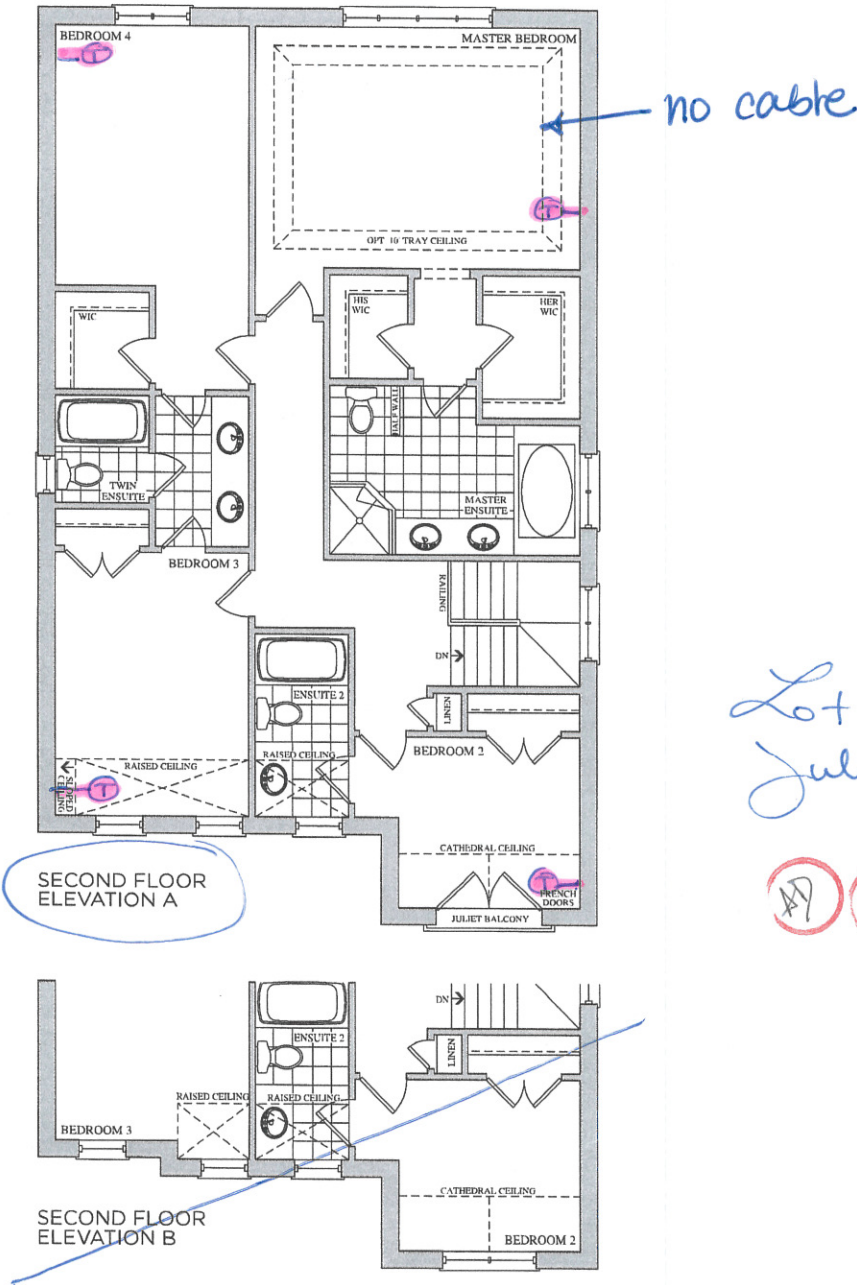

Prices, figures, illustrations, sizes, features and finishes are subject to change without notice. E.O.E. Areas and dimensions are approximate and actual usable floor space may vary from the stated area. Layout may be reverse of the unit purchased. E. & O.E.

The
Scarlati
38' SERIES

Elevation A • 3,591 sq.ft. | Elevation B • 3,578 sq.ft.

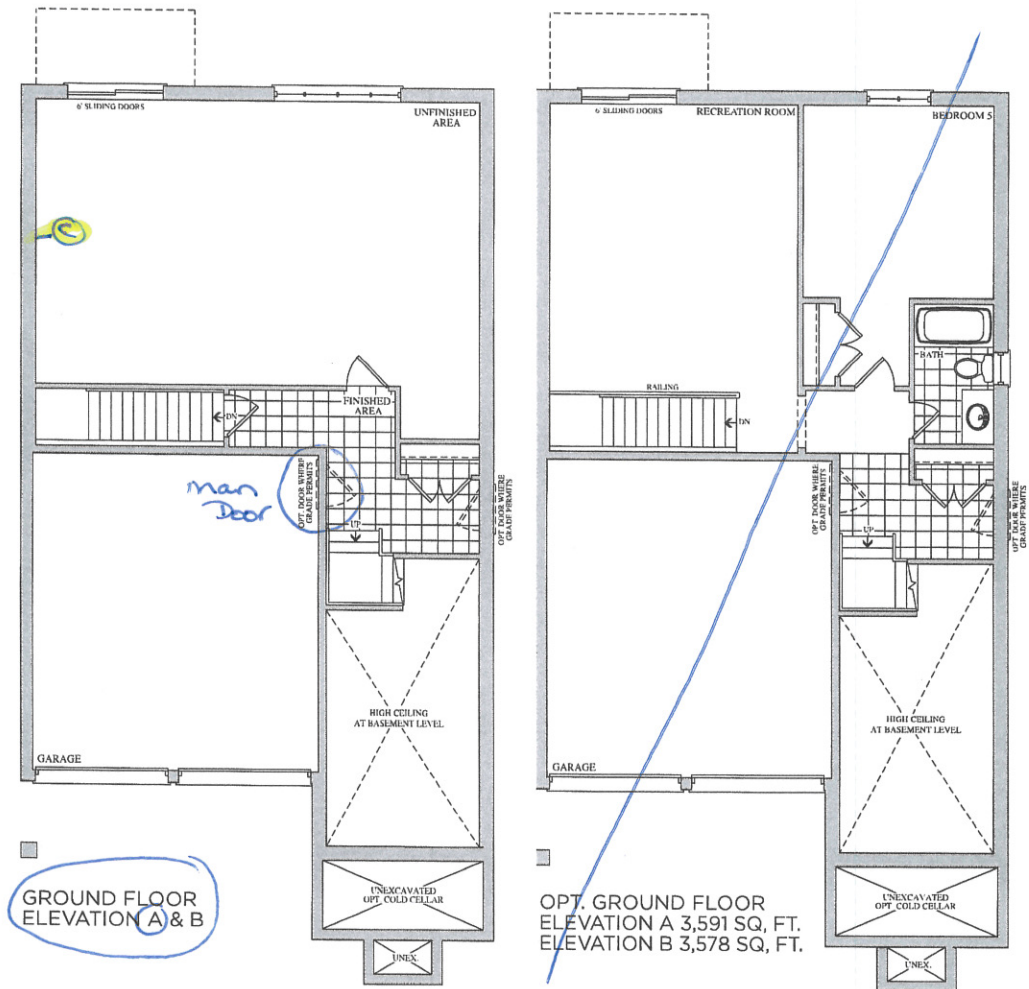


Lot 18
July 11, 16

(X) (AD)


Prices, figures, illustrations, sizes, features and finishes are subject to change without notice. E.&O.E. Areas and dimensions are approximate and actual usable floor space may vary from the stated area. Layout may be reverse of the unit purchased. E. & O.E.

GOLDPARK
HOMES

BSMNT WINDOWS
2 x 30" x 16"

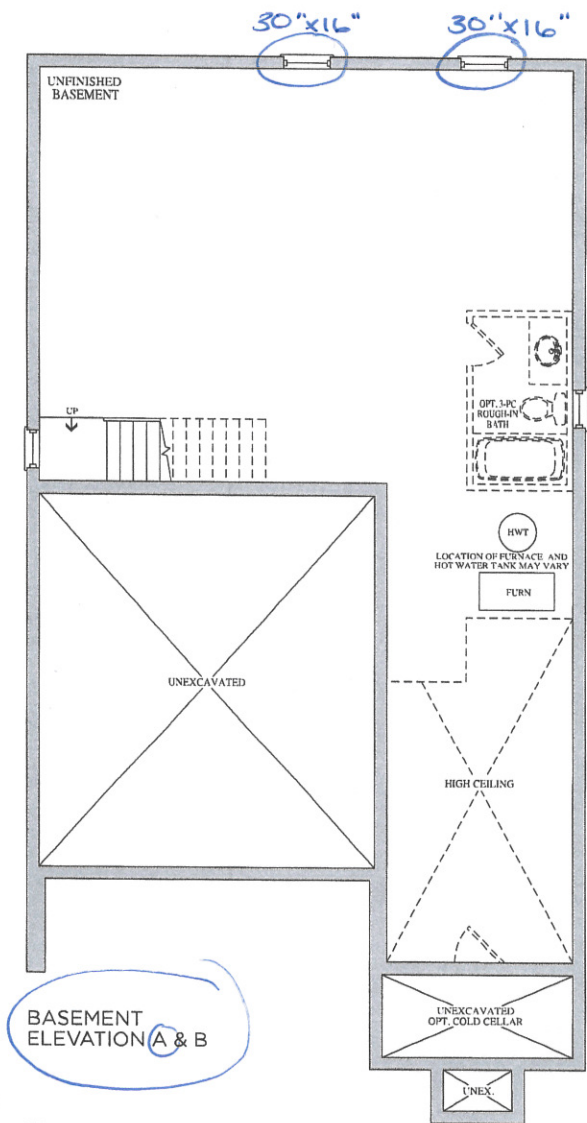

BASEMENT
ELEVATION A & B

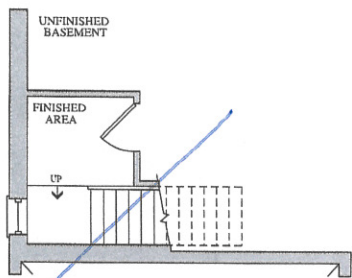

OPT. BASEMENT
ELEVATION A & B

Lot 18
July 11, 16
A D

Prices, figures, illustrations, sizes, features and finishes are subject to change without notice. E.&O.E. Areas and dimensions are approximate and actual usable floor space may vary from the stated area. Layout may be reverse of the unit purchased. E. & O.E.



Stacey Carlete
Project Coordinator



Claude Azzopardi
Contracts Manager



Nancy Moore
Corporate Counsel

18
Lot #



Model	38.1 The Bizet		
Elevation	Circle One	A	2189.6 Square Feet
		B	2186.7 Square Feet
Optional Layouts	Circle All that Apply		

Model	38.2 The Ravel		
Elevation	Circle One	A	2271.5 Square Feet
		B	2273.7 Square Feet
Optional Layouts	Circle All that Apply		

Model	38.3 The Haydn		
Elevation	Circle One	A	2394.5 Square Feet
		B	2388.3 Square Feet
Optional Layouts	Circle All that Apply		

Model	38.4 The Vivaldi		
Elevation	Circle One	A	2459.1 Square Feet
		B	2459.1 Square Feet
Optional Layouts	Circle All that Apply		

Model	38.5 The Handel		
Elevation	Circle One	A	2549.2 Square Feet
		B	2554.7 Square Feet
Optional Layouts	Circle All that Apply		

Model	38.9 The Puccini		
Elevation	Circle One	A	3628.0 Square Feet
		B	3634.7 Square Feet
Optional Layouts	Circle All that Apply	GFA1	GROUND FLOOR Optional Alternative Layout

Model	38.6 The Scarlatti		
Elevation	Circle One	A	3521.1 Square Feet
		B	3508.1 Square Feet
Optional Layouts	Circle All that Apply	GFA1	GROUND FLOOR Optional Alternative Layout

Model	38.7 The Schubert		
Elevation	Circle One	A	3593.8 Square Feet
		B	3610.5 Square Feet
Optional Layouts	Circle All that Apply	GFA1	GROUND FLOOR Optional Alternative Layout
		SFA4	SECOND FLOOR Additional Bedroom

Model	38.8 The Corelli		
Elevation	Circle One	A	3801.5 Square Feet
		B	3801.5 Square Feet
Optional Layouts	Circle All that Apply	GFA1	GROUND FLOOR Optional Alternative Layout
		SFA4	SECOND FLOOR Additional Bedroom w/ Ensuite

Model	41.1 The Strauss		
Elevation	Circle One	A	2554.2 Square Feet
		B	2571.2 Square Feet
Optional Layouts	Circle All that Apply	SFA1	SECOND FLOOR Shower in Lieu of Tub B2

Model	41.2 The Mozart		
Elevation	Circle One	A	2725.9 Square Feet
		B	2711.1 Square Feet
Optional Layouts	Circle All that Apply	SFA1	SECOND FLOOR Shower in Lieu of Tub B2

Model	41.3 The Chopin		
Elevation	Circle One	A	2800.0 Square Feet
		B	2810.5 Square Feet
Optional Layouts	Circle All that Apply		

Model	41.4 The Bach		
Elevation	Circle One	A	2894.4 Square Feet
		B	2894.5 Square Feet
Optional Layouts	Circle All that Apply		

Model	41.5 The Brahms		
Elevation	Circle One	A	3948.1 Square Feet
		B	3949.1 Square Feet
Optional Layouts	Circle All that Apply	GFA1	GROUND FLOOR Optional Alternative Layout
		SFA2	SECOND FLOOR Shower in Lieu of Tub B4
		SFA3	SECOND FLOOR Optional Laundry Layout

Model	41.6 The Verdi		
Elevation	Circle One	A	3862.5 Square Feet
		B	3866.4 Square Feet
Optional Layouts	Circle All that Apply	GFA1	GROUND FLOOR Optional Alternative Layout
		SFA3	SECOND FLOOR Optional Laundry Layout

July 11, 16

