

Brampton Encore - 53 - 1 - 38-5 Elev.B HANDEL
CENTRAL VAC AND WIRING

Inv.442	1 - TELEPHONE AND CABLE ROUGH-IN LOCATION
Line5349	Note:
20Apr16 / 25Jul16	
Inv.442	1 - BEDROOM #4: INSTALL RG 6 ROUGH-IN IN BED #4, SEE SKETCH
Line5353	Note:
20Apr16 / 25Jul16	
Inv.442	1 - MASTER BEDROOM: ROUGH-IN FOR EXTRA SECURITY KEY PAD IN MASTER BEDROOM, BESIDE LIGHT SWITCH
Line5350	Note:
20Apr16 / 25Jul16	
Inv.442	1 - BEDROOM #3: INSTALL RG 6 ROUGH-IN - IN BED 3, SEE SKETCH
Line5352	Note:
20Apr16 / 25Jul16	
Inv.442	1 - ATTIC: INSTALL CONDUIT PIPE- FROM ATTIC TO ELECTRICAL PANEL- MUST SPECIFY LOCATION AND TERMINATION POINT. LOCATION TO BE DETERMINED BY VENDOR
Line5357	Note:
20Apr16 / 25Jul16	

ELECTRICAL

Inv.442	1 - ROUGH-IN FOR EXTERIOR PORCH CEILING OUTLET WITH COVER PLAN (ON SAME SWITCH) SPECIFY LOCATION
Line5355	Note:
20Apr16 / 25Jul16	
Inv.442	1 - FAMILY ROOM: INSTALL 110V WALL RECEPTACLE ON DEDICATED CIRCUIT - FOR FUTURE TV. INSTALL 5' OFF FINISHED FLOOR. SEE SKETCH
Line5354	Note:
20Apr16 / 25Jul16	
Inv.442	1 - KITCHEN: INSTALL KITCHEN CABINET VALANCE LIGHTS (UNDER CABINETS) - WITH STRIP LIGHTS - DOES NOT INCLUDE (AND REQUIRES) KITCHEN UPGRADE PRICING
Line5356	Note:
20Apr16 / 25Jul16	
Inv.442	1 - KITCHEN: RELOCATE STANDARD KITCHEN LIGHT FIXTURE - SEE SKETCH
Line5364	Note: LOCATIONS MAY VARY SLIGHTLY DUE TO JOIST LOCATIONS
20Apr16 / 25Jul16	
Inv.442	1 - KITCHEN: INSTALL ROUGH - IN CEILING OUTLET ON SAME SWITCH AS STANDARD KITCHEN LIGHT- DOES NOT INCLUDE FIXTURE - ABOVE ISLAND. SEE SKETCH
Line5365	Note: LOCATIONS MAY VARY SLIGHTLY DUE TO JOIST LOCATIONS
20Apr16 / 25Jul16	
Inv.442	5 - KITCHEN: INSTALL FIVE (5) POT LIGHTS: 4 INCH HALOGEN POT LIGHT - 440 WH- IN KITCHEN, ON SAME SWITCH. SEE SKETCH
Line5366	Note:
20Apr16 / 25Jul16	
Inv.442	1 - KITCHEN: INSTALL ONE (1) POT LIGHTS: 4 INCH HALOGEN POT LIGHT - 440 WH- ABOVE KITCHEN SINK, ON SEPERATE SWITCH. SEE SKETCH
Line5367	Note:
20Apr16 / 25Jul16	
Inv.442	8 - FAMILY ROOM: INSTALL EIGHT (8) POT LIGHTS: 4 INCH HALOGEN POT LIGHT - 440 WH- IN FAMILY ROOM, ON SAME SWITCH. SEE SKETCH
Line5368	Note: DELETE STANDARD FAMILY ROOM LIGHT
20Apr16 / 25Jul16	

EXTERIOR COLOURS

Inv.692	1 - EXTERIOR COLOUR PACKAGE 3
Line9183	Note:
25Jul16 / 25Jul16	

FORMING

Inv.442	1 - EXTERIOR: INSTALL SIDE DOOR- HOME TO EXTERIOR- AS PER PLAN AND GRADE PERMITTING
Line5359	Note:
20Apr16 / 25Jul16	

Inv.442	1 - COLD CELLAR
Line5724	Note: As Per M.C. 04/29/15
20Apr16 / 25Jul16	

FRAMING

Inv.442	1 - GARAGE: INSTALL MANDOOR - GARAGE TO HOUSE- AS PER PLAN AND GRADE PERMITTING
Line5358	Note:
20Apr16 / 25Jul16	

Inv.442	1 - ENSUITE 2: INSTALL SHOWER IN LIEU OF TUB- FRAMED SHOWER ENCLOSURE WITH POTLIGHT
Line9180	Note:
20Apr16 / 25Jul16	

GLASS AND MIRROR

Inv.442	1 - ENSUITE 2: INSTALL SHOWER IN LIEU OF TUB- FRAMED SHOWER ENCLOSURE WITH POTLIGHT
Line5360	Note:
20Apr16 / 25Jul16	

Inv.442	1 - MASTER ENSUITE: CONVERT FRAMED SHOWER TO 10MM FRAMLESS SHOWER ENCLOSURE WITH DOOR AND 10MM SIDE PANEL
Line5362	Note:
20Apr16 / 25Jul16	

HVAC

Inv.442	1 - KITCHEN: INSTALL GAS LINE ROUGH - MAIN FLOOR- (2-STOREY MODELS) FOR STOVE
Line5363	Note:
20Apr16 / 25Jul16	

PLUMBING


Inv.442	1 - ENSUITE #2: INSTALL BIDET - ROUGH-IN (DOES NOT INCLUDE FIXTURE). VANITY MUST BE MADE SMALLER TO ACCOMODATE ROUGH-IN. EXTRA CHARGES MAY APPLY.
Line5361	Note:
20Apr16 / 25Jul16	

Inv.442	1 - ENSUITE 2: INSTALL SHOWER IN LIEU OF TUB- FRAMED SHOWER ENCLOSURE WITH POTLIGHT
Line9181	Note:
20Apr16 / 25Jul16	


The Handel

38' SERIES

Elevation A • 2,603 sq.ft. | Elevation B • 2,603 sq.ft.

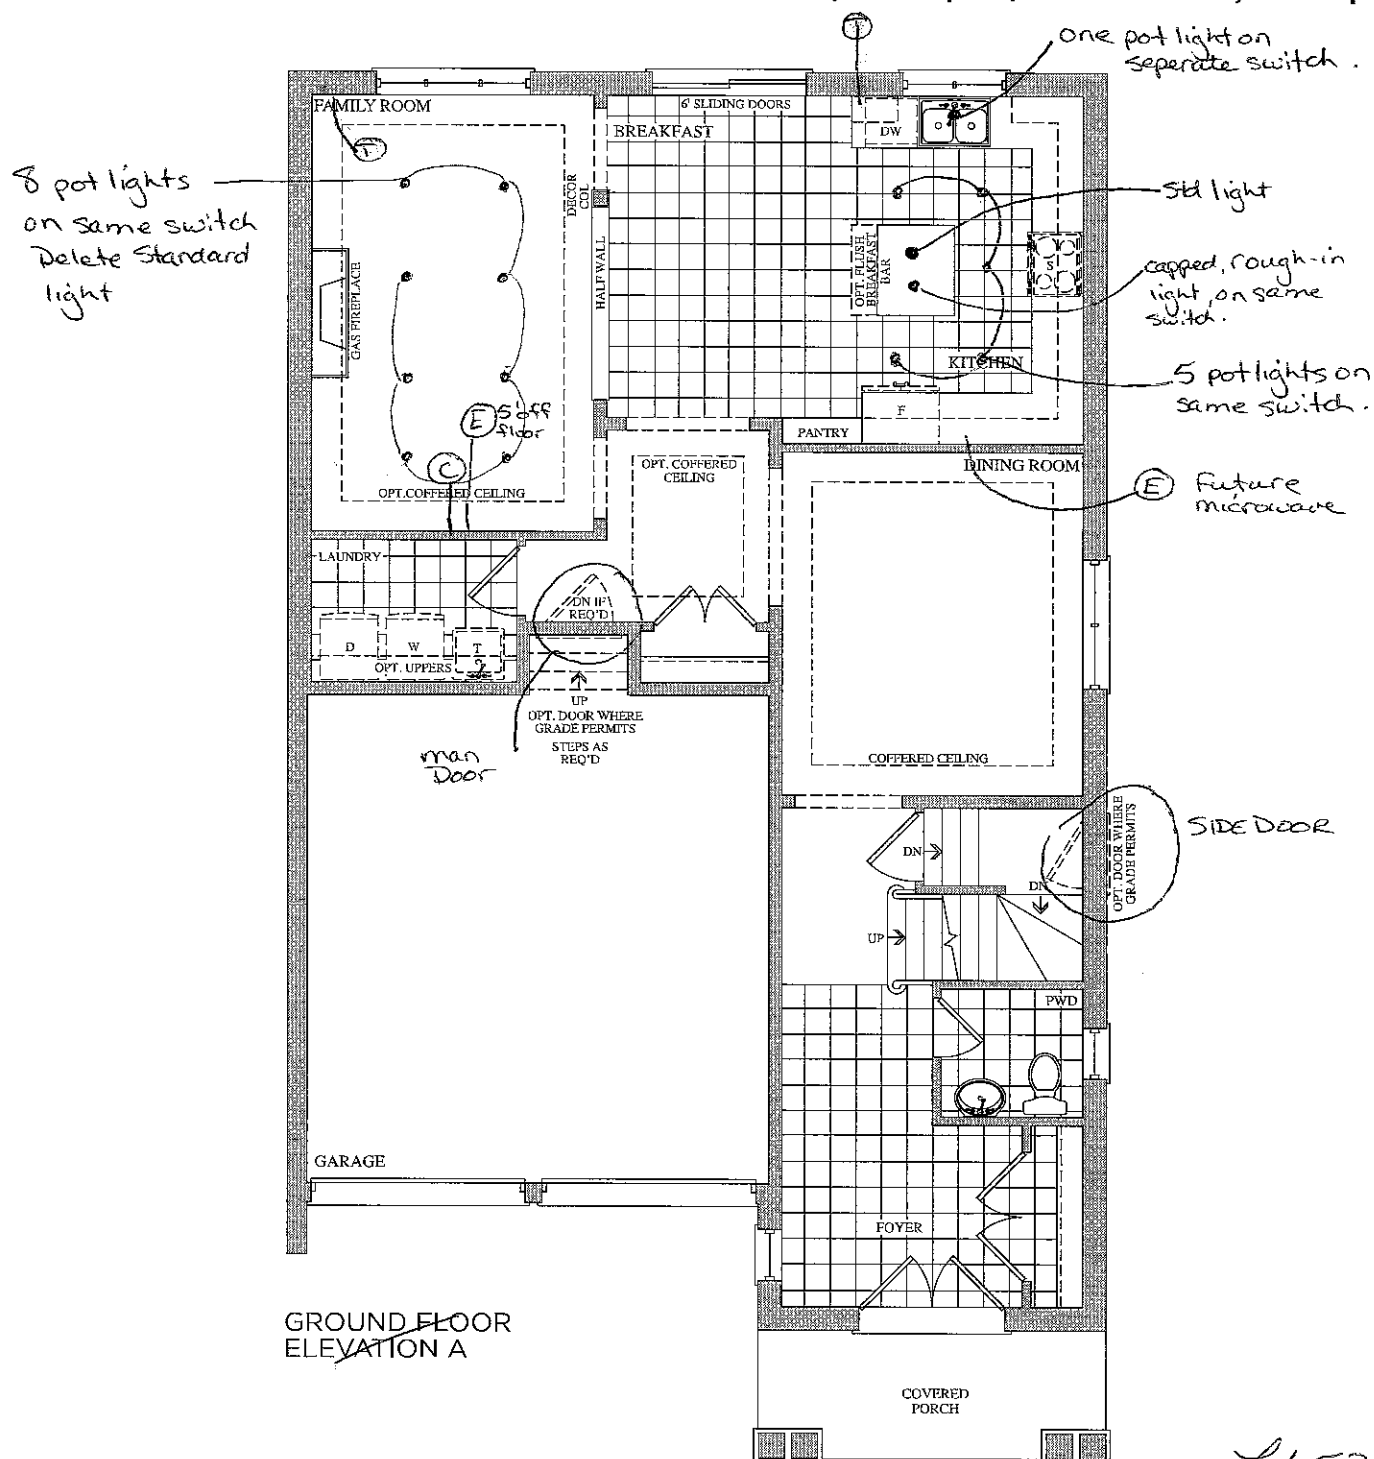

GROUND FLOOR
ELEVATION A

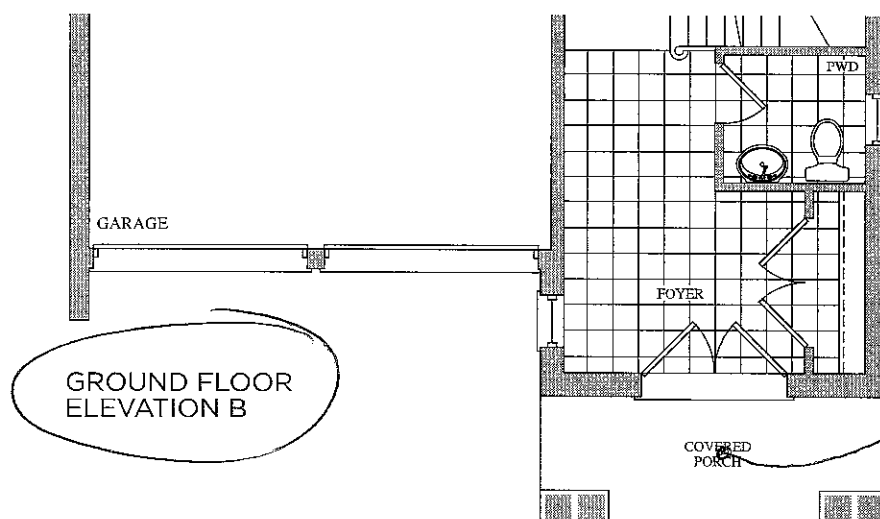

GROUND FLOOR
ELEVATION B

Lot 53
April 20, 2016




ceiling outlet
w/ cover plate
with switch.


Telephone — (T)
Cable — (C)

The
Handel
38' SERIES

Elevation A • 2,603 sq.ft. | Elevation B • 2,603 sq.ft.

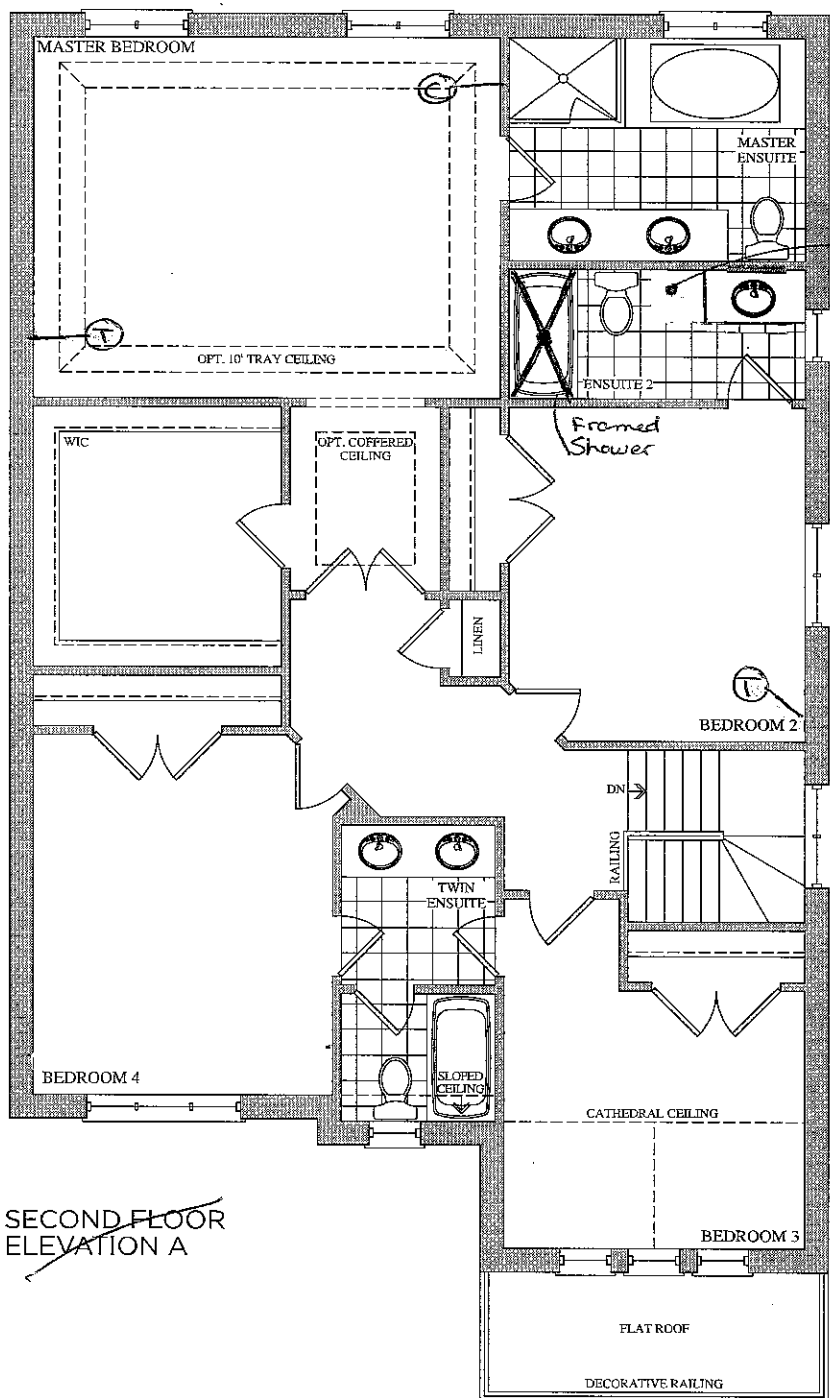

SECOND FLOOR
ELEVATION A

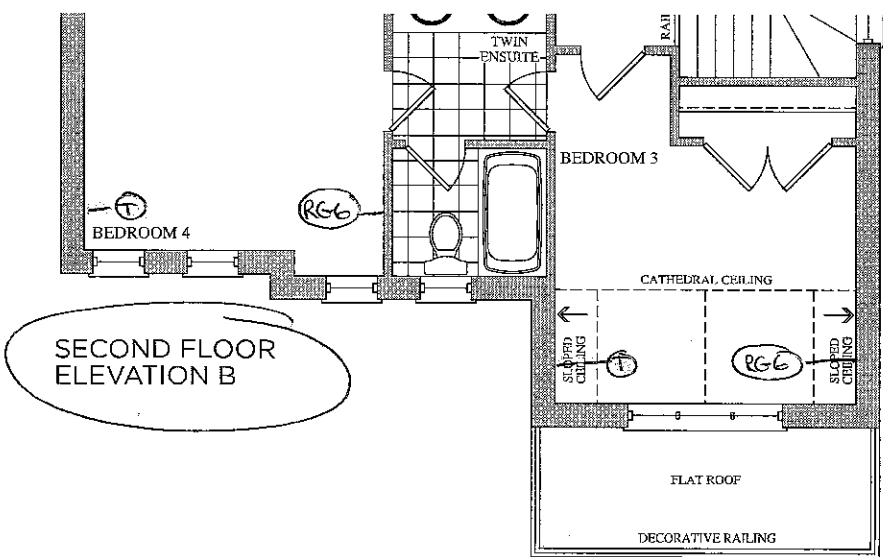


SECOND FLOOR
ELEVATION B

Lot 53
April 20, 2016
(Handwritten initials and signature)

Prices, figures, illustrations, sizes, features and finishes are subject to change without notice. E.&O.C. Areas and dimensions are approximate and actual usable floor space may vary from the stated area. Layout may be reverse of the unit purchased. E. & O.E.

Elevation A • 2,603 sq.ft. | Elevation B • 2,603 sq.ft.

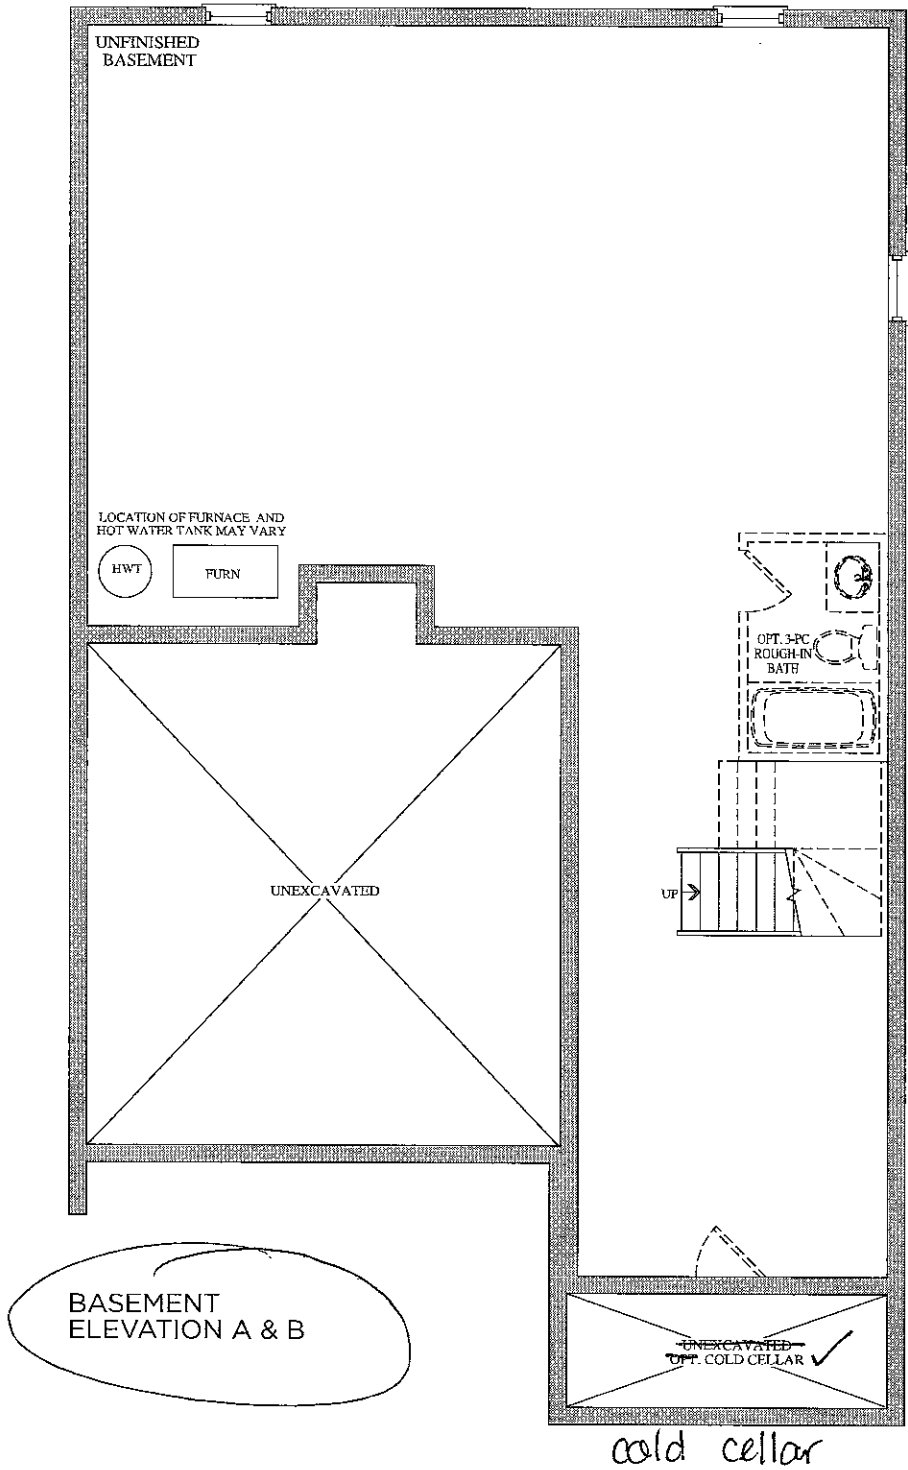

Lot 53
April 20, 2016



Stacey Carlete
Project Coordinator



Claude Azzopardi
Contracts Manager



Nancy Mc
Corporate C

53
Lot #



38.1 The Bizet			
Elevation	Circle One	A	2189.6 Square Feet
		B	2186.7 Square Feet
Optional Layouts	Circle All that Apply		

38.2 The Ravel			
Elevation	Circle One	A	2271.5 Square Feet
		B	2273.7 Square Feet
Optional Layouts	Circle All that Apply		

38.3 The Haydn			
Elevation	Circle One	A	2394.5 Square Feet
		B	2388.3 Square Feet
Optional Layouts	Circle All that Apply		

38.4 The Vivaldi			
Elevation	Circle One	A	2459.1 Square Feet
		B	2459.1 Square Feet
Optional Layouts	Circle All that Apply		

38.5 The Handel			
Elevation	Circle One	A	2549.2 Square Feet
		B	2554.7 Square Feet
Optional Layouts	Circle All that Apply		

38.9 The Puccini			
Elevation	Circle One	A	3628.0 Square Feet
		B	3634.7 Square Feet
Optional Layouts	Circle All that Apply	GFA1	GROUND FLOOR Optional Alternative Layout

38.6 The Scarlatti			
Elevation	Circle One	A	3521.1 Square Feet
		B	3508.1 Square Feet
Optional Layouts	Circle All that Apply	GFA1	GROUND FLOOR Optional Alternative Layout

38.7 The Schubert			
Elevation	Circle One	A	3593.8 Square Feet
		B	3610.5 Square Feet
Optional Layouts	Circle All that Apply	GFA1	GROUND FLOOR Optional Alternative Layout
		SFA4	SECOND FLOOR Additional Bedroom

38.8 The Corelli			
Elevation	Circle One	A	3801.5 Square Feet
		B	3801.5 Square Feet
Optional Layouts	Circle All that Apply	GFA1	GROUND FLOOR Optional Alternative Layout
		SFA4	SECOND FLOOR Additional Bedroom w/ Ensuite

41.1 The Strauss			
Elevation	Circle One	A	2554.2 Square Feet
		B	2571.2 Square Feet
Optional Layouts	Circle All that Apply	SFA1	SECOND FLOOR Shower in Lieu of Tub B2

41.2 The Mozart			
Elevation	Circle One	A	2725.9 Square Feet
		B	2711.1 Square Feet
Optional Layouts	Circle All that Apply	SFA1	SECOND FLOOR Shower in Lieu of Tub B2

41.3 The Chopin			
Elevation	Circle One	A	2800.0 Square Feet
		B	2810.5 Square Feet
Optional Layouts	Circle All that Apply		

41.4 The Bach			
Elevation	Circle One	A	2894.4 Square Feet
		B	2894.5 Square Feet
Optional Layouts	Circle All that Apply		

41.5 The Brahms			
Elevation	Circle One	A	3948.1 Square Feet
		B	3949.1 Square Feet
Optional Layouts	Circle All that Apply	GFA1	GROUND FLOOR Optional Alternative Layout
		SFA2	SECOND FLOOR Shower in Lieu of Tub B4
		SFA3	SECOND FLOOR Optional Laundry Layout

41.6 The Verdi			
Elevation	Circle One	A	3862.5 Square Feet
		B	3866.4 Square Feet
Optional Layouts	Circle All that Apply	GFA1	GROUND FLOOR Optional Alternative Layout
		SFA3	SECOND FLOOR Optional Laundry Layout

April 20, 2016

