

Brampton Encore - 87 - 1 - 41-3 Elev.A CHOPIN
CENTRAL VAC AND WIRING

Inv.632	1 - TELEPHONE AND CABLE ROUGH-IN LOCATIONS
Line7979	Note:
7Jul16 / 27Oct16	
Inv.632	1 - FAMILY ROOM: INSTALL CONDUIT PIPE- FOR TELEVISION- ABOVE FIREPLACE, SEE SKETCH
Line7981	Note:
7Jul16 / 27Oct16	
Inv.632	1 - INSTALL VAC PAN UNDER KITCHEN SINK
Line7990	Note:
7Jul16 / 27Oct16	

ELECTRICAL

Inv.632	1 - FAMILY ROOM: INSTALL 110V WALL RECEPTACLE ON DEDICATED CIRCUIT - ABOVE FIREPLACE SEE SKETCH
Line7982	Note:
7Jul16 / 27Oct16	

EXTERIOR COLOURS

Inv.632	1 - EXTERIOR COLOUR PACKAGE 7
Line13161	Note:
7Jul16 / 27Oct16	

FORMING

Inv.632	1 - EXTERIOR: INSTALL SIDE DOOR- HOME TO EXTERIOR- AS PER PLAN AND GRADE PERMITTING
Line7984	Note:
7Jul16 / 27Oct16	

FRAMING

Inv.632	1 - GARAGE: INSTALL MANDOOR - GARAGE TO HOUSE- AS PER PLAN AND GRADE PERMITTING
Line7983	Note: GIVEN IN AGREEMENT OF PURCHAE AND SALE
7Jul16 / 27Oct16	
Inv.632	1 - MAILN FLOOR: INSTALL SIX (X6) STANDARD DOOR EXTENDED HEIGHT 96" (PRICE PER DOOR)- GROUND FLOOR 2 STOREY MODELS. ON CLOSETS, POWDER ROOM AND BASEMENT DOOR
Line13160	Note:
7Jul16 / 27Oct16	

INTERIOR TRIM AND DOORS

Inv.632	6 - MAILN FLOOR: INSTALL SIX (X6) STANDARD DOOR EXTENDED HEIGHT 96" (PRICE PER DOOR)- GROUND FLOOR 2 STOREY MODELS. ON CLOSETS, POWDER ROOM AND BASEMENT DOOR
Line7989	Note:
7Jul16 / 27Oct16	

KITCHEN AND BATH CABINETRY

Inv.632	1 - INSTALL VAC PAN UNDER KITCHEN SINK
Line13159	Note:
7Jul16 / 27Oct16	

MISC.

Brampton Encore - 87 - 1 - 41-3 Elev.A CHOPIN

Inv.632	1 - BONUS PACKAGE: \$7864.80 (INCLUDING TAXES) WORTH OF UPGRADES FROM GOLD PARK HOMES DÉCOR CENTRE IS BEING APPLIED TOWARD THE STRUCTURAL APPOINTMENT. PURCHASER HAS A REMAINING AMOUNT OF \$7135.20 (INCLUDING TAXES) TO BE USED TOWARD THE COLOUR APPOINTMENT
Line7994	Note:
7Jul16 / 27Oct16	
Inv.632	1 - Purchaser has attended a Structural appointment at the Decor Centre & has DECLINED any additional upgrades and accepts and acknowledges that there will be no further structural changes/additions/deletions to be made upon signing on July 7, 2016
Line7995	Note:
7Jul16 / 27Oct16	
Inv.632	1 - Purchasers are aware & accepts that ANY changes made to upgrades after signing this Purchasers Extra Form are subject to a minimum administration fee of \$500. PLUS a 10% holdback fee
Line7996	Note:
7Jul16 / 27Oct16	

PLUMBING

Inv.632	1 - ROUGH-IN - 3PC BASEMENT ROUGH-IN
Line7991	Note:
7Jul16 / 27Oct16	

WINDOWS - BASEMENT


Inv.632	3 - BASEMENT: INSTALL THREE (X3) BASEMENT WINDOWS - UPGRADE EXISTING BASEMENT WINDOW TO 30 INCH X 24 INCH - MAY REQUIRE INSTALLATION OF WINDOW WELL
Line7988	Note:
7Jul16 / 27Oct16	

WINDOWS AND DOORS

Inv.632	1 - MAN DOOR GARAGE TO HOUSE - OPTIONAL - IF GRADE PERMITS
Line13158	Note:
7Jul16 / 27Oct16	

The
Chopin
41' SERIES


Elevation A • 2,858 sq.ft. | Elevation B • 2,870 sq.ft.

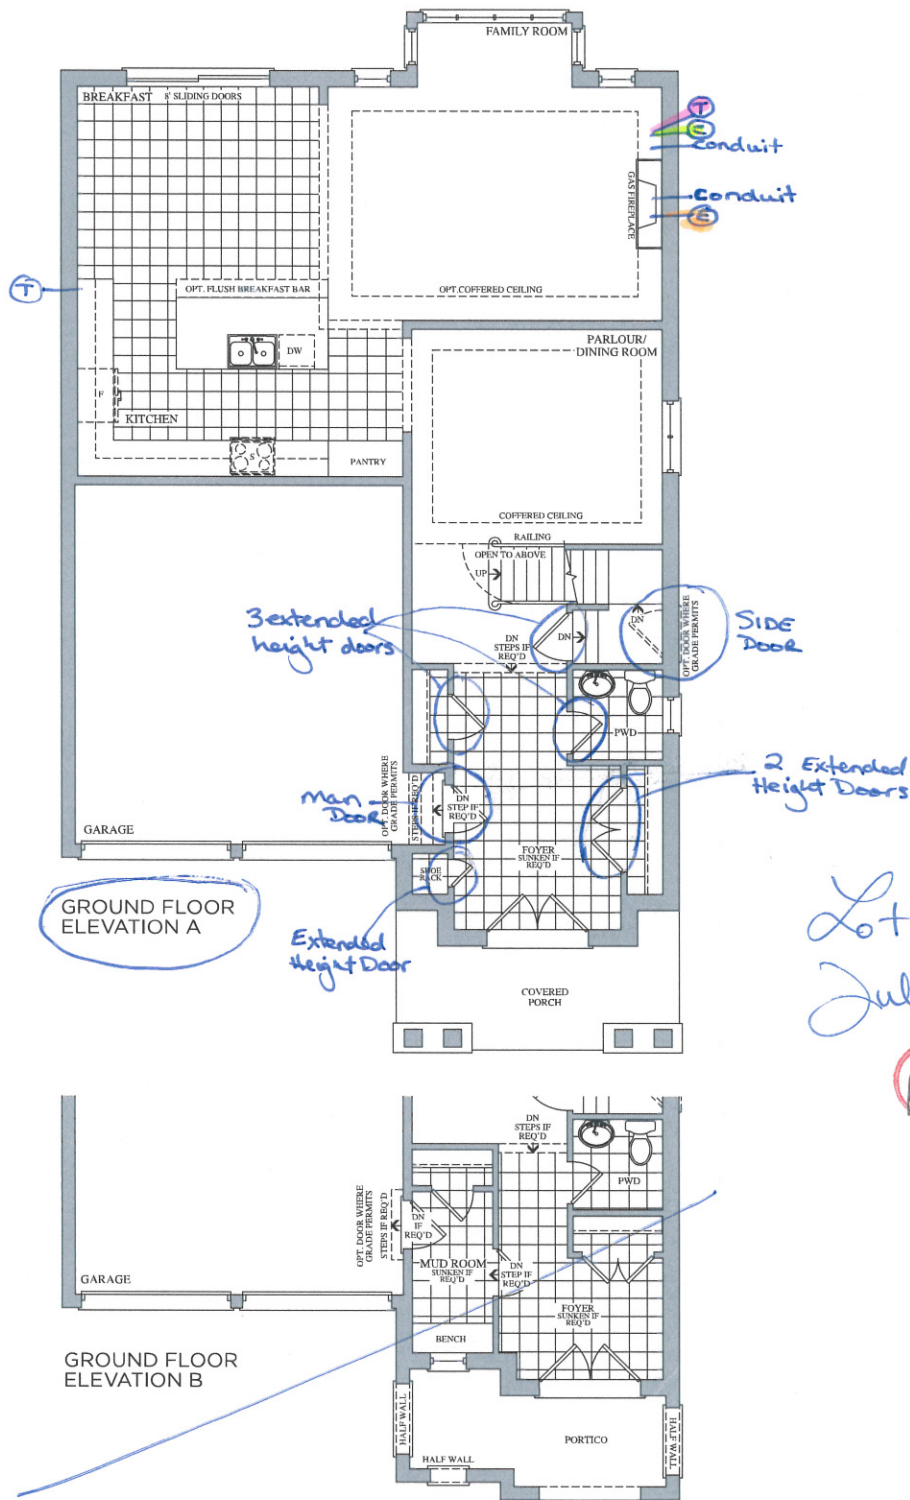


Prices, figures, illustrations, sizes, features and finishes are subject to change without notice. E.&O.E. Areas and dimensions are approximate and actual usable floor space may vary from the stated area. Layout may be reverse of the unit purchased. E. & O.E.

The
Chopin
41' SERIES

Elevation A • 2,858 sq.ft. | Elevation B • 2,870 sq.ft.

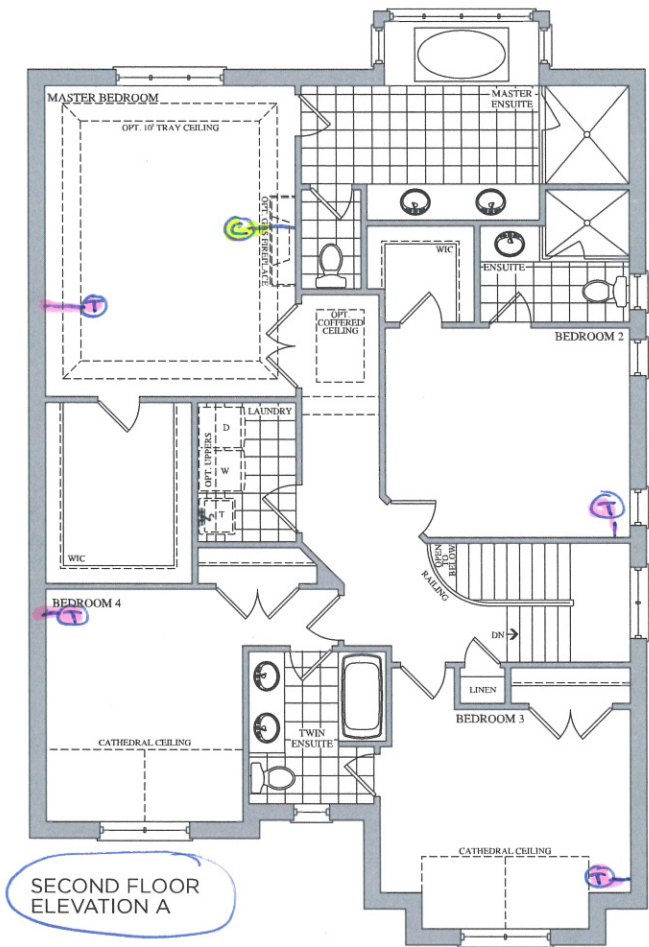

SECOND FLOOR
ELEVATION A

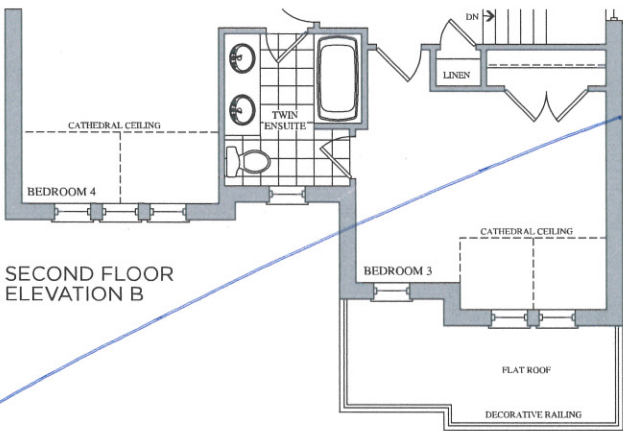


SECOND FLOOR
ELEVATION B

Lot 87
July 7, 16


K.C. ○

BSMT WINDOWS
3 x 30"x24"

Elevation A • 2,858 sq.ft. | Elevation B • 2,870 sq.ft.

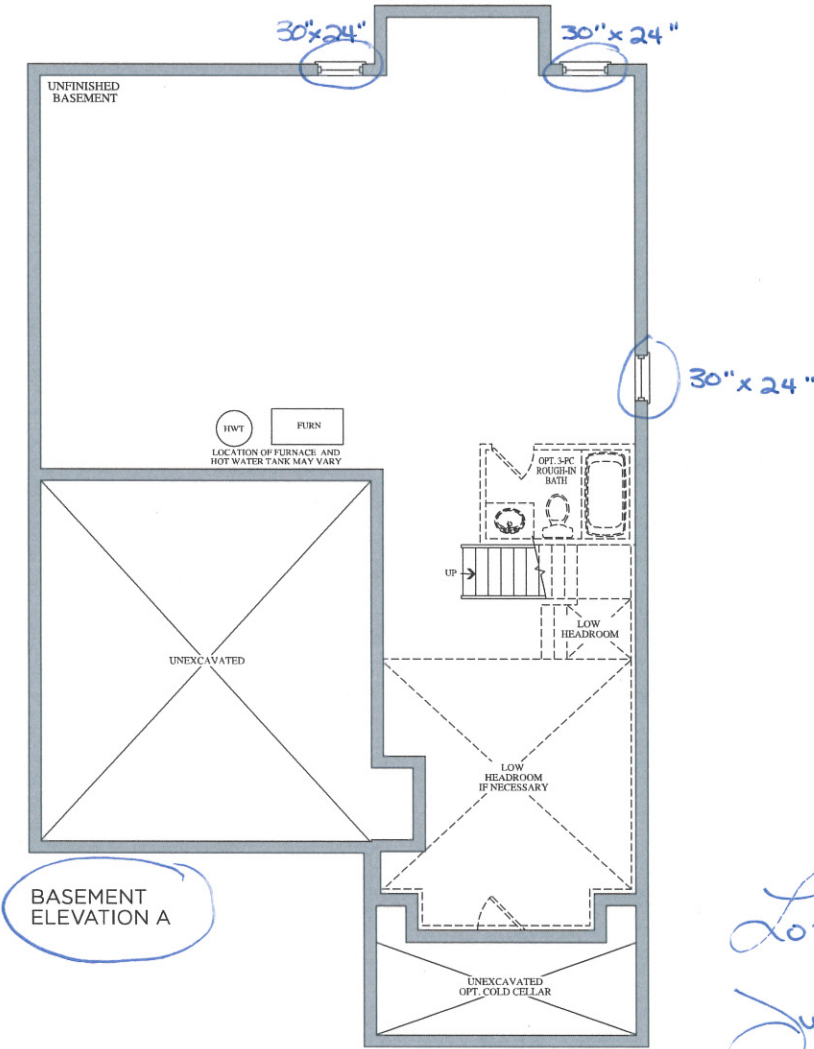

Lot 87
July 7, 16
K.C.

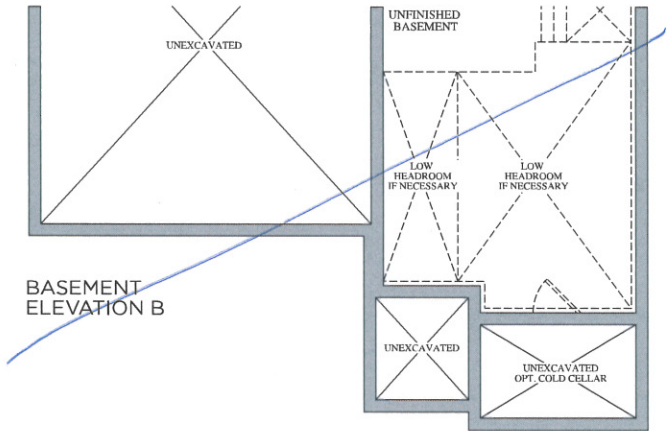

Prices, figures, illustrations, sizes, features and finishes are subject to change without notice. E.&O.E. Areas and dimensions are approximate and actual usable floor space may vary from the stated area. Layout may be reverse of the unit purchased. E. & O.E.



Stacey Carlete
Project Coordinator



Claude Azzopardi
Contracts Manager



Nancy Mc
Corporate C

87
Lot #



encore
BRAMPTON

38.1 The Bizet			
Elevation	Circle One	A	2189.6 Square Feet
		B	2186.7 Square Feet
Optional Layouts	Circle All that Apply		

38.2 The Ravel			
Elevation	Circle One	A	2271.5 Square Feet
		B	2273.7 Square Feet
Optional Layouts	Circle All that Apply		

38.3 The Haydn			
Elevation	Circle One	A	2394.5 Square Feet
		B	2388.3 Square Feet
Optional Layouts	Circle All that Apply		

38.4 The Vivaldi			
Elevation	Circle One	A	2459.1 Square Feet
		B	2459.1 Square Feet
Optional Layouts	Circle All that Apply		

38.5 The Handel			
Elevation	Circle One	A	2549.2 Square Feet
		B	2554.7 Square Feet
Optional Layouts	Circle All that Apply		

38.9 The Puccini			
Elevation	Circle One	A	3628.0 Square Feet
		B	3634.7 Square Feet
Optional Layouts	Circle All that Apply	GFA1	GROUND FLOOR Optional Alternative Layout

38.6 The Scarlatti			
Elevation	Circle One	A	3521.1 Square Feet
		B	3508.1 Square Feet
Optional Layouts	Circle All that Apply	GFA1	GROUND FLOOR Optional Alternative Layout

38.7 The Schubert			
Elevation	Circle One	A	3593.8 Square Feet
		B	3610.5 Square Feet
Optional Layouts	Circle All that Apply	GFA1	GROUND FLOOR Optional Alternative Layout
		SFA4	SECOND FLOOR Additional Bedroom

38.8 The Corelli			
Elevation	Circle One	A	3801.5 Square Feet
		B	3801.5 Square Feet
Optional Layouts	Circle All that Apply	GFA1	GROUND FLOOR Optional Alternative Layout
		SFA4	SECOND FLOOR Additional Bedroom w/ Ensuite

41.1 The Strauss			
Elevation	Circle One	A	2554.2 Square Feet
		B	2571.2 Square Feet
Optional Layouts	Circle All that Apply	SFA1	SECOND FLOOR Shower In Lieu of Tub B2

41.2 The Mozart			
Elevation	Circle One	A	2725.9 Square Feet
		B	2711.1 Square Feet
Optional Layouts	Circle All that Apply	SFA1	SECOND FLOOR Shower In Lieu of Tub B2

41.3 The Chopin			
Elevation	Circle One	A	2800.0 Square Feet
		B	2810.5 Square Feet
Optional Layouts	Circle All that Apply		

41.4 The Bach			
Elevation	Circle One	A	2894.4 Square Feet
		B	2894.5 Square Feet
Optional Layouts	Circle All that Apply		

41.5 The Brahms			
Elevation	Circle One	A	3948.1 Square Feet
		B	3949.1 Square Feet
Optional Layouts	Circle All that Apply	GFA1	GROUND FLOOR Optional Alternative Layout
		SFA2	SECOND FLOOR Shower In Lieu of Tub B4
Optional Layouts	Circle All that Apply	SFA3	SECOND FLOOR Optional Laundry Layout

41.6 The Verdi			
Elevation	Circle One	A	3862.5 Square Feet
		B	3866.4 Square Feet
Optional Layouts	Circle All that Apply	GFA1	GROUND FLOOR Optional Alternative Layout
		SFA3	SECOND FLOOR Optional Laundry Layout
Optional Layouts	Circle All that Apply		

July 7, 16

Kc