

Brampton Encore - 125 - 1 - 41-5 Elev.A BRAHMS OPT - GFA1

CENTRAL VAC AND WIRING

Inv.641	1 - DEN: INSTALL ADDITIONAL CAT 6- MUST SPECIFY LOCATION. SEE SKETCH
Line14480	Note:
11Jul16 / 24Nov16	
Inv.641	1 - MASTER BEDROOM: UPGRADE CAT 5 TO CAT 6 WIRING - UPGRADE AN OUTLET TO CAT 6- MUST SPECIFY LOCATION. SEE SKETCH
Line14476	Note:
11Jul16 / 24Nov16	
Inv.641	1 - TELEPHONE AND CABLE ROUGH-IN LOCATIONS
Line8161	Note:
11Jul16 / 24Nov16	
Inv.641	1 - BEDROOM 3: UPGRADE CAT 5 TO CAT 6- MUST SPECIFY LOCATION. SEE SKETCH
Line14478	Note:
11Jul16 / 24Nov16	
Inv.641	1 - GROUND FLOOR: INSTALL ROUGH-IN FOR EXTRA SECURITY KEY PAD, ON GROUND FLOOR. SEE SKETCH FOR LOCATION
Line8163	Note:
11Jul16 / 24Nov16	
Inv.641	1 - MASTER BEDROOM: INSTALL ROUGH-IN FOR EXTRA SECURITY KEY PAD IN MASTER BEDROOM, BY LIGHT SWITCH.
Line8164	Note:
11Jul16 / 24Nov16	
Inv.641	1 - FAMILY ROOM: INSTALL CONDUIT PIPE- FOR TELEVISION- MUST SPECIFY LOCATION AND TERMINATION POINT. TO GO ABOVE FIREPLACE
Line14473	Note:
11Jul16 / 24Nov16	
Inv.641	1 - FAMILY ROOM: INSTALL ADDITIONAL CABLE (COAX) - IN FAMILY ROOM, ABOVE FIREPLACE. SEE SKETCH
Line14475	Note:
11Jul16 / 24Nov16	
Inv.641	1 - BEDROOM 2: UPGRADE CAT 5 TO CAT 6- MUST SPECIFY LOCATION. SEE SKETCH
Line14477	Note:
11Jul16 / 24Nov16	
Inv.641	1 - BEDROOM 4: UPGRADE CAT 5 TO CAT 6- MUST SPECIFY LOCATION. SEE SKETCH
Line14479	Note:
11Jul16 / 24Nov16	
Inv.641	1 - GROUND FLOOR REC ROOM: INSTALL ADDITIONAL CAT 6- MUST SPECIFY LOCATION. SEE SKETCH
Line14481	Note:
11Jul16 / 24Nov16	
Inv.641	1 - FAMILY ROOM: UPGRADE CAT 5 TO CAT 6- MUST SPECIFY LOCATION. SEE SKETCH
Line14482	Note:
11Jul16 / 24Nov16	

ELECTRICAL

Inv.641	5 - EXTERIOR: INSTALL FIVE (X5) POT LIGHTS: 4 INCH LINE VOLTAGE POT LIGHT - (EXTERIOR) , AS PER SKETCH. SEE PLAN
Line8171	Note:
11Jul16 / 24Nov16	

Brampton Encore - 125 - 1 - 41-5 Elev.A BRAHMS OPT - GFA1

Inv.641	1 - KITCHEN: INSTALL ROUGH - IN CEILING OUTLET & SWITCH (WITH COVER PLATE) - DOES NOT INCLUDE FIXTURE - ABOVE KITCHEN ISLAND. SEE SKETCH
Line8186	Note:
11Jul16 / 24Nov16	
Inv.641	1 - LIVING/DINING ROOM: RELOCATE STANDARD DINING ROOM FIXTURE - TO THE CENTRE OF THE LIVING/DINING ROOM. SEE SKETCH
Line8167	Note: IN ADDITION TO BUILDER'S STANDARD SWITCH CONTROLLED RECEPTICAL
11Jul16 / 24Nov16	
Inv.641	1 - FAMILY ROOM: INSTALL 110V WALL RECEPTACLE ON DEDICATED CIRCUIT - ABOVE FIREPLACE FOR FUTURE TV. SEE SKETCH
Line14474	Note:
11Jul16 / 24Nov16	

EXTERIOR COLOURS

Inv.641	1 - EXTERIOR COLOUR PACKAGE 6
Line14529	Note:
11Jul16 / 24Nov16	

FORMING

Inv.641	1 - GARAGE/EXTERIOR: INSTALL BACK DOOR- GARAGE TO EXTERIOR- AS PER PLAN AND GRADE PERMITTING
Line8174	Note:
11Jul16 / 24Nov16	

FRAMING

Inv.641	1 - GARAGE: INSTALL MANDOOR - GARAGE TO HOUSE- AS PER PLAN AND GRADE PERMITTING
Line8172	Note: GIVEN IN AGREEMENT OF PURCHASE AND SALE
11Jul16 / 24Nov16	
Inv.641	1 - MAIN FLOOR: EXTENDED HEIGHT 96" (PRICE PER DOOR) MAIN FLOOR 3 STOREY MODELS - FOR CLOSETS, POWDER ROOM, PANTRY, DEN. SEE SKETCH
Line14528	Note:
11Jul16 / 24Nov16	
Inv.641	1 - OPTIONAL GROUND FLOOR
Line14526	Note:
11Jul16 / 24Nov16	

GARAGE DOORS

Inv.641	2 - GARAGE: INSTALL TWO (X2) INSULATION KIT - STANDARD GARAGE DOORS - EACH HOUSE REQUIRES 2 INSULATION KITS- PER DOOR PRICE
Line14484	Note:
11Jul16 / 24Nov16	

INTERIOR TRIM AND DOORS

Inv.641	5 - MAIN FLOOR: INSTALL FIVE (X5) STANDARD DOOR EXTENDED HEIGHT 96" (PRICE PER DOOR) MAIN FLOOR 3 STOREY MODELS - FOR CLOSETS, POWDER ROOM, PANTRY. SEE SKETCH
Line8177	Note:
11Jul16 / 24Nov16	
Inv.641	2 - DEN: INSTALL TWO (X2) STANDARD FRENCH DOORS EXTENDED HEIGHT 96" (PRICE PER DOOR) MAIN FLOOR 3 STOREY MODELS - FOR DEN. SEE SKETCH
Line8178	Note:
11Jul16 / 24Nov16	

Brampton Encore - 125 - 1 - 41-5 Elev.A BRAHMS OPT - GFA1

MISC.

Inv.641	1 - EXTERIOR: DO NOT INSTALL SIDE DOOR- HOME TO EXTERIOR- AS PER PLAN AND GRADE PERMITTING
Line8173	Note: GRADE DOES NOT PERMIT- SEE PE 1013
11Jul16 / 24Nov16	
Inv.641	1 - BONUS PACKAGE: \$10,000.00 (INCLUDING TAXES) WORTH OF UPGRADES FROM GOLD PARK HOMES DÉCOR CENTRE IS BEING APPLIED TOWARD THE STRUCTURAL APPOINTMENT. PURCHASER HAS A REMAINING AMOUNT OF \$00 (INCLUDING TAXES) TO BE USED TOWARD THE COLOUR APPOINTMENT
Line8188	Note:
11Jul16 / 24Nov16	
Inv.641	1 - Purchaser has attended a Structural appointment at the Decor Centre & has DECLINED any additional upgrades and accepts and acknowledges that there will be no further structural changes/additions/deletions to be made upon signing on November 23, 2016
Line8189	Note:
11Jul16 / 24Nov16	
Inv.641	1 - Purchasers are aware & accepts that ANY changes made to upgrades after signing this Purchasers Extra Form are subject to a minimum administration fee of \$500. PLUS a 10% holdback fee
Line14483	Note:
11Jul16 / 24Nov16	


PLUMBING

Inv.641	1 - KITCHEN: INSTALL ROUGH-IN - WATERLINE FOR FRIDGE
Line8184	Note:
11Jul16 / 24Nov16	
Inv.641	1 - BASEMENT: INSTALL ROUGH-IN - 3PC BASEMENT ROUGH-IN, AS PER PLAN
Line8185	Note:
11Jul16 / 24Nov16	

(T) Telephone
 (C) Cable
 (E) Electrical

**The
Brahms
41' SERIES**

Elevation A • 4,038 sq.ft. | Elevation B • 4,038 sq.ft.

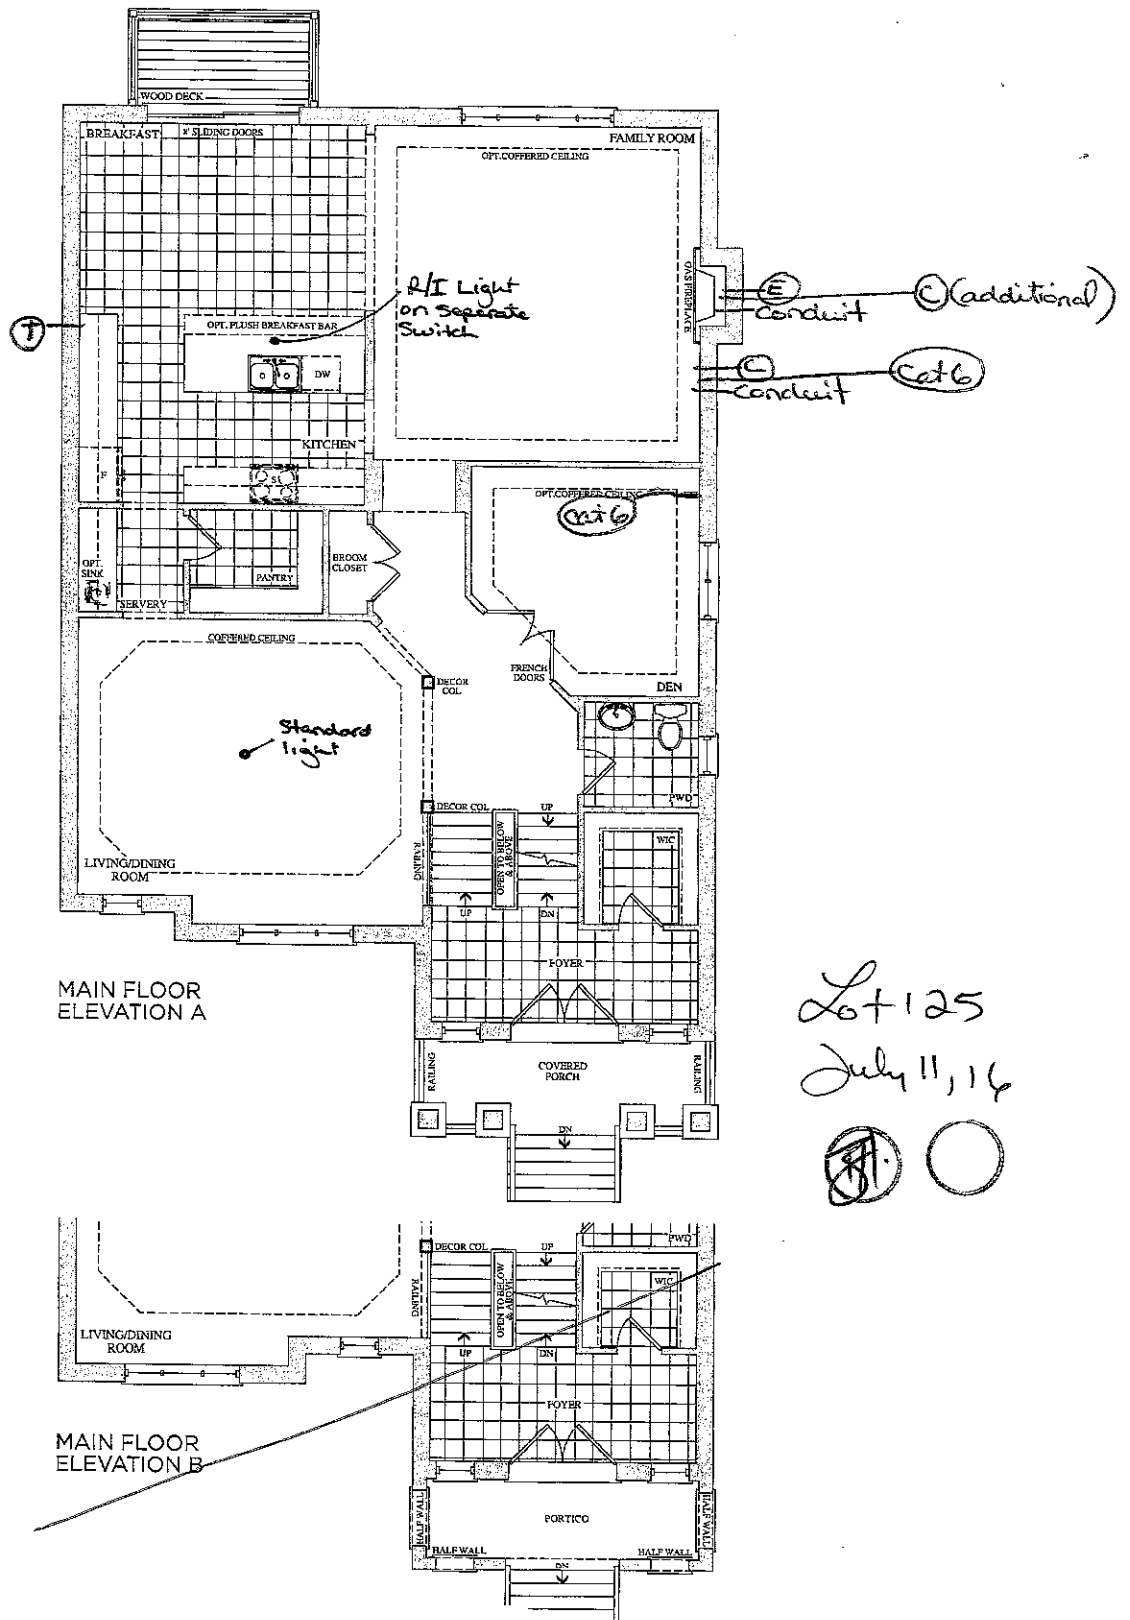


Prices, figures, illustrations, sizes, features and finishes are subject to change without notice. E.&O.E. Areas and dimensions are approximate and actual usable floor space may vary from the stated area. Layout may be reverse of the unit purchased. E. & O.E.


GOLDPARK
HOMES

The
Brahms
41' SERIES

Elevation A • 4,038 sq.ft. | Elevation B • 4,038 sq.ft.

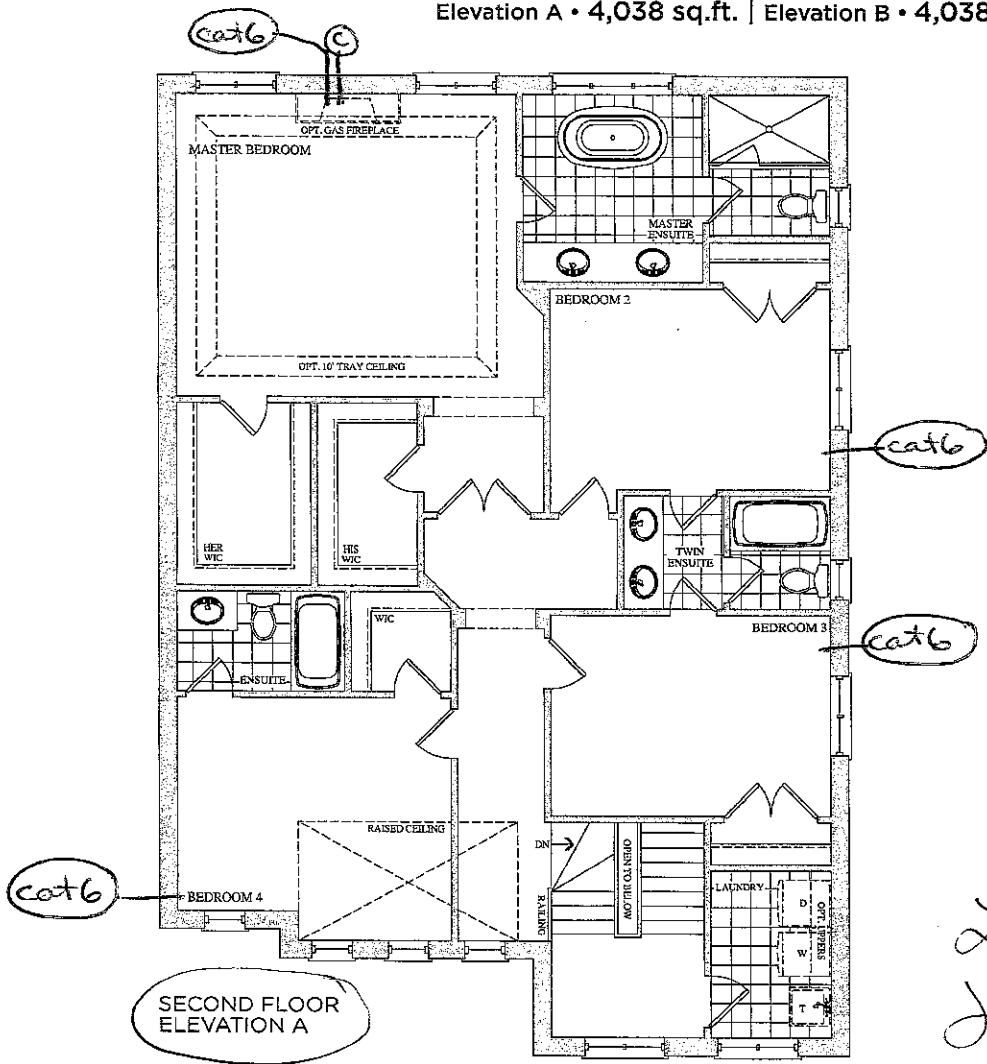


Lot 125
July 11, 16

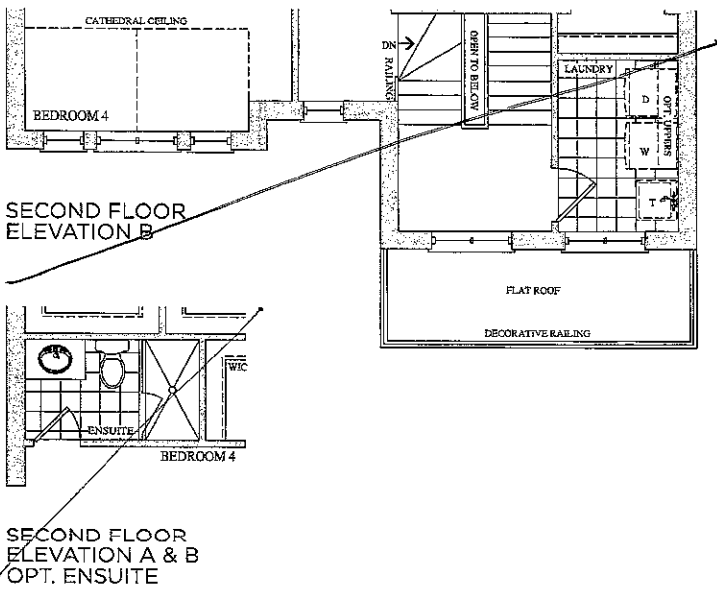


Prices, figures, illustrations, sizes, features and finishes are subject to change without notice. E.&O.E. Areas and dimensions are approximate and actual usable floor space may vary from the stated area. Layout may be reverse of the unit purchased. E. & O.E.

• Smooth Ceilings

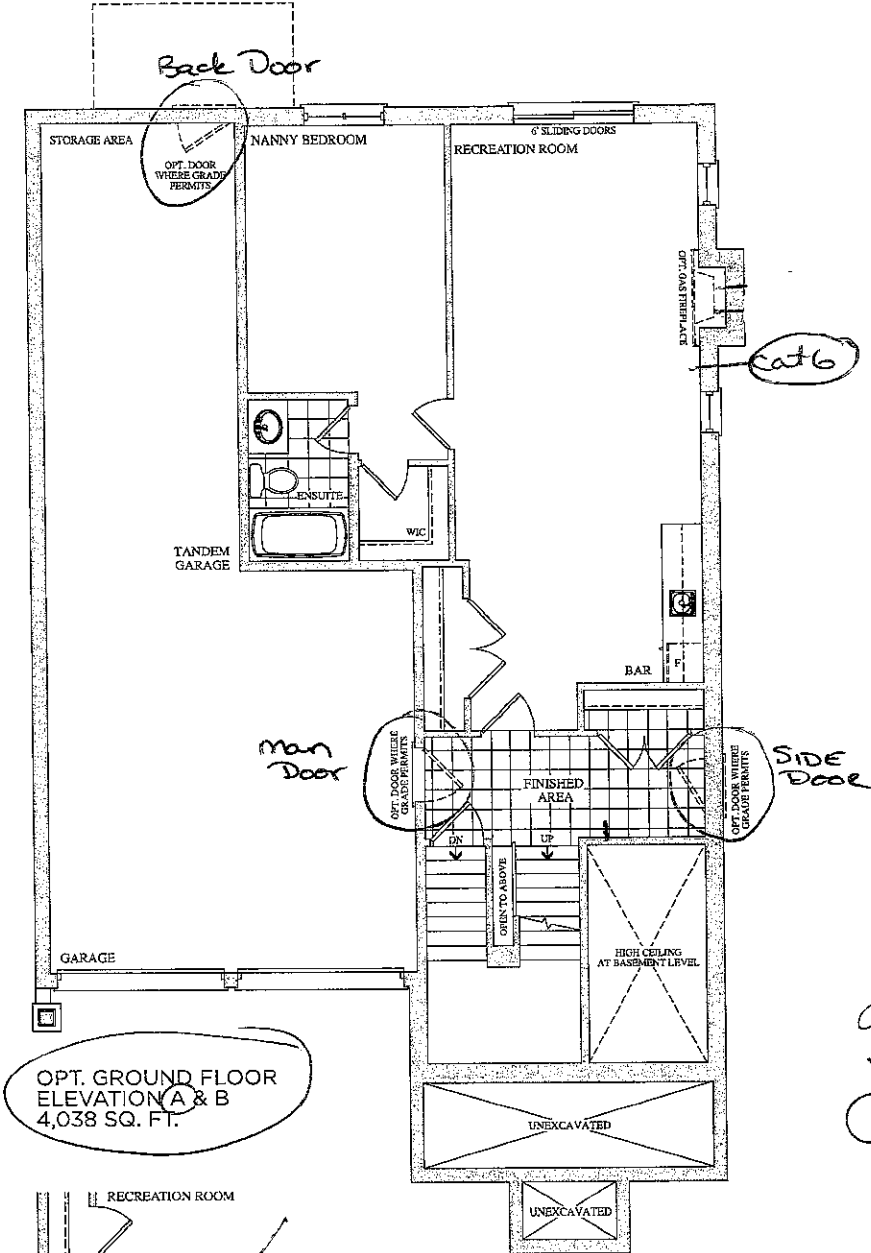


OPT. GROUND FLOOR
ELEVATION A & B
4,038 SQ. FT.

Lot 125
July 11, 16
[Signature]

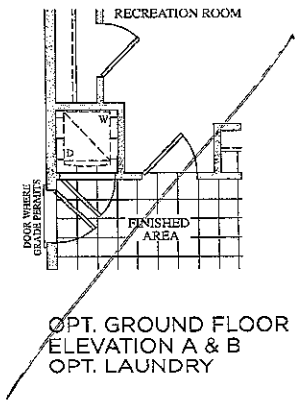


Prices, figures, illustrations, sizes, features and finishes are subject to change without notice. E.&O.E. Areas and dimensions are approximate and actual useable floor space may vary from the stated area. Layout may be reverse of the unit purchased. E. & O.E.

Elevation A • 4,038 sq.ft. | Elevation B • 4,038 sq.ft.

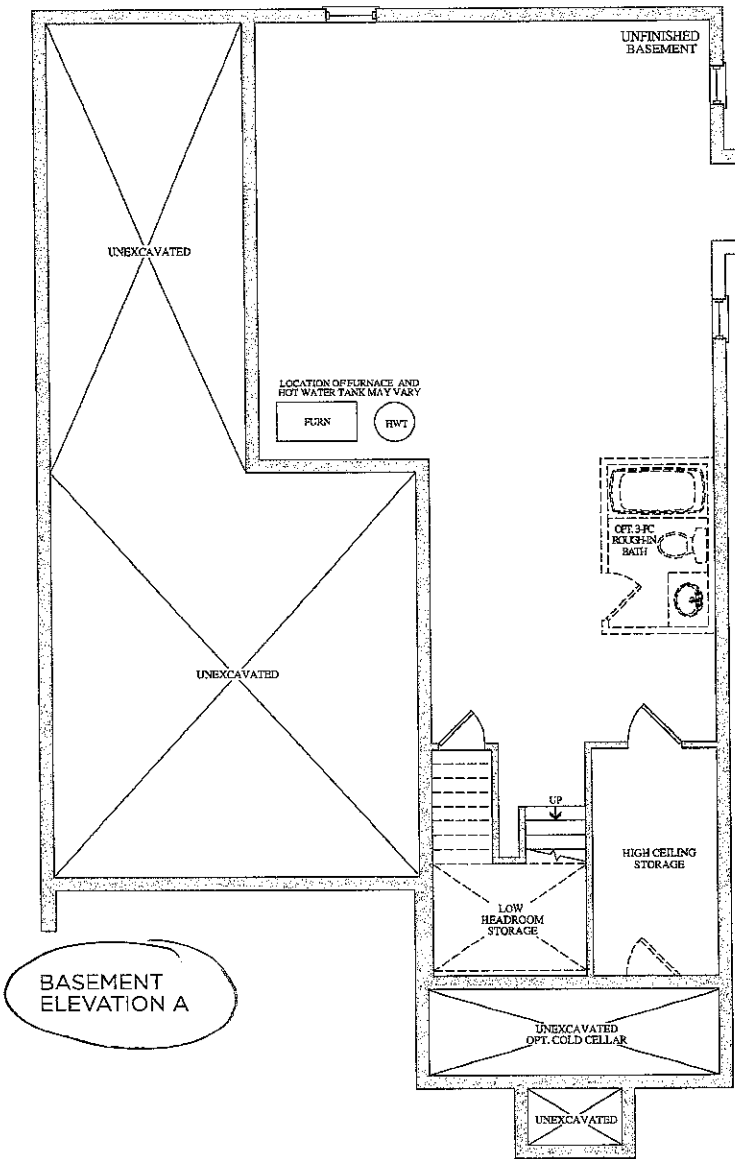

Lot 125
July 11, 16

JH.

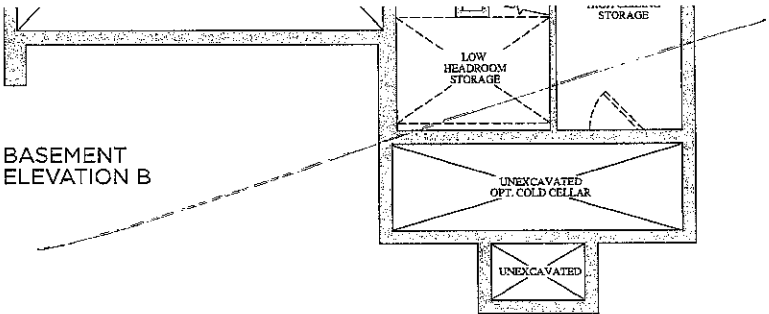

Prices, figures, illustrations, sizes, features and finishes are subject to change without notice. E.&O.E. Areas and dimensions are approximate and actual usable floor space may vary from the stated area. Layout may be reverse of the unit purchased. E. & O.E.



Stacey Carlete
Project Coordinator



Claude Azzopardi
Contracts Manager



Nancy Mc
Corporate C

125
Lot #



38.1 The Bizet			
Elevation	Circle One	A	2189.6 Square Feet
		B	2186.7 Square Feet
Optional Layouts	Circle All that Apply		

38.2 The Ravel			
Elevation	Circle One	A	2271.5 Square Feet
		B	2273.7 Square Feet
Optional Layouts	Circle All that Apply		

38.3 The Haydn			
Elevation	Circle One	A	2394.5 Square Feet
		B	2388.3 Square Feet
Optional Layouts	Circle All that Apply		

38.4 The Vivaldi			
Elevation	Circle One	A	2459.1 Square Feet
		B	2459.1 Square Feet
Optional Layouts	Circle All that Apply		

38.5 The Handel			
Elevation	Circle One	A	2549.2 Square Feet
		B	2554.7 Square Feet
Optional Layouts	Circle All that Apply		

38.9 The Puccini			
Elevation	Circle One	A	3628.0 Square Feet
		B	3634.7 Square Feet
Optional Layouts	Circle All that Apply	GFA1	GROUND FLOOR Optional Alternative Layout

38.6 The Scarlatti			
Elevation	Circle One	A	3521.1 Square Feet
		B	3508.1 Square Feet
Optional Layouts	Circle All that Apply	GFA1	GROUND FLOOR Optional Alternative Layout

38.7 The Schubert			
Elevation	Circle One	A	3593.8 Square Feet
		B	3610.5 Square Feet
Optional Layouts	Circle All that Apply	GFA1	GROUND FLOOR Optional Alternative Layout
		SFA4	SECOND FLOOR Additional Bedroom

38.8 The Corelli			
Elevation	Circle One	A	3801.5 Square Feet
		B	3801.5 Square Feet
Optional Layouts	Circle All that Apply	GFA1	GROUND FLOOR Optional Alternative Layout
		SFA4	SECOND FLOOR Additional Bedroom w/ Ensuite

41.1 The Strauss			
Elevation	Circle One	A	2554.2 Square Feet
		B	2571.2 Square Feet
Optional Layouts	Circle All that Apply	SFA1	SECOND FLOOR Shower In Lieu of Tub B2

41.2 The Mozart			
Elevation	Circle One	A	2725.9 Square Feet
		B	2711.1 Square Feet
Optional Layouts	Circle All that Apply	SFA1	SECOND FLOOR Shower In Lieu of Tub B2

41.3 The Chopin			
Elevation	Circle One	A	2800.0 Square Feet
		B	2810.5 Square Feet
Optional Layouts	Circle All that Apply		

41.4 The Bach			
Elevation	Circle One	A	2894.4 Square Feet
		B	2894.5 Square Feet
Optional Layouts	Circle All that Apply		

41.5 The Brahms			
Elevation	Circle One	A	3948.1 Square Feet
		B	3949.1 Square Feet
Optional Layouts	Circle All that Apply	GFA1	GROUND FLOOR Optional Alternative Layout
		SFA2	SECOND FLOOR Shower In Lieu of Tub B4
		SFA3	SECOND FLOOR Optional Laundry Layout

41.6 The Verdi			
Elevation	Circle One	A	3852.5 Square Feet
		B	3856.4 Square Feet
Optional Layouts	Circle All that Apply	GFA1	GROUND FLOOR Optional Alternative Layout
		SFA3	SECOND FLOOR Optional Laundry Layout


July 11, 16



in's Best Value
Square Foot
-Car
GES

The Brahms 41' SERIES

Elevation A • 3,352 sq.ft.

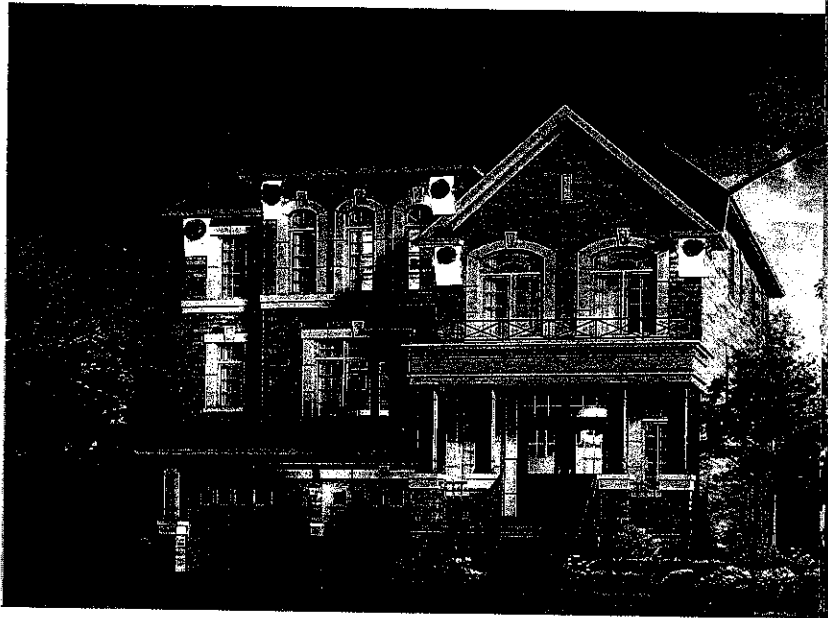

Lot 125
July 11, 16
\$00

5 exterior pot
lights

Elevation B • 3,352 sq.ft.



GOLDPARK
HOMES

Prices, figures, illustrations, sizes, features and finishes are subject to change without notice.