

Brampton Encore - 80 - 1 - 41-6 Elev.A VERDI OPT - GFA1
CENTRAL VAC AND WIRING

Inv.583	1 - TELEPHONE AND CABLE ROUGH-IN LOCATIONS
Line7089	Note:
16Jun16 / 16Nov16	

ELECTRICAL

Inv.583	1 - LIVING ROOM: INSTALL ADDITIONAL STANDARD FIXTURE WITH SWITCH - MUST SPECIFY LOCATION. SEE SKETCH.
	IN ADDITION TO BUILDER'S STANDARD SWITCH CONTROLLED RECEPTICAL
Line7090	Note:
16Jun16 / 16Nov16	

EXTERIOR COLOURS

Inv.583	1 - EXTERIOR COLOUR PACKAGE 10
Line14162	Note:
16Jun16 / 16Nov16	

FRAMING

Inv.583	1 - GARAGE: INSTALL MANDOOR - GARAGE TO HOUSE- AS PER PLAN AND GRADE PERMITING
Line7091	Note: GIVEN IN AGREEMENT OF PURCHASE AND SALE
16Jun16 / 16Nov16	
Inv.583	1 - OPTIONAL GROUND FLOOR
Line14164	Note:
16Jun16 / 16Nov16	

GARAGE DOORS

Inv.583	2 - GARAGE: INSTALL TWO (X2) INSULATION KIT - STANDARD GARAGE DOORS - EACH HOUSE REQUIRES 2 INSULATION KITS- PER DOOR PRICE
Line7092	Note:
16Jun16 / 16Nov16	
Inv.583	2 - GARAGE: INSTALL TWO (X2) GARAGE DOOR OPENER - WITH 1 REMOTE- PRICE IS PER DOOR
Line7093	Note:
16Jun16 / 16Nov16	
Inv.583	1 - GARAGE: INSTALL DIGITAL ENTRY KEYPAD
Line7094	Note:
16Jun16 / 16Nov16	

HVAC

Inv.583	1 - KITCHEN: INSTALL GAS LINE ROUGH - MAIN FLOOR - (3 STOREY MODELS), FOR STOVE
Line7096	Note:
16Jun16 / 16Nov16	

MISC.

Inv.583	1 - BONUS PACKAGE: \$4960.70 (INCLUDING TAXES) WORTH OF UPGRADES FROM GOLD PARK HOMES DÉCOR CENTRE IS BEING APPLIED TOWARD THE STRUCTURAL APPOINTMENT. PURCHASER HAS A REMAINING AMOUNT OF \$5039.30 (INCLUDING TAXES) TO BE USED TOWARD THE COLOUR APPOINTMENT
Line7098	Note:
16Jun16 / 16Nov16	

Brampton Encore - 80 - 1 - 41-6 Elev.A VERDI OPT - GFA1

Inv.583	1 - Purchaser has attended a Structural appointment at the Decor Centre & has DECLINED any additional upgrades and accepts and acknowledges that there will be no further structural changes/additions/deletions to be made upon signing on June 16, 2016
Line7099	Note:
16Jun16 / 16Nov16	

Inv.583	1 - Purchasers are aware & accepts that ANY changes made to upgrades after signing this Purchasers Extra Form are subject to a minimum administration fee of \$500. PLUS a 10% holdback fee
Line7100	Note:
16Jun16 / 16Nov16	

PLUMBING

Inv.583	1 - KITCHEN: INSTALL ROUGH-IN - WATERLINE FOR FRIDGE
Line7097	Note:
16Jun16 / 16Nov16	



WINDOWS - BASEMENT

Inv.583	3 - BASEMENT: INSTALL THREE (X3) BASEMENT WINDOWS - UPGRADE EXISTING BASEMENT WINDOW TO 30 INCH X 24 INCH - MAY REQUIRE INSTALLATION OF WINDOW WELL
Line7095	Note:
16Jun16 / 16Nov16	

WINDOWS AND DOORS

Inv.583	1 - GARAGE: INSTALL MANDOOR - GARAGE TO HOUSE- AS PER PLAN AND GRADE PERMITING
Line14163	Note:
16Jun16 / 16Nov16	

Telephone — (T)
Cable — (C)

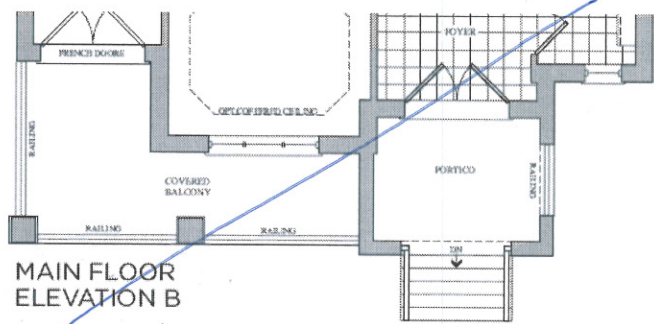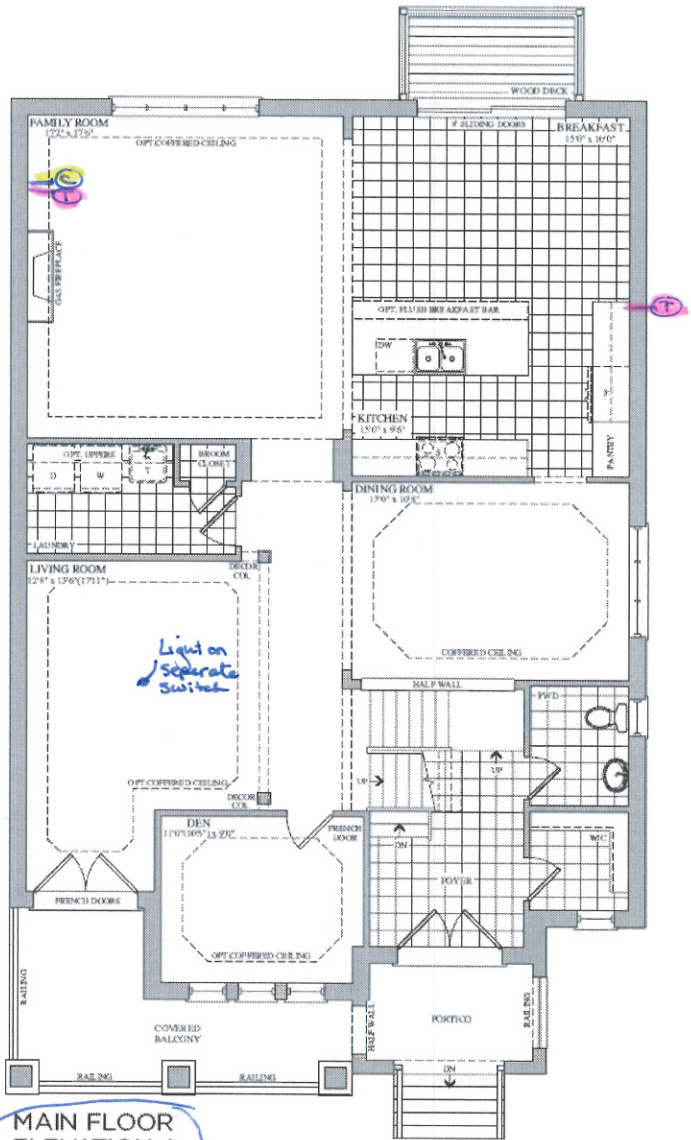

The Verdi
41' SERIES

Elevation A • 3,409 sq.ft.

Elevation B • 3,409 sq.ft.

GOLD PARK

These floor plans are subject to change without notice. All dimensions are approximate and do not include any area not shown. All dimensions are subject to change without notice. © 2016


Lot 80
June 16, 16

PA

PA


Telephone — (T)

Cable — (C)

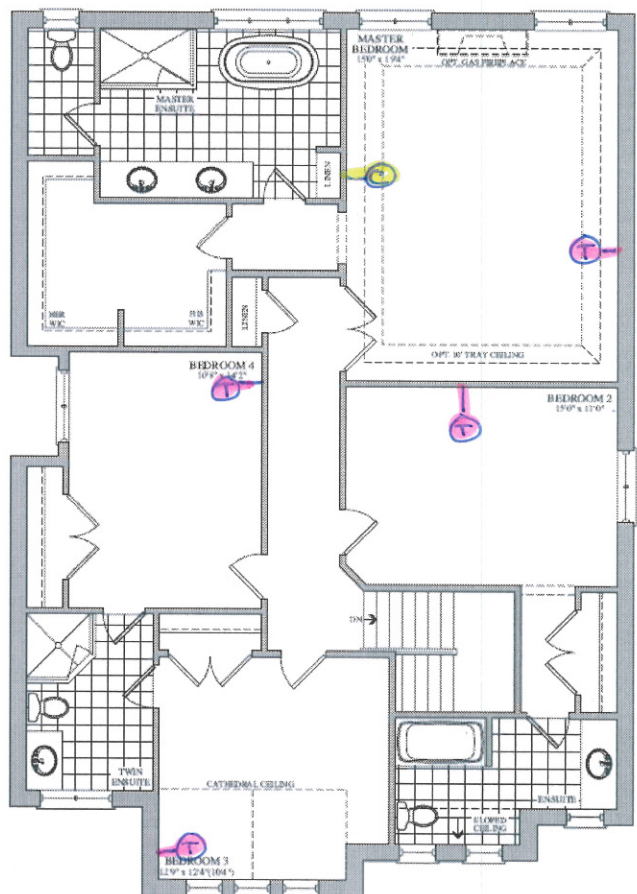


SECOND FLOOR
ELEVATION A

The Verdi
41' SERIES
Elevation A • 3,409 sq.ft.

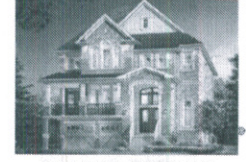


Elevation B • 3,409 sq.ft.

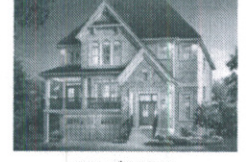

GOLDPARK

Prices, features, specifications, and other information are subject to change without notice. © 2014. All rights reserved. All dimensions are approximate and subject to change without notice. All other trademarks and registered trademarks are the property of their respective owners.

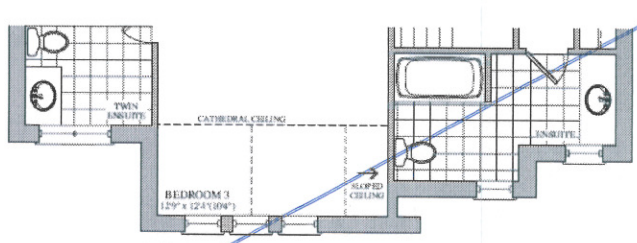


SECOND FLOOR
ELEVATION B

Lot 80
June 16, 16


PA

PA

Telephone (T)

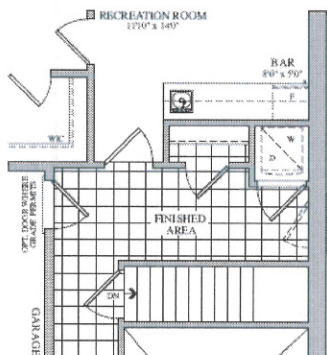


OPT. GROUND FLOOR
ELEVATION A & B
OPT. LAUNDRY

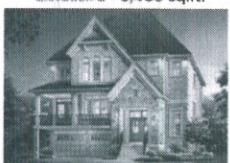

GOLD PARK

2008 Copyright. All rights reserved. No part of this publication may be reproduced without prior written permission from the publisher. All rights reserved. 01-01

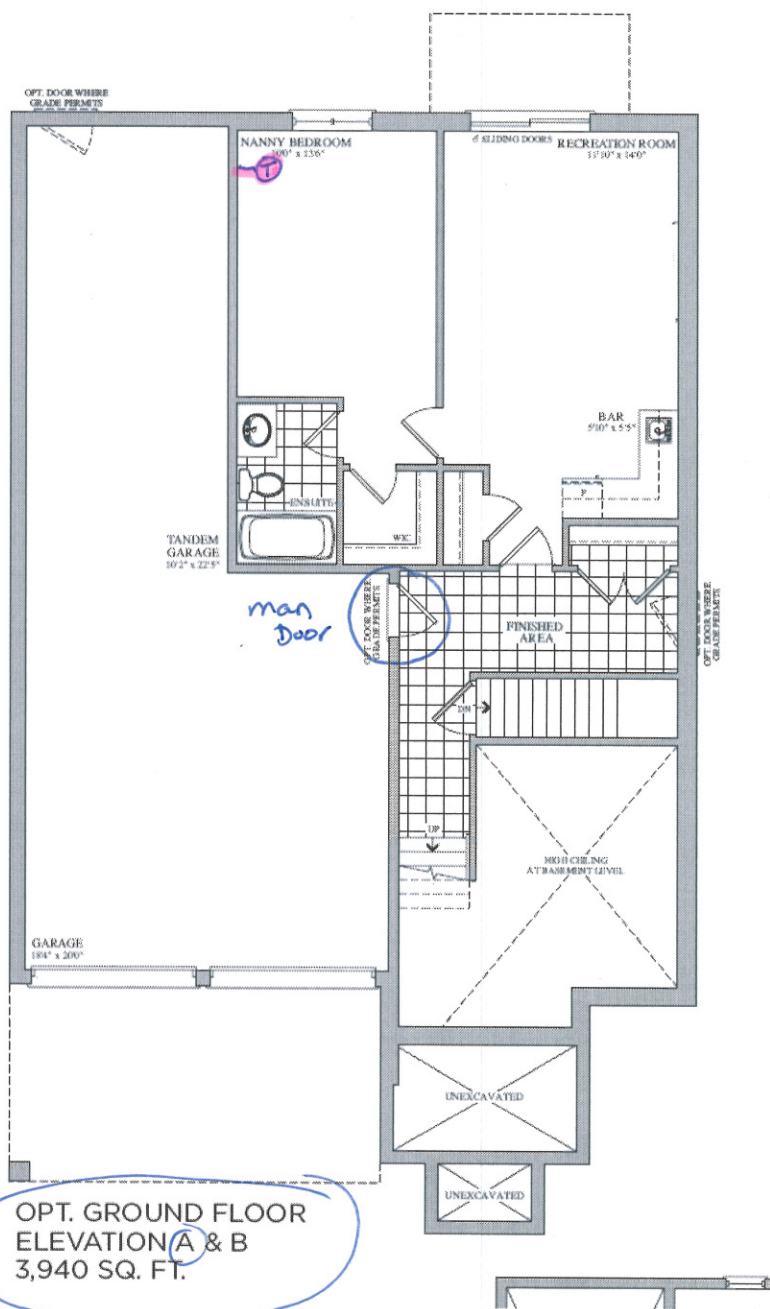

OPT. GROUND FLOOR
ELEVATION A & B
3,940 SQ. FT.


Lot 80

June 16, 16

AT

BSMNT WINDOWS

3 x 30" x 24"

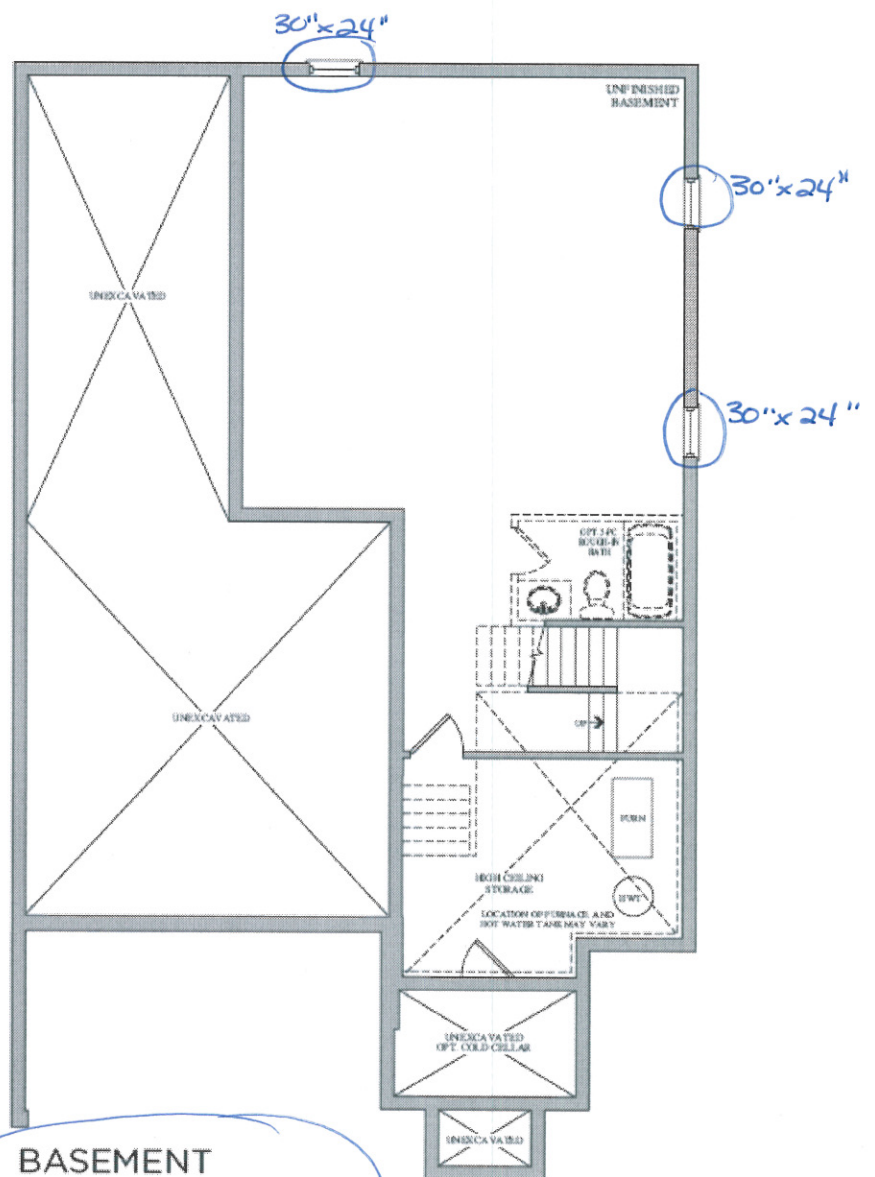

BASEMENT
ELEVATION A & B



Lot 80
June 16, 16

PA

PA



Stacey Carlete
Project Coordinator



Claude Azzopardi
Contracts Manager



Nancy Mc
Corporate C



38.1 The Bizet			
Elevation	Circle One	A	2189.6 Square Feet
		B	2186.7 Square Feet
Optional Layouts	Circle All that Apply		

38.2 The Ravel			
Elevation	Circle One	A	2271.5 Square Feet
		B	2273.7 Square Feet
Optional Layouts	Circle All that Apply		

38.3 The Haydn			
Elevation	Circle One	A	2394.5 Square Feet
		B	2388.3 Square Feet
Optional Layouts	Circle All that Apply		

38.4 The Vivaldi			
Elevation	Circle One	A	2459.1 Square Feet
		B	2459.1 Square Feet
Optional Layouts	Circle All that Apply		

38.5 The Handel			
Elevation	Circle One	A	2549.2 Square Feet
		B	2554.7 Square Feet
Optional Layouts	Circle All that Apply		

38.9 The Puccini			
Elevation	Circle One	A	3628.0 Square Feet
		B	3634.7 Square Feet
Optional Layouts	Circle All that Apply	GFA1	GROUND FLOOR Optional Alternative Layout

38.6 The Scarlatti			
Elevation	Circle One	A	3521.1 Square Feet
		B	3508.1 Square Feet
Optional Layouts	Circle All that Apply	GFA1	GROUND FLOOR Optional Alternative Layout

38.7 The Schubert			
Elevation	Circle One	A	3593.8 Square Feet
		B	3610.5 Square Feet
Optional Layouts	Circle All that Apply	GFA1	GROUND FLOOR Optional Alternative Layout
		SFA4	SECOND FLOOR Additional Bedroom

38.8 The Corelli			
Elevation	Circle One	A	3801.5 Square Feet
		B	3801.5 Square Feet
Optional Layouts	Circle All that Apply	GFA1	GROUND FLOOR Optional Alternative Layout
		SFA4	SECOND FLOOR Additional Bedroom w/ Ensuite

41.1 The Strauss			
Elevation	Circle One	A	2554.2 Square Feet
		B	2571.2 Square Feet
Optional Layouts	Circle All that Apply	SFA1	SECOND FLOOR Shower in Lieu of Tub B2

41.2 The Mozart			
Elevation	Circle One	A	2725.9 Square Feet
		B	2711.1 Square Feet
Optional Layouts	Circle All that Apply	SFA1	SECOND FLOOR Shower in Lieu of Tub B2

41.3 The Chopin			
Elevation	Circle One	A	2800.0 Square Feet
		B	2810.5 Square Feet
Optional Layouts	Circle All that Apply		

41.4 The Bach			
Elevation	Circle One	A	2894.4 Square Feet
		B	2894.5 Square Feet
Optional Layouts	Circle All that Apply		

41.5 The Brahms			
Elevation	Circle One	A	3948.1 Square Feet
		B	3949.1 Square Feet
Optional Layouts	Circle All that Apply	GFA1	GROUND FLOOR Optional Alternative Layout
		SFA2	SECOND FLOOR Shower in Lieu of Tub B4
		SFA3	SECOND FLOOR Optional Laundry Layout

41.6 The Verdi			
Elevation	Circle One	A	3862.5 Square Feet
		B	3866.4 Square Feet
Optional Layouts	Circle All that Apply	GFA1	GROUND FLOOR Optional Alternative Layout
		SFA3	SECOND FLOOR Optional Laundry Layout

June 16, 16

PK

PK