

Brampton Encore - 129 - 1 - 41-1 Elev.A STRAUSS
CENTRAL VAC AND WIRING

Inv.651	1 - TELEPHONE AND CABLE ROUGH-IN LOCATIONS
Line8274	Note:
12Jul16 / 15Nov16	
Inv.651	1 - FAMILY ROOM: INSTALL CONDUIT PIPE- FOR TELEVISION- ABOVE FIREPLACE
Line8275	Note:
12Jul16 / 15Nov16	

CERAMIC

Inv.651	1 - ENSUITE (BED #2): INSTALL SHOWER IN LIEU OF TUB- INCLUDES FRAMED GLASS SHOWER ENCLOSURE-
Line14023	Note:
12Jul16 / 15Nov16	

ELECTRICAL

Inv.651	1 - FAMILY ROOM: INSTALL 110V WALL RECEPTACLE ON DEDICATED CIRCUIT - ABOVE FIREPLACE. SEE SKETCH
Line8276	Note:
12Jul16 / 15Nov16	
Inv.651	1 - KITCHEN: INSTALL KITCHEN CABINET STRIP VALANCE LIGHTS (UNDER CABINETS) - ROUGH - IN - DOES NOT INCLUDE (AND REQUIRES) KITCHEN UPGRADE PRICING
Line8277	Note:
12Jul16 / 15Nov16	

EXTERIOR COLOURS

Inv.651	1 - EXTERIOR COLOUR PACKAGE 4
Line14025	Note:
12Jul16 / 15Nov16	

FRAMING

Inv.651	1 - ENSUITE (BED #2): INSTALL SHOWER IN LIEU OF TUB- INCLUDES FRAMED GLASS SHOWER ENCLOSURE-
Line8282	Note:
12Jul16 / 15Nov16	
Inv.651	1 - GARAGE: INSTALL MANDOOR - GARAGE TO HOUSE- AS PER PLAN AND GRADE PERMITING
Line8278	Note: GIVEN IN AGREEMENT OF PURCHASE AND SALE
12Jul16 / 15Nov16	
Inv.651	1 - MAIN FLOOR: INSTALL SIX (X6) STANDARD DOORS EXTENDED HEIGHT 96" (PRICE PER DOOR)- GROUND FLOOR 2 STOREY MODELS. ON CLOSETS, POWDER ROOM, BASEMENT AND LAUNDRY. SEE SKETCH
Line14024	Note:
12Jul16 / 15Nov16	

INTERIOR TRIM AND DOORS

Inv.651	6 - MAIN FLOOR: INSTALL SIX (X6) STANDARD DOORS EXTENDED HEIGHT 96" (PRICE PER DOOR)- GROUND FLOOR 2 STOREY MODELS. ON CLOSETS, POWDER ROOM, BASEMENT AND LAUNDRY. SEE SKETCH
Line8284	Note:
12Jul16 / 15Nov16	

MISC.

Brampton Encore - 129 - 1 - 41-1 Elev.A STRAUSS

Inv.651	1 - BONUS PACKAGE: \$7898.70 (INCLUDING TAXES) WORTH OF UPGRADES FROM GOLD PARK HOMES DÉCOR CENTRE IS BEING APPLIED TOWARD THE STRUCTURAL APPOINTMENT. PURCHASER HAS A REMAINING AMOUNT OF \$7101.30 (INCLUDING TAXES) TO BE USED TOWARD THE COLOUR APPOINTMENT
Line8286	Note:
12Jul16 / 15Nov16	
Inv.651	1 - Purchaser has attended a Structural appointment at the Decor Centre & has DECLINED any additional upgrades and accepts and acknowledges that there will be no further structural changes/additions/deletions to be made upon signing on July 12, 2016
Line8287	Note:
12Jul16 / 15Nov16	
Inv.651	1 - Purchasers are aware & accepts that ANY changes made to upgrades after signing this Purchasers Extra Form are subject to a minimum administration fee of \$500. PLUS a 10% holdback fee
Line8288	Note:
12Jul16 / 15Nov16	

PLUMBING

Inv.651	1 - BASEMENT: INSTALL ROUGH-IN - 3PC BASEMENT ROUGH-IN
Line8285	Note:
12Jul16 / 15Nov16	
Inv.651	1 - ENSUITE (BED #2): INSTALL SHOWER IN LIEU OF TUB- INCLUDES FRAMED GLASS SHOWER ENCLOSURE-
Line14022	Note:
12Jul16 / 15Nov16	

WINDOWS - BASEMENT

Inv.651	2 - BASEMENT: INSTALL TWO (X2) BASEMENT WINDOWS - UPGRADE EXISTING BASEMENT WINDOW TO 30 INCH X 24 INCH - MAY REQUIRE INSTALLATION OF WINDOW WELL. SEE SKETCH
Line9037	Note:
12Jul16 / 15Nov16	


WINDOWS AND DOORS

Inv.651	1 - GARAGE: INSTALL MANDOOR - GARAGE TO HOUSE- AS PER PLAN AND GRADE PERMITING
Line14020	Note:
12Jul16 / 15Nov16	

Telephone — (T)
Cable — (C)
Electrical — (E)

The
Strauss
41' SERIES

Elevation A • 2,607 sq.ft. | Elevation B • 2,625 sq.ft.

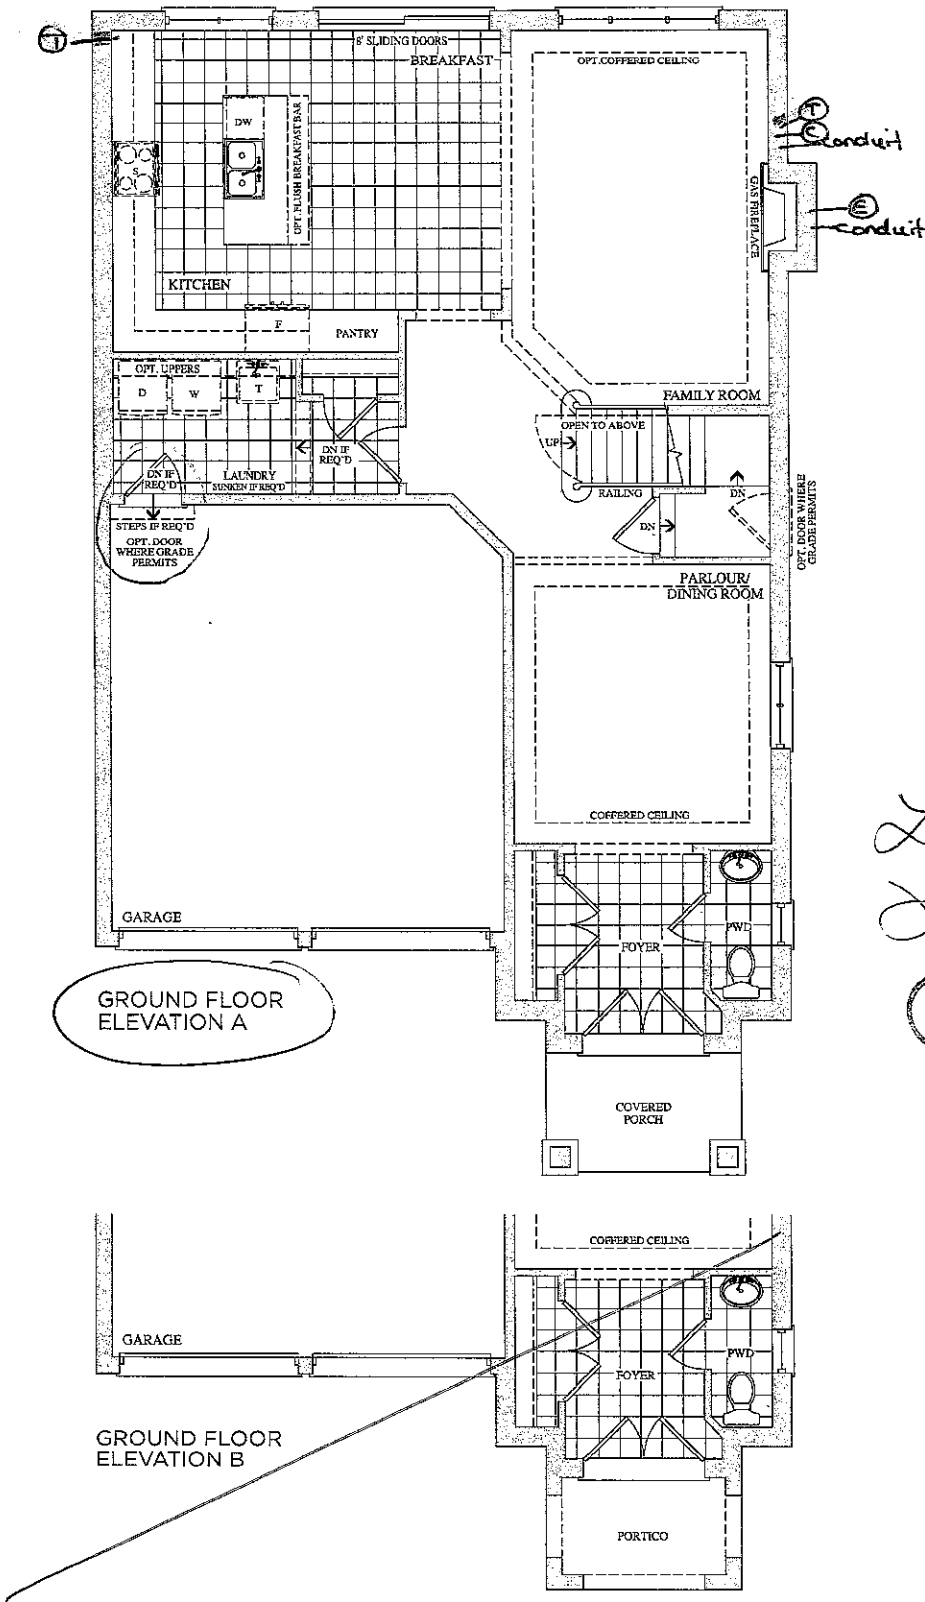



Prices, figures, illustrations, sizes, features and finishes are subject to change without notice. E.&O.E. Areas and dimensions are approximate and actual usable floor space may vary from the stated area. Layout may be reverse of the unit purchased. E. & O.E.

GOLDpark
HOMES

Telephone — T
Cable — C

The
Strauss
41' SERIES


Elevation A • 2,607 sq.ft. | Elevation B • 2,625 sq.ft.

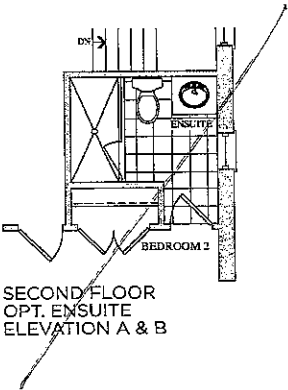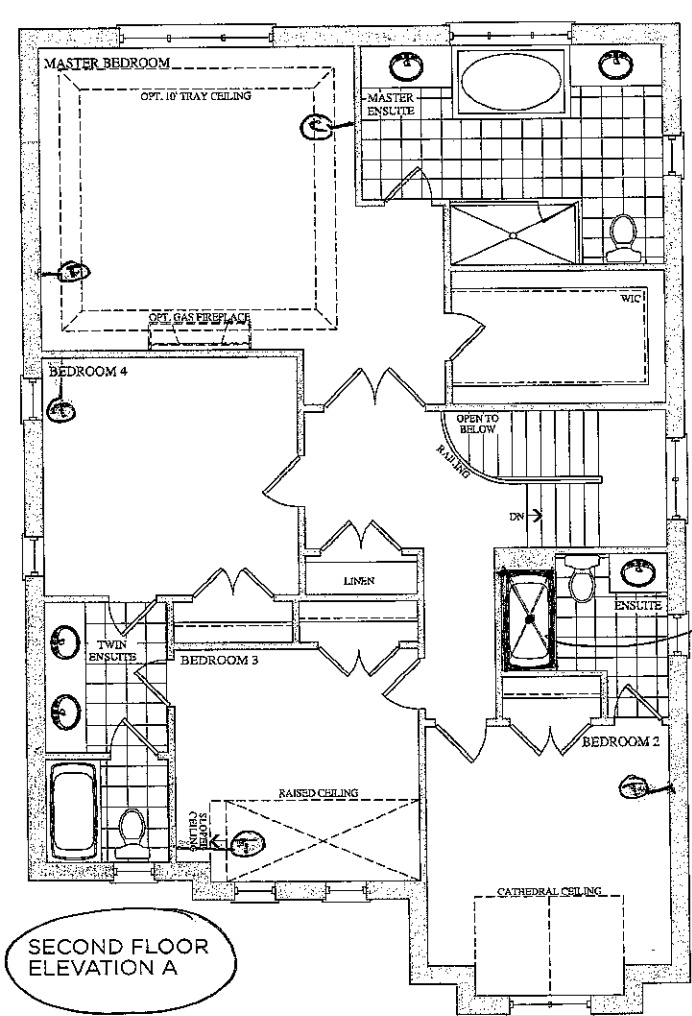

Delete tub, install
framed shower w/pot
light.

Lot 129
July 12, 16


B.D. CL

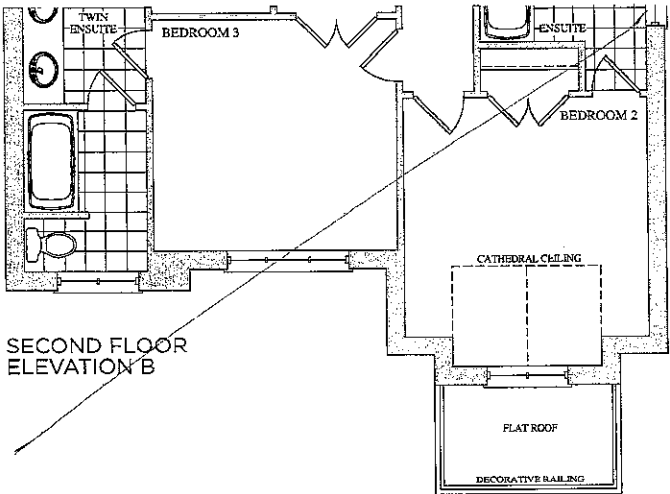

Prices, figures, illustrations, sizes, features and finishes are subject to change without notice. E.&O.E. Areas and dimensions are approximate and actual usable floor space may vary from the stated area. Layout may be reverse of the unit purchased. E. & O.E.

BSMT WINDOWS
2 x 30" x 24"

Elevation A • 2,607 sq.ft. | Elevation B • 2,625 sq.ft.

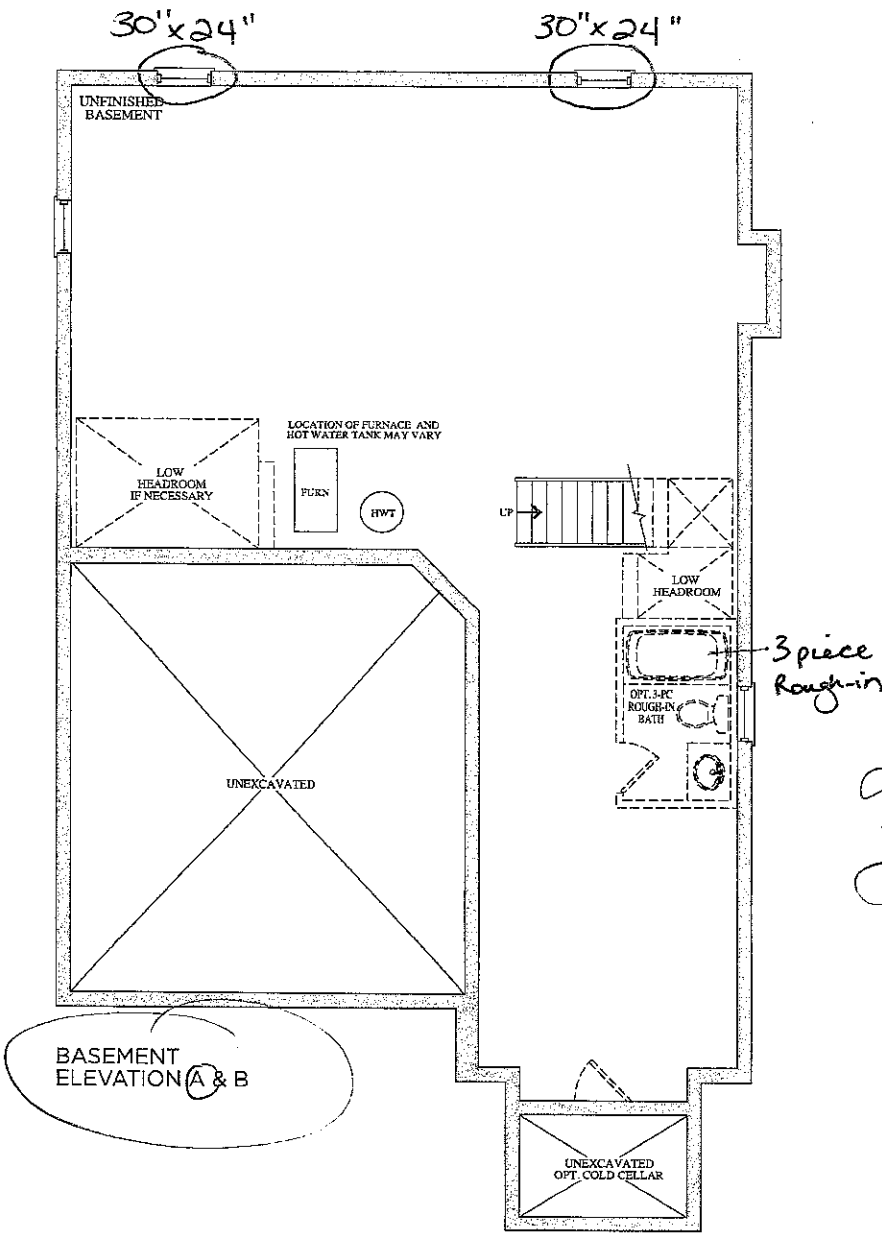

Lot 129
July 12, 16
B.D. C.L.



Stacey Carlete
Project Coordinator



Claude Azzopardi
Contracts Manager



Nancy Moore
Corporate Counsel

129
Lot #



38.1 The Bizet			
Elevation	Circle One	A	2189.6 Square Feet
		B	2186.7 Square Feet
Optional Layouts	Circle All that Apply		

38.2 The Ravel			
Elevation	Circle One	A	2271.5 Square Feet
		B	2273.7 Square Feet
Optional Layouts	Circle All that Apply		

38.3 The Haydn			
Elevation	Circle One	A	2394.5 Square Feet
		B	2388.3 Square Feet
Optional Layouts	Circle All that Apply		

38.4 The Vivaldi			
Elevation	Circle One	A	2459.1 Square Feet
		B	2459.1 Square Feet
Optional Layouts	Circle All that Apply		

38.5 The Handel			
Elevation	Circle One	A	2549.2 Square Feet
		B	2554.7 Square Feet
Optional Layouts	Circle All that Apply		

38.9 The Puccini			
Elevation	Circle One	A	3628.0 Square Feet
		B	3634.7 Square Feet
Optional Layouts	Circle All that Apply	GFA1	GROUND FLOOR Optional Alternative Layout

38.6 The Scarlatti			
Elevation	Circle One	A	3521.1 Square Feet
		B	3508.1 Square Feet
Optional Layouts	Circle All that Apply	GFA1	GROUND FLOOR Optional Alternative Layout

38.7 The Schubert			
Elevation	Circle One	A	3593.8 Square Feet
		B	3610.5 Square Feet
Optional Layouts	Circle All that Apply	GFA1	GROUND FLOOR Optional Alternative Layout
		SFA4	SECOND FLOOR Additional Bedroom
Optional Layouts	Circle All that Apply		

38.8 The Corelli			
Elevation	Circle One	A	3801.5 Square Feet
		B	3801.5 Square Feet
Optional Layouts	Circle All that Apply	GFA1	GROUND FLOOR Optional Alternative Layout
		SFA4	SECOND FLOOR Additional Bedroom w/ Ensuite
Optional Layouts	Circle All that Apply		

41.1 The Strauss			
Elevation	Circle One	A	2554.2 Square Feet
		B	2571.2 Square Feet
Optional Layouts	Circle All that Apply	SFA1	SECOND FLOOR Shower in Lieu of Tub B2

41.2 The Mozart			
Elevation	Circle One	A	2725.9 Square Feet
		B	2711.1 Square Feet
Optional Layouts	Circle All that Apply	SFA1	SECOND FLOOR Shower in Lieu of Tub B2

41.3 The Chopin			
Elevation	Circle One	A	2800.0 Square Feet
		B	2810.5 Square Feet
Optional Layouts	Circle All that Apply		

41.4 The Bach			
Elevation	Circle One	A	2894.4 Square Feet
		B	2894.5 Square Feet
Optional Layouts	Circle All that Apply		

41.5 The Brahms			
Elevation	Circle One	A	3948.1 Square Feet
		B	3949.1 Square Feet
Optional Layouts	Circle All that Apply	GFA1	GROUND FLOOR Optional Alternative Layout
		SFA2	SECOND FLOOR Shower in Lieu of Tub B4
Optional Layouts	Circle All that Apply	SFA3	SECOND FLOOR Optional Laundry Layout

41.6 The Verdi			
Elevation	Circle One	A	3862.5 Square Feet
		B	3866.4 Square Feet
Optional Layouts	Circle All that Apply	GFA1	GROUND FLOOR Optional Alternative Layout
		SFA3	SECOND FLOOR Optional Laundry Layout
Optional Layouts	Circle All that Apply		

July 12, 16

Amrum Lin