

Kleinburg Glen - 2L - 1 - 25-1 Elev.A RIVERSTONE
CENTRAL VAC AND WIRING

Inv.629	1 - MUD ROOM: ROUGH - IN FOR EXTRA SECURITY KEY PAD. Please see floor plan for location
Line7945	Note:
6Jul16 / 29Jul16	
Inv.684	1 - FAMILY ROOM: CONDUIT PIPE - FOR TELEVISION - OVER FIREPLACE APPROX 66" AFF. - TERMINATING AT RIGHT SIDE, STANDARD HEIGHT. PLEASE SEE FLOORPLAN FOR LOCATION
Line8997	Note:
20Jul16 / 29Jul16	

ELECTRICAL

Inv.629	1 - FAMILY ROOM: 110V WALL RECEPTACLE ON NORMAL CIRCUIT - OVER FIREPLACE IN LINE WITH CABLE. Please see floorplan for location
Line7946	Note:
6Jul16 / 29Jul16	

EXTERIOR COLOURS

Inv.629	1 - EXTERIOR COLOUR PACKAGE 8
Line9604	Note:
6Jul16 / 29Jul16	

FRAMING

Inv.629	1 - MASTER ENSUITE: DELETE TUB AND RELOCATE TOILET TO WINDOW WALL AND CONVERT CORNER SHOWER TO FULL WIDTH FRAMED GLASS SHOWER
Line7950	Note:
6Jul16 / 29Jul16	
Inv.629	1 - MASTER ENSUITE: CONVERT DOUBLE DOOR TO SINGLE DOOR. Please see floorplan for detail.
Line7951	Note:
6Jul16 / 29Jul16	
Inv.794	2 - MAIN FLOOR: EXTENDED HEIGHT ARCHWAY (PER DOORWAY)
Line10612	Note:
29Aug16 / 29Aug16	
Inv.794	1 - MAIN FLOOR: EXTENDED DORO HEIGHT TO 96 INCH
Line10613	Note:
29Aug16 / 29Aug16	

GLASS AND MIRROR

Inv.684	1 - MASTER ENSUITE: CONVERT FRAMED SHOWER TO 10MM FRAMLESS SHOWER ENCLOSURE WITH DOOR AND 10MM SIDE PANEL
Line9000	Note:
20Jul16 / 29Jul16	

HVAC

Inv.629	1 - LAUNDRY: RELOCATE LAUNDRY TO BASEMENT. Please see floorplan for location. Price included in price above
Line7954	Note:
6Jul16 / 29Jul16	

INTERIOR TRIM AND DOORS

Kleinburg Glen - 2L - 1 - 25-1 Elev.A RIVERSTONE

Inv.684	2 - MAIN FLOOR: EXTENDED HEIGHT ARCHWAY (PRICE PER DOORWAY)
Line8998	Note:
20Jul16 / 29Jul16	
Inv.684	5 - STANDARD DOOR EXTENDED HEIGHT 96 INCH (PRICE PER DOOR) - GROUND FLOOR 2 STOREY MODELS
Line8999	Note:
20Jul16 / 29Jul16	

MISC.


Inv.629	1 - Purchaser has attended a Structural appointment at the Decor Centre & has DECLINED any additional upgrades and accepts and acknowledges that there will be no further structural changes/additions/deletions to be made upon signing on July 6, 2016.
Line7965	Note:
6Jul16 / 29Jul16	
Inv.629	1 - Purchasers are aware & accepts that ANY changes made to upgrades after signing this Purchasers Extra Form are subject to a minimum administration fee of \$500. PLUS a 10% holdback fee.
Line7966	Note:
6Jul16 / 29Jul16	
Inv.629	1 - BONUS PACKAGE: \$5,000.00 (INCLUDING TAXES) WORTH OF UPGRADES FROM GOLD PARK HOMES DÉCOR CENTRE IS BEING APPLIED TOWARD THE STRUCTURAL APPOINTMENT. PURCHASER HAS A REMAINING AMOUNT OF \$00 (INCLUDING TAXES) TO BE USED TOWARD THE COLOUR APPOINTMENT.
Line7967	Note: Balance of \$271.45 Paid by Cheque
6Jul16 / 29Jul16	
Inv.684	1 - Purchasers are aware & accepts that ANY changes made to upgrades after signing this Purchasers Extra Form are subject to a minimum administration fee of \$500. PLUS a 10% holdback fee.
Line9001	Note:
20Jul16 / 29Jul16	
Inv.684	1 - SECOND INVOICE
BALANCE OF \$4,452,20.00 PAID BY CHEQUE	
Line9002	Note:
20Jul16 / 29Jul16	

PLUMBING

Inv.629	1 - LAUNDRY: RELOCATE WASHER/DRYER TO BASEMENT. Please see floorplan for location. Laundry Tub remains in Main floor Mud Room
Line7952	Note:
6Jul16 / 29Jul16	
Inv.629	1 - MASTER ENSUITE: DELETE TUB AND RELOCATE TOILET TO WINDOW WALL AND CONVERT CORNER SHOWER TO FULL WIDTH FRAMED GLASS SHOWER
Line9603	Note:
6Jul16 / 29Jul16	



Elevation B • 1,849 sq.ft.

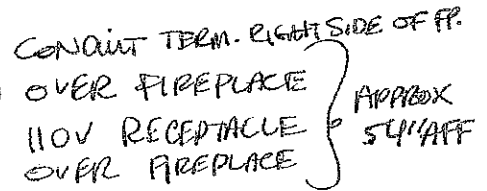

D.K. DATE: JULY, 25/16

X EXTEND DOORS
HEIGHTS + ARCHWAYS



D.K.

DATE: JULY 25/16

STD. & OPT. GROUND FLOOR
ELEVATION B

Lot 2L
July 6, 2016.




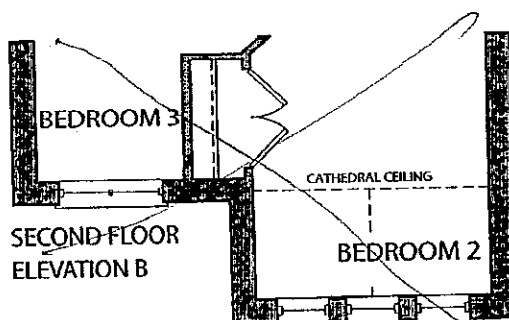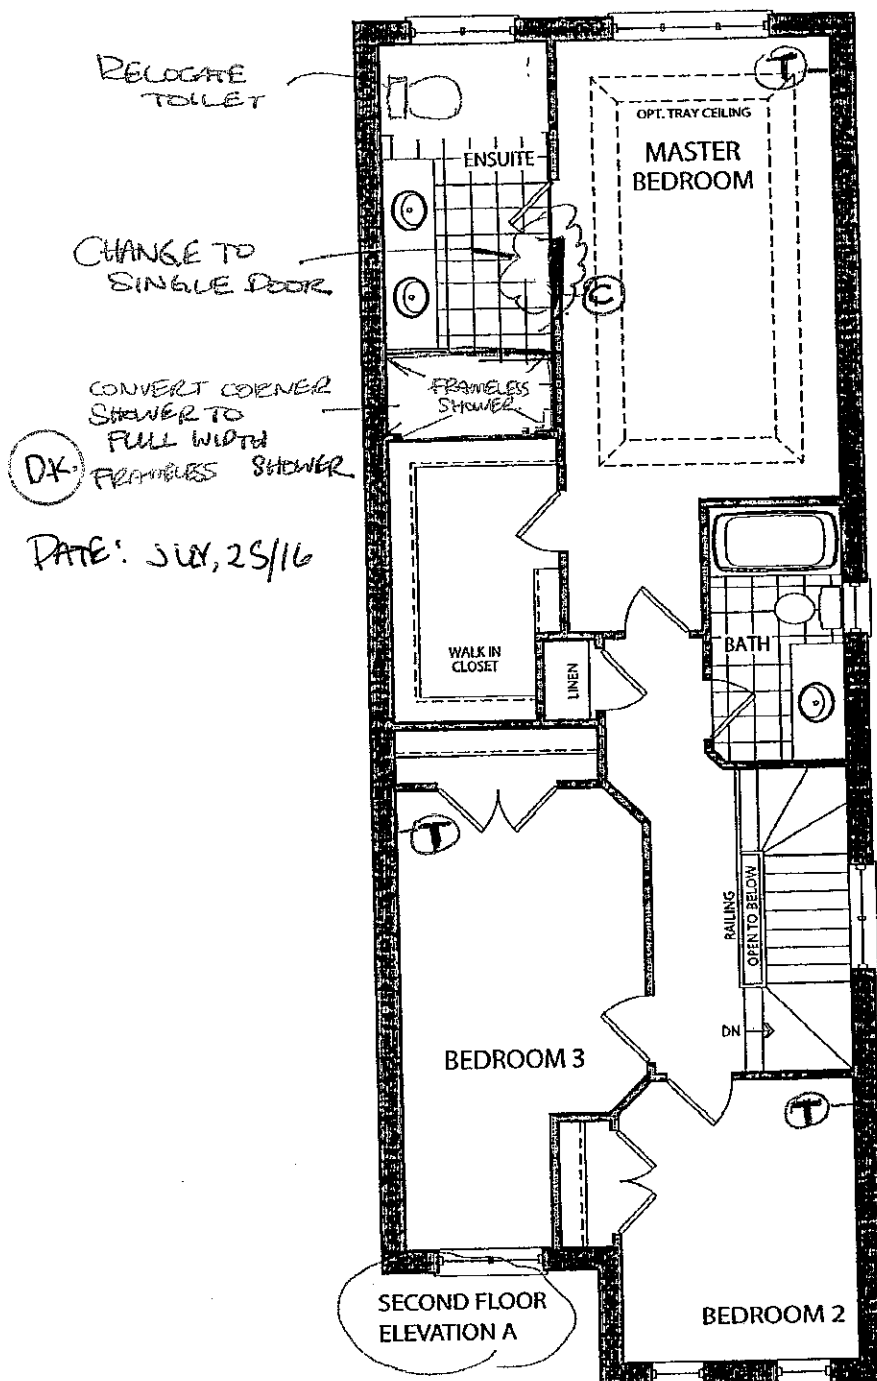


LOT 2L
July 6, 2016

82

Elevation A • 1,849 sq.ft.
Elevation B • 1,849 sq.ft.

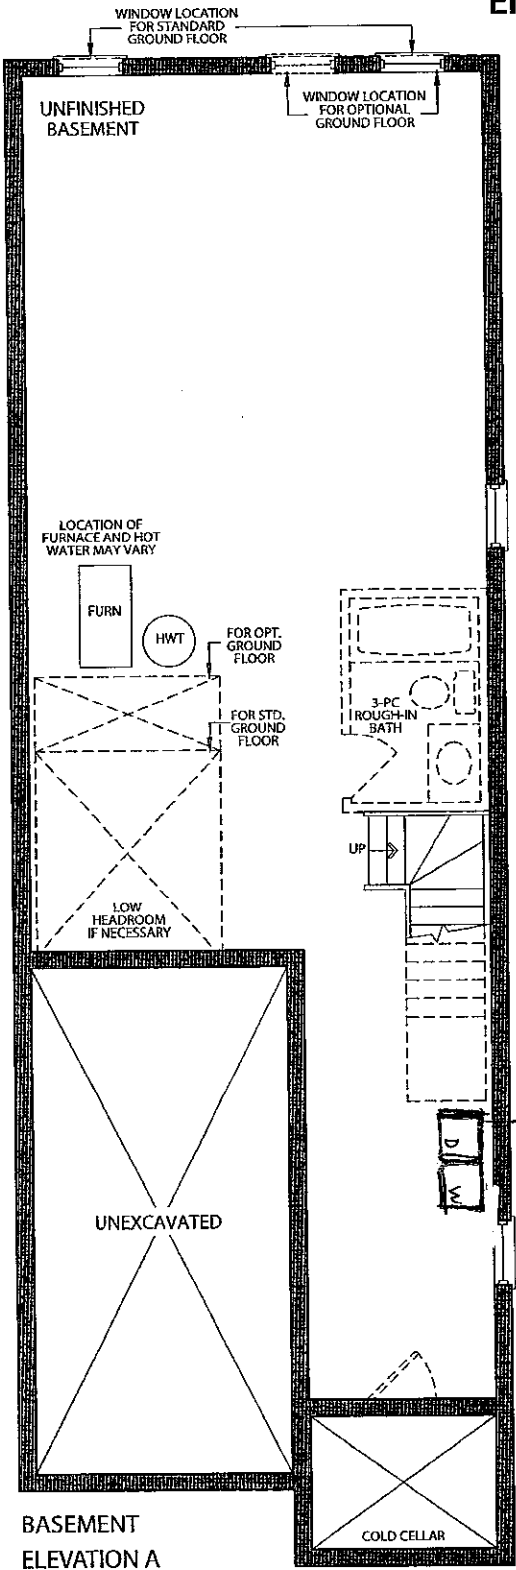

BASEMENT
ELEVATION A

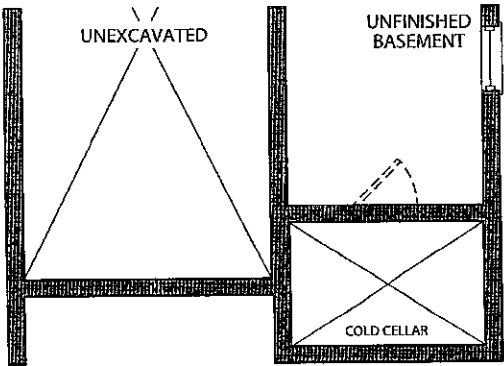

BASEMENT
ELEVATION B

Lot 2L.
July 6, 2016

D.V.

SP



Stacey Carlete
Project Coordinator



Claude Azzopardi
Contracts Manager



Nancy Martini
Corporate Controller



25.1 The Riverstone			
Elevation	Circle One	A	1812.7 Square Feet
		B	1812.7 Square Feet
Taller Ceilings	Circle All that Apply	GFTC	9' Ceilings Ground Floor
		MFTC	10' Ceilings Main Floor
		SFTC	9' Ceilings Second Floor
Optional Layouts	Circle All that Apply	GFA1	GROUND FLOOR Alternative Layout Kitchen/Family Room

25.2 The Hudson			
Elevation	Circle One	A	1860.8 Square Feet
		B	1858.6 Square Feet
Taller Ceilings	Circle All that Apply	GFTC	9' Ceilings Ground Floor
		MFTC	10' Ceilings Main Floor
		SFTC	9' Ceilings Second Floor
Optional Layouts	Circle All that Apply	GFA1	GROUND FLOOR Alternative Layout Kitchen/Family Room

25.3 The Oakmount			
Elevation	Circle One	A	2013.0 Square Feet
		B	2013.0 Square Feet
Taller Ceilings	Circle All that Apply	GFTC	9' Ceilings Ground Floor
		MFTC	10' Ceilings Main Floor
		SFTC	9' Ceilings Second Floor
Optional Layouts	Circle All that Apply	GFA1	GROUND FLOOR Alternative Layout Kitchen/Family Room
		SFA4	SECOND FLOOR Alternative Layout Laundry Room
		SFA5	SECOND FLOOR Additional Bedroom

25.4 The Stanford			
Elevation	Circle One	A	2665.6 Square Feet
		B	2665.6 Square Feet
Taller Ceilings	Circle All that Apply	GFTC	9' Ceilings Ground Floor
		MFTC	10' Ceilings Main Floor
		SFTC	9' Ceilings Second Floor
Optional Layouts	Circle All that Apply	GFA2	GROUND FLOOR Optional Piece Bathroom
		MFA1	MAIN FLOOR Alternative Layout Kitchen/Family Room
		SFA2	SECOND FLOOR Shower in Lieu of Tub (Master Ens.)
		SFA5	SECOND FLOOR Additional Bedroom

25.5 The Regency			
Elevation	Circle One	A	2924.0 Square Feet
		B	2924.0 Square Feet
Taller Ceilings	Circle All that Apply	GFTC	9' Ceilings Ground Floor
		MFTC	10' Ceilings Main Floor
		SFTC	9' Ceilings Second Floor
Optional Layouts	Circle All that Apply	GFA2	GROUND FLOOR Optional Piece Bathroom
		MFA1	MAIN FLOOR Alternative Layout Kitchen/Family Room
		SFA2	SECOND FLOOR Shower in Lieu of Tub (Master Ens.)
		SFA5	SECOND FLOOR Additional Bedroom

25.6 The Lincoln			
Elevation	Circle One	A	3021.0 Square Feet
		B	3014.0 Square Feet
Taller Ceilings	Circle All that Apply	GFTC	9' Ceilings Ground Floor
		MFTC	10' Ceilings Main Floor
		SFTC	9' Ceilings Second Floor
Optional Layouts	Circle All that Apply	GFA2	GROUND FLOOR Optional Piece Bathroom
		MFA1	MAIN FLOOR Alternative Layout Kitchen/Family Room

25.7 The Carnegie			
Elevation	Circle One	A	3150.8 Square Feet
		B	3150.8 Square Feet
Taller Ceilings	Circle All that Apply	GFTC	9' Ceilings Ground Floor
		MFTC	10' Ceilings Main Floor
		SFTC	9' Ceilings Second Floor
Optional Layouts	Circle All that Apply	GFA2	GROUND FLOOR Optional Piece Bathroom
		MFA1	MAIN FLOOR Alternative Layout Kitchen/Family Room
		SFA1	SECOND FLOOR Shower in Lieu of Tub (Bedroom 2)

25.8 The Biltmore			
Elevation	Circle One	A	1980.8 Square Feet
		B	1989.3 Square Feet
Taller Ceilings	Circle All that Apply	GFTC	9' Ceilings Ground Floor
		MFTC	10' Ceilings Main Floor
		SFTC	9' Ceilings Second Floor
Optional Layouts	Circle All that Apply		

Elevation	Circle One		
Taller Ceilings	Circle All that Apply		
Optional Layouts	Circle All that Apply		

Elevation	Circle One		
Taller Ceilings	Circle All that Apply		
Optional Layouts	Circle All that Apply		

LOT 2L

July 6, 2016

OK