

Kleinburg Glen - 4L - 1 - 25-1 Elev.A RIVERSTONE OPT- GFA1
CENTRAL VAC AND WIRING

Inv.693	1 - FAMILY ROOM: CONDUIT PIPE - FOR FUTURE TELEVISION - OVER FIREPLACE. APPROX 66" AFF. TERMINATING LEFT SIDE OF FIREPLACE, STANDARD HEIGHT.
Line9193	Note:
26Jul16 / 29Jul16	
Inv.693	1 - FAMILY ROOM: RELOCATE STANDARD TELEPHONE JACK FROM KITCHEN TO FAMILY ROOM. PLEASE SEE FLOORPLAN FOR LOCATION
Line9200	Note:
26Jul16 / 29Jul16	

ELECTRICAL

Inv.693	1 - KITCHEN CABINET STRIP VALANCE LIGHTS (UNDER CABINETS) - ROUGH - IN - DOES NOT INCLUDE (AND REQUIRES) KITCHEN UPGRADE PRICING
Line9187	Note:
26Jul16 / 29Jul16	
Inv.693	1 - KITCHEN: ADDITIONAL STANDARD FIXTURE ON SAME SWITCH OVER ISLAND. CONNECTED TO 1ST ISLAND LIGHT. PLEASE SEE FLOORPLAN FOR LOCATION.
Line9189	Note:
26Jul16 / 29Jul16	
Inv.693	1 - KITCHEN: 110V WALL RECEPTACLE ON DEDICATED CIRCUIT - GAS FIRED APPLIANCE - FOR AUX. EQUIPMENT - NOT A STOVE PLUG
Line9191	Note:
26Jul16 / 29Jul16	
Inv.693	1 - KITCHEN: ADDITIONAL STANDARD FIXTURE WITH SWITCH - OVER ISLAND. CONNECTED TO SECOND ISLAND LIGHT. PLEASE SEE FLOORPLAN FOR LOCATION
Line9188	Note:
26Jul16 / 29Jul16	
Inv.693	1 - FAMILY ROOM: 110V WALL RECEPTACLE ON NORMAL CIRCUIT - OVER FIREPLACE. APPROX 66" AFF
Line9194	Note:
26Jul16 / 29Jul16	
Inv.693	1 - KITCHEN: 110V WALL RECEPTACLE ON DEDICATED CIRCUIT - FOR MICROWAVE - MICROWAVE NOT INCLUDED. RIGHT SIDE OF ISLAND. PLEASE SEE FLOORPLAN FOR LOCATION
Line9199	Note:
26Jul16 / 29Jul16	

EXTERIOR COLOURS

Inv.693	1 - EXTERIOR COLOUR PACKAGE 11
Line9611	Note:
26Jul16 / 29Jul16	

FRAMING

Inv.693	1 - MASTER ENSUITE: CONVERT FRAMED SHOWER TO 10MM FRAMLESS SHOWER ENCLOSURE WITH DOOR AND 10MM SIDE PANEL
Line9610	Note:
26Jul16 / 29Jul16	
Inv.795	1 - MAIN FLOOR:EXTENDED HEIGHT ARCHWAY
Line10621	Note:
29Aug16 / 29Aug16	

Kleinburg Glen - 4L - 1 - 25-1 Elev.A RIVERSTONE OPT- GFA1

Inv.795	1 - MAIN FLOOR: EXTENDED HEIGHT DOORWAY 96"
Line10622	Note:
29Aug16 / 29Aug16	

GLASS AND MIRROR

Inv.693	1 - MASTER ENSUITE: CONVERT FRAMED SHOWER TO 10MM FRAMLESS SHOWER ENCLOSURE WITH DOOR AND 10MM SIDE PANEL
Line9197	Note:
26Jul16 / 29Jul16	

HVAC

Inv.693	1 - KITCHEN: GAS LINE ROUGH - GROUND FLOOR FOR FUTURE GAS RANGE.
Line9190	Note:
26Jul16 / 29Jul16	

INTERIOR TRIM AND DOORS

Inv.693	2 - MAIN FLOOR: EXTENDED HEIGHT ARCHWAY (PRICE PER DOORWAY) -
Line9195	Note:
26Jul16 / 29Jul16	
Inv.693	6 - MAIN FLOOR: STANDARD DOOR EXTENDED HEIGHT 96 INCH (PRICE PER DOOR) - GROUND FLOOR 2 STOREY MODELS
Line9196	Note:
26Jul16 / 29Jul16	

MISC.

Inv.693	1 - Purchaser has attended a Structural appointment at the Decor Centre & has DECLINED any additional upgrades and accepts and acknowledges that there will be no further structural changes/additions/deletions to be made upon signing on July 26, 2016.
Line9210	Note:
26Jul16 / 29Jul16	
Inv.693	1 - Purchasers are aware & accepts that ANY changes made to upgrades after signing this Purchasers Extra Form are subject to a minimum administration fee of \$500. PLUS a 10% holdback fee.
Line9211	Note:
26Jul16 / 29Jul16	
Inv.693	1 - BONUS PACKAGE: \$5,000.00 (INCLUDING TAXES) WORTH OF UPGRADES FROM GOLD PARK HOMES DÉCOR CENTRE IS BEING APPLIED TOWARD THE STRUCTURAL APPOINTMENT. PURCHASER HAS A REMAINING AMOUNT OF \$00 (INCLUDING TAXES) TO BE USED TOWARD THE COLOUR APPOINTMENT.
Line9212	Note:
26Jul16 / 29Jul16	
Inv.693	1 - BALANCE AFTER CREDIT: \$6,661.60 PAID BY VISA: \$6,661.60
Line9214	Note:
26Jul16 / 29Jul16	

PLUMBING

Inv.693	1 - KITICHEN: ROUGH - IN - WATERLINE FOR FRIDGE
Line9192	Note:
26Jul16 / 29Jul16	
Inv.693	1 - MASTER ENSUITE: UPGRADE TO FREE STANDING TUB - UPG1 ONLY
Line9198	Note:
26Jul16 / 29Jul16	

Kleinburg Glen - 4L - 1 - 25-1 Elev.A RIVERSTONE OPT- GFA1

Inv.693	1 - MASTER ENSUITE: CONVERT FRAMED SHOWER TO 10MM FRAMLESS SHOWER ENCLOSURE WITH DOOR AND 10MM SIDE PANEL
Line9609	Note:
26Jul16 / 29Jul16	


WINDOWS - BASEMENT

Inv.693	1 - BASEMENT WINDOWS - UPGRADE EXISTING BASEMENT WINDOW TO 53 INCH X 16 INCH - MAY REQUIRE INSTALLATION OF WINDOW WELL. Please see floorplan for location
Line9186	Note:
26Jul16 / 29Jul16	

Inv.693	1 - BASEMENT: UPGRADED WINDOW TO BE COLOURMATCHED.
Line9218	Note:
26Jul16 / 29Jul16	


Elevation A • 1,849 sq.ft.

Elevation B • 1,849 sq.ft.

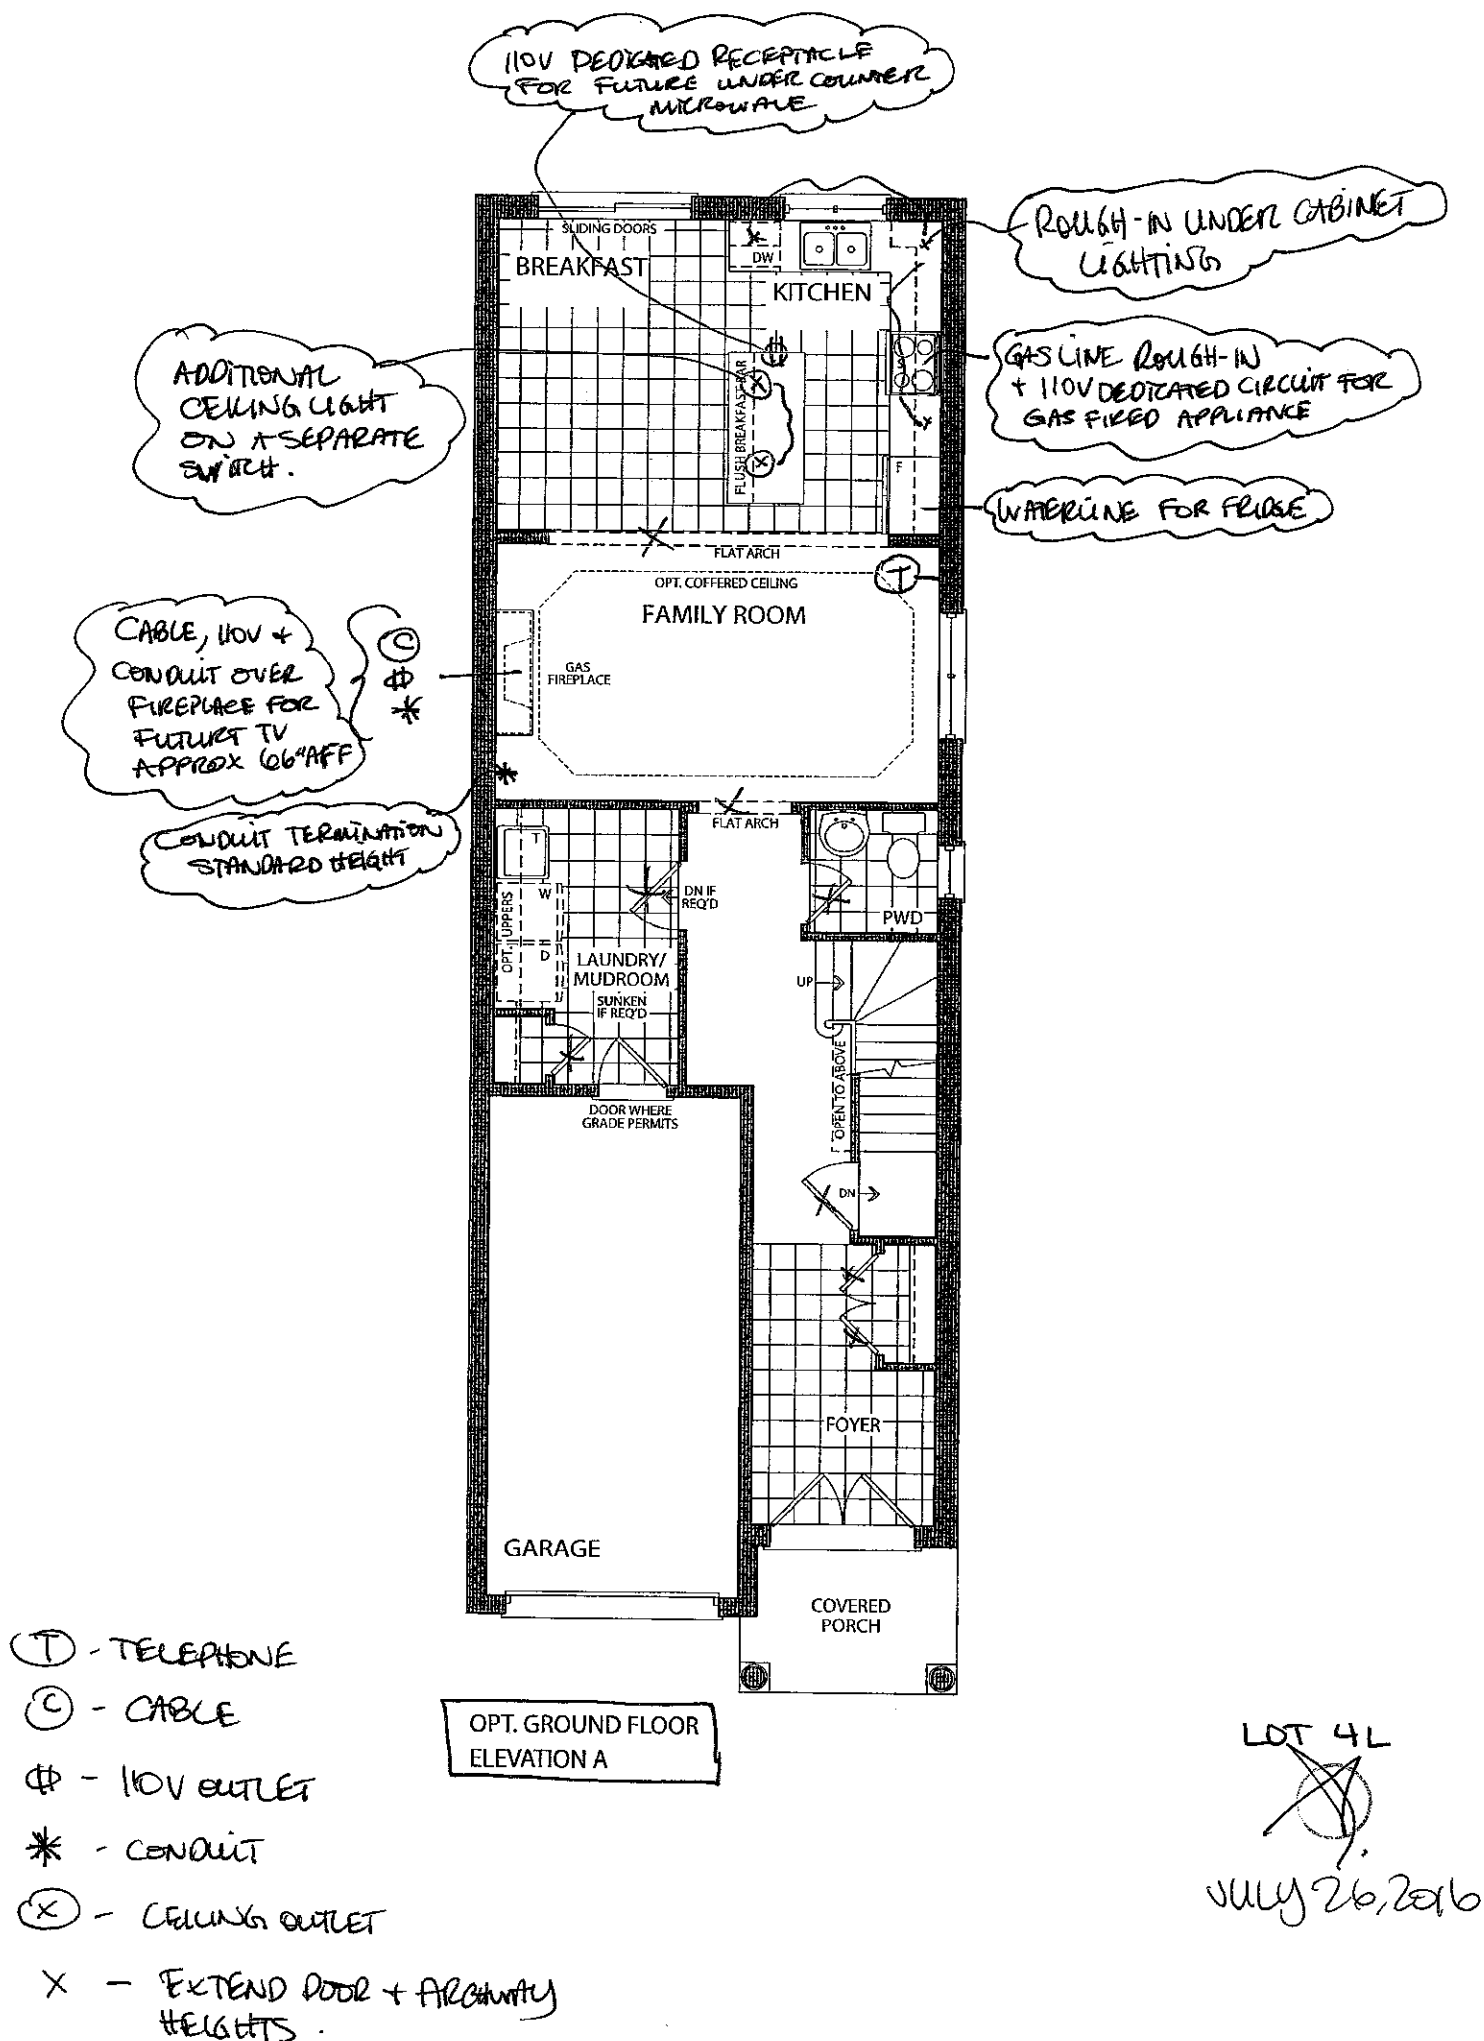


Elevation A • 1,849 sq.ft.

Elevation B • 1,849 sq.ft.

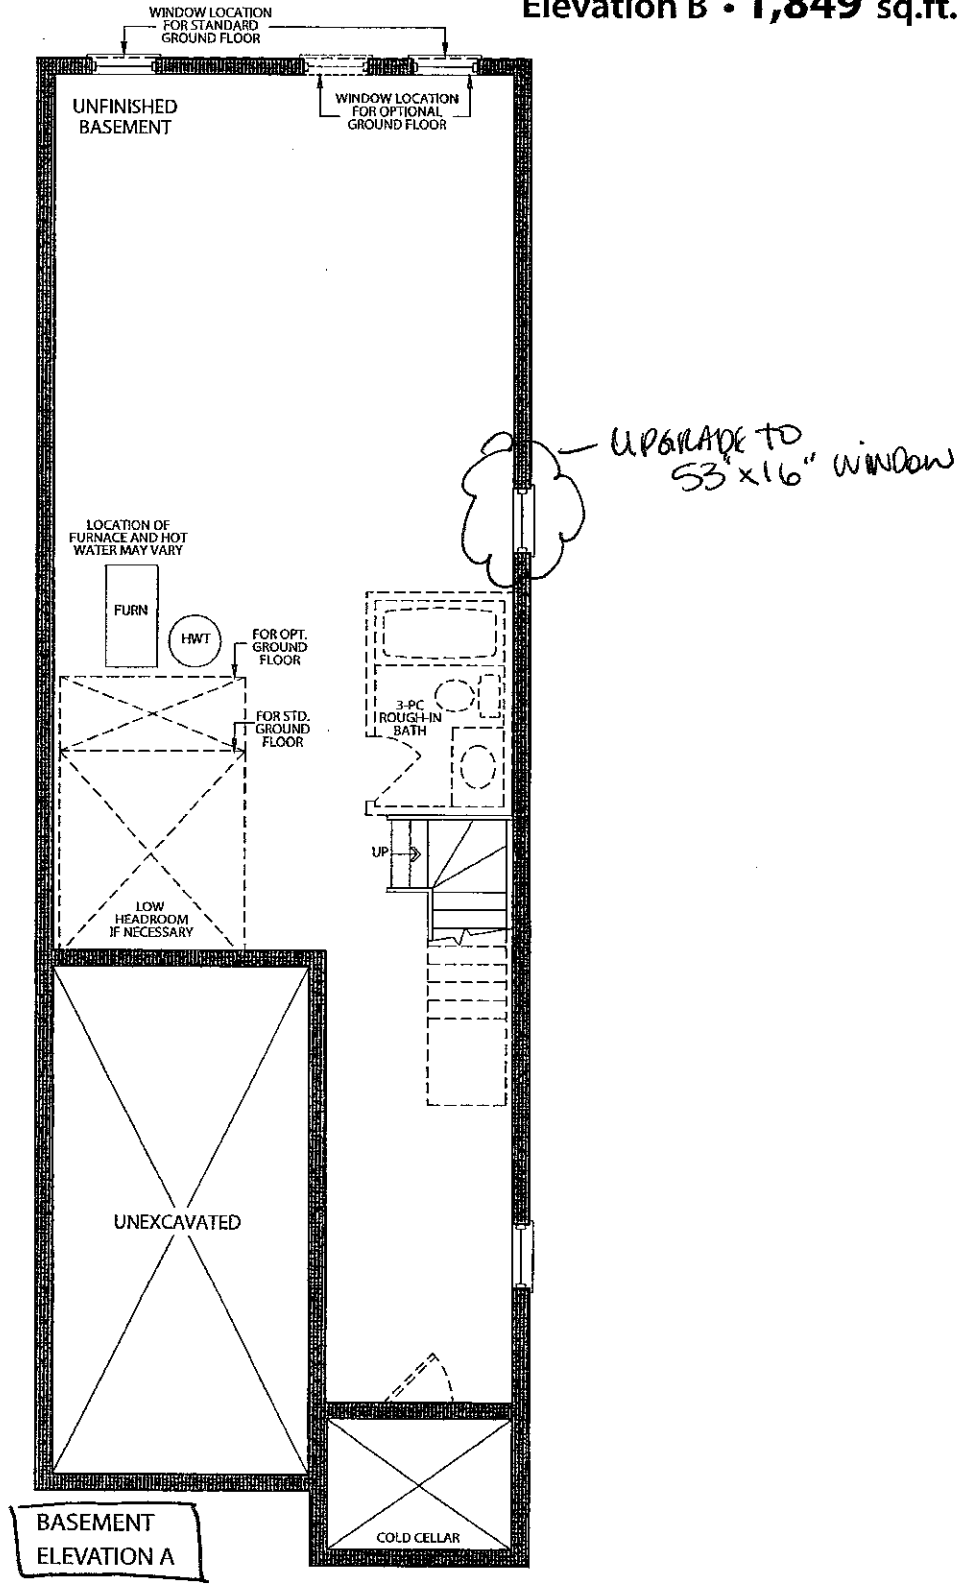



BASEMENT
ELEVATION A

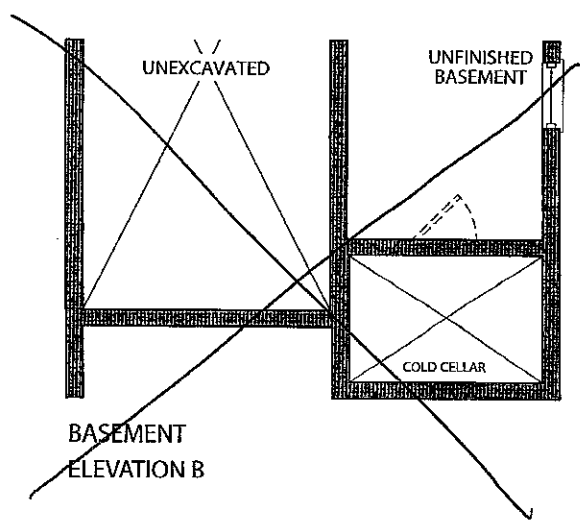

BASEMENT
ELEVATION B

LOT 4L
July 26, 2016

Elevation A • 1,849 sq.ft.
Elevation B • 1,849 sq.ft.

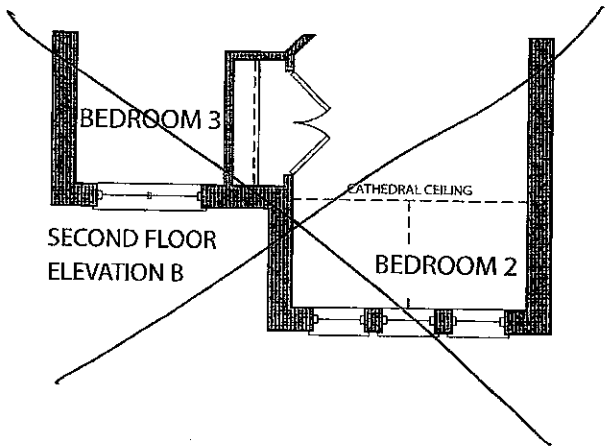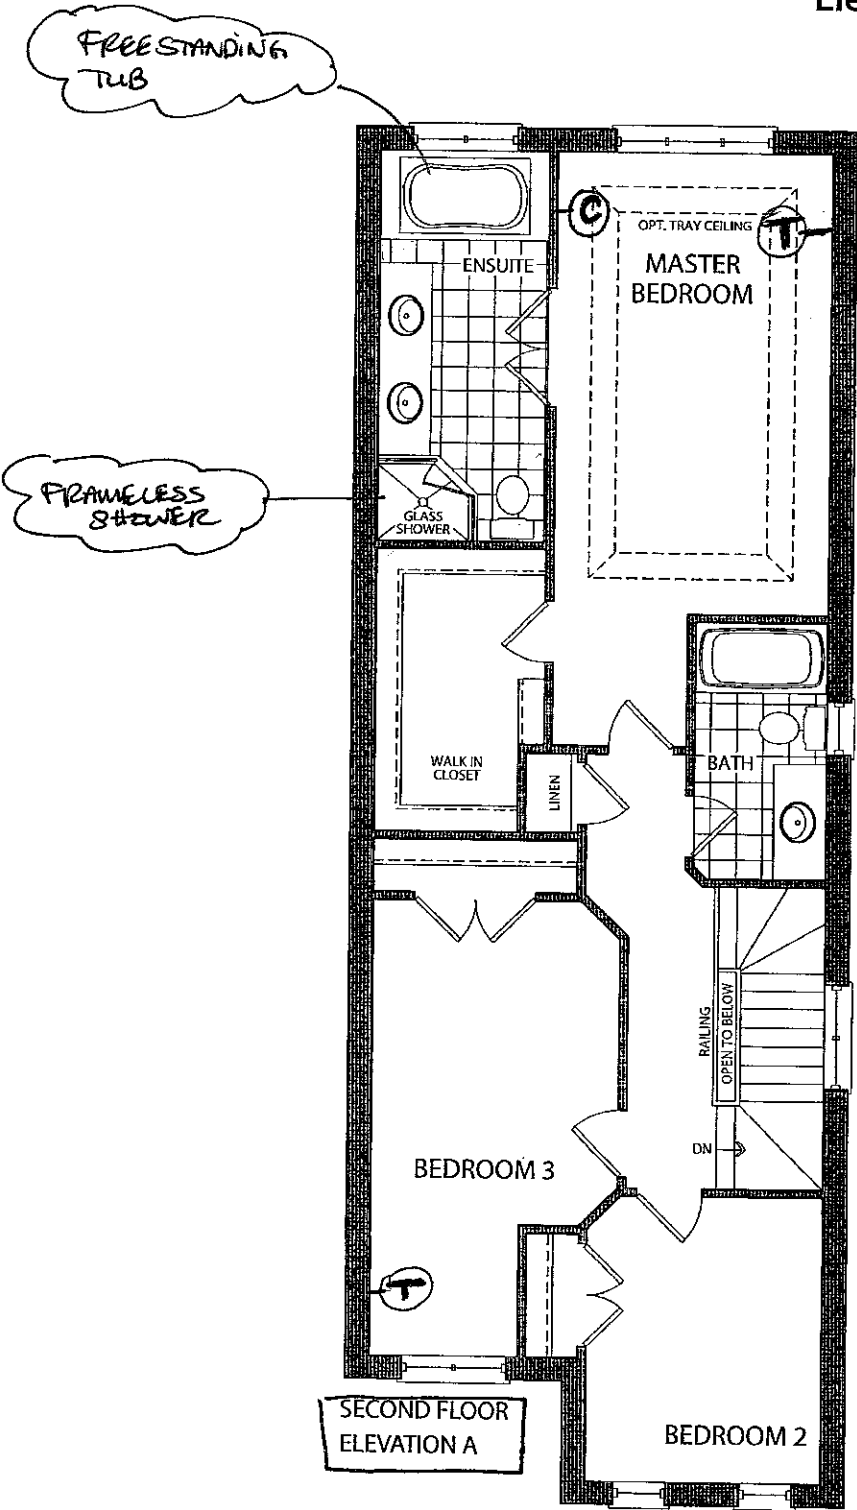

LOT 4L

July 26, 2016



Stacey Carlete
Project Coordinator



Claude Azzopardi
Contracts Manager



Nancy Martini
Corporate Controller



25.1 The Riverstone			
Elevation	Circle One	A	1812.7 Square Feet
		B	1812.7 Square Feet
Taller Ceilings	Circle All that Apply	GFTC	9' Ceilings Ground Floor
		MFTC	10' Ceilings Main Floor
		SFTC	9' Ceilings Second Floor
Optional Layouts	Circle All that Apply	GFA1	GROUND FLOOR Alternative Layout Kitchen/Family Room

25.2 The Hudson			
Elevation	Circle One	A	1860.8 Square Feet
		B	1858.6 Square Feet
Taller Ceilings	Circle All that Apply	GFTC	9' Ceilings Ground Floor
		MFTC	10' Ceilings Main Floor
		SFTC	9' Ceilings Second Floor
Optional Layouts	Circle All that Apply	GFA1	GROUND FLOOR Alternative Layout Kitchen/Family Room

25.3 The Oakmount			
Elevation	Circle One	A	2013.0 Square Feet
		B	2013.0 Square Feet
Taller Ceilings	Circle All that Apply	GFTC	9' Ceilings Ground Floor
		MFTC	10' Ceilings Main Floor
		SFTC	9' Ceilings Second Floor
Optional Layouts	Circle All that Apply	GFA1	GROUND FLOOR Alternative Layout Kitchen/Family Room
		SFA4	SECOND FLOOR Alternative Layout Laundry Room
		SFA5	SECOND FLOOR Additional Bedroom

25.4 The Stanford			
Elevation	Circle One	A	2665.6 Square Feet
		B	2665.6 Square Feet
Taller Ceilings	Circle All that Apply	GFTC	9' Ceilings Ground Floor
		MFTC	10' Ceilings Main Floor
		SFTC	9' Ceilings Second Floor
Optional Layouts	Circle All that Apply	GFA2	GROUND FLOOR Optional Piece Bathroom
		MFA1	MAIN FLOOR Alternative Layout Kitchen/Family Room
		SFA2	SECOND FLOOR Shower in Lieu of Tub (Master Ens.)
		SFA5	SECOND FLOOR Additional Bedroom

25.5 The Regency			
Elevation	Circle One	A	2924.0 Square Feet
		B	2924.0 Square Feet
Taller Ceilings	Circle All that Apply	GFTC	9' Ceilings Ground Floor
		MFTC	10' Ceilings Main Floor
		SFTC	9' Ceilings Second Floor
Optional Layouts	Circle All that Apply	GFA2	GROUND FLOOR Optional Piece Bathroom
		MFA1	MAIN FLOOR Alternative Layout Kitchen/Family Room
		SFA2	SECOND FLOOR Shower in Lieu of Tub (Master Ens.)
		SFA5	SECOND FLOOR Additional Bedroom

25.6 The Lincoln			
Elevation	Circle One	A	3021.0 Square Feet
		B	3014.0 Square Feet
Taller Ceilings	Circle All that Apply	GFTC	9' Ceilings Ground Floor
		MFTC	10' Ceilings Main Floor
		SFTC	9' Ceilings Second Floor
Optional Layouts	Circle All that Apply	GFA2	GROUND FLOOR Optional Piece Bathroom
		MFA1	MAIN FLOOR Alternative Layout Kitchen/Family Room

25.7 The Carnegie			
Elevation	Circle One	A	3150.8 Square Feet
		B	3150.8 Square Feet
Taller Ceilings	Circle All that Apply	GFTC	9' Ceilings Ground Floor
		MFTC	10' Ceilings Main Floor
		SFTC	9' Ceilings Second Floor
Optional Layouts	Circle All that Apply	GFA2	GROUND FLOOR Optional Piece Bathroom
		MFA1	MAIN FLOOR Alternative Layout Kitchen/Family Room
		SFA1	SECOND FLOOR Shower in Lieu of Tub (Bedroom 2)

25.8 The Biltmore			
Elevation	Circle One	A	1980.8 Square Feet
		B	1989.3 Square Feet
Taller Ceilings	Circle All that Apply	GFTC	9' Ceilings Ground Floor
		MFTC	10' Ceilings Main Floor
		SFTC	9' Ceilings Second Floor
Optional Layouts	Circle All that Apply		

Elevation	Circle One		
Taller Ceilings	Circle All that Apply		
Optional Layouts	Circle All that Apply		

Elevation	Circle One		
Taller Ceilings	Circle All that Apply		
Optional Layouts	Circle All that Apply		

LOT 4L

July 26, 2016