

Kleinburg Glen - 5R - 1 - 25-3 Elev.B OAKMOUNT OPT- SFA5

CENTRAL VAC AND WIRING

Inv.674	1 - MUDROOM: ROUGH - IN FOR EXTRA SECURITY KEY PAD
Line8782	Note:
18Jul16 / 30Aug16	
Inv.674	1 - FAMILY ROOM: ROUGH - IN WIRING FOR ONE PAIR OF SPEAKERS - See plan for location.
Line8783	Note:
18Jul16 / 30Aug16	
Inv.674	1 - FAMILY ROOM: CONDUIT PIPE - FOR TELEVISION - Locate above fireplace, approx. 66" A.F.F. Terminating beside fireplace at cable location. See plan for location.
Line8784	Note:
18Jul16 / 30Aug16	

DRYWALL

Inv.674	1 - SMOOTH CEILINGS - (2 - Story Design) 2ND FLOOR
Line8796	Note:
18Jul16 / 30Aug16	

ELECTRICAL

Inv.674	1 - FAMILY ROOM: 110V WALL RECEPTACLE ON NORMAL CIRCUIT Locate approx. 66" A.F.F. above fireplace for future tv. See plan for location.
Line8785	Note:
18Jul16 / 30Aug16	
Inv.674	2 - KITCHEN & BREAKFAST: RELOCATE STANDARD FIXTURE -Kitchen: locate approx. center above island. Breakfast: locate approx. center of window. See plan for location.
Line8786	Note:
18Jul16 / 30Aug16	
Inv.674	1 - KITCHEN: 110V WALL RECEPTACLE ON DEDICATED CIRCUIT - FOR MICROWAVE - MICROWAVE & CABINETRY CUSTOMIZATION NOT INCLUDED. For future *below counter* shelf, see plan for location.
Line8787	Note:
18Jul16 / 30Aug16	

EXTERIOR COLOURS

Inv.674	1 - EXTERIOR COLOUR PACKAGE 10
Line9614	Note:
18Jul16 / 30Aug16	

FRAMING

Inv.674	10 - MAIN FLOOR: FRAME MAIN FLOOR DOORS & ARCHES AT 96 INCH - ADDED WITH THE ADDITION OF TALLER INTERIOR DOORS
Line8789	Note:
18Jul16 / 30Aug16	

INTERIOR TRIM AND DOORS

Inv.674	4 - MAIN FLOOR: EXTENDED HEIGHT ARCHWAY (PRICE PER DOORWAY) - 96"
Line8790	Note:
18Jul16 / 30Aug16	
Inv.674	6 - MAIN FLOOR: STANDARD DOOR EXTENDED HEIGHT 96 INCH (PRICE PER DOOR) - GROUND FLOOR 2 STOREY MODELS
Line8791	Note:
18Jul16 / 30Aug16	

Kleinburg Glen - 5R - 1 - 25-3 Elev.B OAKMOUNT OPT- SFA5

KITCHEN AND BATH CABINETRY

Inv.674	1 - KITCHEN: ROTATE ISLAND 90 degrees. See plan for location.
Line8795	Note:
18Jul16 / 30Aug16	

MISC.

Inv.674	1 - Purchaser has attended a Structural appointment at the Decor Centre & has DECLINED any additional upgrades and accepts and acknowledges that there will be no further structural changes/additions/deletions to be made upon signing on July 18, 2016.
Line8797	Note:
18Jul16 / 30Aug16	

Inv.674	1 - Purchasers are aware & accepts that ANY changes made to upgrades after signing this Purchasers Extra Form are subject to a minimum administration fee of \$500. PLUS a 10% holdback fee.
Line8798	Note:
18Jul16 / 30Aug16	

Inv.674	1 - BONUS PACKAGE: \$5,000.00 (INCLUDING TAXES) WORTH OF UPGRADES FROM GOLD PARK HOMES DÉCOR CENTRE IS BEING APPLIED TOWARD THE STRUCTURAL APPOINTMENT. PURCHASER HAS A REMAINING AMOUNT OF \$00 (INCLUDING TAXES) TO BE USED TOWARD THE COLOUR APPOINTMENT.
Line8799	Note:
18Jul16 / 30Aug16	

PLUMBING

Inv.674	1 - KITCHEN: ROUGH - IN - WATERLINE FOR FRIDGE
Line8793	Note:
18Jul16 / 30Aug16	

Inv.674	1 - KITCHEN: ROTATE ISLAND 90 degrees. See plan for location.
Line9613	Note:
18Jul16 / 30Aug16	

WINDOWS - BASEMENT

Inv.674	2 - BASEMENT WINDOWS - UPGRADE EXISTING BASEMENT WINDOW TO 30 INCH X 24 INCH - MAY REQUIRE INSTALLATION OF WINDOW WELL *2 SIDE WINDOWS, LOB lot *see plan for location.
Line8794	Note:
18Jul16 / 30Aug16	



Elevation B • 2,053 sq.ft.

GROUND FLOOR
ELEVATION A

STD. & OPT.
GROUND FLOOR
ELEVATION B





GOLDPARK
HOMES


~~Elevation A • 2,053 sq.ft.~~

✓ Elevation B • 2,053 sq.ft.

LOT 5R
July 18 2016

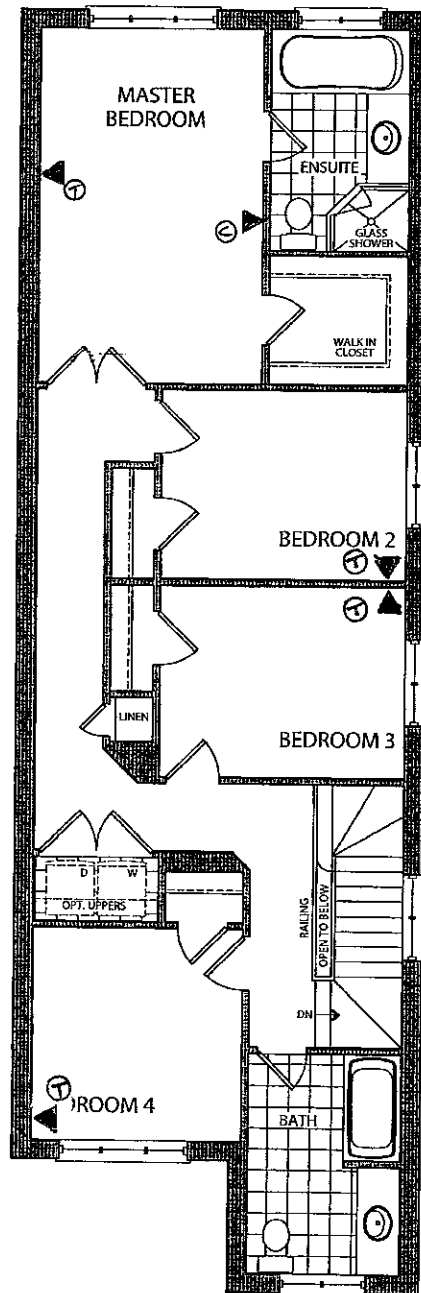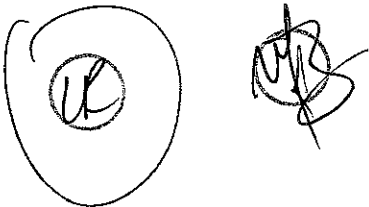


X OPT. SECOND FLOOR
ELEVATION A

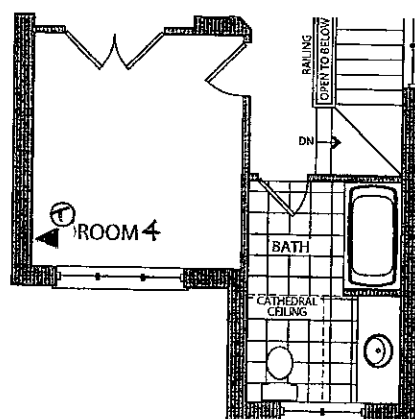

* OPT. SECOND FLOOR
ELEVATION B
(4-BDRM).

Elevation A • 2,053 sq.ft.

Elevation B • 2,053 sq.ft.

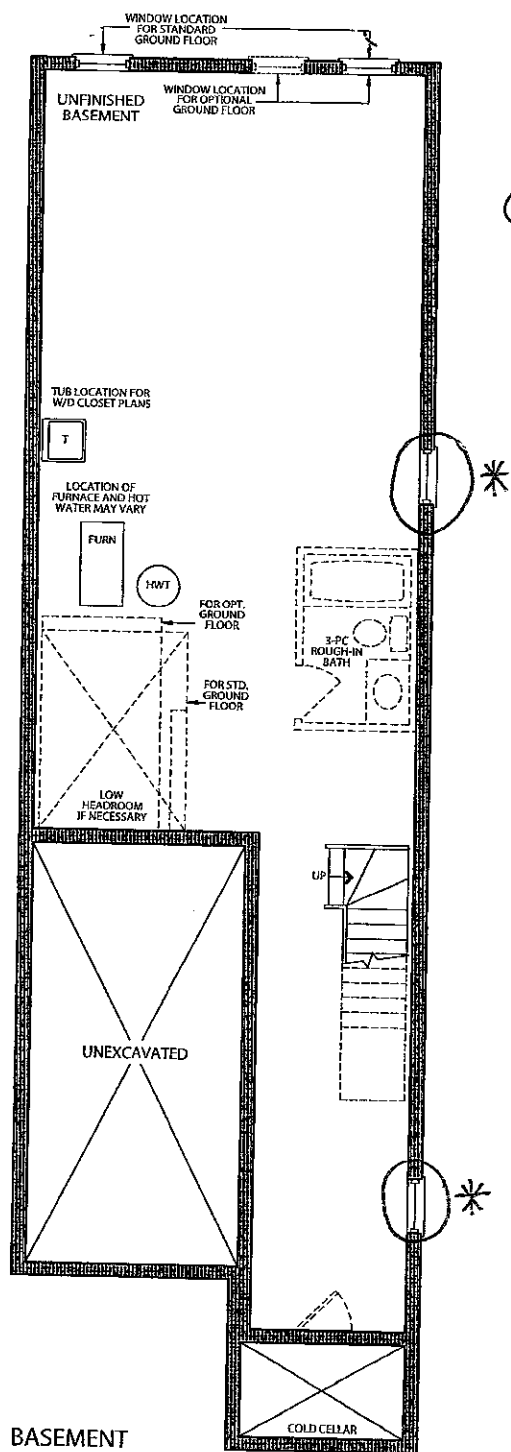

UPG
24 x 30"
window

BASEMENT
ELEVATION A & B

Lot 52
July 18 2016.
[Handwritten signatures]



Stacey Carlete
Project Coordinator



Claude Azzopardi
Contracts Manager



Nancy Martini
Corporate Controller



25.1 The Riverstone			
Elevation	Circle One	A	1812.7 Square Feet
		B	1812.7 Square Feet
Taller Ceilings	Circle All that Apply	GFTC	9' Ceilings Ground Floor
		MFTC	10' Ceilings Main Floor
		SFTC	9' Ceilings Second Floor
Optional Layouts	Circle All that Apply	GFA1	GROUND FLOOR Alternative Layout Kitchen/Family Room

25.2 The Hudson			
Elevation	Circle One	A	1860.8 Square Feet
		B	1858.6 Square Feet
Taller Ceilings	Circle All that Apply	GFTC	9' Ceilings Ground Floor
		MFTC	10' Ceilings Main Floor
		SFTC	9' Ceilings Second Floor
Optional Layouts	Circle All that Apply	GFA1	GROUND FLOOR Alternative Layout Kitchen/Family Room

25.3 The Oakmount			
Elevation	Circle One	A	2013.0 Square Feet
		<u>B</u>	2013.0 2053.0 Square Feet
Taller Ceilings	Circle All that Apply	GFTC	9' Ceilings Ground Floor
		MFTC	10' Ceilings Main Floor
		SFTC	9' Ceilings Second Floor
Optional Layouts	Circle All that Apply	GFA1	GROUND FLOOR Alternative Layout Kitchen/Family Room
		SFA4	SECOND FLOOR Alternative Layout Laundry Room
		<u>SFA5</u>	SECOND FLOOR Additional Bedroom

25.4 The Stanford			
Elevation	Circle One	A	2665.6 Square Feet
		B	2665.6 Square Feet
Taller Ceilings	Circle All that Apply	GFTC	9' Ceilings Ground Floor
		MFTC	10' Ceilings Main Floor
		SFTC	9' Ceilings Second Floor
Optional Layouts	Circle All that Apply	GFA2	GROUND FLOOR Optional Piece Bathroom
		MFA1	MAIN FLOOR Alternative Layout Kitchen/Family Room
		SFA2	SECOND FLOOR Shower in Lieu of Tub (Master Ens.)
		SFA5	SECOND FLOOR Additional Bedroom

25.5 The Regency			
Elevation	Circle One	A	2924.0 Square Feet
		B	2924.0 Square Feet
Taller Ceilings	Circle All that Apply	GFTC	9' Ceilings Ground Floor
		MFTC	10' Ceilings Main Floor
		SFTC	9' Ceilings Second Floor
Optional Layouts	Circle All that Apply	GFA2	GROUND FLOOR Optional Piece Bathroom
		MFA1	MAIN FLOOR Alternative Layout Kitchen/Family Room
		SFA2	SECOND FLOOR Shower in Lieu of Tub (Master Ens.)
		SFA5	SECOND FLOOR Additional Bedroom

25.6 The Lincoln			
Elevation	Circle One	A	3021.0 Square Feet
		B	3014.0 Square Feet
Taller Ceilings	Circle All that Apply	GFTC	9' Ceilings Ground Floor
		MFTC	10' Ceilings Main Floor
		SFTC	9' Ceilings Second Floor
Optional Layouts	Circle All that Apply	GFA2	GROUND FLOOR Optional Piece Bathroom
		MFA1	MAIN FLOOR Alternative Layout Kitchen/Family Room

25.7 The Carnegie			
Elevation	Circle One	A	3150.8 Square Feet
		B	3150.8 Square Feet
Taller Ceilings	Circle All that Apply	GFTC	9' Ceilings Ground Floor
		MFTC	10' Ceilings Main Floor
		SFTC	9' Ceilings Second Floor
Optional Layouts	Circle All that Apply	GFA2	GROUND FLOOR Optional Piece Bathroom
		MFA1	MAIN FLOOR Alternative Layout Kitchen/Family Room
		SFA1	SECOND FLOOR Shower in Lieu of Tub (Bedroom 2)

25.8 The Biltmore			
Elevation	Circle One	A	1980.8 Square Feet
		B	1989.3 Square Feet
Taller Ceilings	Circle All that Apply	GFTC	9' Ceilings Ground Floor
		MFTC	10' Ceilings Main Floor
		SFTC	9' Ceilings Second Floor
Optional Layouts	Circle All that Apply		

Elevation	Circle One		
Taller Ceilings	Circle All that Apply		
Optional Layouts	Circle All that Apply		

Elevation	Circle One		
Taller Ceilings	Circle All that Apply		
Optional Layouts	Circle All that Apply		

Lot 5R

