

CONSTRUCTION SUMMARY

Kleinburg Glen - 6L - 1 - 25-3 Elev.A OAKMOUNT OPT- SFA5 EXTERIOR COLOURS

Inv. 567	1 - EXTERIOR COLOUR PACKAGE 1
Line10700	Note:
14Jun16 / 30Aug16	

MISC.

	MISC.
Inv.567	1 - Purchaser has attended a Structural appointment at the Decor Centre & has DECLINED any additional upgrades and accepts and acknowledges that there will be no further structural changes/additions/deletions to be made upon signing on June 14, 2016
Line8409	Note:
14Jun16/30Aug16	
Inv.567	1 - BONUS PACKAGE: \$5,000.00 (INCLUDING TAXES) WORTH OF UPGRADES FROM GOLD PARK HOMES DÉCOR CENTRE IS BEING APPLIED TOWARD THE STRUCTURAL APPOINTMENT. PURCHASER HAS A REMAINING AMOUNT OF \$1621.30 (INCLUDING TAXES) TO BE USED TOWARD THE COLOUR APPOINTMENT.
Line 8411	Note:
14Jun16/30Aug16	
Inv. 567	1 - Purchasers are aware & accepts that ANY changes made to upgrades after signing this Purchasers Extra Form are subject to a minimum administration fee of \$500. PLUS a 10% holdback fee.
Line8410	Note:
14Jun16/30Aug16	

WINDOWS - BASEMENT


Inv. 567	2 - BASEMENT WINDOWS - UPGRADE EXISTING BASEMENT WINDOW TO 30 INCH X 24
	INCH - MAY REQUIRE INSTALLATION OF WINDOW WELL *SIDE WINDOWS- LOB LOT
Line10699	Note:
14Jun16/30Aug16	

Page 1 of 1



the Oakmount

Elevation A • 2,053 sq.ft. Elevation B • 2,053 sq.ft.

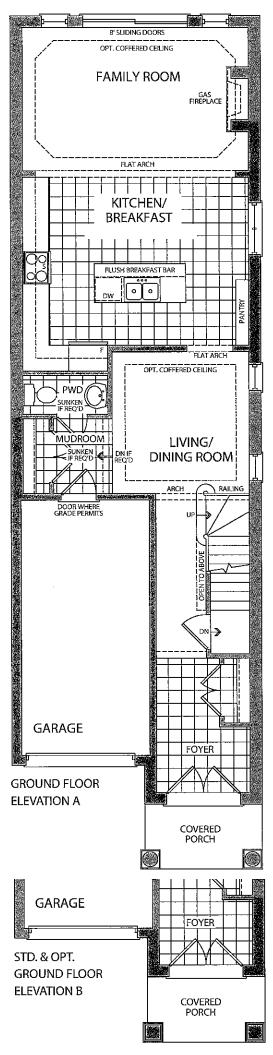






the Oakmount

Elevation B • 2,053 sq.ft.

LOT 6L

July: 122016

See attached
signature

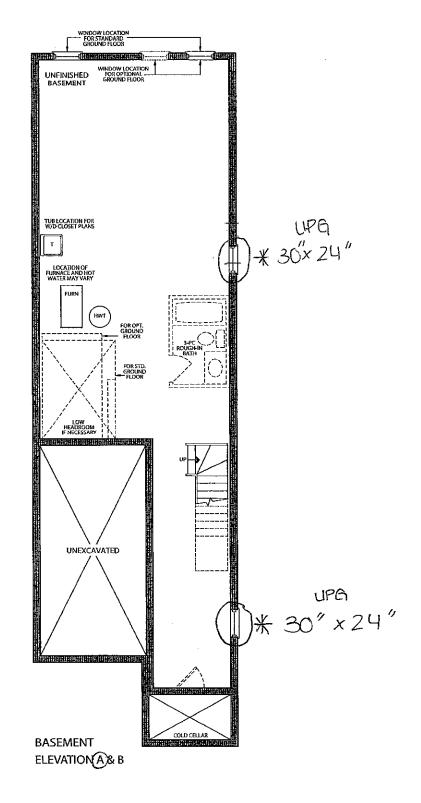







the Oakmount

Elevation B • 2,053 sq.ft. ×

LOTEL July 12 2016 Described Signature

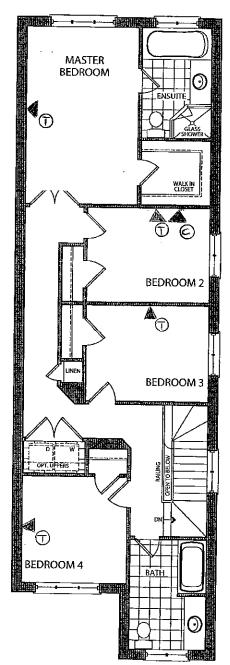

OPT. SECOND FLOOR ELEVATION A

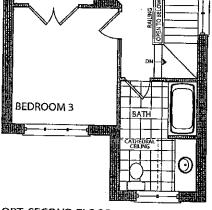

OPT. SECOND FLOOR ELEVATION B



()	Stacey Carlete
	Project Coordinator







Model	25.1 The Riverstone			
	Circle	Α	1812.7 Square Feet	
Elevation	One	В	1812.7 Square Feet	
	Circle All that Apply	GFTC	9' Ceilings Ground Floor	
Taller Ceilings		MFTC	10' Ceilings Main Floor	
		SFTC	9' Ceilings Second Floor	
		GFA1	GROUND FLOOR Alternative Layout Kitchen/Family Room	
Optional Layouts	Circle All that Apply			

Model		25.2 T	he Hudson
Elevation	Circle One	А	1860.8 Square Feet
Elevation		В	1858.6 Square Feet
-	Circle All that Apply	GFTC	9' Ceilings Ground Floor
Taller Ceilings		MFTC	10' Ceilings Main Floor
		SFTC	9' Ceilings Second Floor
		GFA1	GROUND FLOOR Alternative Layout Kitchen/Family Room
Optional Layouts	Circle All that Apply		

Model	25.3 The Oakmount			
Elevation	Circle	A	2013.0 Square Feet	
Lievation	One	В	2013.0 Square Feet	
	Circle All that Apply	GFTC	9¹ Ceilings Ground Floor	
Taller Ceilings		MFTC	10' Ceilings Main Floor	
		SFTC	9' Ceilings Second Floor	
		GFA1	GROUND FLOOR Alternative Layout Kitchen/Family Room	
Optional Layouts	Circle All that Apply	SFA4	SECOND FLOOR Alternative Layout Laundry Room	
		(SFA5)	SECOND FLOOR Additional Bedroom	

Model	25.4 The Stanford		
Elevation	Circle	А	2665.6 Square Feet
Lievacion	One	В	2665.6 Square Feet
	Circle All that Apply	GFTC	9' Ceilings Ground Floor
Taller Ceilings		MFTC	10' Ceilings Main Floor
		SFTC	9' Ceilings Second Floor
	Circle All that Apply	GFA2	GROUND FLOOR Optional 3- Piece Bathroom
Optional		MFA1	MAIN FLOOR Alternative Layout Kitchen/Family Room
Layouts		SFA2	SECOND FLOOR Shower in Lieu of Tub (Master Ens.)
***)] **havkvyasvka rasvavra		SFA5	SECOND FLOOR Additional Bedroom

Model		25.5 T	he Regency
	Circle	Α	2924.0 Square Feet
Elevation	One	В	2924.0 Square Feet
	Circle All that Apply	GFTC	9' Ceilings Ground Floor
Taller Ceilings		MFTC	10' Ceilings Main Floor
		SFTC	9' Ceilings Second Floor
	: All that :	GFA2	GROUND FLOOR Optional 3- Piece Bathroom
Optional		MFA1	MAIN FLOOR Alternative Layout Kitchen/Family Room
Layouts		SFA2	SECOND FLOOR Shower in Lieu of Tub (Master Ens.)
		SFA5	SECOND FLOOR Additional Bedroom

Model	25.6 The Lincoln		
Elevation	Circle	A	3021.0 Square Feet
Elevacion	One	В	3014.0 Square Feet
Taller Ceilings	Circle All that Apply	GFTC	9' Ceilings Ground Floor
		MFTC	10' Ceilings Main Floor
		SFTC	9' Ceilings Second Floor
	Circle All that Apply	GFA2	GROUND FLOOR Optional 3 Piece Bathroom
Optional Layouts		MFA1	MAIN FLOOR Alternative Layout Kitchen/Family Room
	<u>.</u>		

Model	25.7 The Carnegie			
Elevation	Circle	А	3150.8 Square Feet	
	One	В	3150.8 Square Feet	
	Circle All that Apply	GFTC	9' Ceilings Ground Floor	
Taller Ceilings		MFTC	10' Ceilings Main Floor	
		SFTC	9' Ceilings Second Floor	
	Circle All that Apply	GFA2	GROUND FLOOR Optional 3- Piece Bathroom	
Optional Layouts		MFA1	MAIN FLOOR Alternative Layout Kitchen/Family Room	
		SFA1	SECOND FLOOR Shower in Lieu of Tub (Bedroom 2)	

Model	25.8 The Biltmore			
-1	Circle One	A	1980.8 Square Feet	
Elevation		В	1989.3 Square Feet	
	Circle All that Apply	GFTC	9' Ceilings Ground Floor	
Taller Ceilings		MFTC	10' Ceîlings Main Floor	
		SFTC	9' Ceilings Second Floor	
Optional Layouts	Circle All that Apply			

	Model		
	Elevation	Circle One	
		Circle All that Apply	
	Optional Layouts	Circle All that Apply	

Model		·	
Elevation	Circle One		
Taller Ceilings	Circle All that Apply		
Optional Layouts	Circle All that Apply		

MLOT 6L
DLOT 6L July 12 2016
cer altached signature