

Kleinburg Glen - 7L - 1 - 25-2 Elev.A HUDSON
CENTRAL VAC AND WIRING

Inv.559	1 - GARAGE ENTRANCE - ADD ROUGH - IN FOR EXTRA SECURITY KEY PAD at door from house to garage
Line6836	Note:
13Jun16 / 28Sep16	
Inv.559	1 - FAMILY ROOM - Add CONDUIT PIPE - FOR TELEVISION - above fireplace approx. 60" A.F.F., terminating right side of fireplace beside cable outlet. See plan for location.
Line6840	Note:
13Jun16 / 28Sep16	
Inv.559	2 - BEDROOM 2 & BEDROOM 3 - Add CAT 5 WIRING - ADD an EXTRA CABLE OUTLET in each bedroom. See plan for location
Line6843	Note:
13Jun16 / 28Sep16	

DRYWALL

Inv.559	1 - SMOOTH CEILINGS - (2 - Story Design) 2ND FLOOR
Line6837	Note:
13Jun16 / 28Sep16	

ELECTRICAL

Inv.559	1 - FAMILY ROOM - Add a 110V WALL RECEPTACLE ON NORMAL CIRCUIT - above fireplace, approx. 60" A.F.F. See plan for location
Line6842	Note:
13Jun16 / 28Sep16	

EXTERIOR COLOURS

Inv.873	1 - EXTERIOR COLOUR PACKAGE 4
Line12099	Note:
28Sep16 / 28Sep16	

HVAC

Inv.559	1 - HUMIDIFIER: WB3 - 12 (UP TO 2,000 SQ.FT.)
Line6839	Note:
13Jun16 / 28Sep16	


MISC.

Inv.559	1 - Purchaser has attended a Structural appointment at the Decor Centre & has DECLINED any additional upgrades and accepts and acknowledges that there will be no further structural changes/additions/deletions to be made upon signing on June 13, 2016.
Line6844	Note:
13Jun16 / 28Sep16	
Inv.559	1 - Purchasers are aware & accepts that ANY changes made to upgrades after signing this Purchasers Extra Form are subject to a minimum administration fee of \$500. PLUS a 10% holdback fee.
Line6845	Note:
13Jun16 / 28Sep16	
Inv.559	1 - BONUS PACKAGE: \$5,000.00 (INCLUDING TAXES) WORTH OF UPGRADES FROM GOLD PARK HOMES DÉCOR CENTRE IS BEING APPLIED TOWARD THE STRUCTURAL APPOINTMENT. PURCHASER HAS A REMAINING AMOUNT OF \$0.00 (INCLUDING TAXES) TO BE USED TOWARD THE COLOUR APPOINTMENT.
Line6846	Note:
13Jun16 / 28Sep16	

LOT 7L

JUNE 13 2016.

PL

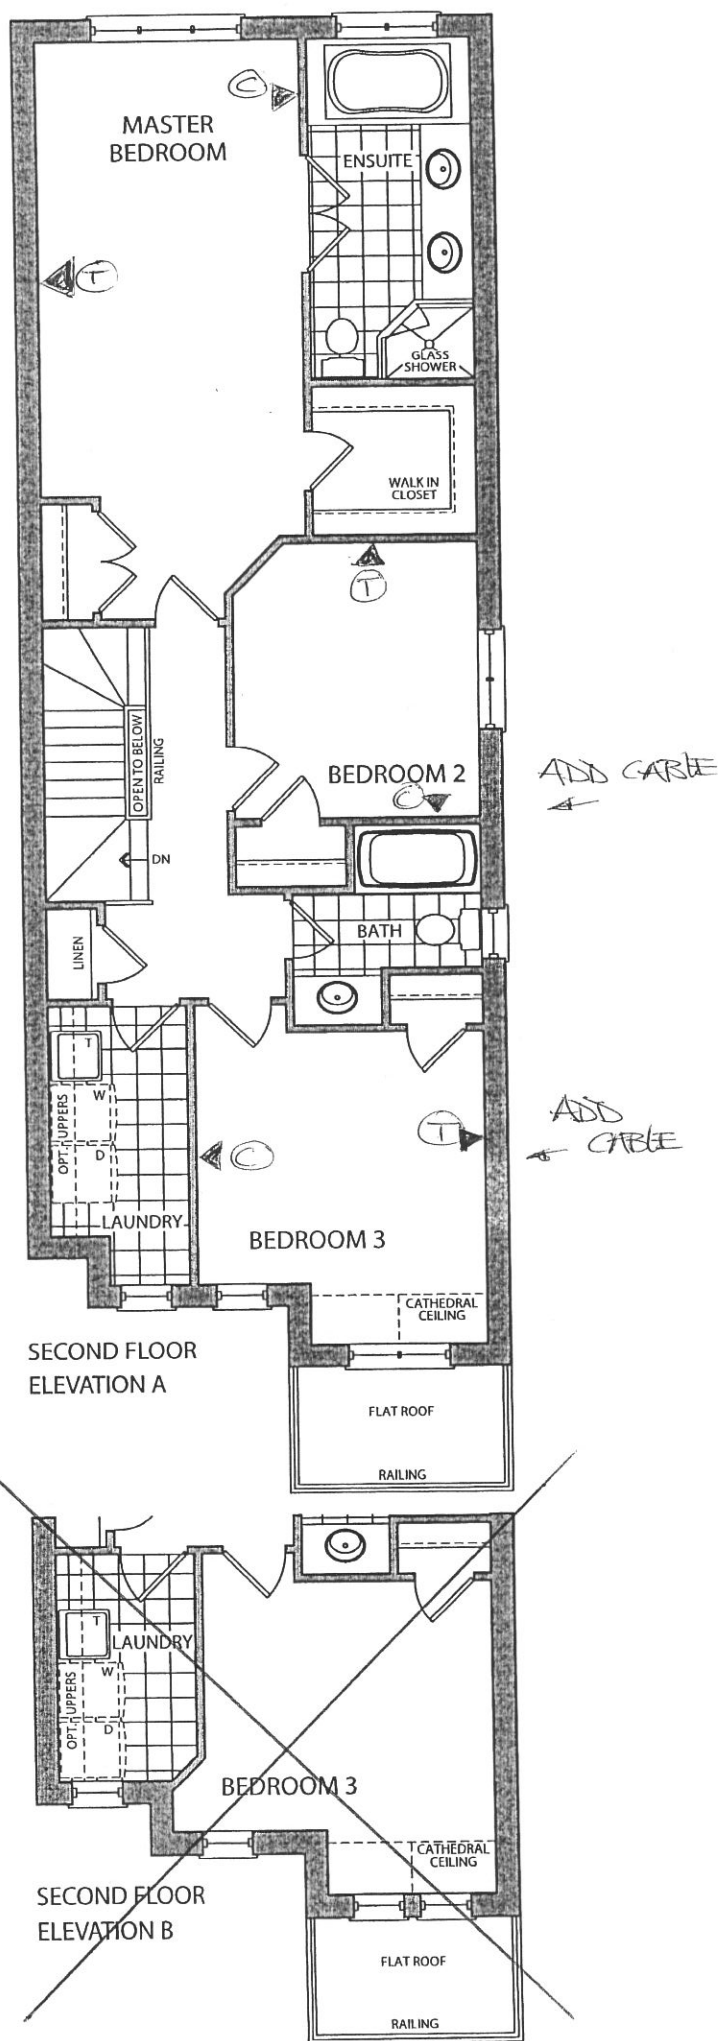

LOT 7L

JUNE 13 2016


Pin

the Hudson

Elevation A • 1,898 sq.ft.

Elevation B • 1,898 sq.ft.


ADD: ELECTRICAL OUTLET
2" CONDUIT above
fireplace - 60" AFF
to RIGHT of F.P.
beside CABLE.

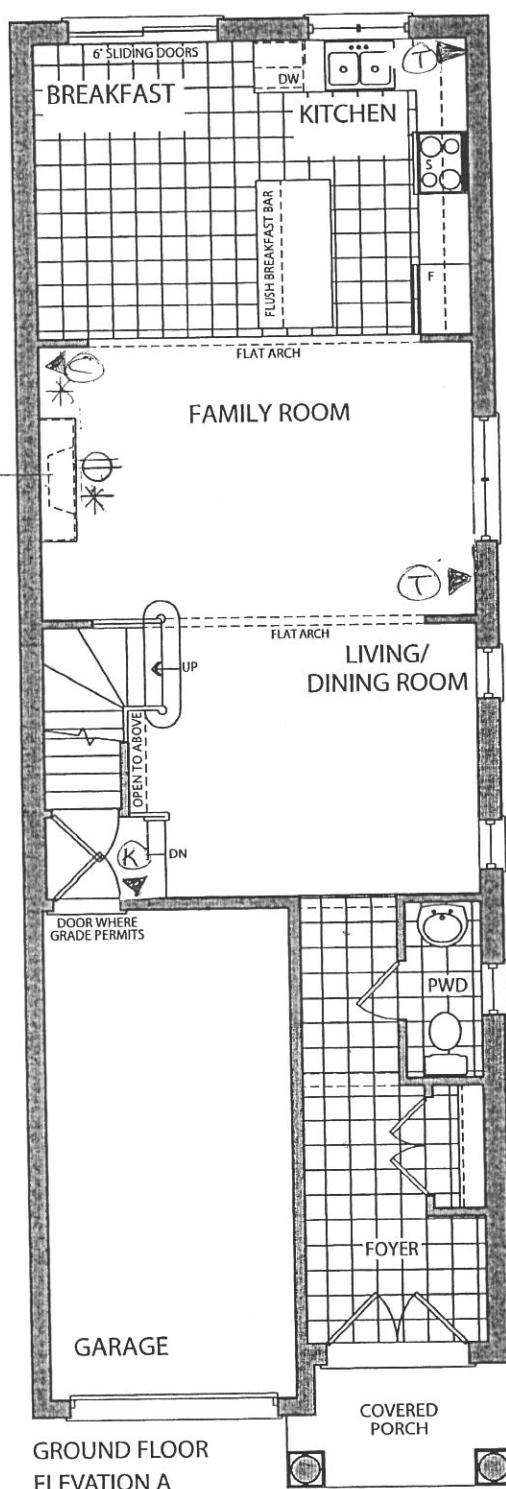

GROUND FLOOR
ELEVATION A

LEGEND.


- ▲ (T) - PHONE
- ▲ (C) - CABLE
- ▲ (K) - ROUGH-IN KEYPAD
- * - 2" CONDUIT
- - ELECTRICAL OUTLET

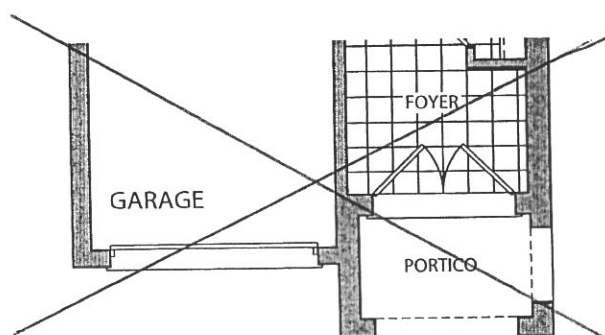


GROUND FLOOR
ELEVATION B

LOT 7L

JUNE 13 2016

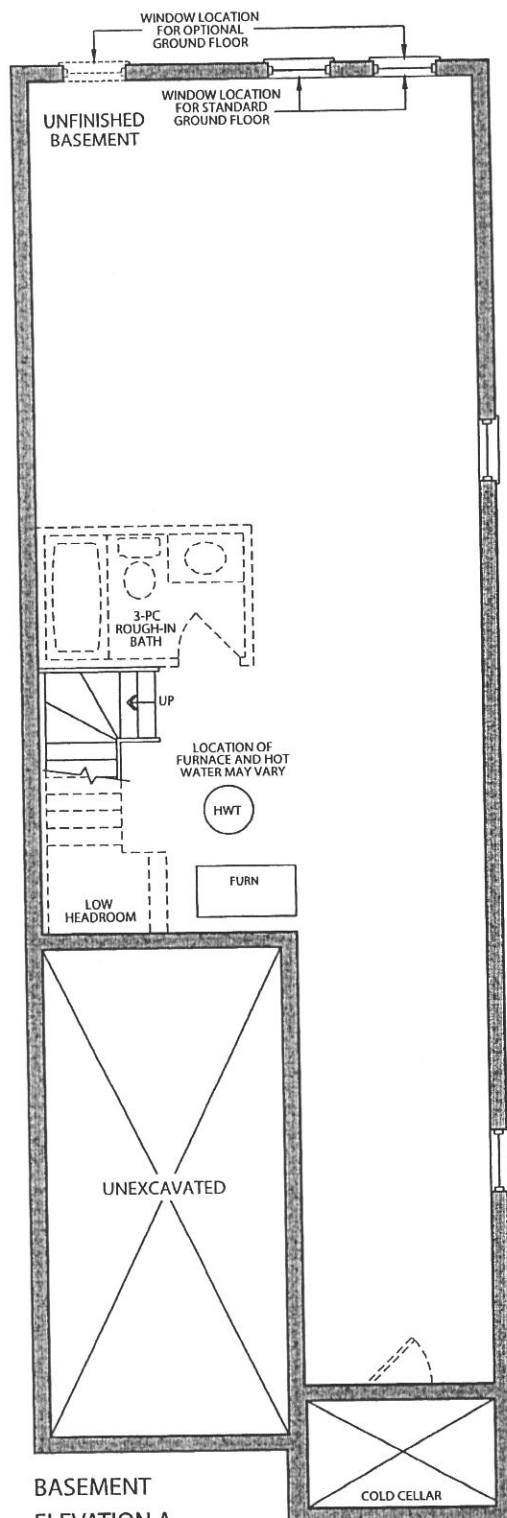

BASEMENT
ELEVATION A

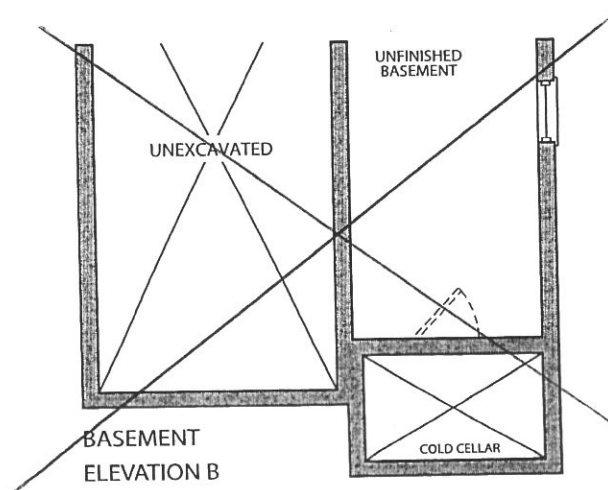

BASEMENT
ELEVATION B



Stacey Carlete
Project Coordinator



Claude Azzopardi
Contracts Manager



Nancy Martini
Corporate Controller



25.1 The Riverstone			
Elevation	Circle One	A	1812.7 Square Feet
		B	1812.7 Square Feet
Taller Ceilings	Circle All that Apply	GFTC	9' Ceilings Ground Floor
		MFTC	10' Ceilings Main Floor
		SFTC	9' Ceilings Second Floor
Optional Layouts	Circle All that Apply	GFA1	GROUND FLOOR Alternative Layout Kitchen/Family Room

25.2 The Hudson			
Elevation	Circle One	A	1860.8 Square Feet
		B	1858.6 Square Feet
Taller Ceilings	Circle All that Apply	GFTC	9' Ceilings Ground Floor
		MFTC	10' Ceilings Main Floor
		SFTC	9' Ceilings Second Floor
Optional Layouts	Circle All that Apply	GFA1	GROUND FLOOR Alternative Layout Kitchen/Family Room

25.3 The Oakmount			
Elevation	Circle One	A	2013.0 Square Feet
		B	2013.0 Square Feet
Taller Ceilings	Circle All that Apply	GFTC	9' Ceilings Ground Floor
		MFTC	10' Ceilings Main Floor
		SFTC	9' Ceilings Second Floor
Optional Layouts	Circle All that Apply	GFA1	GROUND FLOOR Alternative Layout Kitchen/Family Room
		SFA4	SECOND FLOOR Alternative Layout Laundry Room
		SFA5	SECOND FLOOR Additional Bedroom

25.4 The Stanford			
Elevation	Circle One	A	2665.6 Square Feet
		B	2665.6 Square Feet
Taller Ceilings	Circle All that Apply	GFTC	9' Ceilings Ground Floor
		MFTC	10' Ceilings Main Floor
		SFTC	9' Ceilings Second Floor
Optional Layouts	Circle All that Apply	GFA2	GROUND FLOOR Optional Piece Bathroom
		MFA1	MAIN FLOOR Alternative Layout Kitchen/Family Room
		SFA2	SECOND FLOOR Shower in Lieu of Tub (Master Ens.)
		SFA5	SECOND FLOOR Additional Bedroom

25.5 The Regency			
Elevation	Circle One	A	2924.0 Square Feet
		B	2924.0 Square Feet
Taller Ceilings	Circle All that Apply	GFTC	9' Ceilings Ground Floor
		MFTC	10' Ceilings Main Floor
		SFTC	9' Ceilings Second Floor
Optional Layouts	Circle All that Apply	GFA2	GROUND FLOOR Optional Piece Bathroom
		MFA1	MAIN FLOOR Alternative Layout Kitchen/Family Room
		SFA2	SECOND FLOOR Shower in Lieu of Tub (Master Ens.)
		SFA5	SECOND FLOOR Additional Bedroom

25.6 The Lincoln			
Elevation	Circle One	A	3021.0 Square Feet
		B	3014.0 Square Feet
Taller Ceilings	Circle All that Apply	GFTC	9' Ceilings Ground Floor
		MFTC	10' Ceilings Main Floor
		SFTC	9' Ceilings Second Floor
Optional Layouts	Circle All that Apply	GFA2	GROUND FLOOR Optional Piece Bathroom
		MFA1	MAIN FLOOR Alternative Layout Kitchen/Family Room

25.7 The Carnegie			
Elevation	Circle One	A	3150.8 Square Feet
		B	3150.8 Square Feet
Taller Ceilings	Circle All that Apply	GFTC	9' Ceilings Ground Floor
		MFTC	10' Ceilings Main Floor
		SFTC	9' Ceilings Second Floor
Optional Layouts	Circle All that Apply	GFA2	GROUND FLOOR Optional Piece Bathroom
		MFA1	MAIN FLOOR Alternative Layout Kitchen/Family Room
		SFA1	SECOND FLOOR Shower in Lieu of Tub (Bedroom 2)

25.8 The Biltmore			
Elevation	Circle One	A	1980.8 Square Feet
		B	1989.3 Square Feet
Taller Ceilings	Circle All that Apply	GFTC	9' Ceilings Ground Floor
		MFTC	10' Ceilings Main Floor
		SFTC	9' Ceilings Second Floor
Optional Layouts	Circle All that Apply		

Elevation	Circle One		
Taller Ceilings	Circle All that Apply		
Optional Layouts	Circle All that Apply		

Elevation	Circle One		
Taller Ceilings	Circle All that Apply		
Optional Layouts	Circle All that Apply		

LOT 7L
PH JUNE 13 2016.