

Kleinburg Glen - 7R - 1 - 25-1 Elev.A RIVERSTONE OPT- GFA1
CENTRAL VAC AND WIRING

Inv.682	2 - LAUNDRY & MASTER BEDROOM: ROUGH - IN FOR EXTRA SECURITY KEY PAD. PLEASE SEE FLOORPLAN FOR LOCATIONS
Line8918	Note:
20Jul16 / 30Sep16	
Inv.682	1 - FAMILY ROOM: CONDUIT PIPE - FOR TELEVISION - OVER FIREPLACE. APPROX 66" AFF. PLEASE SEE FLOORPLAN FOR LOCATION. TERMINATING ON LEFT SIDE OF FIREPLACE
Line8930	Note:
20Jul16 / 30Sep16	

ELECTRICAL

Inv.682	1 - KITCHEN: 110V WALL RECEPTACLE ON DEDICATED CIRCUIT - FOR MICROWAVE - MICROWAVE NOT INCLUDED. IN ISLAND, RIGHT SIDE. PLEASE SEE FLOORPLAN FOR LOCATION
Line8921	Note:
20Jul16 / 30Sep16	
Inv.682	1 - KITCHEN CABINET STRIP VALANCE LIGHTS (UNDER CABINETS) - ROUGH - IN - DOES NOT INCLUDE (AND REQUIRES) KITCHEN UPGRADE PRICING
Line8922	Note:
20Jul16 / 30Sep16	
Inv.682	1 - KITCHEN: ADDITIONAL STANDARD FIXTURE WITH SWITCH - OVER ISLAND. PLEASE SEE FLOORPLAN FOR LOCATION.
Line8924	Note:
20Jul16 / 30Sep16	
Inv.682	1 - KITCHEN: ADDITIONAL STANDARD FIXTURE ON SAME SWITCH - OVER ISLAND. CONNECTED TO OTHER ISLAND CEILING LIGHT. PLEASE SEE FLOORPLAN FOR LOCATION
Line8926	Note:
20Jul16 / 30Sep16	
Inv.682	1 - FAMILY ROOM: 110V WALL RECEPTACLE ON NORMAL CIRCUIT - LOCATED ABOVE THE FIREPLACE APPROX 66" AFF. PLEASE SEE FLOORPLAN FOR LOCATION
Line8931	Note:
20Jul16 / 30Sep16	

EXTERIOR COLOURS

Inv.682	1 - EXTERIOR COLOUR PACKAGE 1
Line12165	Note:
20Jul16 / 30Sep16	

FRAMING

Inv.682	1 - OPTIONAL GROUND FLOOR LAYOUT
Line12166	Note:
20Jul16 / 30Sep16	

MISC.


Inv.682	1 - Purchaser has attended a Structural appointment at the Decor Centre & has DECLINED any additional upgrades and accepts and acknowledges that there will be no further structural changes/additions/deletions to be made upon signing on July 20, 2016.
Line8927	Note:
20Jul16 / 30Sep16	
Inv.682	1 - Purchasers are aware & accepts that ANY changes made to upgrades after signing this Purchasers Extra Form are subject to a minimum administration fee of \$500. PLUS a 10% holdback fee.
Line8928	Note:
20Jul16 / 30Sep16	



CONSTRUCTION SUMMARY

Kleinburg Glen - 7R - 1 - 25-1 Elev.A RIVERSTONE OPT- GFA1

Inv.682	1 - BONUS PACKAGE: \$5,000.00 (INCLUDING TAXES) WORTH OF UPGRADES FROM GOLD PARK HOMES DÉCOR CENTRE IS BEING APPLIED TOWARD THE STRUCTURAL APPOINTMENT. PURCHASER HAS A REMAINING AMOUNT OF \$3,564.90 (INCLUDING TAXES) TO BE USED TOWARD THE COLOUR APPOINTMENT.
Line8929	Note:
20Jul16 / 30Sep16	

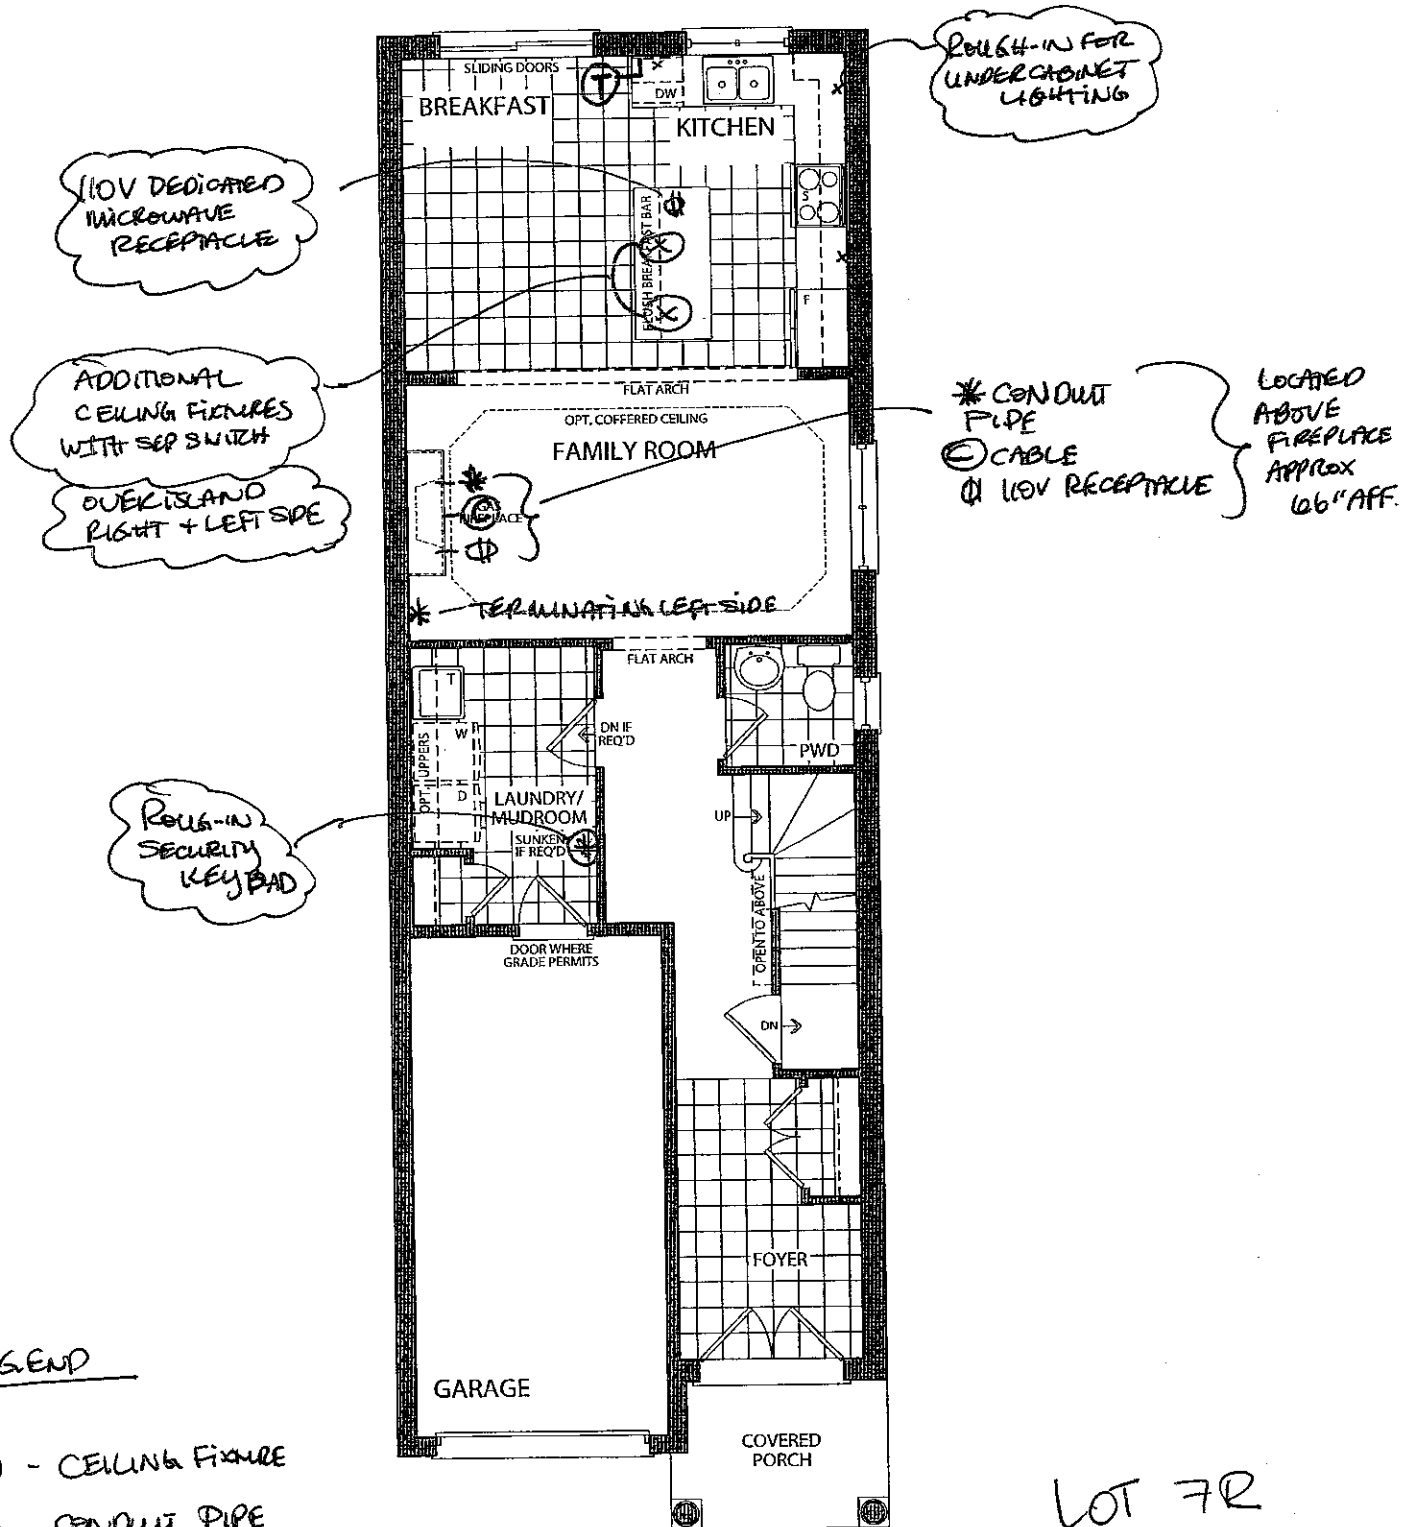



LEGEND

- (X) - CEILING FIXTURE
- * - CONDUIT PIPE
- (C) - CABLE
- (R) - 110V RECEPTACLE
- x - UNDERCABINET ROUGH-IN
- (T) - TELEPHONE
- (*) - SECURITY KEY PAD ROUGH-IN

OPT. GROUND FLOOR
ELEVATION A



LOT 7R

[Signature]
July 20, 2016

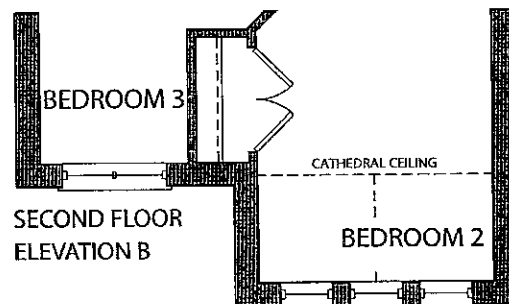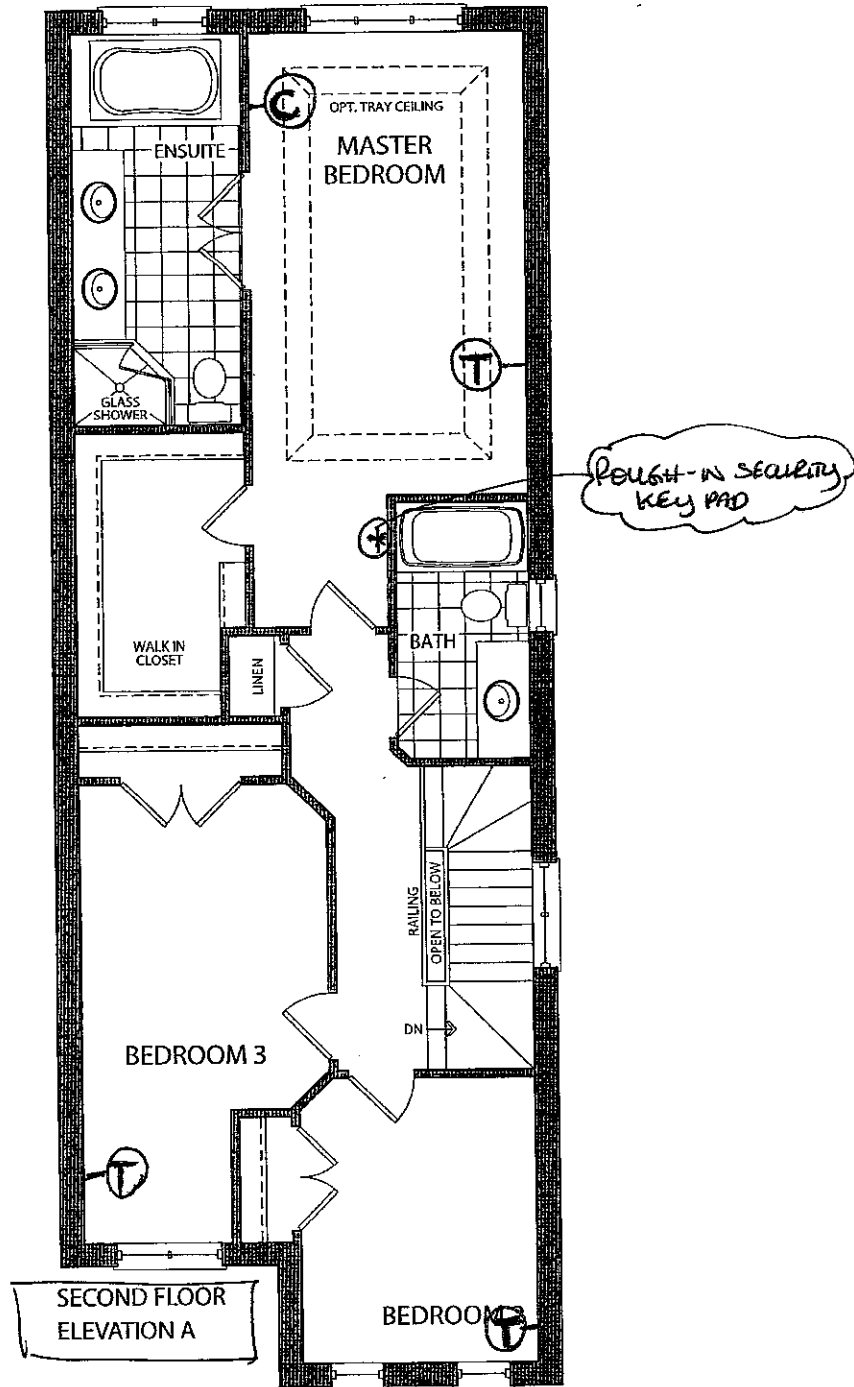

LOT 7R
[Signature]
July 20, 2016

Elevation A • 1,849 sq.ft.
Elevation B • 1,849 sq.ft.

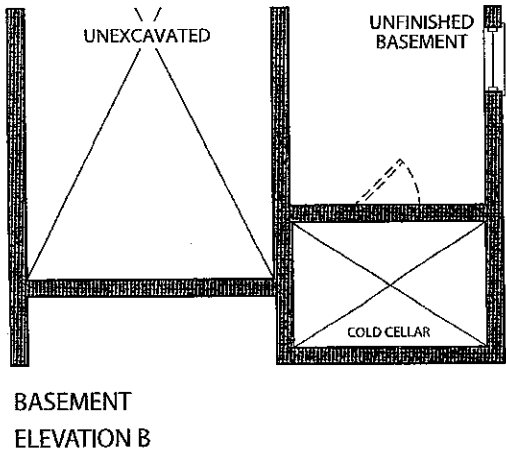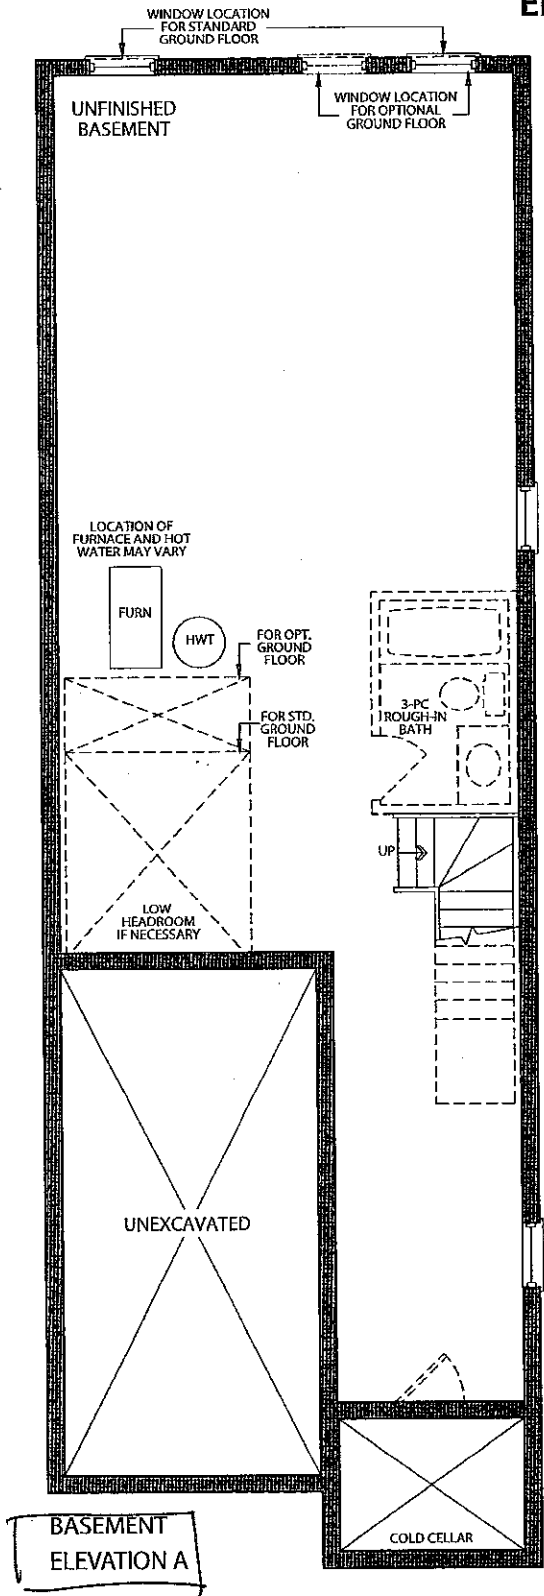

LOT 7R
[Signature]
July 20, 2016.



Stacey Carlete
Project Coordinator



Claude Azzopardi
Contracts Manager



Nancy Martini
Corporate Controller



25.1 The Riverstone			
Elevation	Circle One	A	1812.7 Square Feet
		B	1812.7 Square Feet
Taller Ceilings	Circle All that Apply	GFTC	9' Ceilings Ground Floor
		MFTC	10' Ceilings Main Floor
		SFTC	9' Ceilings Second Floor
Optional Layouts	Circle All that Apply	GFA1	GROUND FLOOR Alternative Layout Kitchen/Family Room

25.2 The Hudson			
Elevation	Circle One	A	1860.8 Square Feet
		B	1858.6 Square Feet
Taller Ceilings	Circle All that Apply	GFTC	9' Ceilings Ground Floor
		MFTC	10' Ceilings Main Floor
		SFTC	9' Ceilings Second Floor
Optional Layouts	Circle All that Apply	GFA1	GROUND FLOOR Alternative Layout Kitchen/Family Room

25.3 The Oakmount			
Elevation	Circle One	A	2013.0 Square Feet
		B	2013.0 Square Feet
Taller Ceilings	Circle All that Apply	GFTC	9' Ceilings Ground Floor
		MFTC	10' Ceilings Main Floor
		SFTC	9' Ceilings Second Floor
Optional Layouts	Circle All that Apply	GFA1	GROUND FLOOR Alternative Layout Kitchen/Family Room
		SFA4	SECOND FLOOR Alternative Layout Laundry Room
		SFA5	SECOND FLOOR Additional Bedroom

25.4 The Stanford			
Elevation	Circle One	A	2665.6 Square Feet
		B	2665.6 Square Feet
Taller Ceilings	Circle All that Apply	GFTC	9' Ceilings Ground Floor
		MFTC	10' Ceilings Main Floor
		SFTC	9' Ceilings Second Floor
Optional Layouts	Circle All that Apply	GFA2	GROUND FLOOR Optional Piece Bathroom
		MFA1	MAIN FLOOR Alternative Layout Kitchen/Family Room
		SFA2	SECOND FLOOR Shower in Lieu of Tub (Master Ens.)
		SFA5	SECOND FLOOR Additional Bedroom

25.5 The Regency			
Elevation	Circle One	A	2924.0 Square Feet
		B	2924.0 Square Feet
Taller Ceilings	Circle All that Apply	GFTC	9' Ceilings Ground Floor
		MFTC	10' Ceilings Main Floor
		SFTC	9' Ceilings Second Floor
Optional Layouts	Circle All that Apply	GFA2	GROUND FLOOR Optional Piece Bathroom
		MFA1	MAIN FLOOR Alternative Layout Kitchen/Family Room
		SFA2	SECOND FLOOR Shower in Lieu of Tub (Master Ens.)
		SFA5	SECOND FLOOR Additional Bedroom

25.6 The Lincoln			
Elevation	Circle One	A	3021.0 Square Feet
		B	3014.0 Square Feet
Taller Ceilings	Circle All that Apply	GFTC	9' Ceilings Ground Floor
		MFTC	10' Ceilings Main Floor
		SFTC	9' Ceilings Second Floor
Optional Layouts	Circle All that Apply	GFA2	GROUND FLOOR Optional Piece Bathroom
		MFA1	MAIN FLOOR Alternative Layout Kitchen/Family Room

25.7 The Carnegie			
Elevation	Circle One	A	3150.8 Square Feet
		B	3150.8 Square Feet
Taller Ceilings	Circle All that Apply	GFTC	9' Ceilings Ground Floor
		MFTC	10' Ceilings Main Floor
		SFTC	9' Ceilings Second Floor
Optional Layouts	Circle All that Apply	GFA2	GROUND FLOOR Optional Piece Bathroom
		MFA1	MAIN FLOOR Alternative Layout Kitchen/Family Room
		SFA1	SECOND FLOOR Shower in Lieu of Tub (Bedroom 2)

25.8 The Biltmore			
Elevation	Circle One	A	1980.8 Square Feet
		B	1989.3 Square Feet
Taller Ceilings	Circle All that Apply	GFTC	9' Ceilings Ground Floor
		MFTC	10' Ceilings Main Floor
		SFTC	9' Ceilings Second Floor
Optional Layouts	Circle All that Apply		

Elevation	Circle One		
Taller Ceilings	Circle All that Apply		
Optional Layouts	Circle All that Apply		

Elevation	Circle One		
Taller Ceilings	Circle All that Apply		
Optional Layouts	Circle All that Apply		

Lot 7R

July 20/16.