

Kleinburg Glen - 9L - 1 - 25-7 Elev.B CARNEGIE OPT- GFA2 AND SFA1  
CENTRAL VAC AND WIRING

|                  |                                                                                                                       |
|------------------|-----------------------------------------------------------------------------------------------------------------------|
| Inv.557          | 1 - GROUND FLOOR: ROUGH - IN FOR EXTRA SECURITY KEY PAD. Installed at door entry. Please see floor plan for location. |
| Line6816         | Note:                                                                                                                 |
| 10Jun16 / 4Oct16 |                                                                                                                       |
| Inv.557          | 1 - CONDUIT PIPE - FROM ATTIC TO ELECTRICAL PANEL - MUST SPECIFY LOCATION AND TERMINATION POINT                       |
| Line6823         | Note:                                                                                                                 |
| 10Jun16 / 4Oct16 |                                                                                                                       |

DRYWALL

|                  |                                                                   |
|------------------|-------------------------------------------------------------------|
| Inv.557          | 2 - SMOOTH CEILINGS - (3 - Story Design) 2ND FLOOR & Ground Floor |
| Line6812         | Note: All 3 floors to be smooth. PRICE ADJUSTED SEE PE:883        |
| 10Jun16 / 4Oct16 |                                                                   |

EXTERIOR COLOURS

|                 |                                |
|-----------------|--------------------------------|
| Inv.884         | 1 - EXTERIOR COLOUR PACKAGE 11 |
| Line12271       | Note:                          |
| 4Oct16 / 4Oct16 |                                |

FRAMING

|                  |                                                                                                                          |
|------------------|--------------------------------------------------------------------------------------------------------------------------|
| Inv.557          | 1 - OPTIONAL GROUND FLOOR                                                                                                |
| Line12267        | Note:                                                                                                                    |
| 10Jun16 / 4Oct16 |                                                                                                                          |
| Inv.557          | 1 - SHOWER IN LIEU OF TUB BEDROOM 2                                                                                      |
| Line12268        | Note:                                                                                                                    |
| 10Jun16 / 4Oct16 |                                                                                                                          |
| Inv.557          | 1 - MAIN FLOOR: STANDARD DOOR EXTENDED HEIGHT 96 INCH (PRICE PER DOOR) MAIN FLOOR 3 STOREY MODELS - INCLUDE FRAMING NOTE |
| Line12270        | Note:                                                                                                                    |
| 10Jun16 / 4Oct16 |                                                                                                                          |

INTERIOR TRIM AND DOORS

|                  |                                                                                                                          |
|------------------|--------------------------------------------------------------------------------------------------------------------------|
| Inv.557          | 4 - MAIN FLOOR: STANDARD DOOR EXTENDED HEIGHT 96 INCH (PRICE PER DOOR) MAIN FLOOR 3 STOREY MODELS - INCLUDE FRAMING NOTE |
| Line6819         | Note:                                                                                                                    |
| 10Jun16 / 4Oct16 |                                                                                                                          |

MISC.

|                  |                                                                                                                                                                                                                                                            |
|------------------|------------------------------------------------------------------------------------------------------------------------------------------------------------------------------------------------------------------------------------------------------------|
| Inv.557          | 1 - Purchasers are aware & accepts that ANY changes made to upgrades after signing this Purchasers Extra Form are subject to a minimum administration fee of \$500. PLUS a 10% holdback fee.                                                               |
| Line6821         | Note:                                                                                                                                                                                                                                                      |
| 10Jun16 / 4Oct16 |                                                                                                                                                                                                                                                            |
| Inv.557          | 1 - Purchaser has attended a Structural appointment at the Decor Centre & has DECLINED any additional upgrades and accepts and acknowledges that there will be no further structural changes/additions/deletions to be made upon signing on June 15, 2016. |
| Line6820         | Note:                                                                                                                                                                                                                                                      |
| 10Jun16 / 4Oct16 |                                                                                                                                                                                                                                                            |


**Kleinburg Glen - 9L - 1 - 25-7 Elev.B CARNEGIE OPT- GFA2 AND SFA1**

|                  |                                                                                                                                                                                                                                                               |
|------------------|---------------------------------------------------------------------------------------------------------------------------------------------------------------------------------------------------------------------------------------------------------------|
| Inv.557          | 1 - BONUS PACKAGE: \$2500.00 (INCLUDING TAXES) WORTH OF UPGRADES FROM GOLD PARK HOMES DÉCOR CENTRE IS BEING APPLIED TOWARD THE STRUCTURAL APPOINTMENT. PURCHASER HAS A REMAINING AMOUNT OF \$2500 (INCLUDING TAXES) TO BE USED TOWARD THE COLOUR APPOINTMENT. |
| Line6822         | Note: 1st Cheque Amount Paid \$2693.70<br>2nd Cheque Amount Paid \$2693.70                                                                                                                                                                                    |
| 10Jun16 / 4Oct16 |                                                                                                                                                                                                                                                               |

**PLUMBING**

|                  |                                                |
|------------------|------------------------------------------------|
| Inv.557          | 1 - KITCHEN: ROUGH - IN - WATERLINE FOR FRIDGE |
| Line6818         | Note:                                          |
| 10Jun16 / 4Oct16 |                                                |
| Inv.557          | 1 - SHOWER IN LIEU OF TUB BEDROOM 2            |
| Line12269        | Note:                                          |
| 10Jun16 / 4Oct16 |                                                |

9L-B  
JUNE 10 2016.

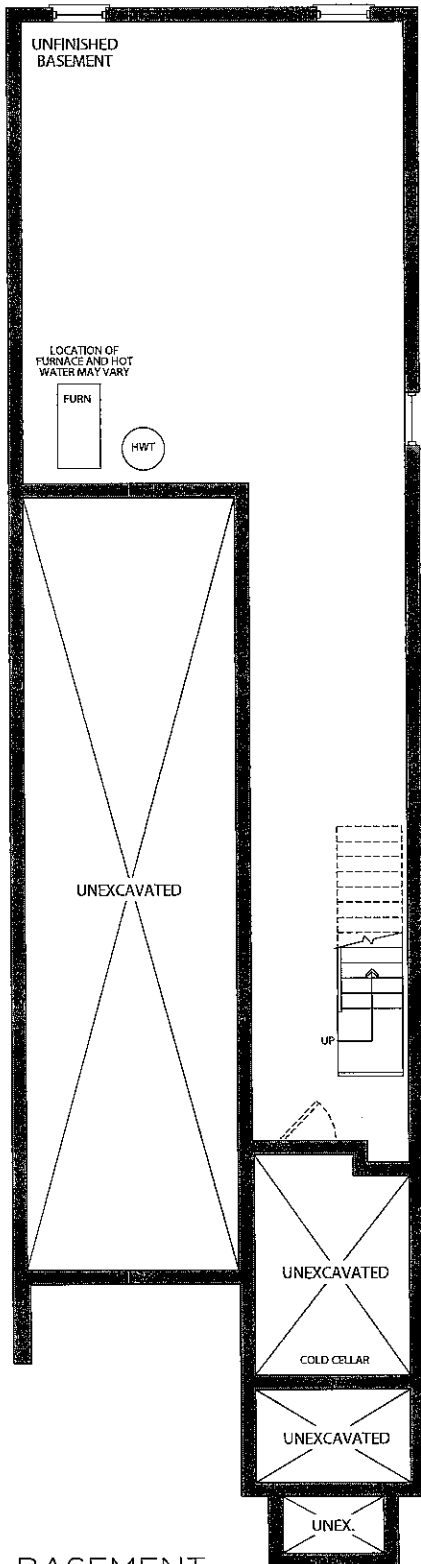

BASEMENT  
ELEVATION A & B



# the Carnegie



Elevation A • 3,214 sq.ft.





Elevation B • 3,214 sq.ft.


**GOLD MARK**

Prices, figures, illustrations, sizes, features and finishes are subject to change without notice. E.&O.E. Areas and dimensions are approximate and actual usable floor space may vary from the stated area. Layout may be reverse of the unit purchased. Models on 25' lots may be linked below grade at basement footings. E. & O.E.

Lot 9L-B


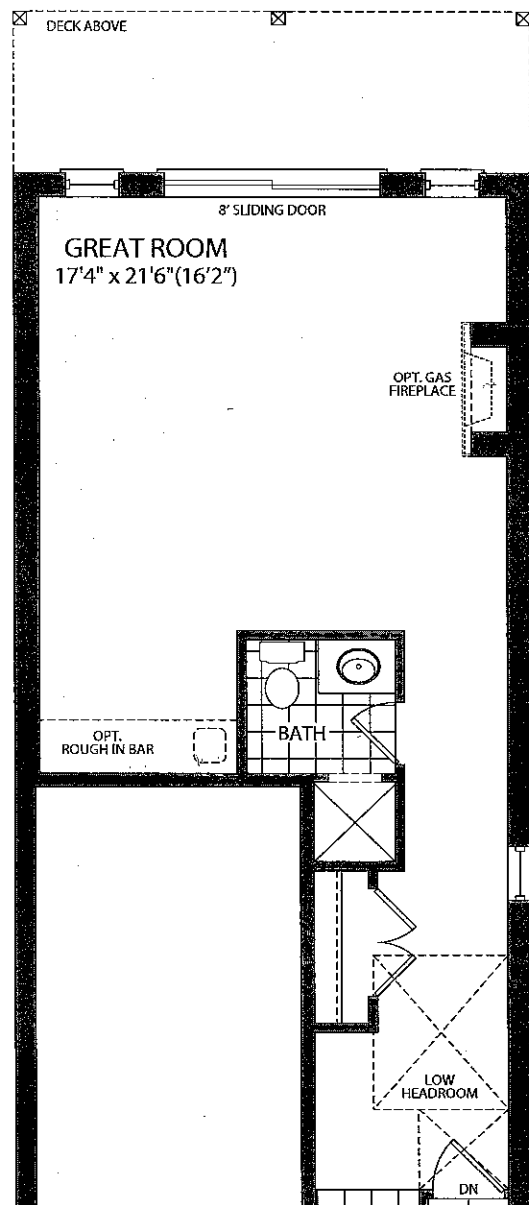
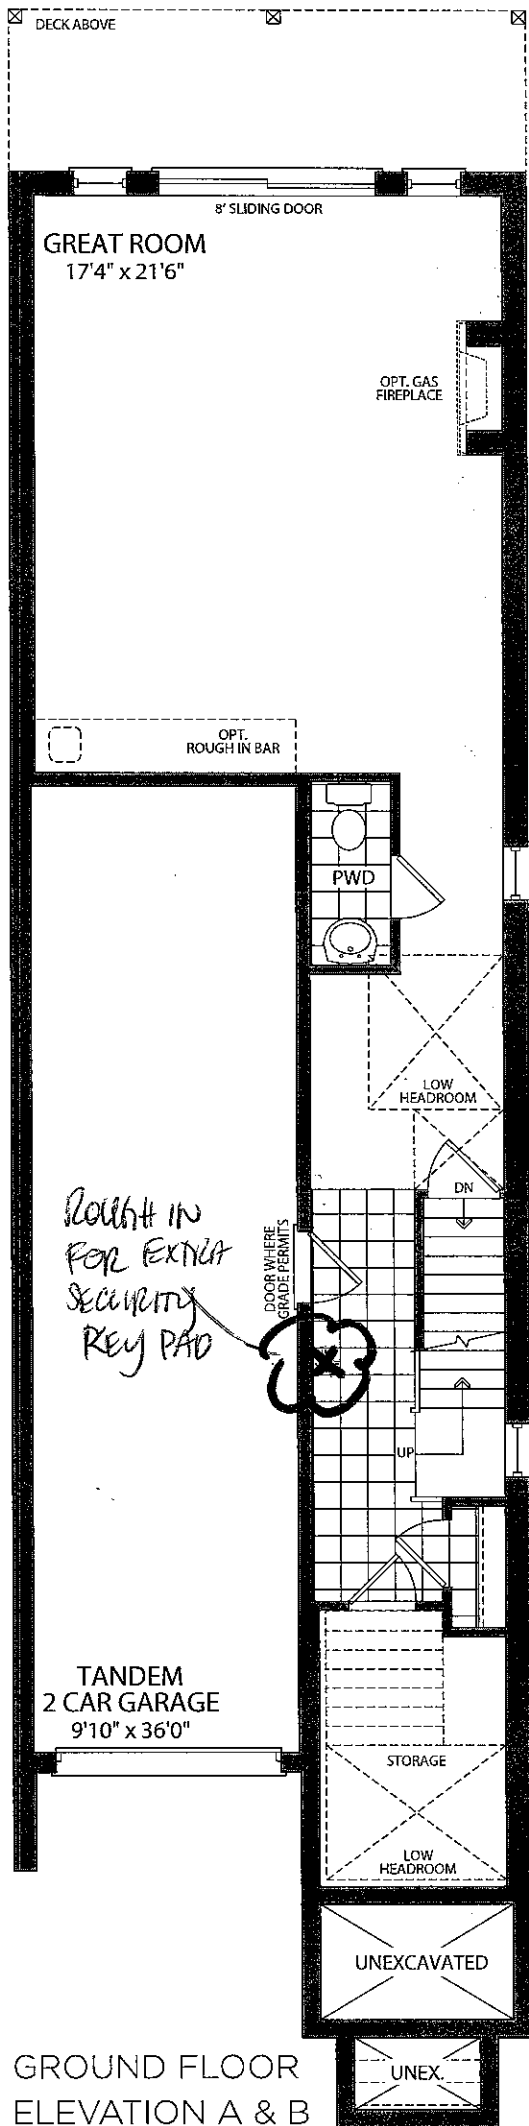


OPT. GROUND FLOOR  
ELEVATION A & B

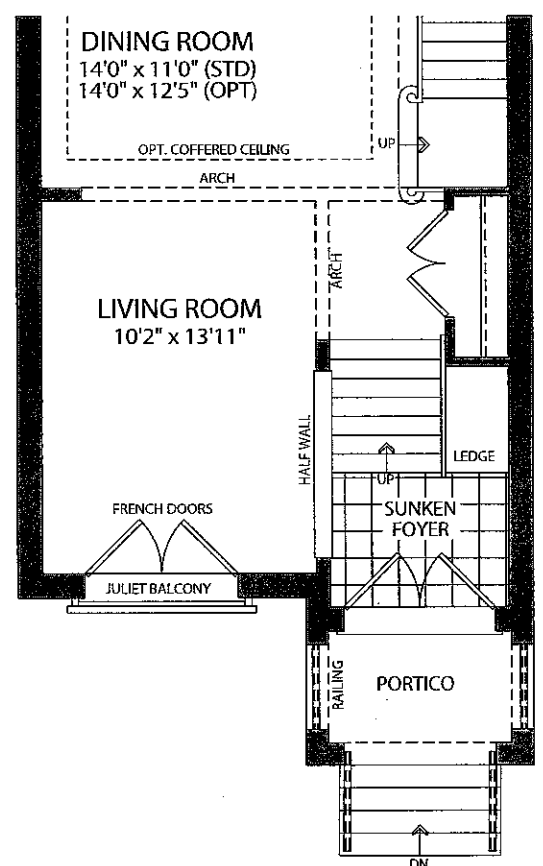


STD. & OPT. MAIN FLOOR  
ELEVATION B

LOT 9L-B

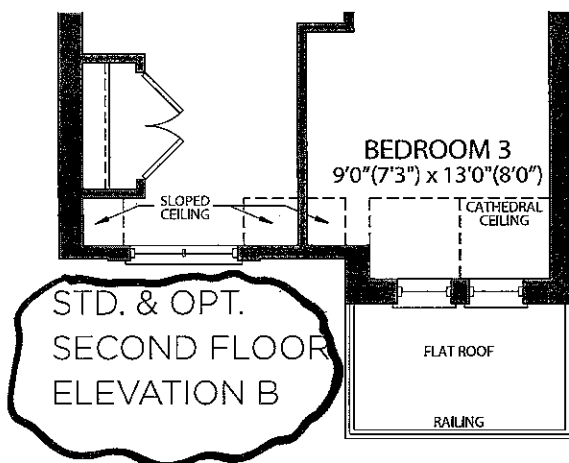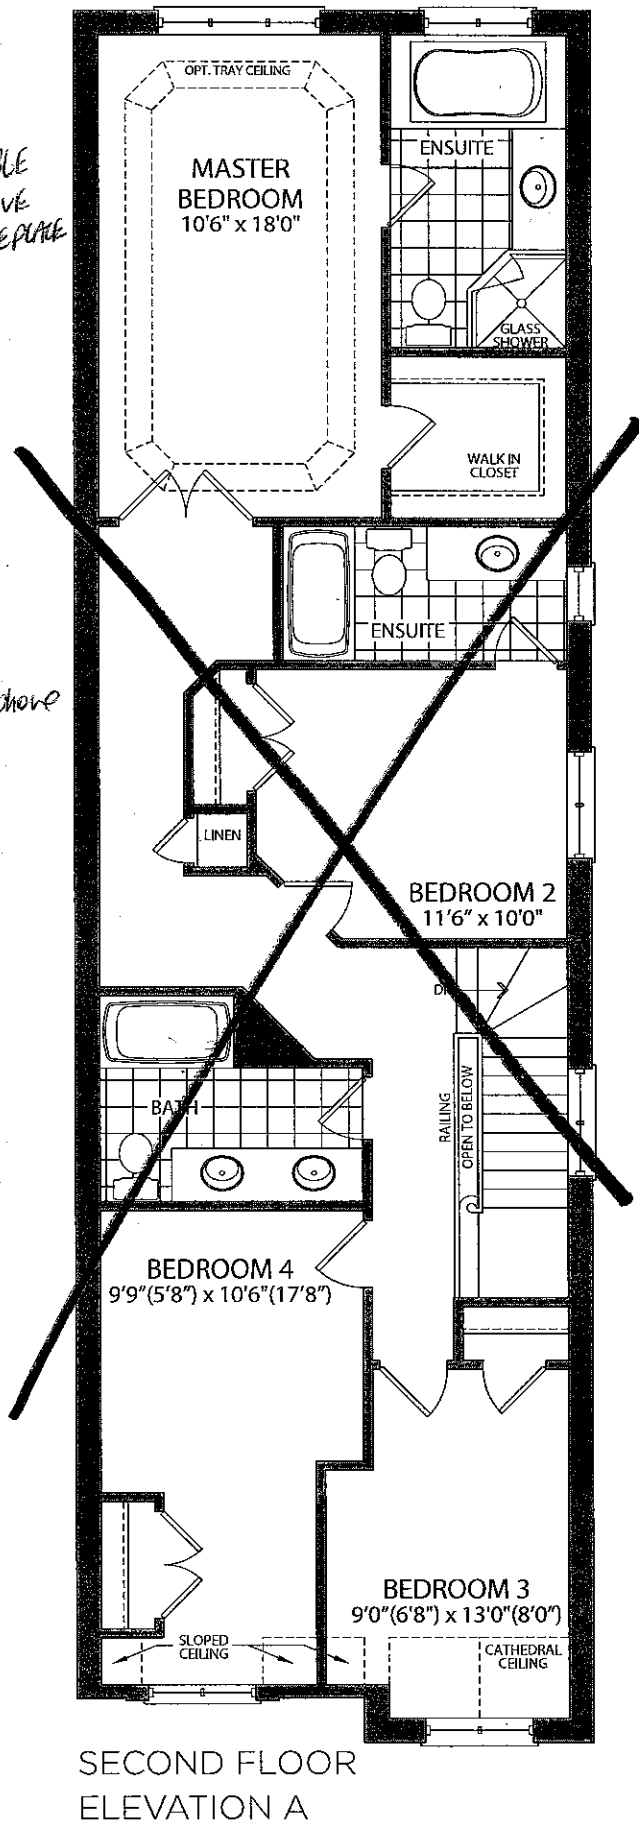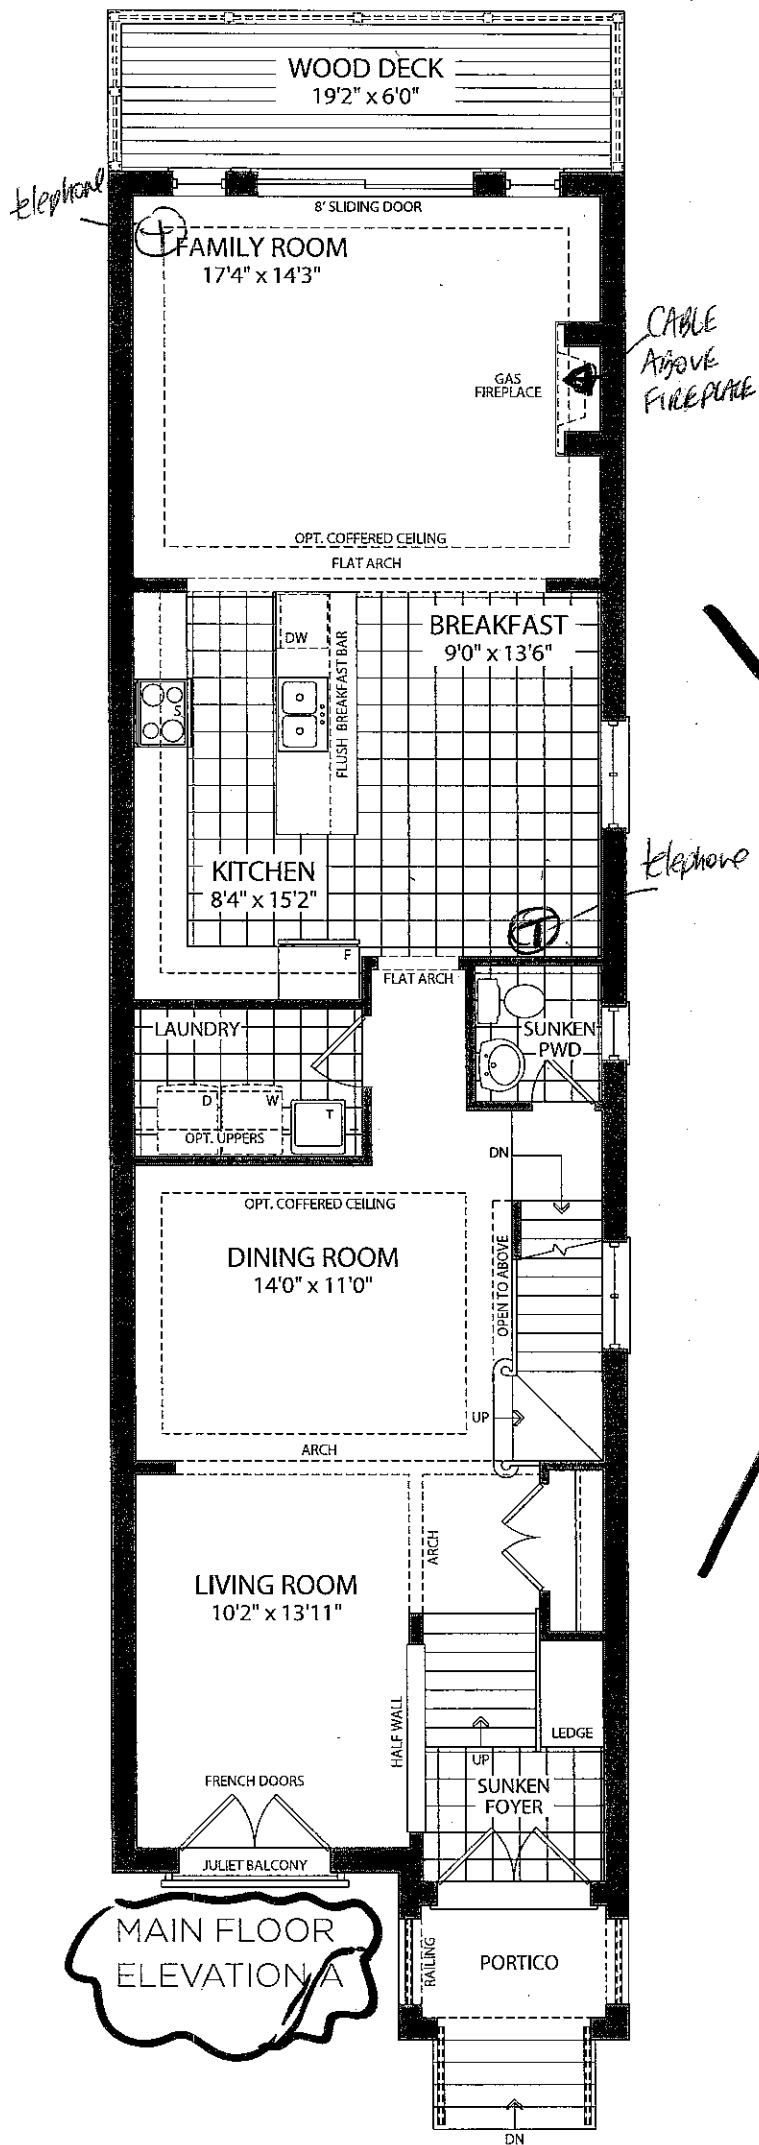


**Lot 9-L B**

*Handwritten:* P.M.

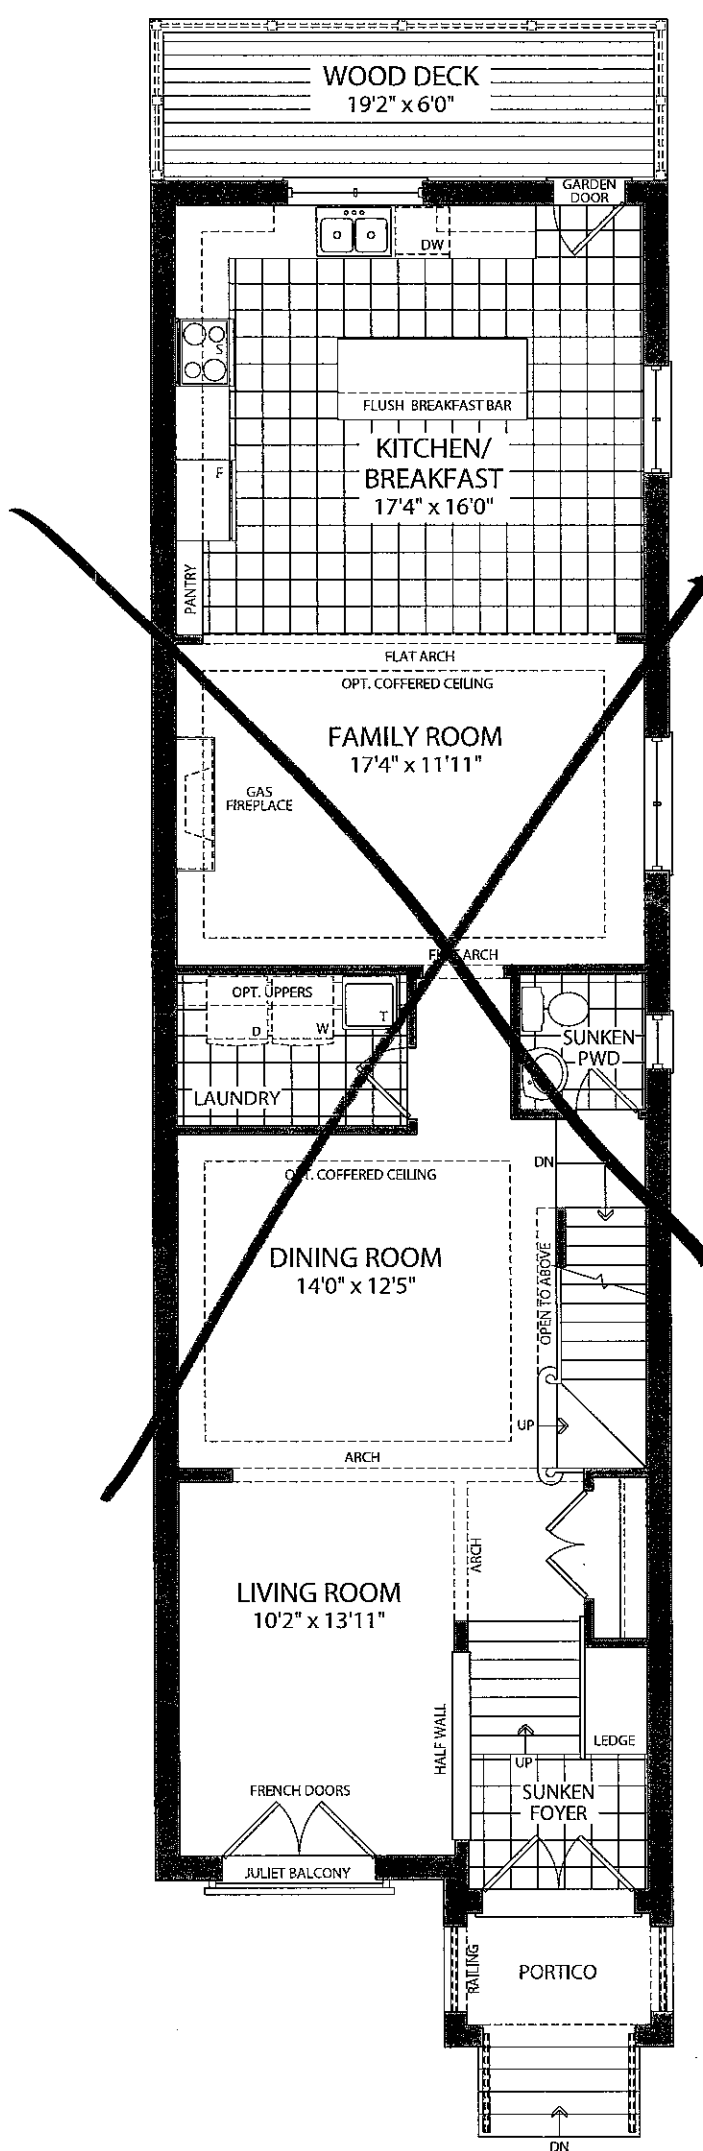

OPT. MAIN FLOOR  
ELEVATION A

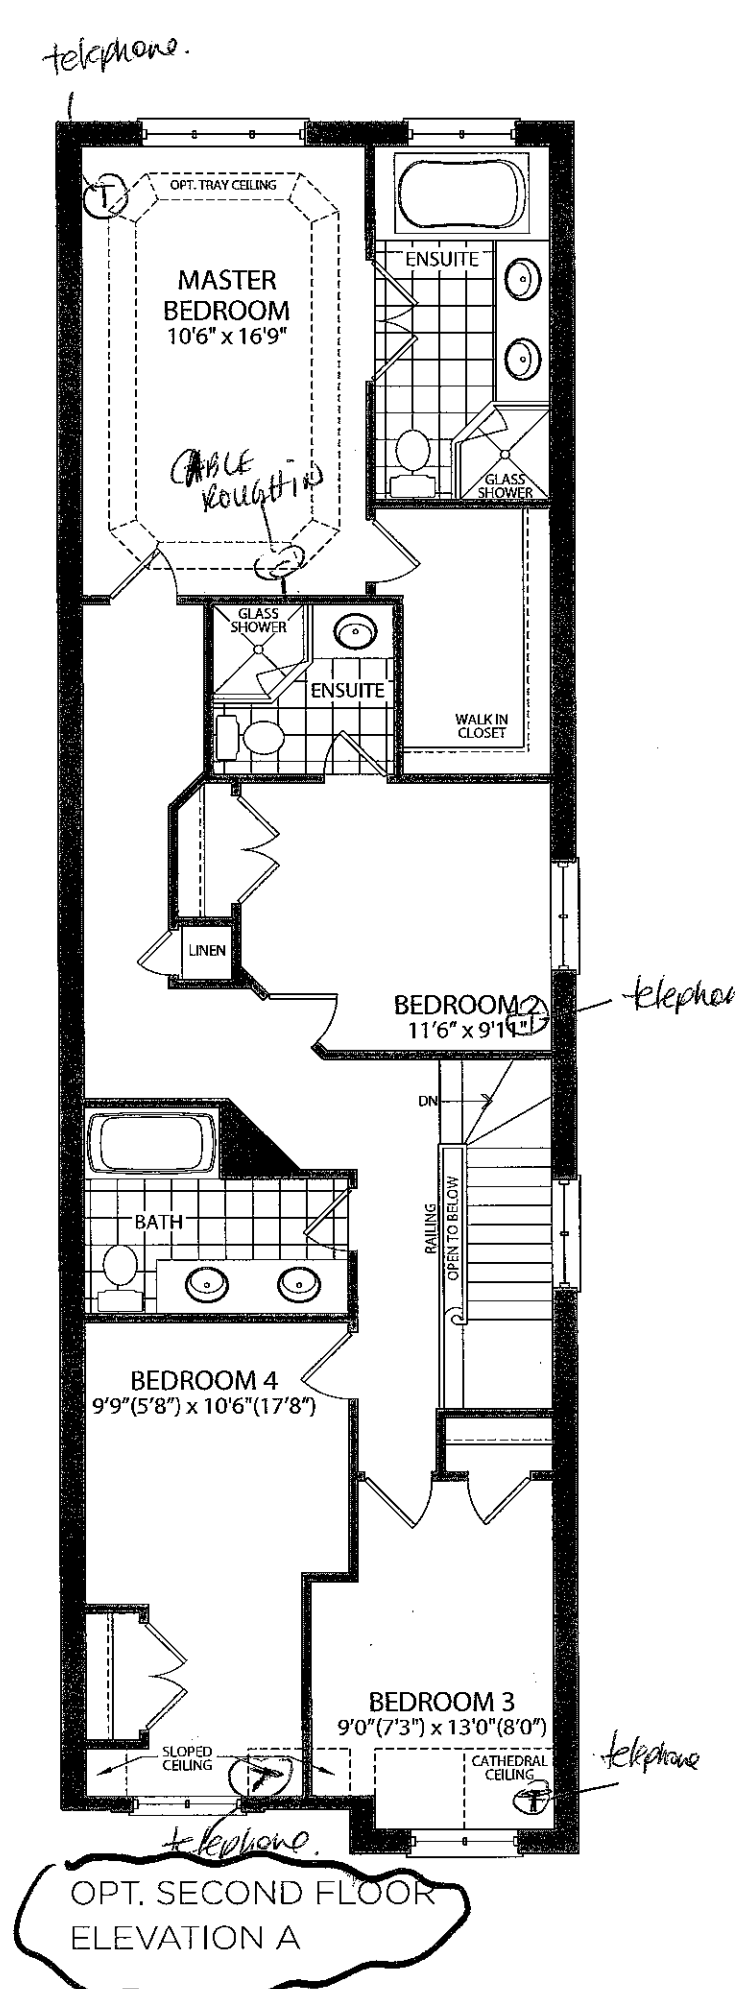



Stacey Carlete  
Project Coordinator



Claude Azzopardi  
Contracts Manager



Nancy Martini  
Corporate Controller



| 25.1 The Riverstone |                       |      |                                                     |
|---------------------|-----------------------|------|-----------------------------------------------------|
| Elevation           | Circle One            | A    | 1812.7 Square Feet                                  |
|                     |                       | B    | 1812.7 Square Feet                                  |
| Taller Ceilings     | Circle All that Apply | GFTC | 9' Ceilings Ground Floor                            |
|                     |                       | MFTC | 10' Ceilings Main Floor                             |
|                     |                       | SFTC | 9' Ceilings Second Floor                            |
| Optional Layouts    | Circle All that Apply | GFA1 | GROUND FLOOR Alternative Layout Kitchen/Family Room |
|                     |                       |      |                                                     |
|                     |                       |      |                                                     |
|                     |                       |      |                                                     |

| 25.2 The Hudson  |                       |      |                                                     |
|------------------|-----------------------|------|-----------------------------------------------------|
| Elevation        | Circle One            | A    | 1860.8 Square Feet                                  |
|                  |                       | B    | 1858.6 Square Feet                                  |
| Taller Ceilings  | Circle All that Apply | GFTC | 9' Ceilings Ground Floor                            |
|                  |                       | MFTC | 10' Ceilings Main Floor                             |
|                  |                       | SFTC | 9' Ceilings Second Floor                            |
| Optional Layouts | Circle All that Apply | GFA1 | GROUND FLOOR Alternative Layout Kitchen/Family Room |
|                  |                       |      |                                                     |
|                  |                       |      |                                                     |
|                  |                       |      |                                                     |

| 25.3 The Oakmount |                       |      |                                                     |
|-------------------|-----------------------|------|-----------------------------------------------------|
| Elevation         | Circle One            | A    | 2013.0 Square Feet                                  |
|                   |                       | B    | 2013.0 Square Feet                                  |
| Taller Ceilings   | Circle All that Apply | GFTC | 9' Ceilings Ground Floor                            |
|                   |                       | MFTC | 10' Ceilings Main Floor                             |
|                   |                       | SFTC | 9' Ceilings Second Floor                            |
| Optional Layouts  | Circle All that Apply | GFA1 | GROUND FLOOR Alternative Layout Kitchen/Family Room |
|                   |                       | SFA4 | SECOND FLOOR Alternative Layout Laundry Room        |
|                   |                       | SFA5 | SECOND FLOOR Additional Bedroom                     |
|                   |                       |      |                                                     |

| 25.4 The Stanford |                       |      |                                                   |
|-------------------|-----------------------|------|---------------------------------------------------|
| Elevation         | Circle One            | A    | 2665.6 Square Feet                                |
|                   |                       | B    | 2665.6 Square Feet                                |
| Taller Ceilings   | Circle All that Apply | GFTC | 9' Ceilings Ground Floor                          |
|                   |                       | MFTC | 10' Ceilings Main Floor                           |
|                   |                       | SFTC | 9' Ceilings Second Floor                          |
| Optional Layouts  | Circle All that Apply | GFA2 | GROUND FLOOR Optional Piece Bathroom              |
|                   |                       | MFA1 | MAIN FLOOR Alternative Layout Kitchen/Family Room |
|                   |                       | SFA2 | SECOND FLOOR Shower in Lieu of Tub (Master Ens.)  |
|                   |                       | SFA5 | SECOND FLOOR Additional Bedroom                   |
|                   |                       |      |                                                   |

| 25.5 The Regency |                       |      |                                                   |
|------------------|-----------------------|------|---------------------------------------------------|
| Elevation        | Circle One            | A    | 2924.0 Square Feet                                |
|                  |                       | B    | 2924.0 Square Feet                                |
| Taller Ceilings  | Circle All that Apply | GFTC | 9' Ceilings Ground Floor                          |
|                  |                       | MFTC | 10' Ceilings Main Floor                           |
|                  |                       | SFTC | 9' Ceilings Second Floor                          |
| Optional Layouts | Circle All that Apply | GFA2 | GROUND FLOOR Optional Piece Bathroom              |
|                  |                       | MFA1 | MAIN FLOOR Alternative Layout Kitchen/Family Room |
|                  |                       | SFA2 | SECOND FLOOR Shower in Lieu of Tub (Master Ens.)  |
|                  |                       | SFA5 | SECOND FLOOR Additional Bedroom                   |
|                  |                       |      |                                                   |

| 25.6 The Lincoln |                       |      |                                                   |
|------------------|-----------------------|------|---------------------------------------------------|
| Elevation        | Circle One            | A    | 3021.0 Square Feet                                |
|                  |                       | B    | 3014.0 Square Feet                                |
| Taller Ceilings  | Circle All that Apply | GFTC | 9' Ceilings Ground Floor                          |
|                  |                       | MFTC | 10' Ceilings Main Floor                           |
|                  |                       | SFTC | 9' Ceilings Second Floor                          |
| Optional Layouts | Circle All that Apply | GFA2 | GROUND FLOOR Optional Piece Bathroom              |
|                  |                       | MFA1 | MAIN FLOOR Alternative Layout Kitchen/Family Room |
|                  |                       |      |                                                   |

| 25.7 The Carnegie |                       |      |                                                   |
|-------------------|-----------------------|------|---------------------------------------------------|
| Elevation         | Circle One            | A    | 3150.8 Square Feet                                |
|                   |                       | B    | 3150.8 Square Feet                                |
| Taller Ceilings   | Circle All that Apply | GFTC | 9' Ceilings Ground Floor                          |
|                   |                       | MFTC | 10' Ceilings Main Floor                           |
|                   |                       | SFTC | 9' Ceilings Second Floor                          |
| Optional Layouts  | Circle All that Apply | GFA2 | GROUND FLOOR Optional Piece Bathroom              |
|                   |                       | MFA1 | MAIN FLOOR Alternative Layout Kitchen/Family Room |
|                   |                       | SFA1 | SECOND FLOOR Shower in Lieu of Tub (Bedroom 2)    |
|                   |                       |      |                                                   |

| 25.8 The Biltmore |                       |      |                          |
|-------------------|-----------------------|------|--------------------------|
| Elevation         | Circle One            | A    | 1980.8 Square Feet       |
|                   |                       | B    | 1989.3 Square Feet       |
| Taller Ceilings   | Circle All that Apply | GFTC | 9' Ceilings Ground Floor |
|                   |                       | MFTC | 10' Ceilings Main Floor  |
|                   |                       | SFTC | 9' Ceilings Second Floor |
| Optional Layouts  | Circle All that Apply |      |                          |
|                   |                       |      |                          |
|                   |                       |      |                          |
|                   |                       |      |                          |

| Elevation        | Circle One            |  |  |
|------------------|-----------------------|--|--|
|                  |                       |  |  |
| Taller Ceilings  | Circle All that Apply |  |  |
|                  |                       |  |  |
|                  |                       |  |  |
| Optional Layouts | Circle All that Apply |  |  |
|                  |                       |  |  |
|                  |                       |  |  |
|                  |                       |  |  |

| Elevation        | Circle One            |  |  |
|------------------|-----------------------|--|--|
|                  |                       |  |  |
| Taller Ceilings  | Circle All that Apply |  |  |
|                  |                       |  |  |
|                  |                       |  |  |
| Optional Layouts | Circle All that Apply |  |  |
|                  |                       |  |  |
|                  |                       |  |  |
|                  |                       |  |  |

LOT 9L-B.

